
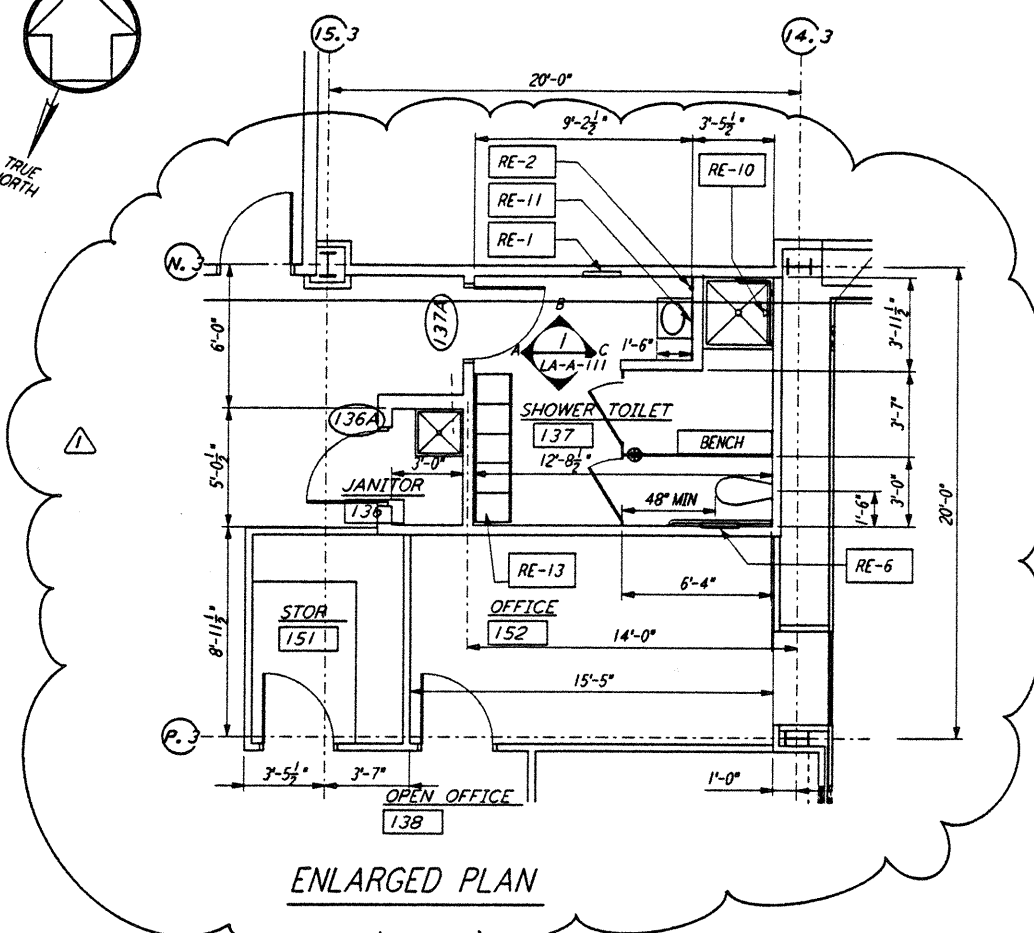



not be reproduced, copied, loaned, exhibited, or used in any other way, except by written consent from PARSONS to the borrower.

This document and the design it covers are the property of PARSONS. They are loaned only with the borrower's expressed written agreement that they will


480 PLOT 13 1410000 1317 33703002 JAVTLU13\WELLES\V3062\HRTU13.PTW

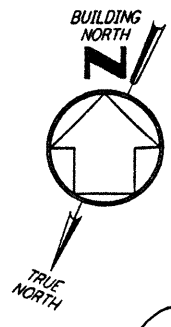


JANITOR 136 / SHOWER TOILET 137
 1/4" = 1'-0"

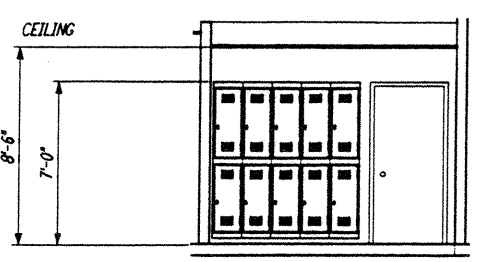


ELEVATION A

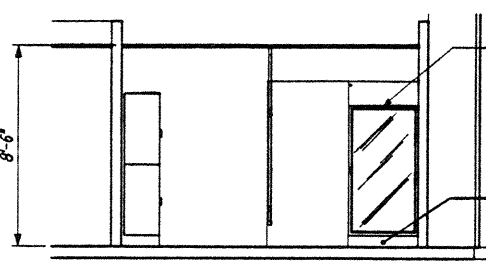


ELEVATION B

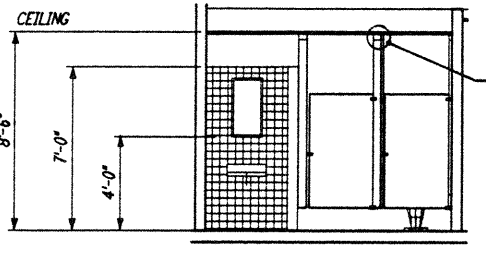


ELEVATION C

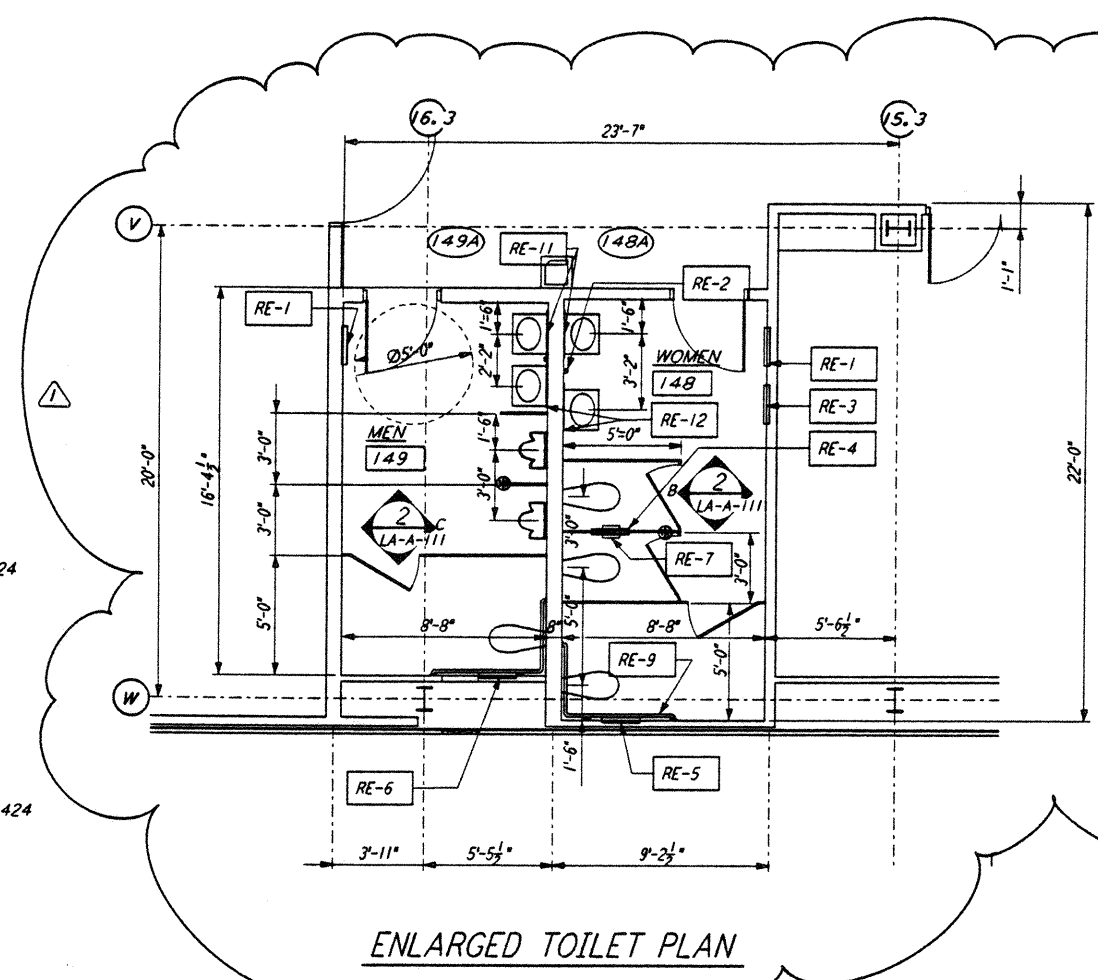


MEN 149 / WOMEN 148
 1/4" = 1'-0"

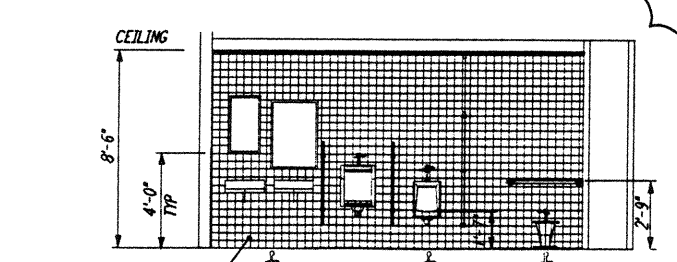


ELEVATION C

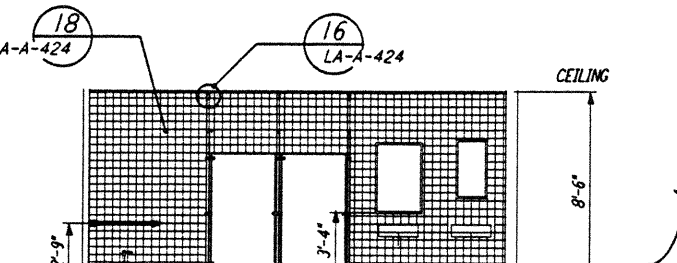


ELEVATION B

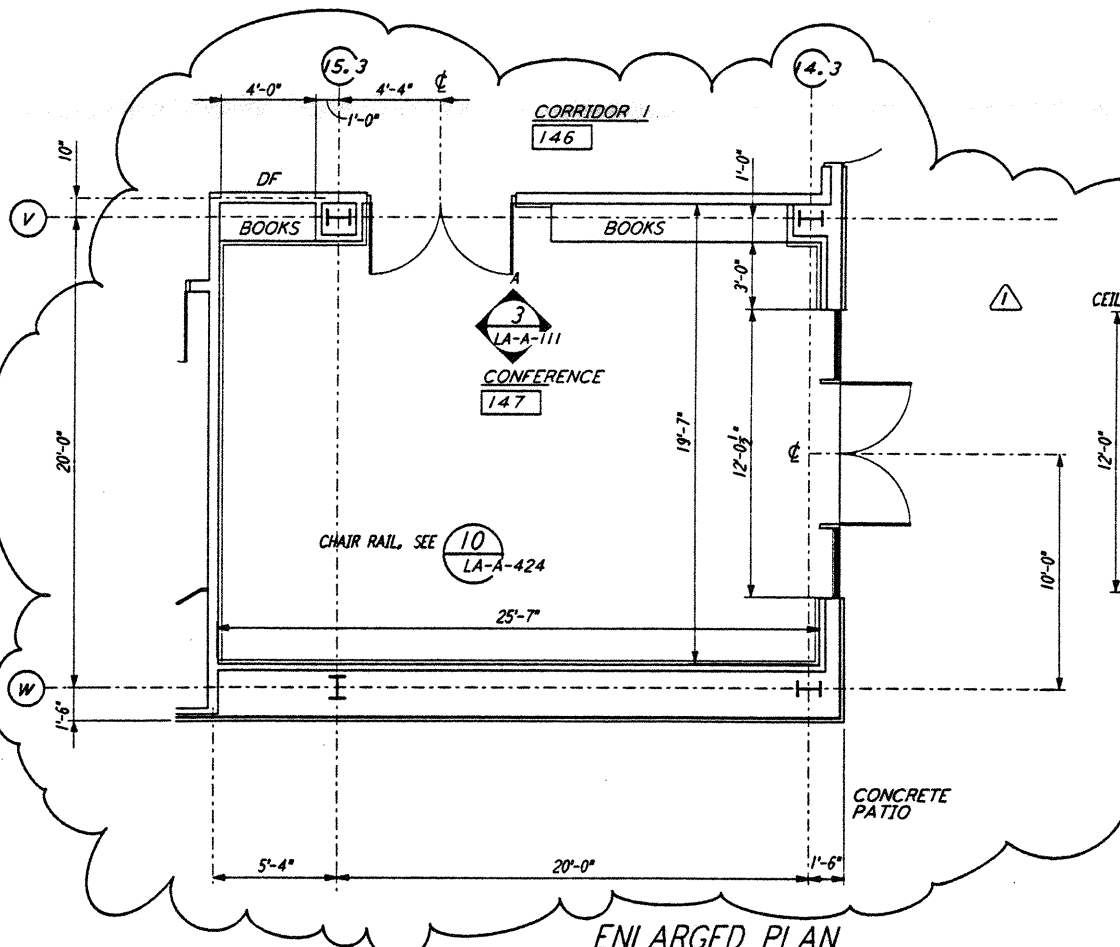


CONFERENCE ROOM 147
 1/4" = 1'-0"

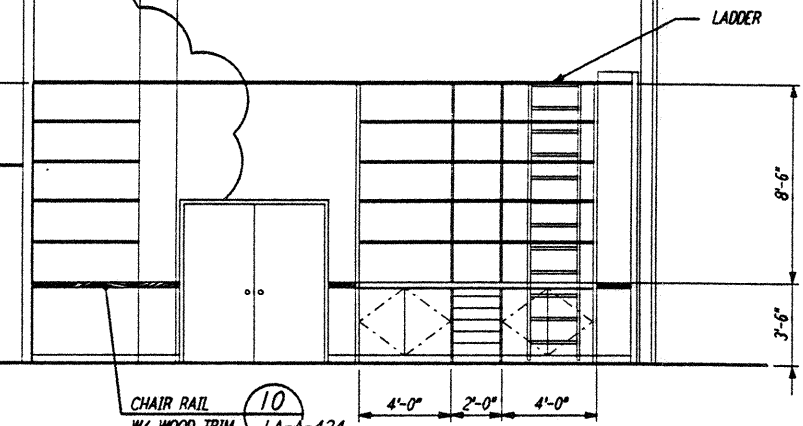


ELEVATION A

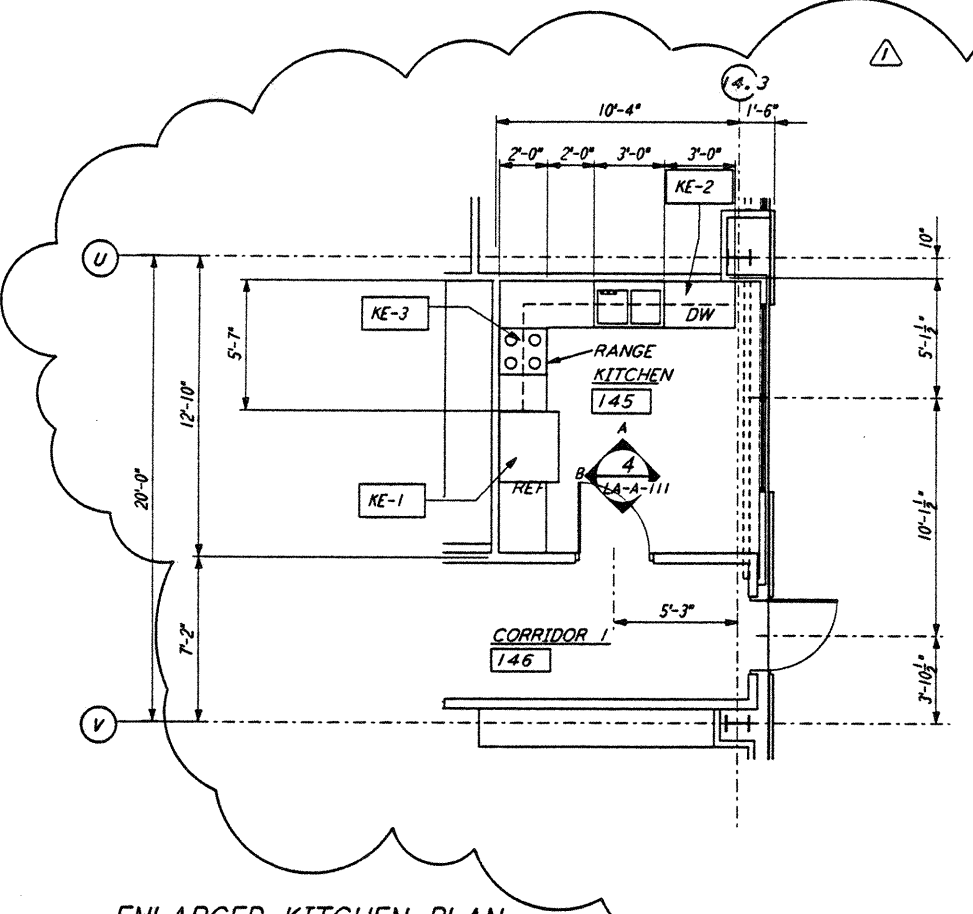


KITCHEN PLAN 145
 1/4" = 1'-0"

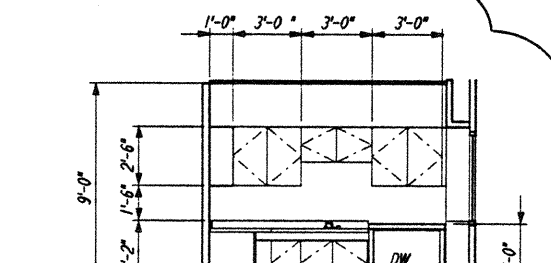

ELEVATION A

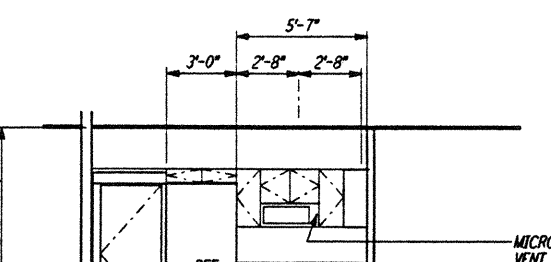

ELEVATION B

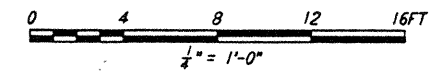

LIGO-D960876-01-0

NO.	DATE	BY	CHKD	ENGR	PROJ	OSB REVISION	DESCRIPTION
1	2-28-97	CXT	TB	AK	TDM	OSB	REVISION

ISSUED FOR CONSTRUCTION	
DRAWN	CXT 11-15-96
CHECKED	TB 11-15-96
ENGINEER	SF 11-15-96
PROJ	MOW 11-15-96



PARSONS
 100 WEST WALNUT STREET
 PASADENA, CALIFORNIA

LIGO
 CALIFORNIA INSTITUTE OF TECHNOLOGY
 MASSACHUSETTS INSTITUTE OF TECHNOLOGY

LASER INTERFEROMETER
 GRAVITATIONAL-WAVE OBSERVATORY
 SITE NO. 2 - LIVINGSTON, LOUISIANA

ARCHITECTURAL
 CORNER STATION
 OSB ENLARGED PLANS

AS NOTED PP150969 8094
 SHEET NUMBER
LA-A-111