

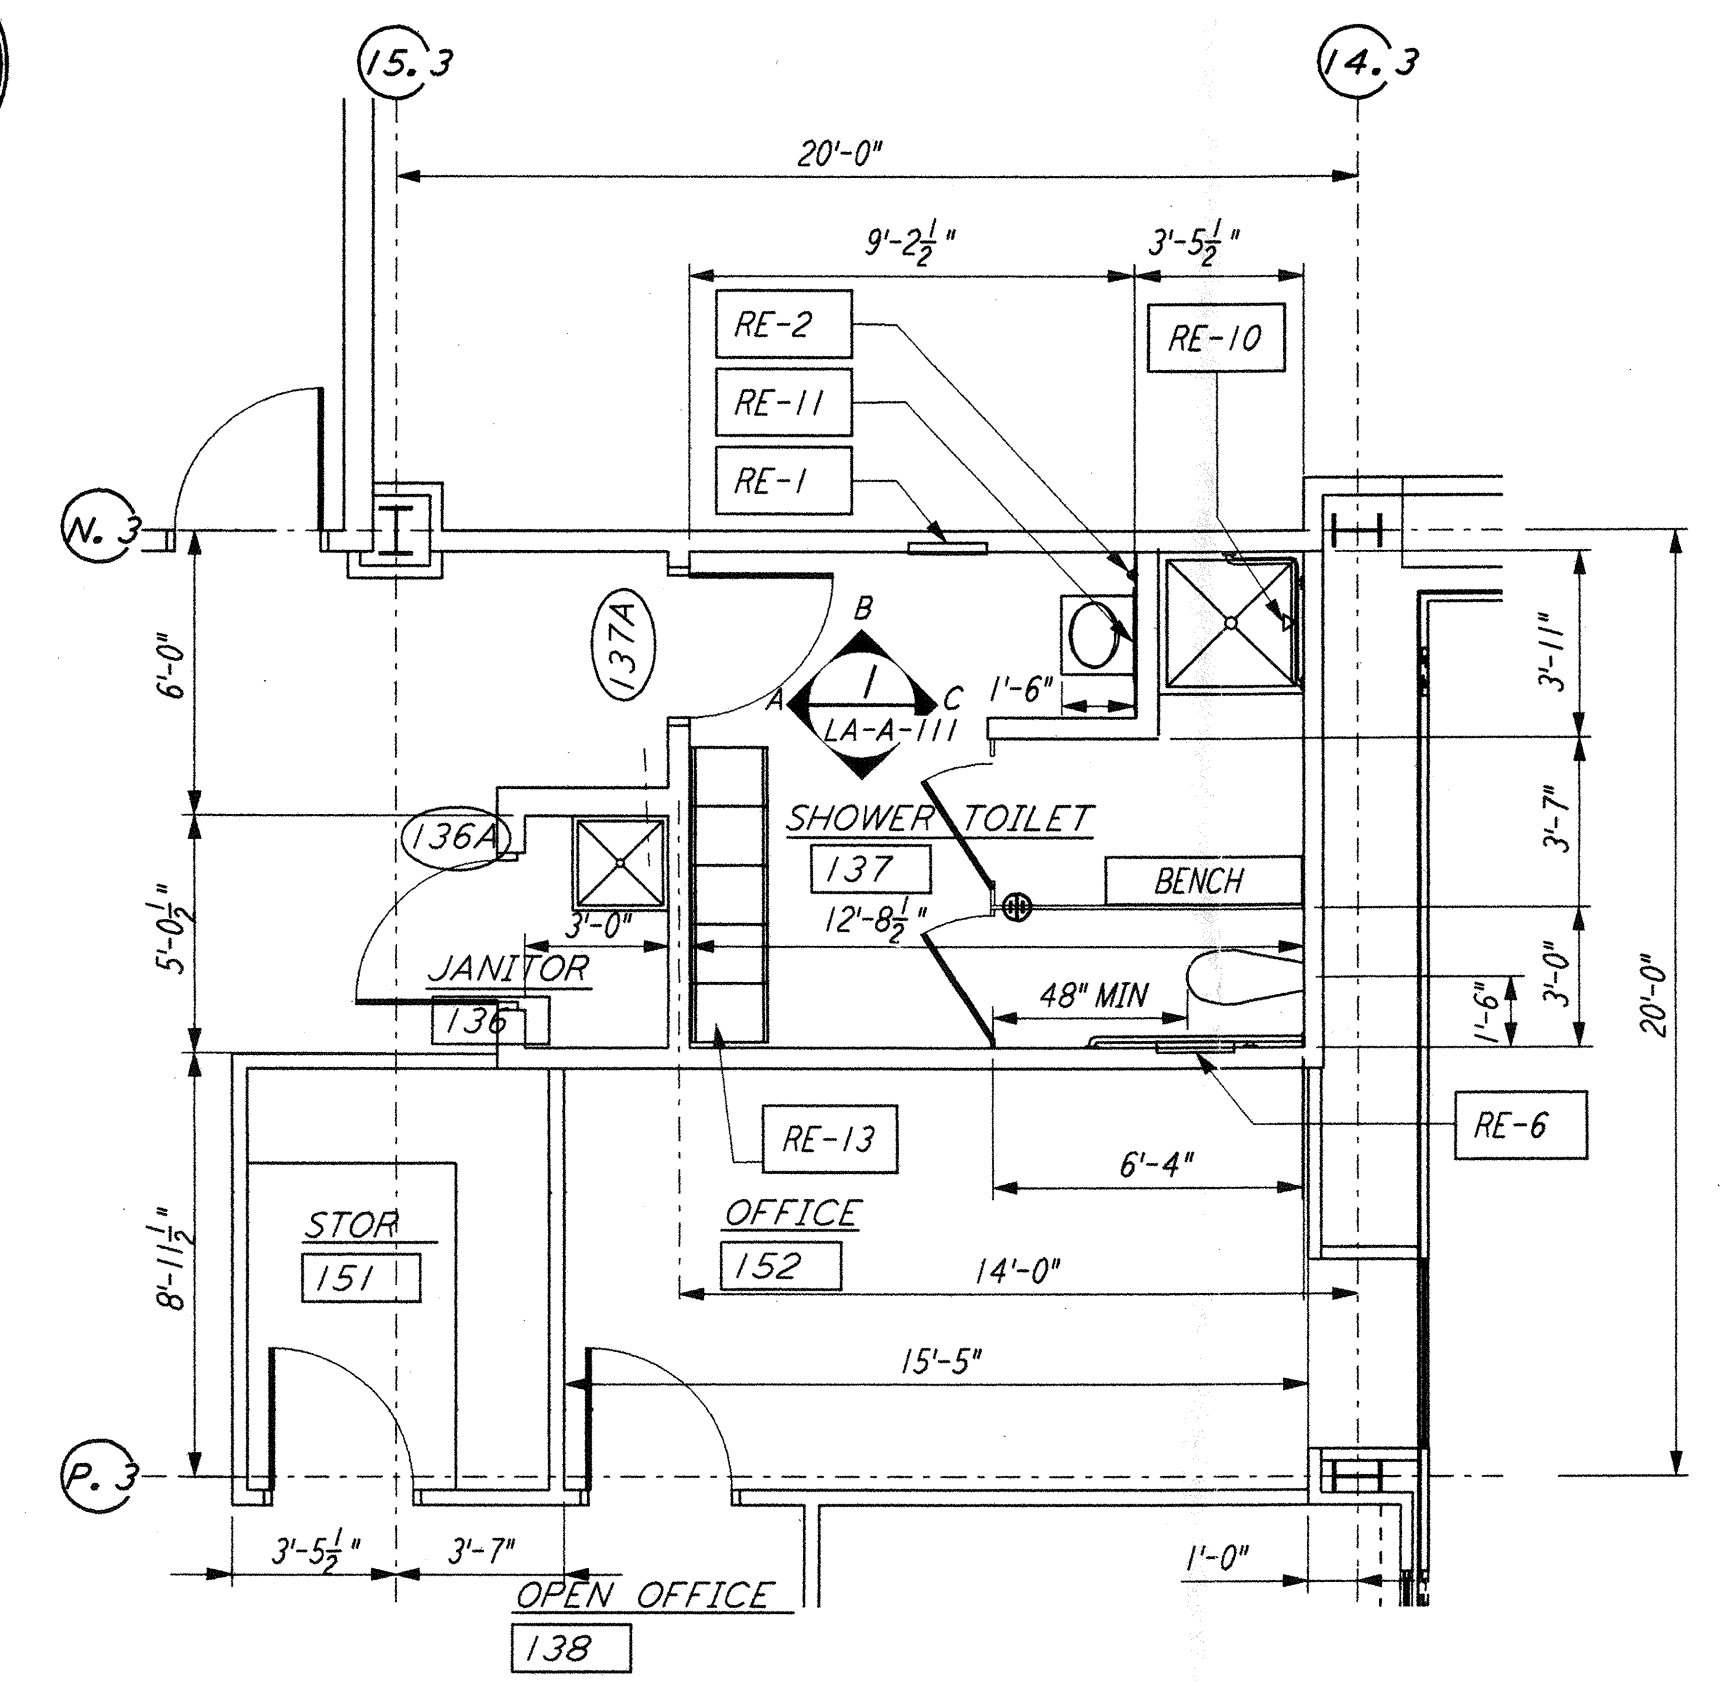


This document and the design it covers are the property of PARSONS. They are loaned only with the borrower's expressed written agreement that they will not be reproduced, copied, loaned, exhibited, or used in any other way, except by written consent from PARSONS to the borrower.

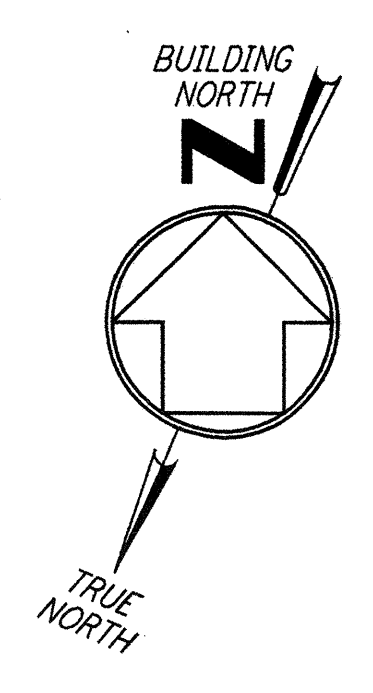


ENLARGED PLAN


JANITOR 136 / SHOWER TOILET 137
 $\frac{1}{4}'' = 1'-0''$

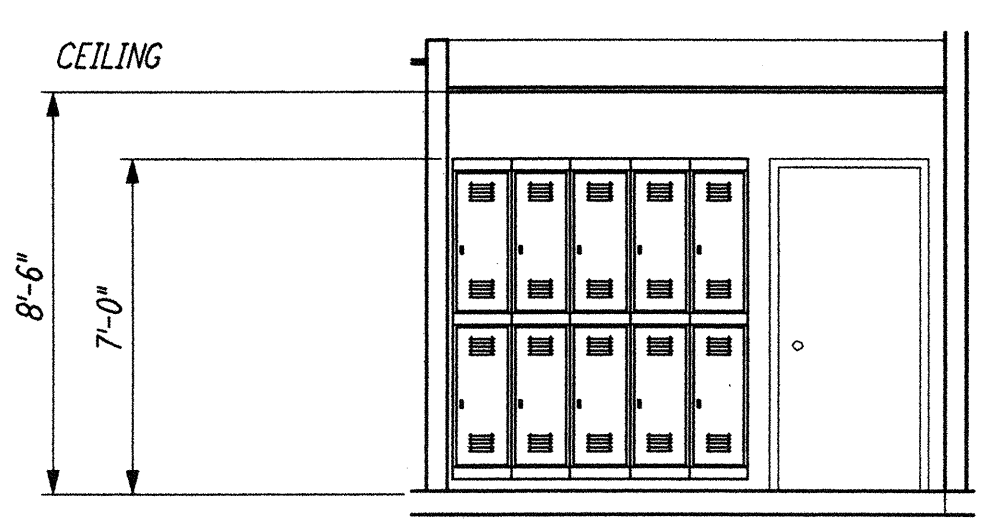

ELEVATION A

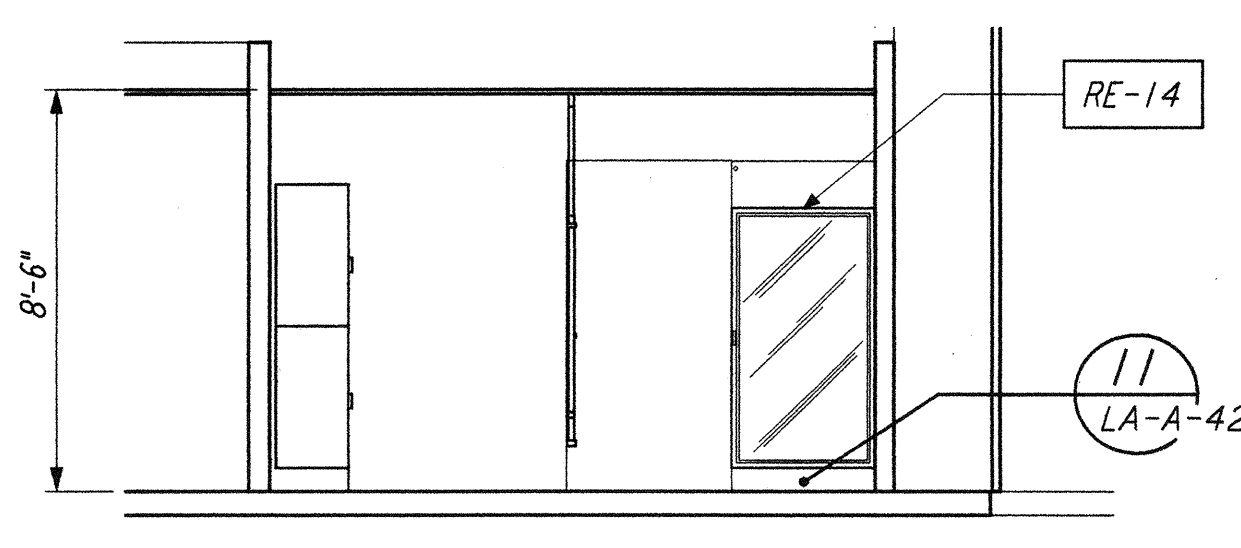


ELEVATION B

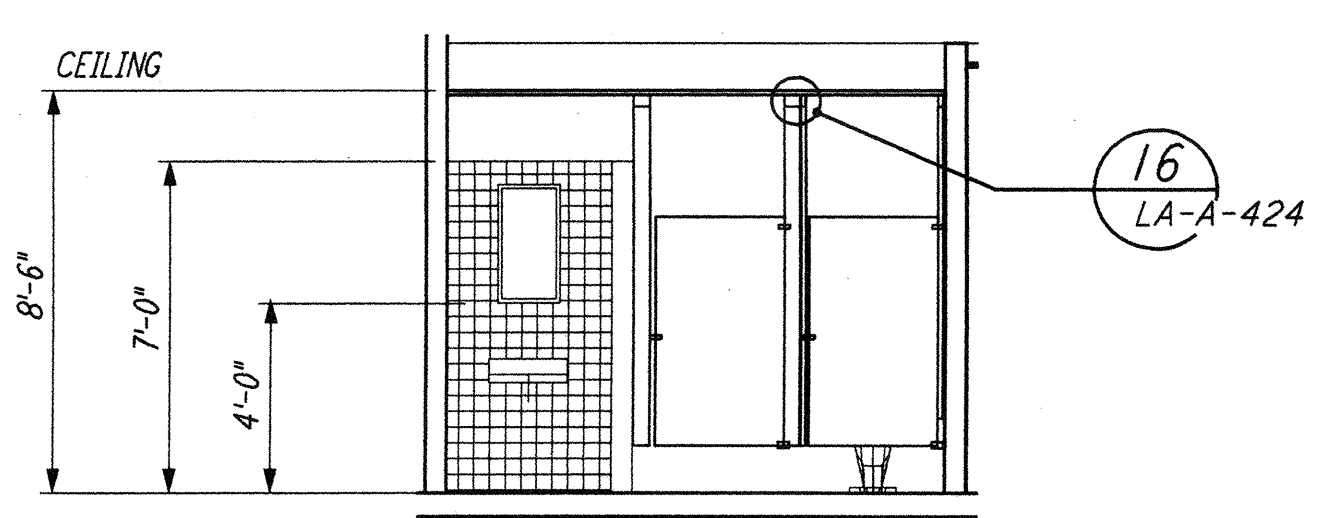

ELEVATION C


1 REF
 LA-A-111 LA-A-108

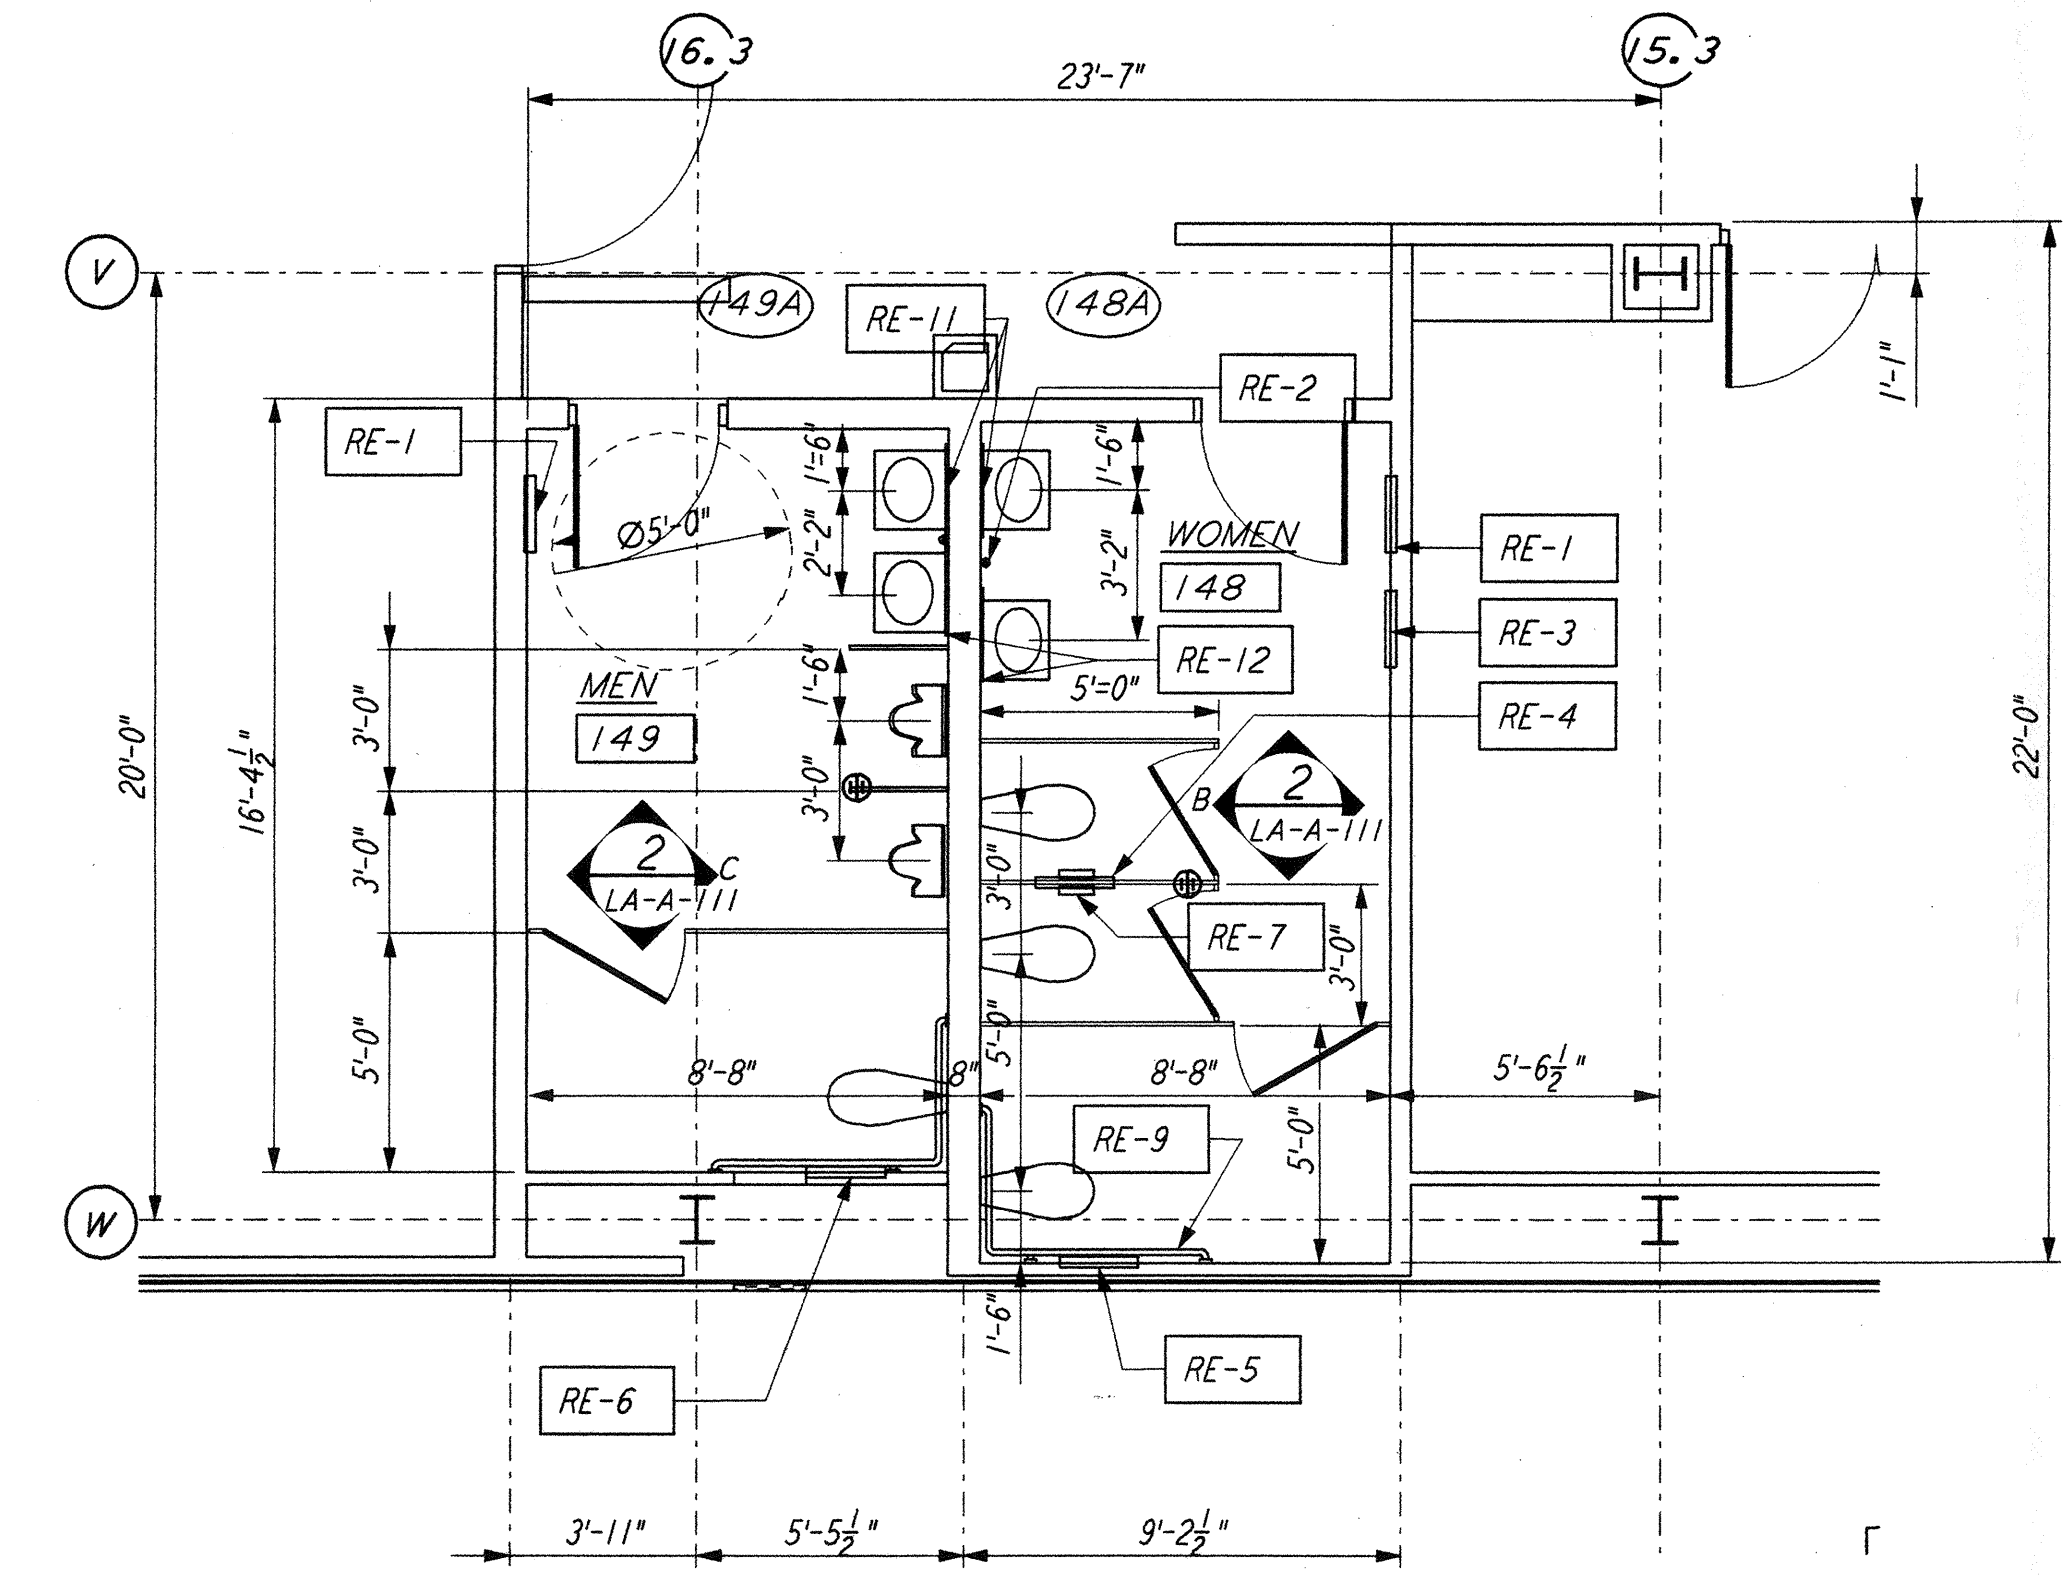


ENLARGED TOILET PLAN

MEN 149 / WOMEN 148
 $\frac{1}{4}'' = 1'-0''$


2 REF
 LA-A-111 LA-A-108

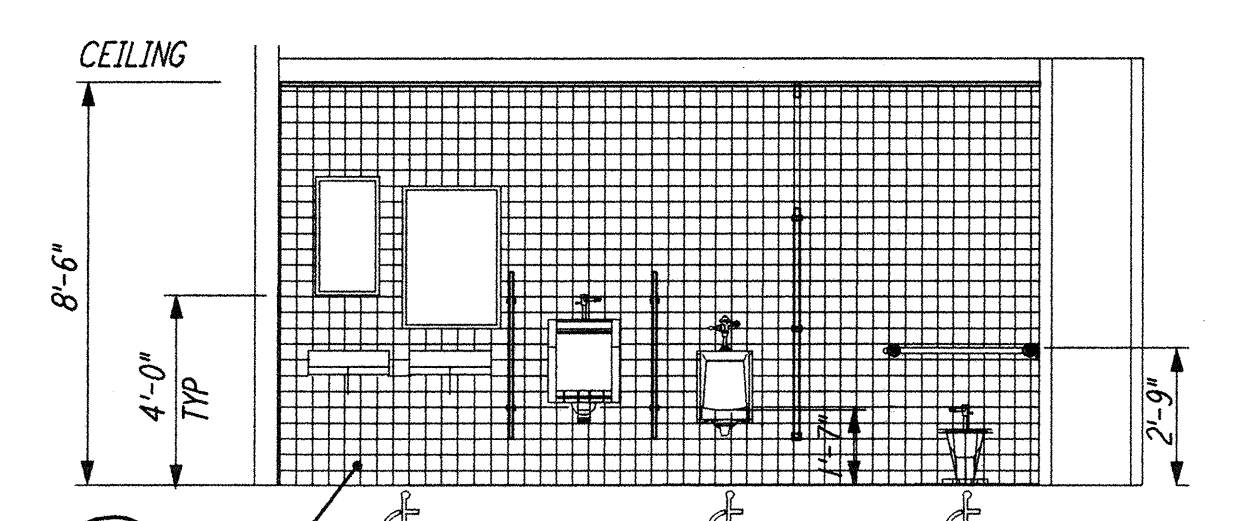

ELEVATION C

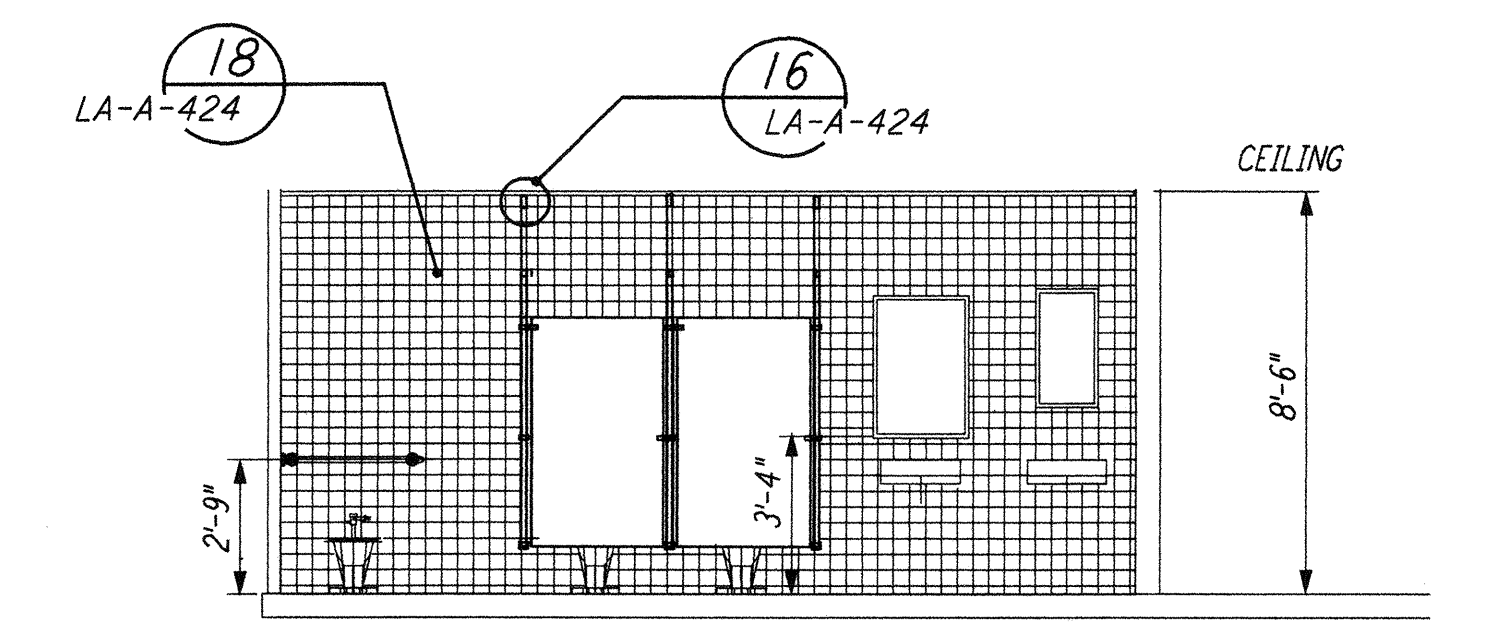


ELEVATION B

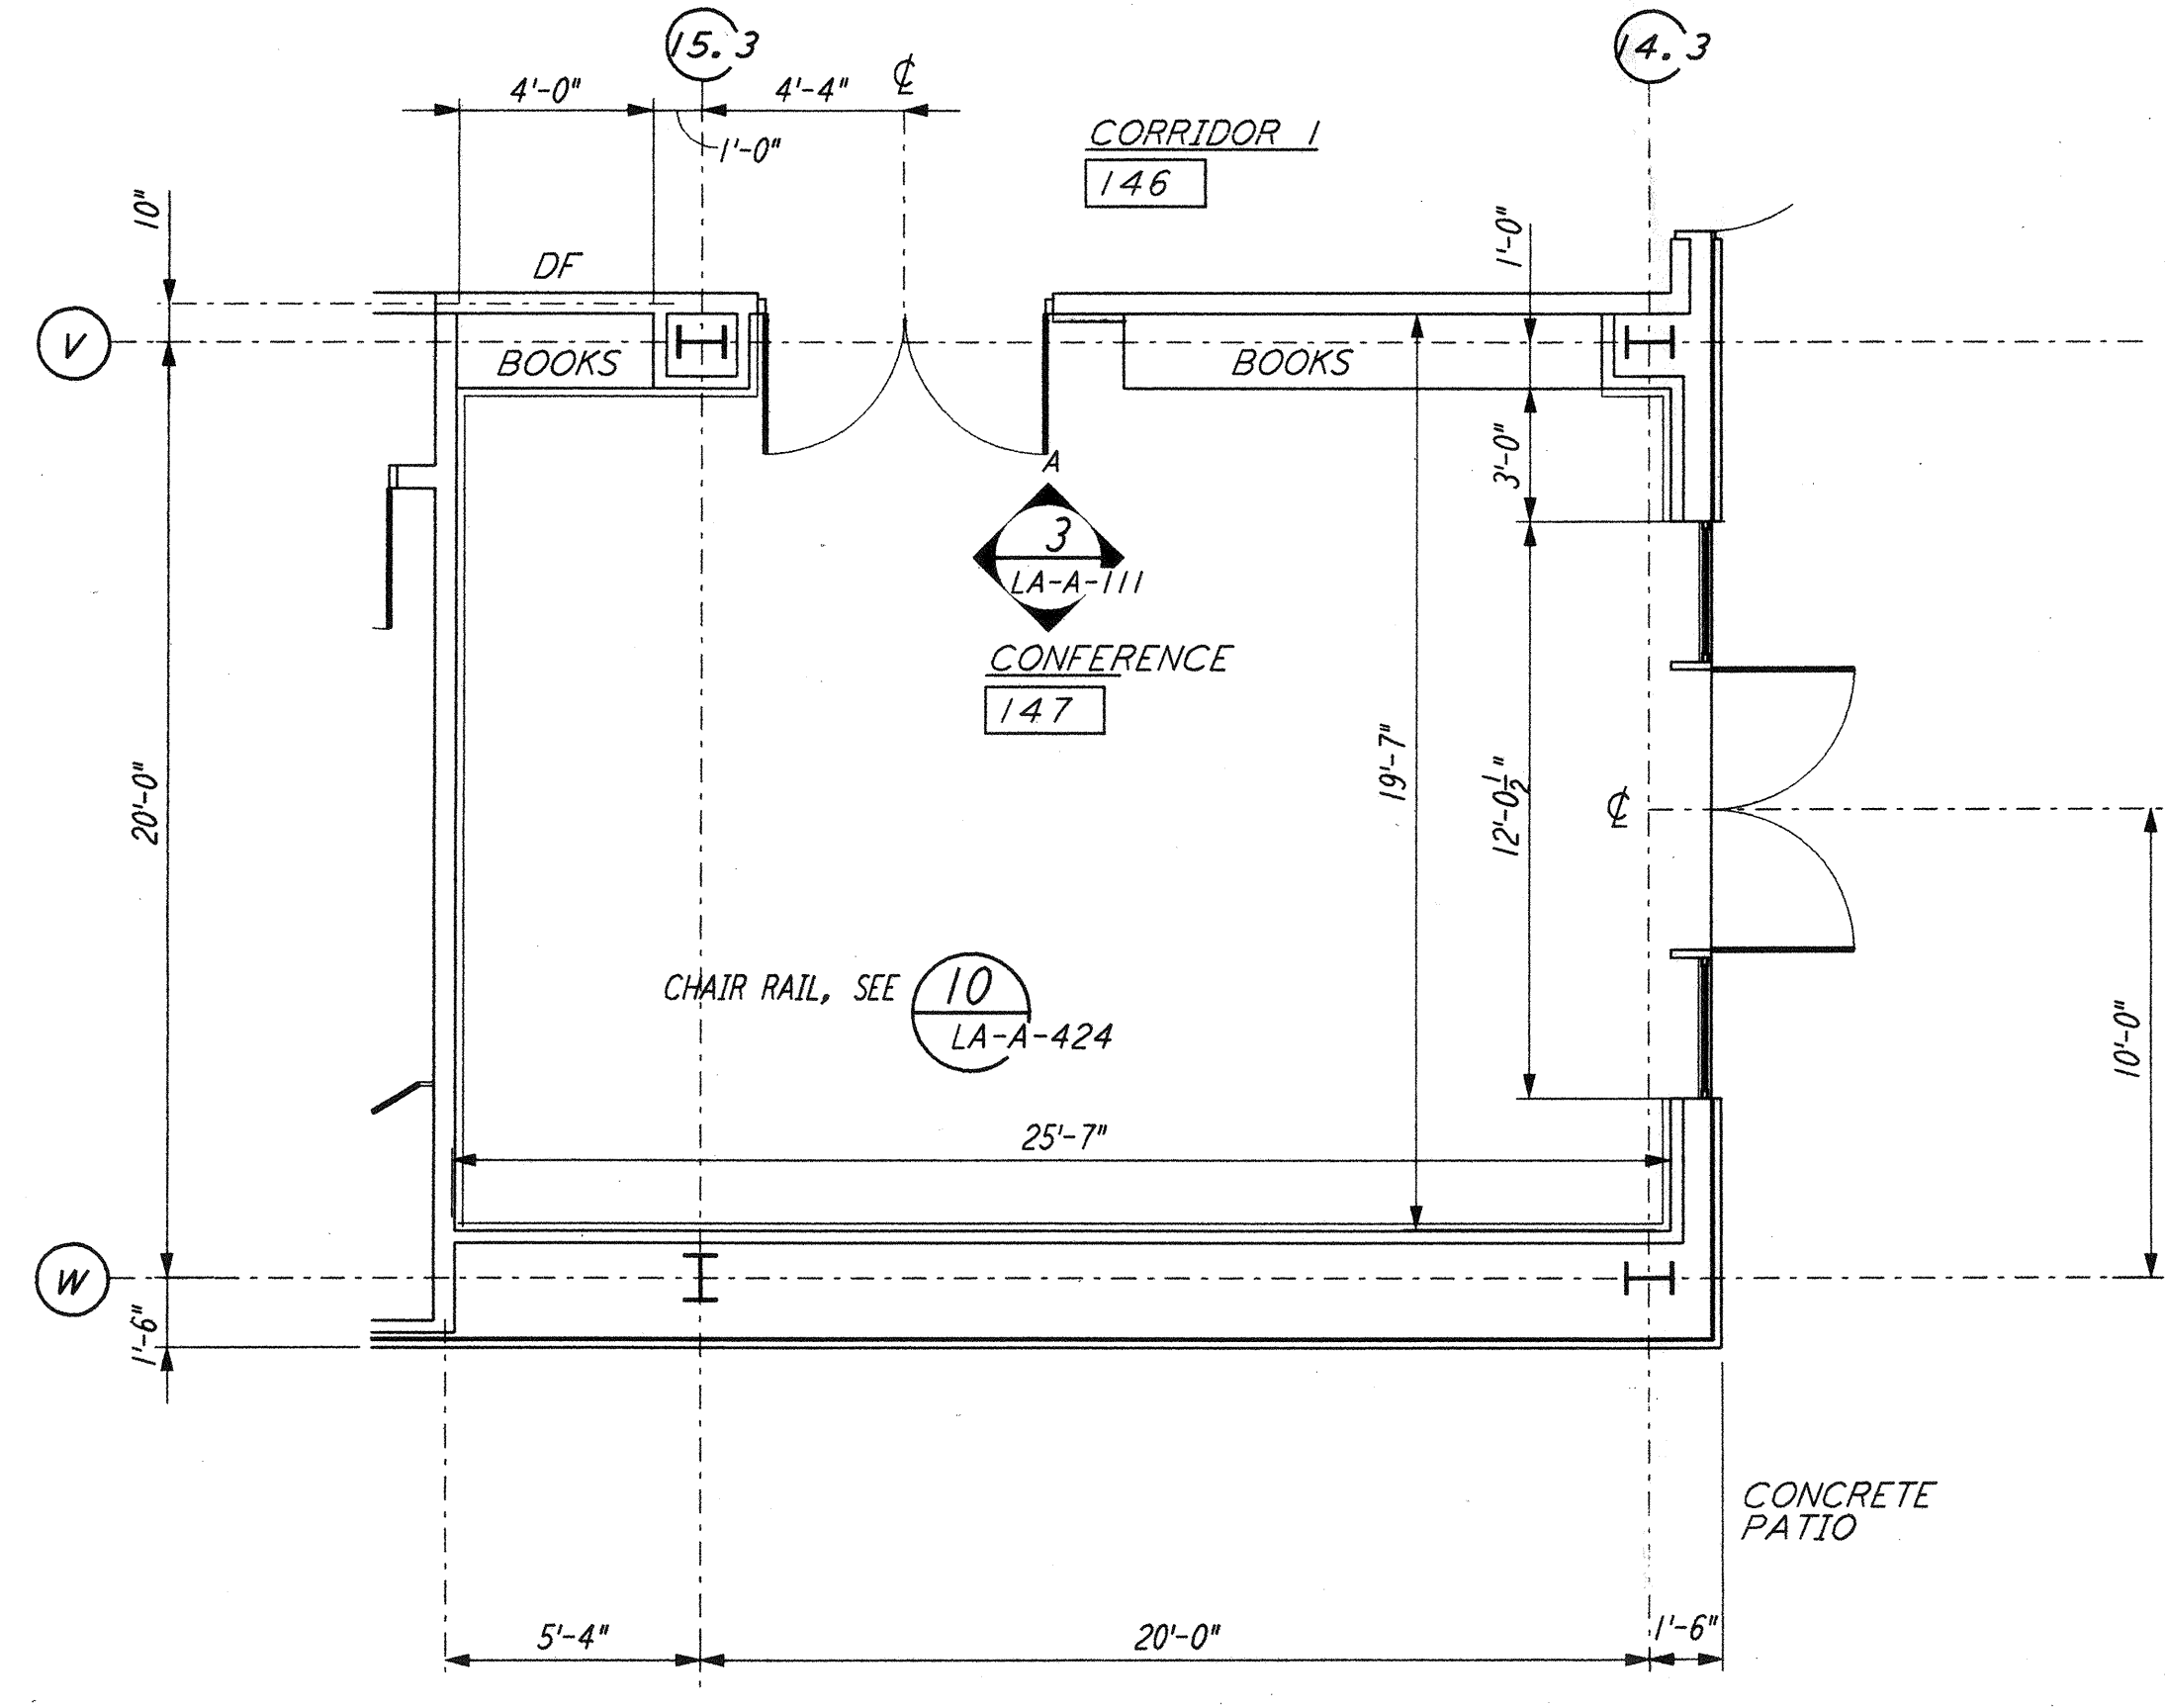


ENLARGED PLAN

CONFERENCE ROOM 147
 $\frac{1}{4}'' = 1'-0''$

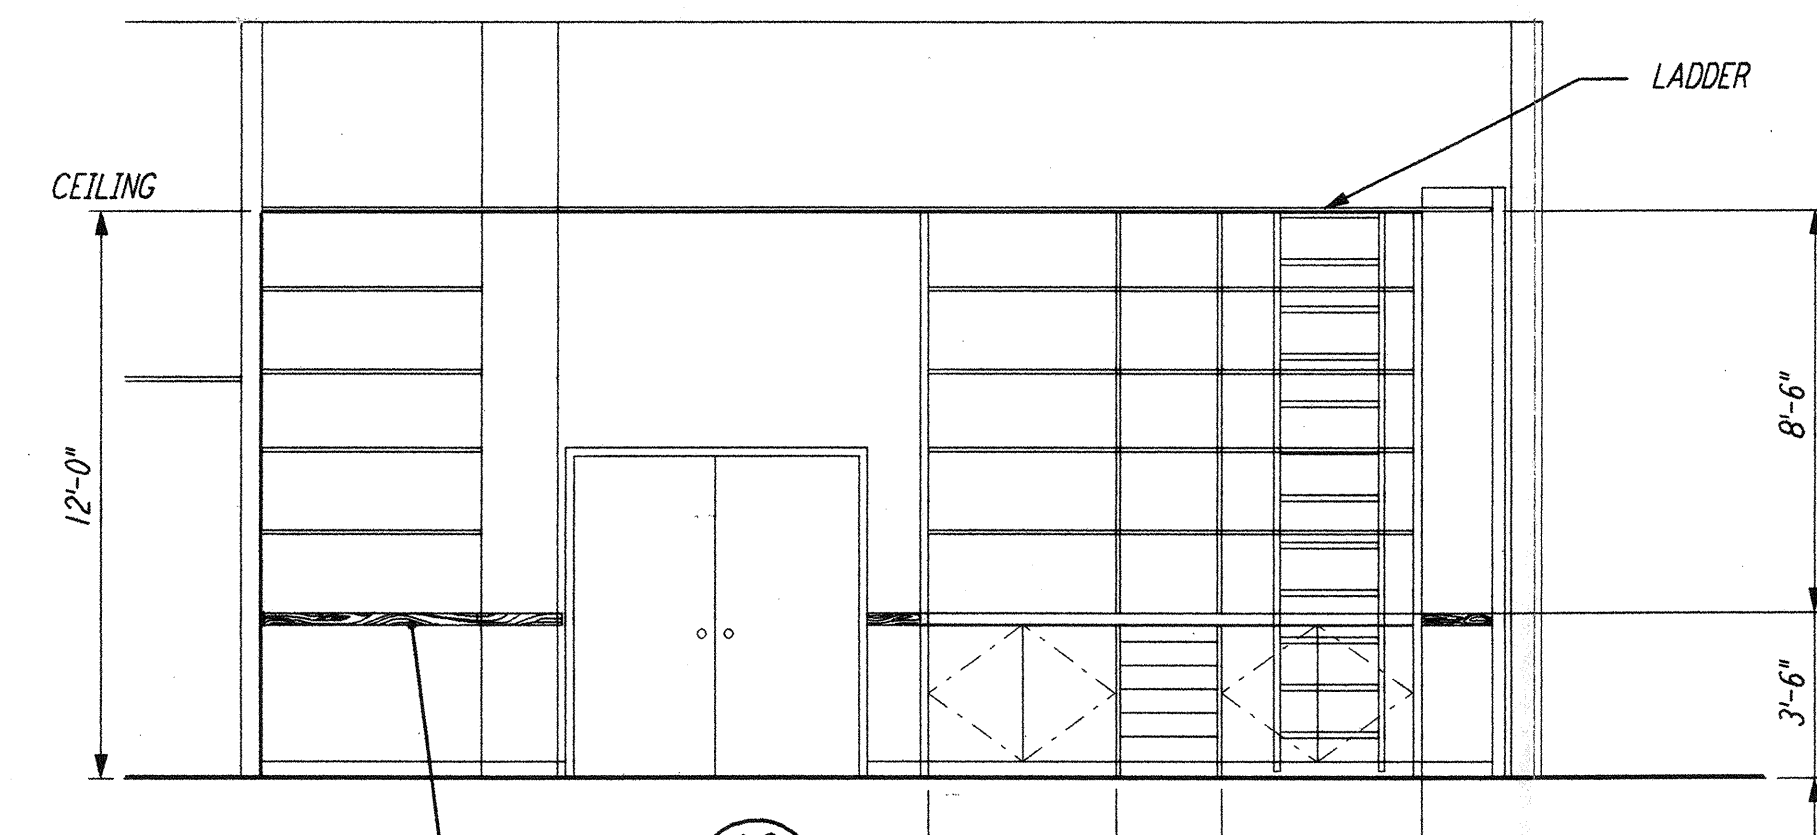

ELEVATION A


3 REF
 LA-A-111 LA-A-108

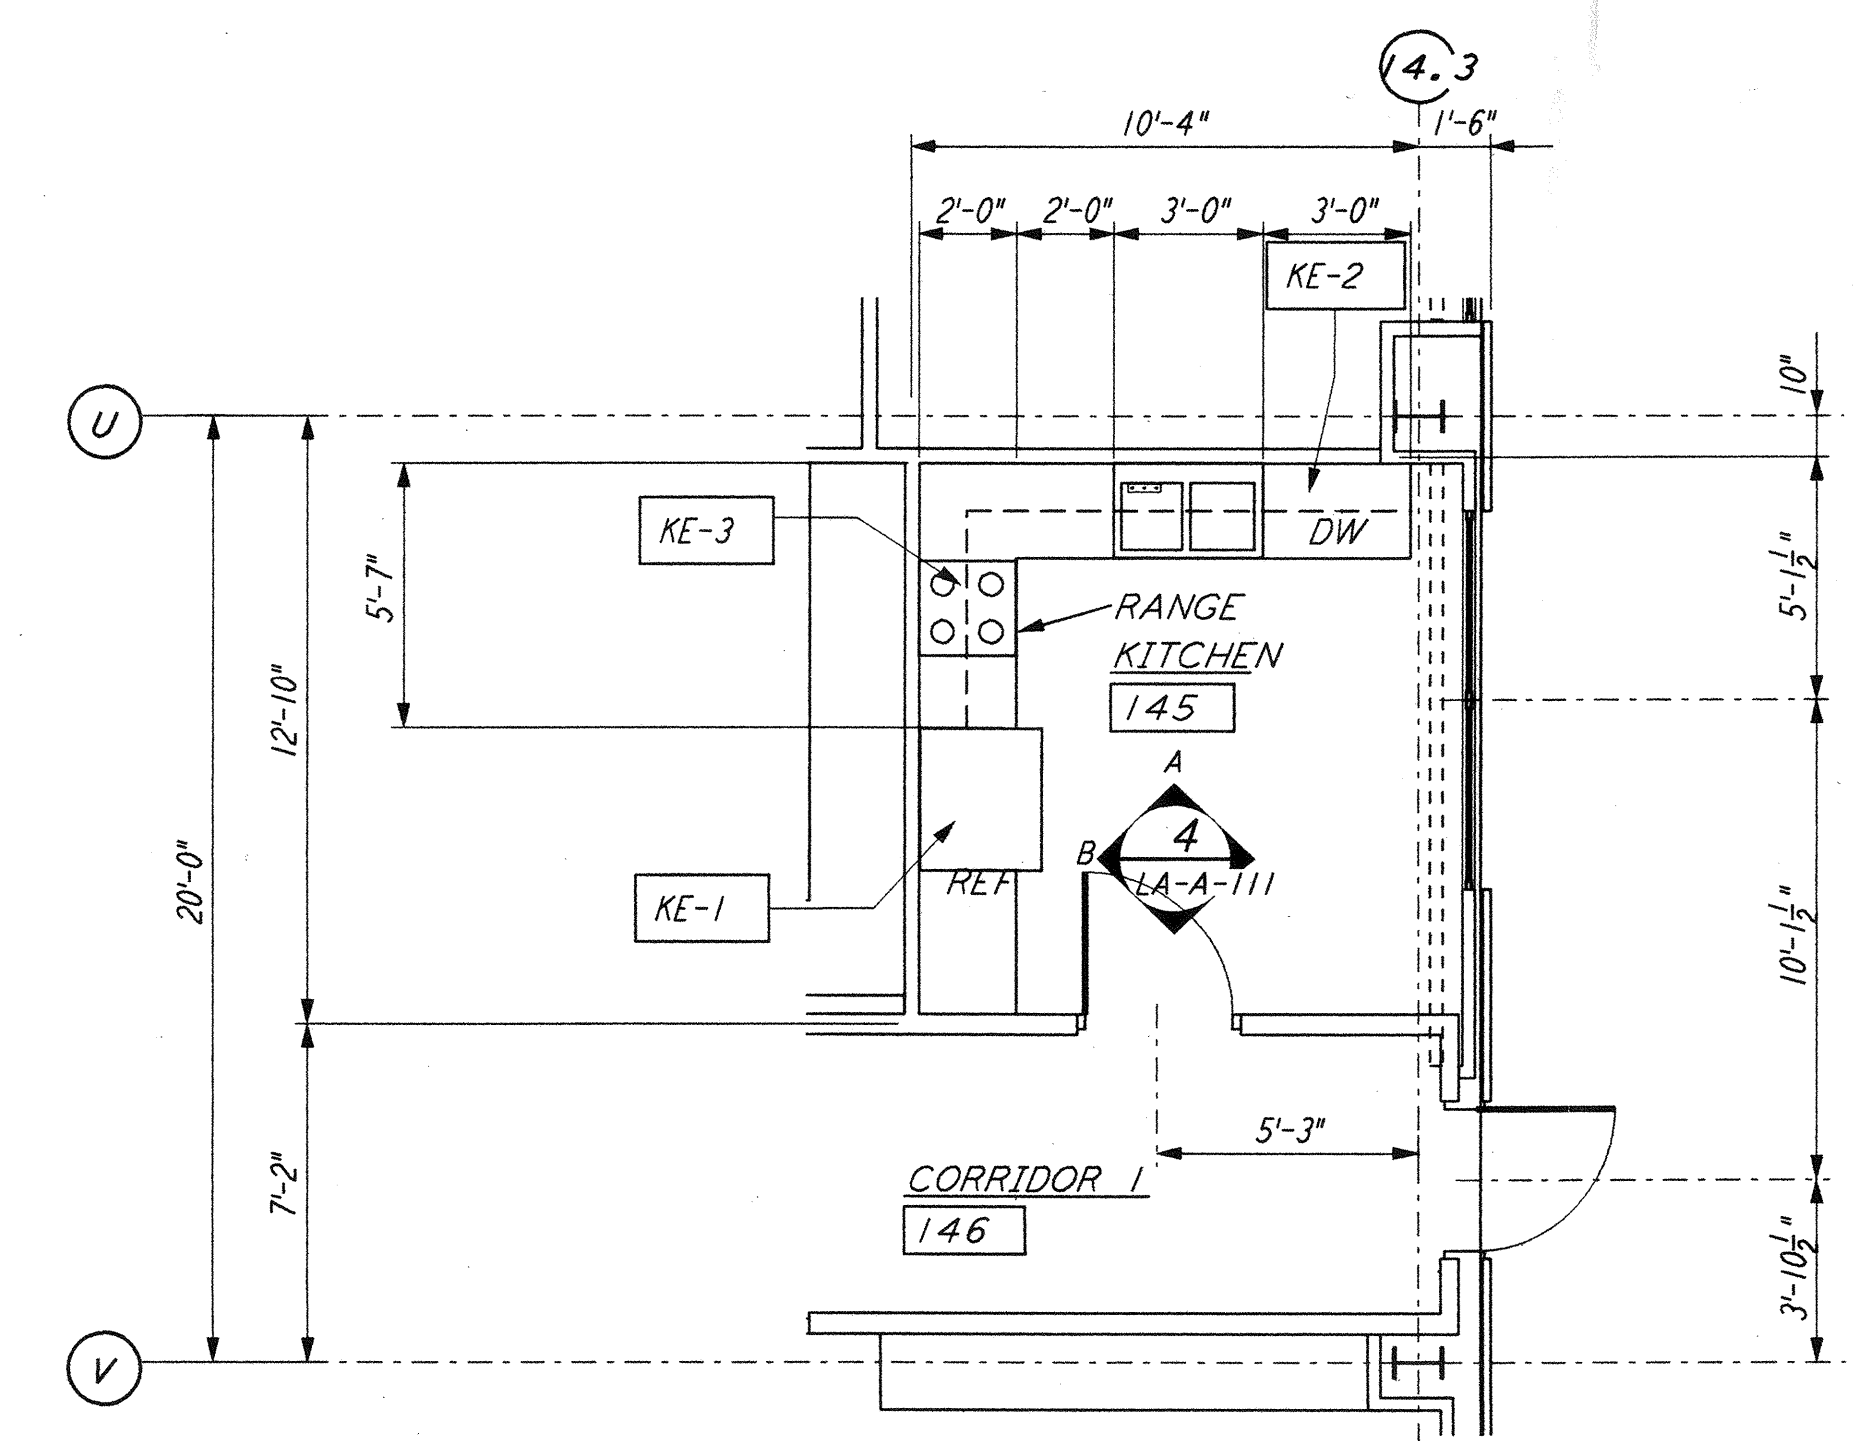


ENLARGED KITCHEN PLAN

KITCHEN PLAN 145
 $\frac{1}{4}'' = 1'-0''$


4 REF
 LA-A-111 LA-A-108

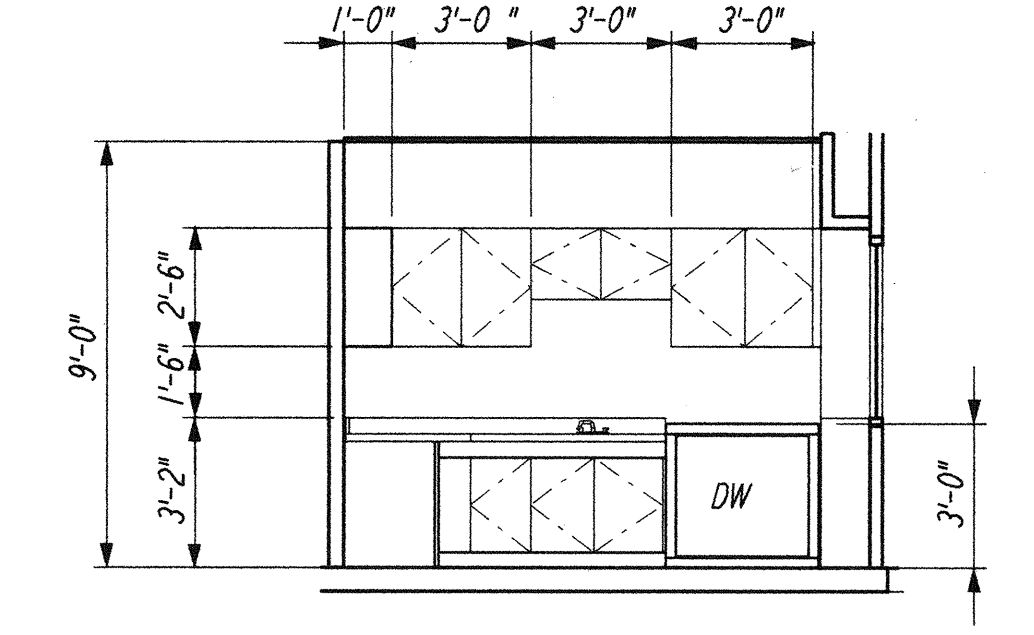

ELEVATION A

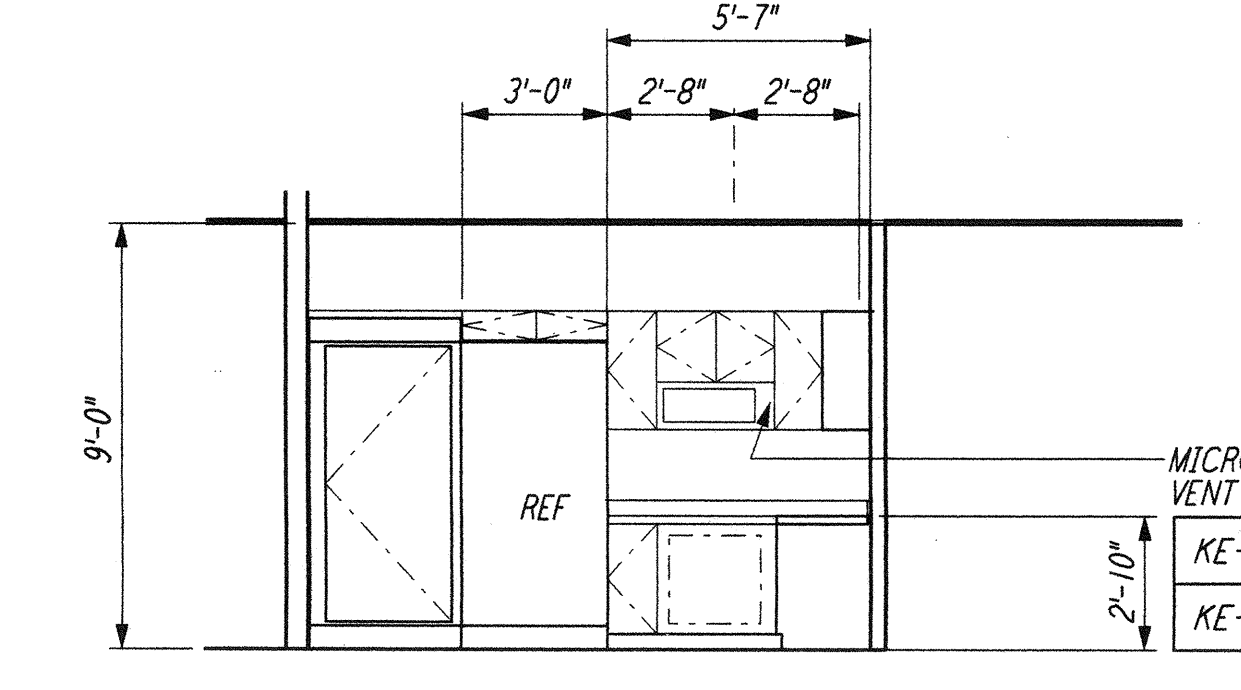

ELEVATION B

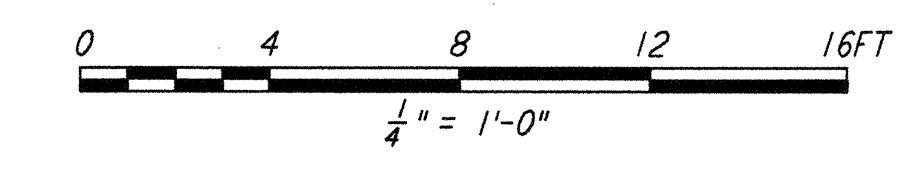

NO.	DATE	BY	CHKD	ENGR	PROJ	DESCRIPTION
2	08-07-98	SJM	CKT	AK	TDM	ISSUED FOR AS-BUILT OSB REVISION
1	2-28-97	CKT	TB	AK	TDM	ISSUED FOR CONSTRUCTION

ISSUED FOR CONSTRUCTION
 DRAWN CKT 11-15-96
 CHECKED TB 11-15-96
 ENGINEER SF 11-15-96
 PROJ MDW 11-15-96

AS-BUILT DRAWINGS

PARSONS
 100 WEST WALNUT STREET
 PASADENA, CALIFORNIA

LIGO
 CALIFORNIA INSTITUTE OF TECHNOLOGY
 MASSACHUSETTS INSTITUTE OF TECHNOLOGY

LIGO-D960876-02-0
 LASER INTERFEROMETER
 GRAVITATIONAL-WAVE OBSERVATORY
 SITE NO. 2 - LIVINGSTON, LOUISIANA

ARCHITECTURAL CORNER STATION OSB ENLARGED PLANS
LA-A-111

SCALE: AS NOTED
 CONTRACT NUMBER: PPI50969
 PROJECT NUMBER: 8094