

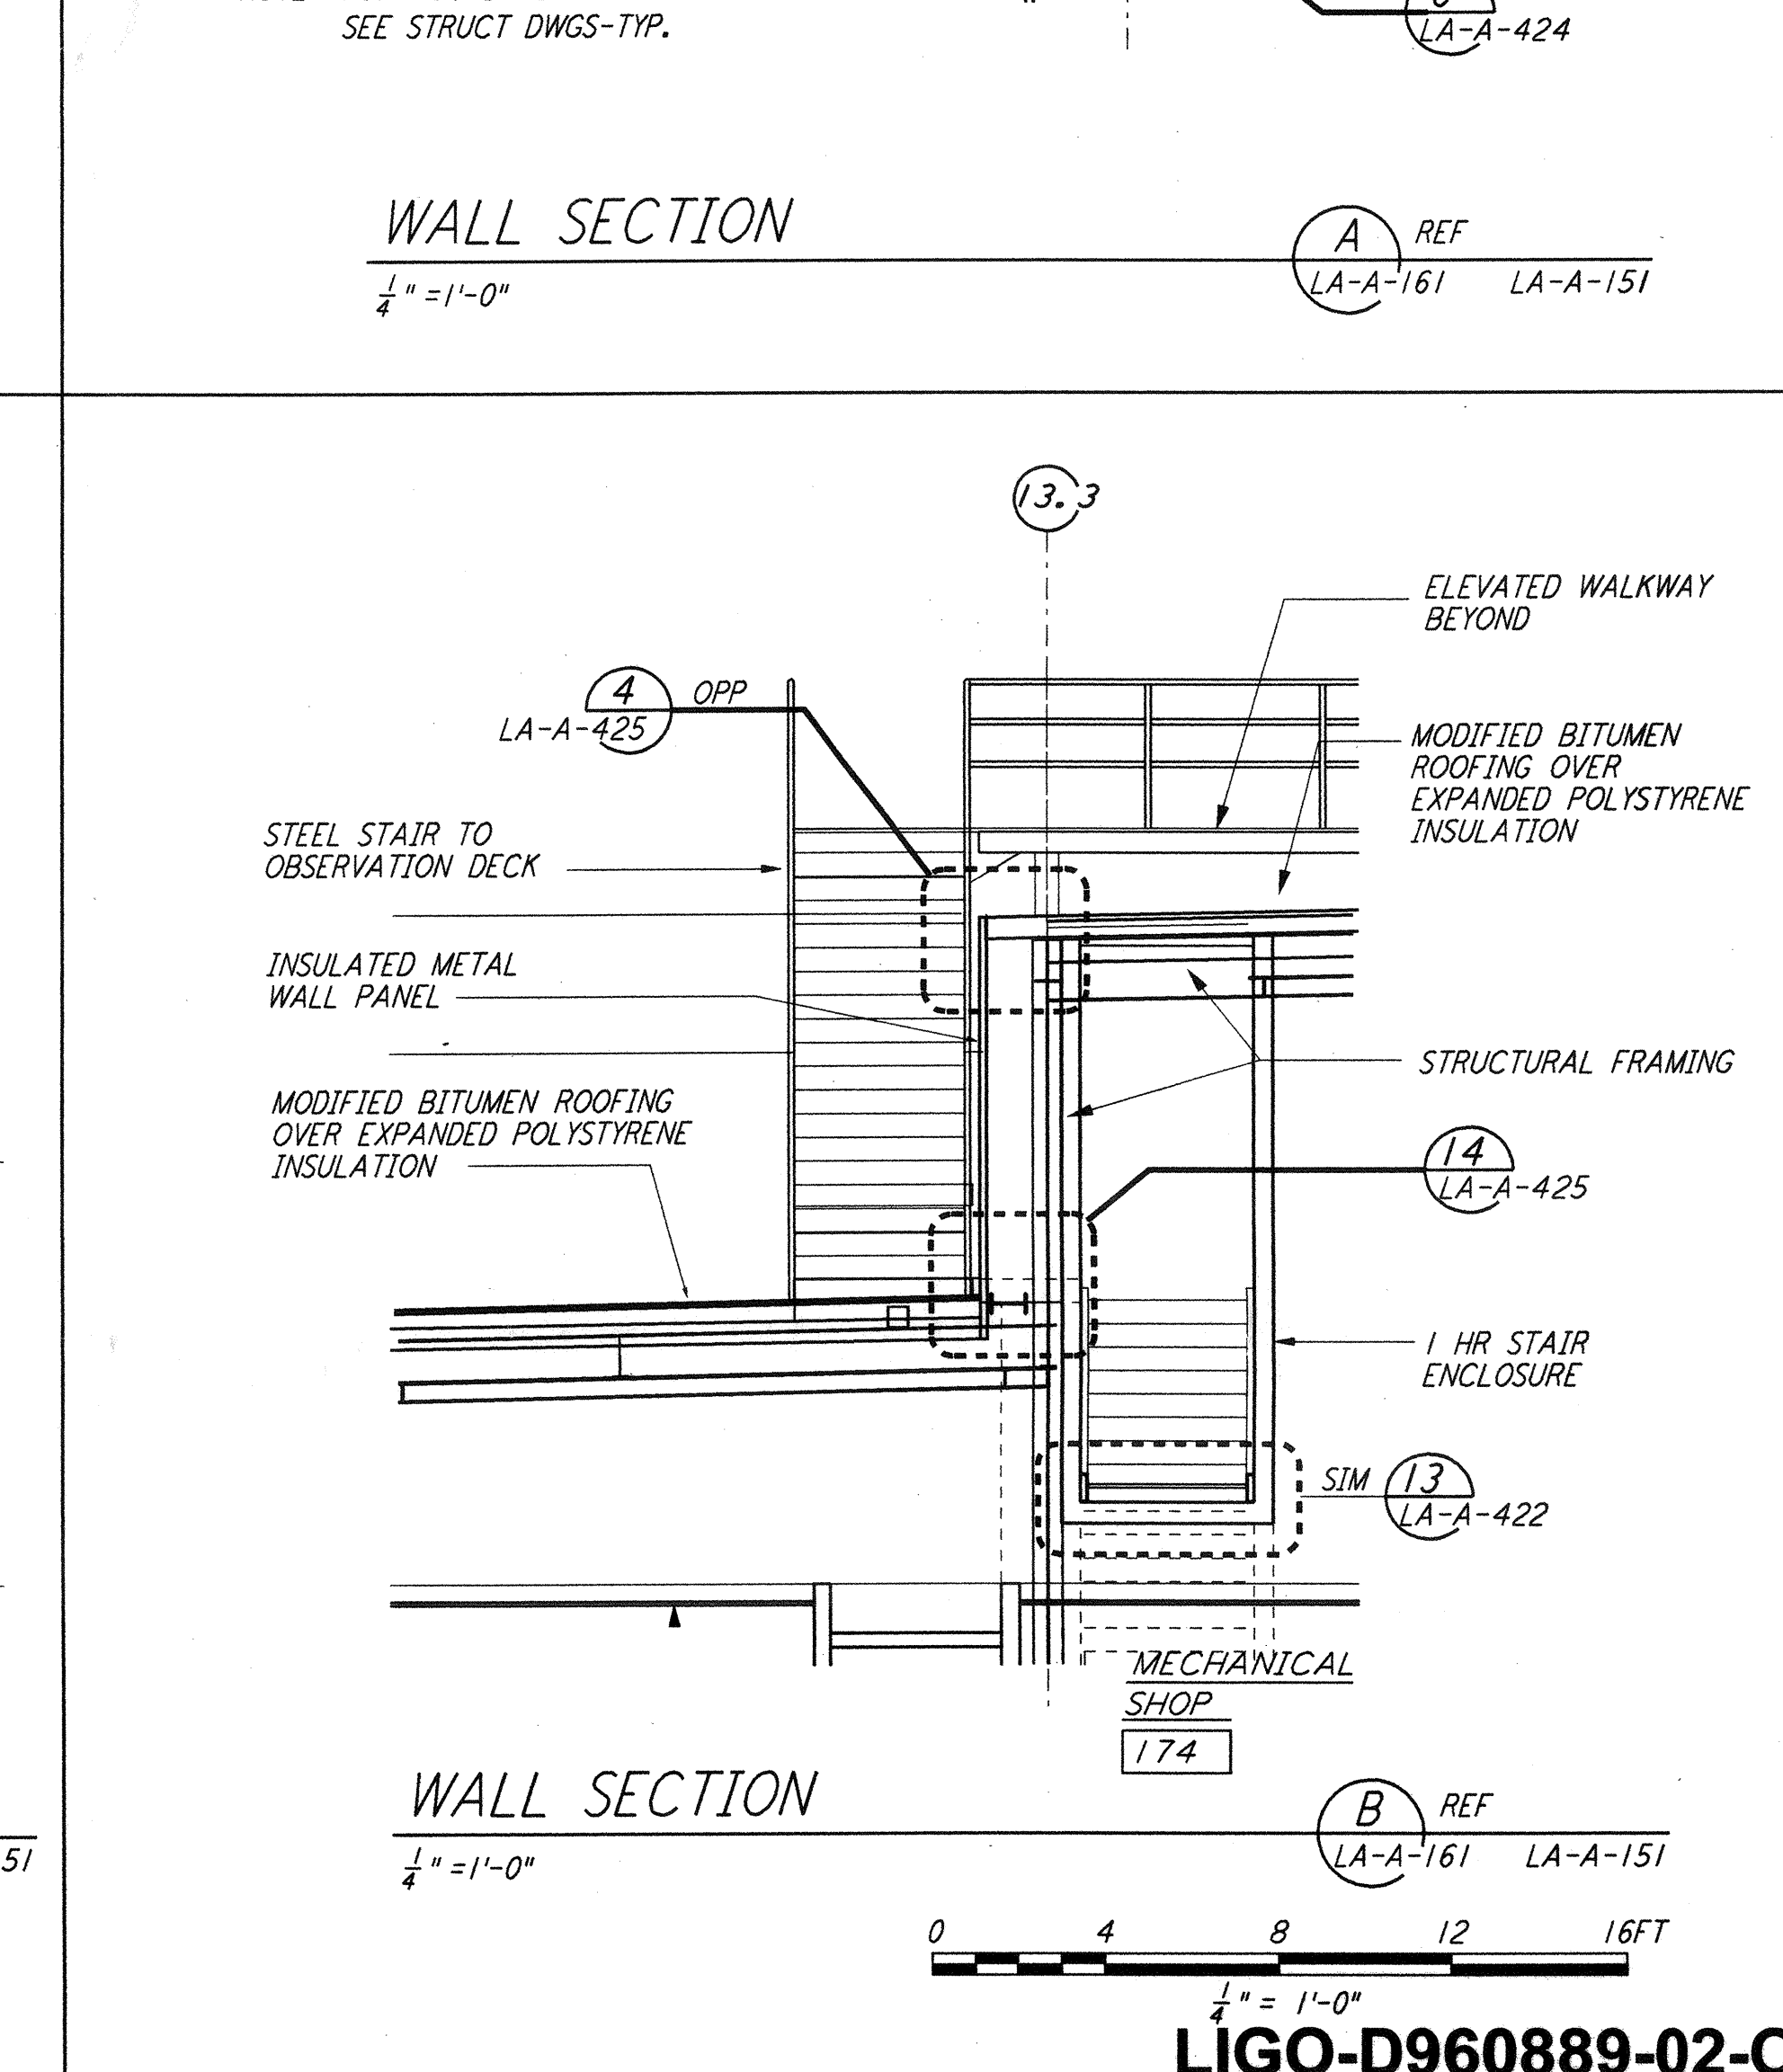
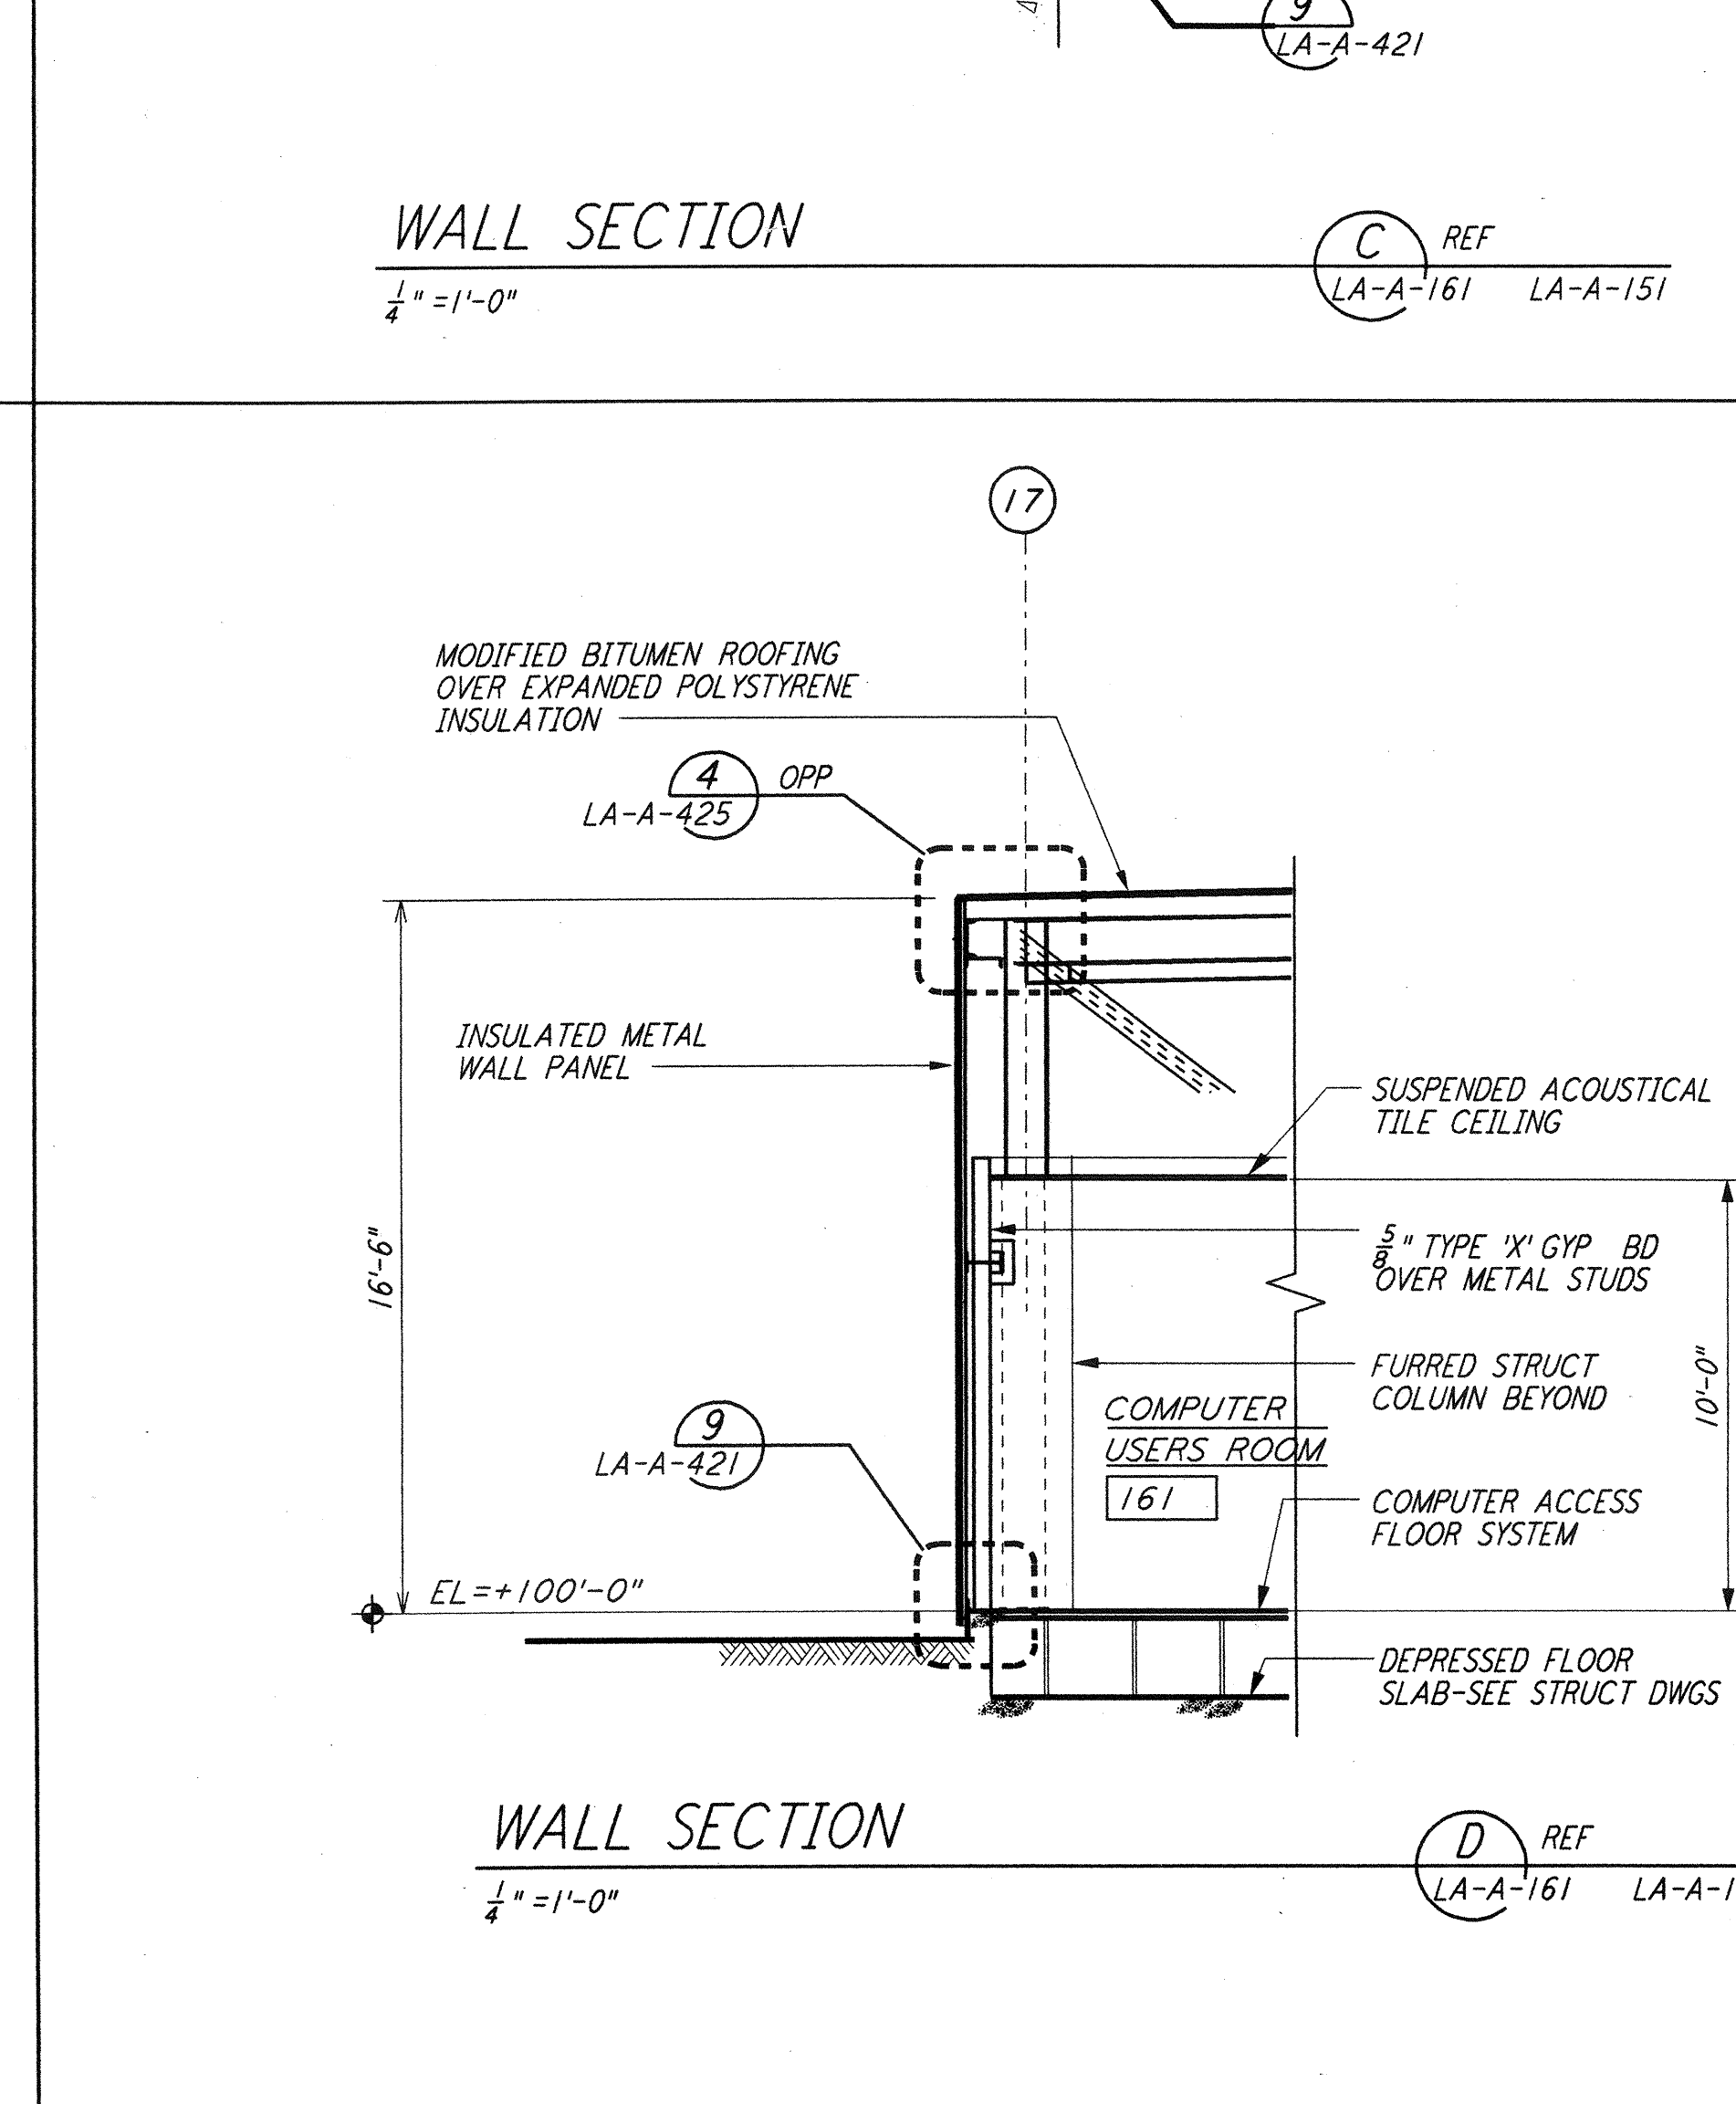
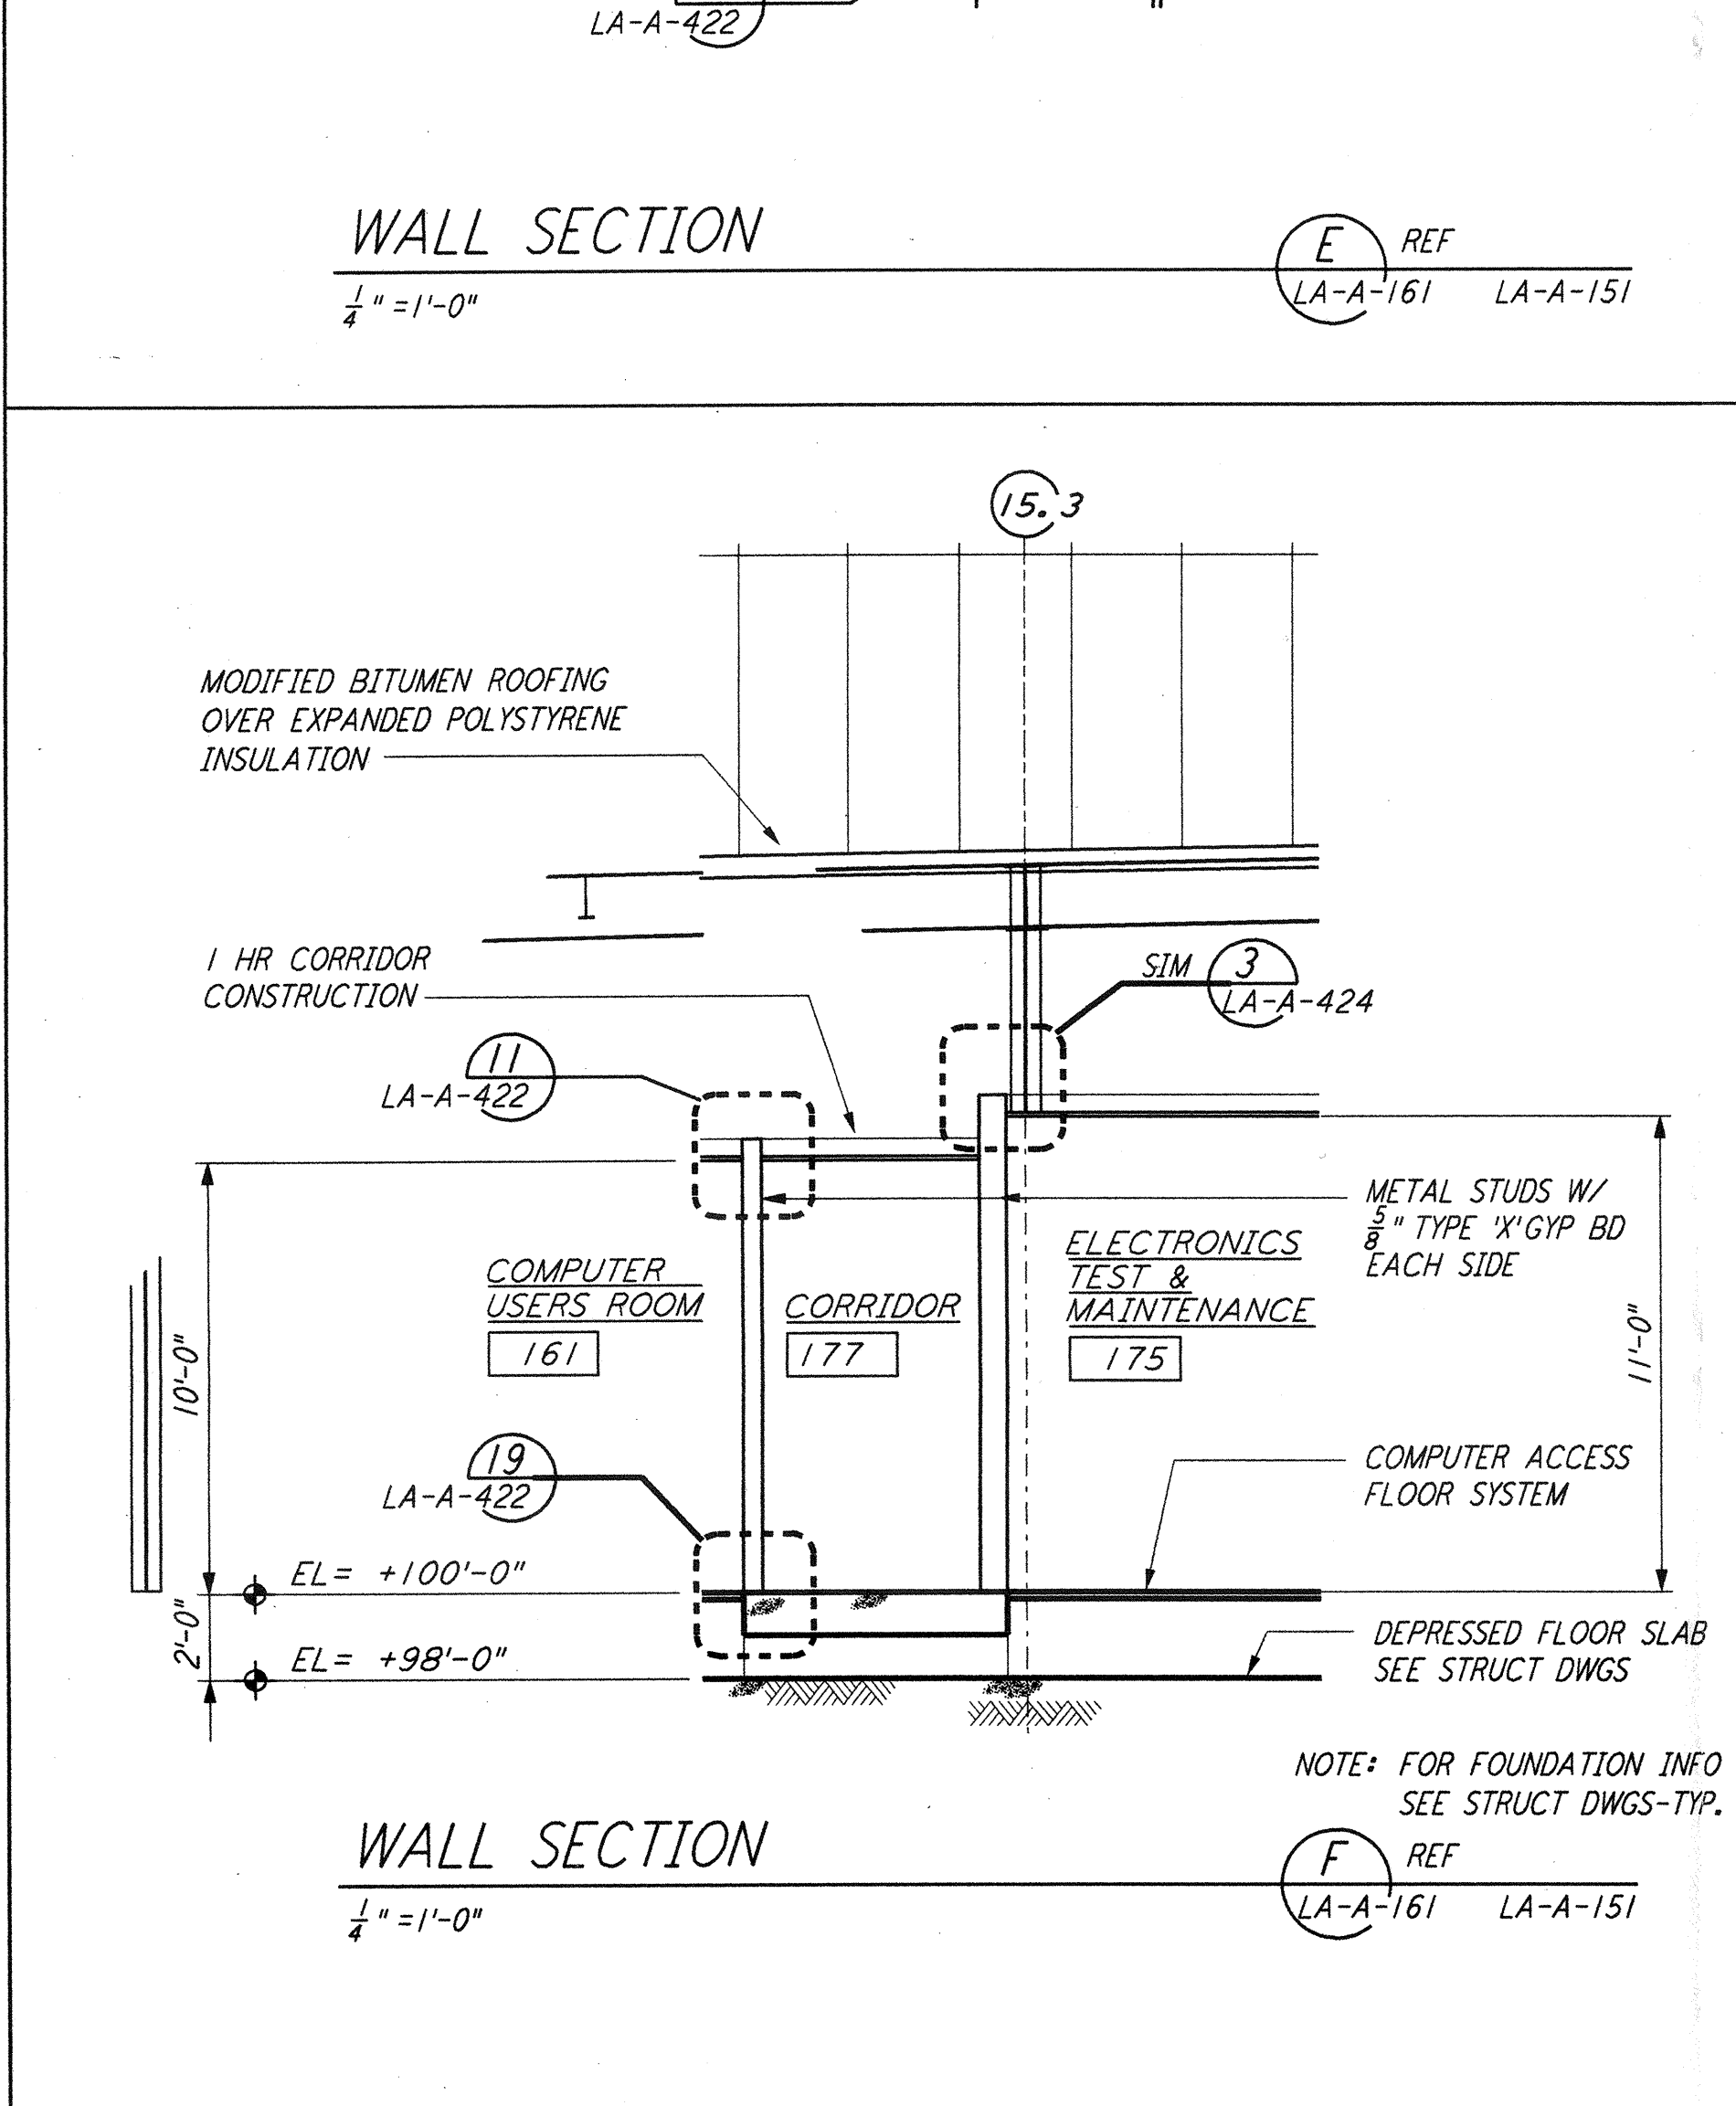
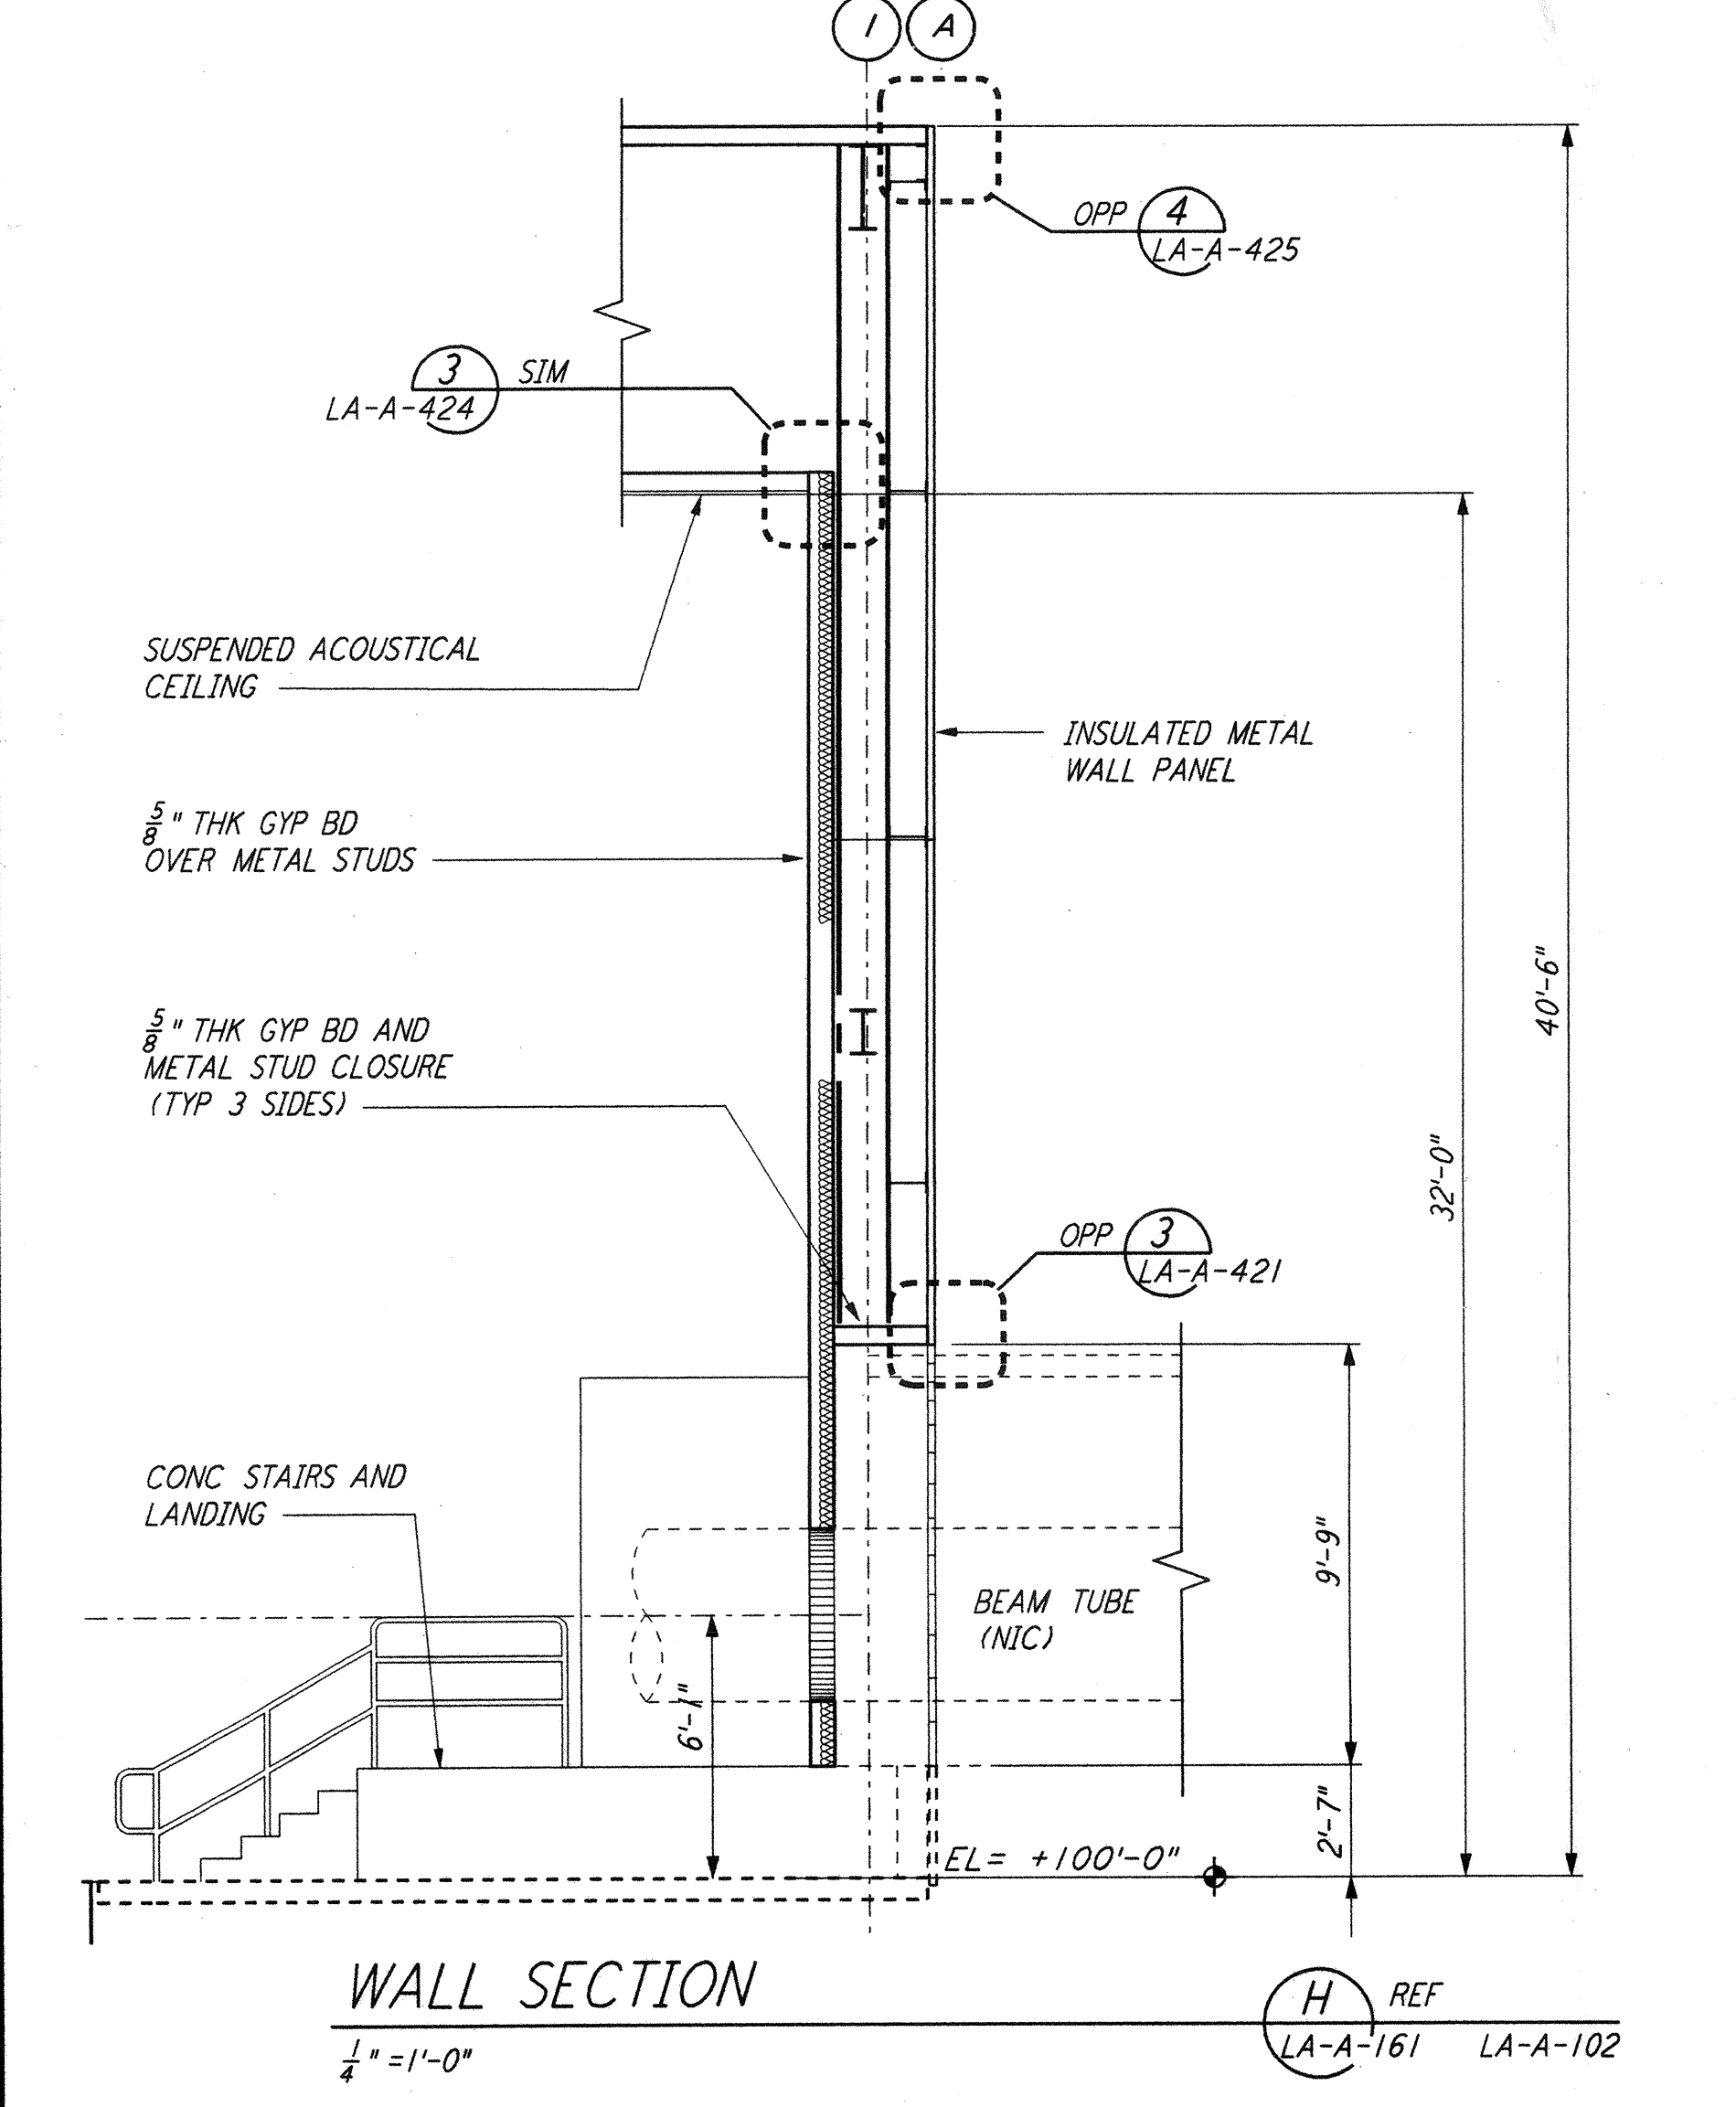
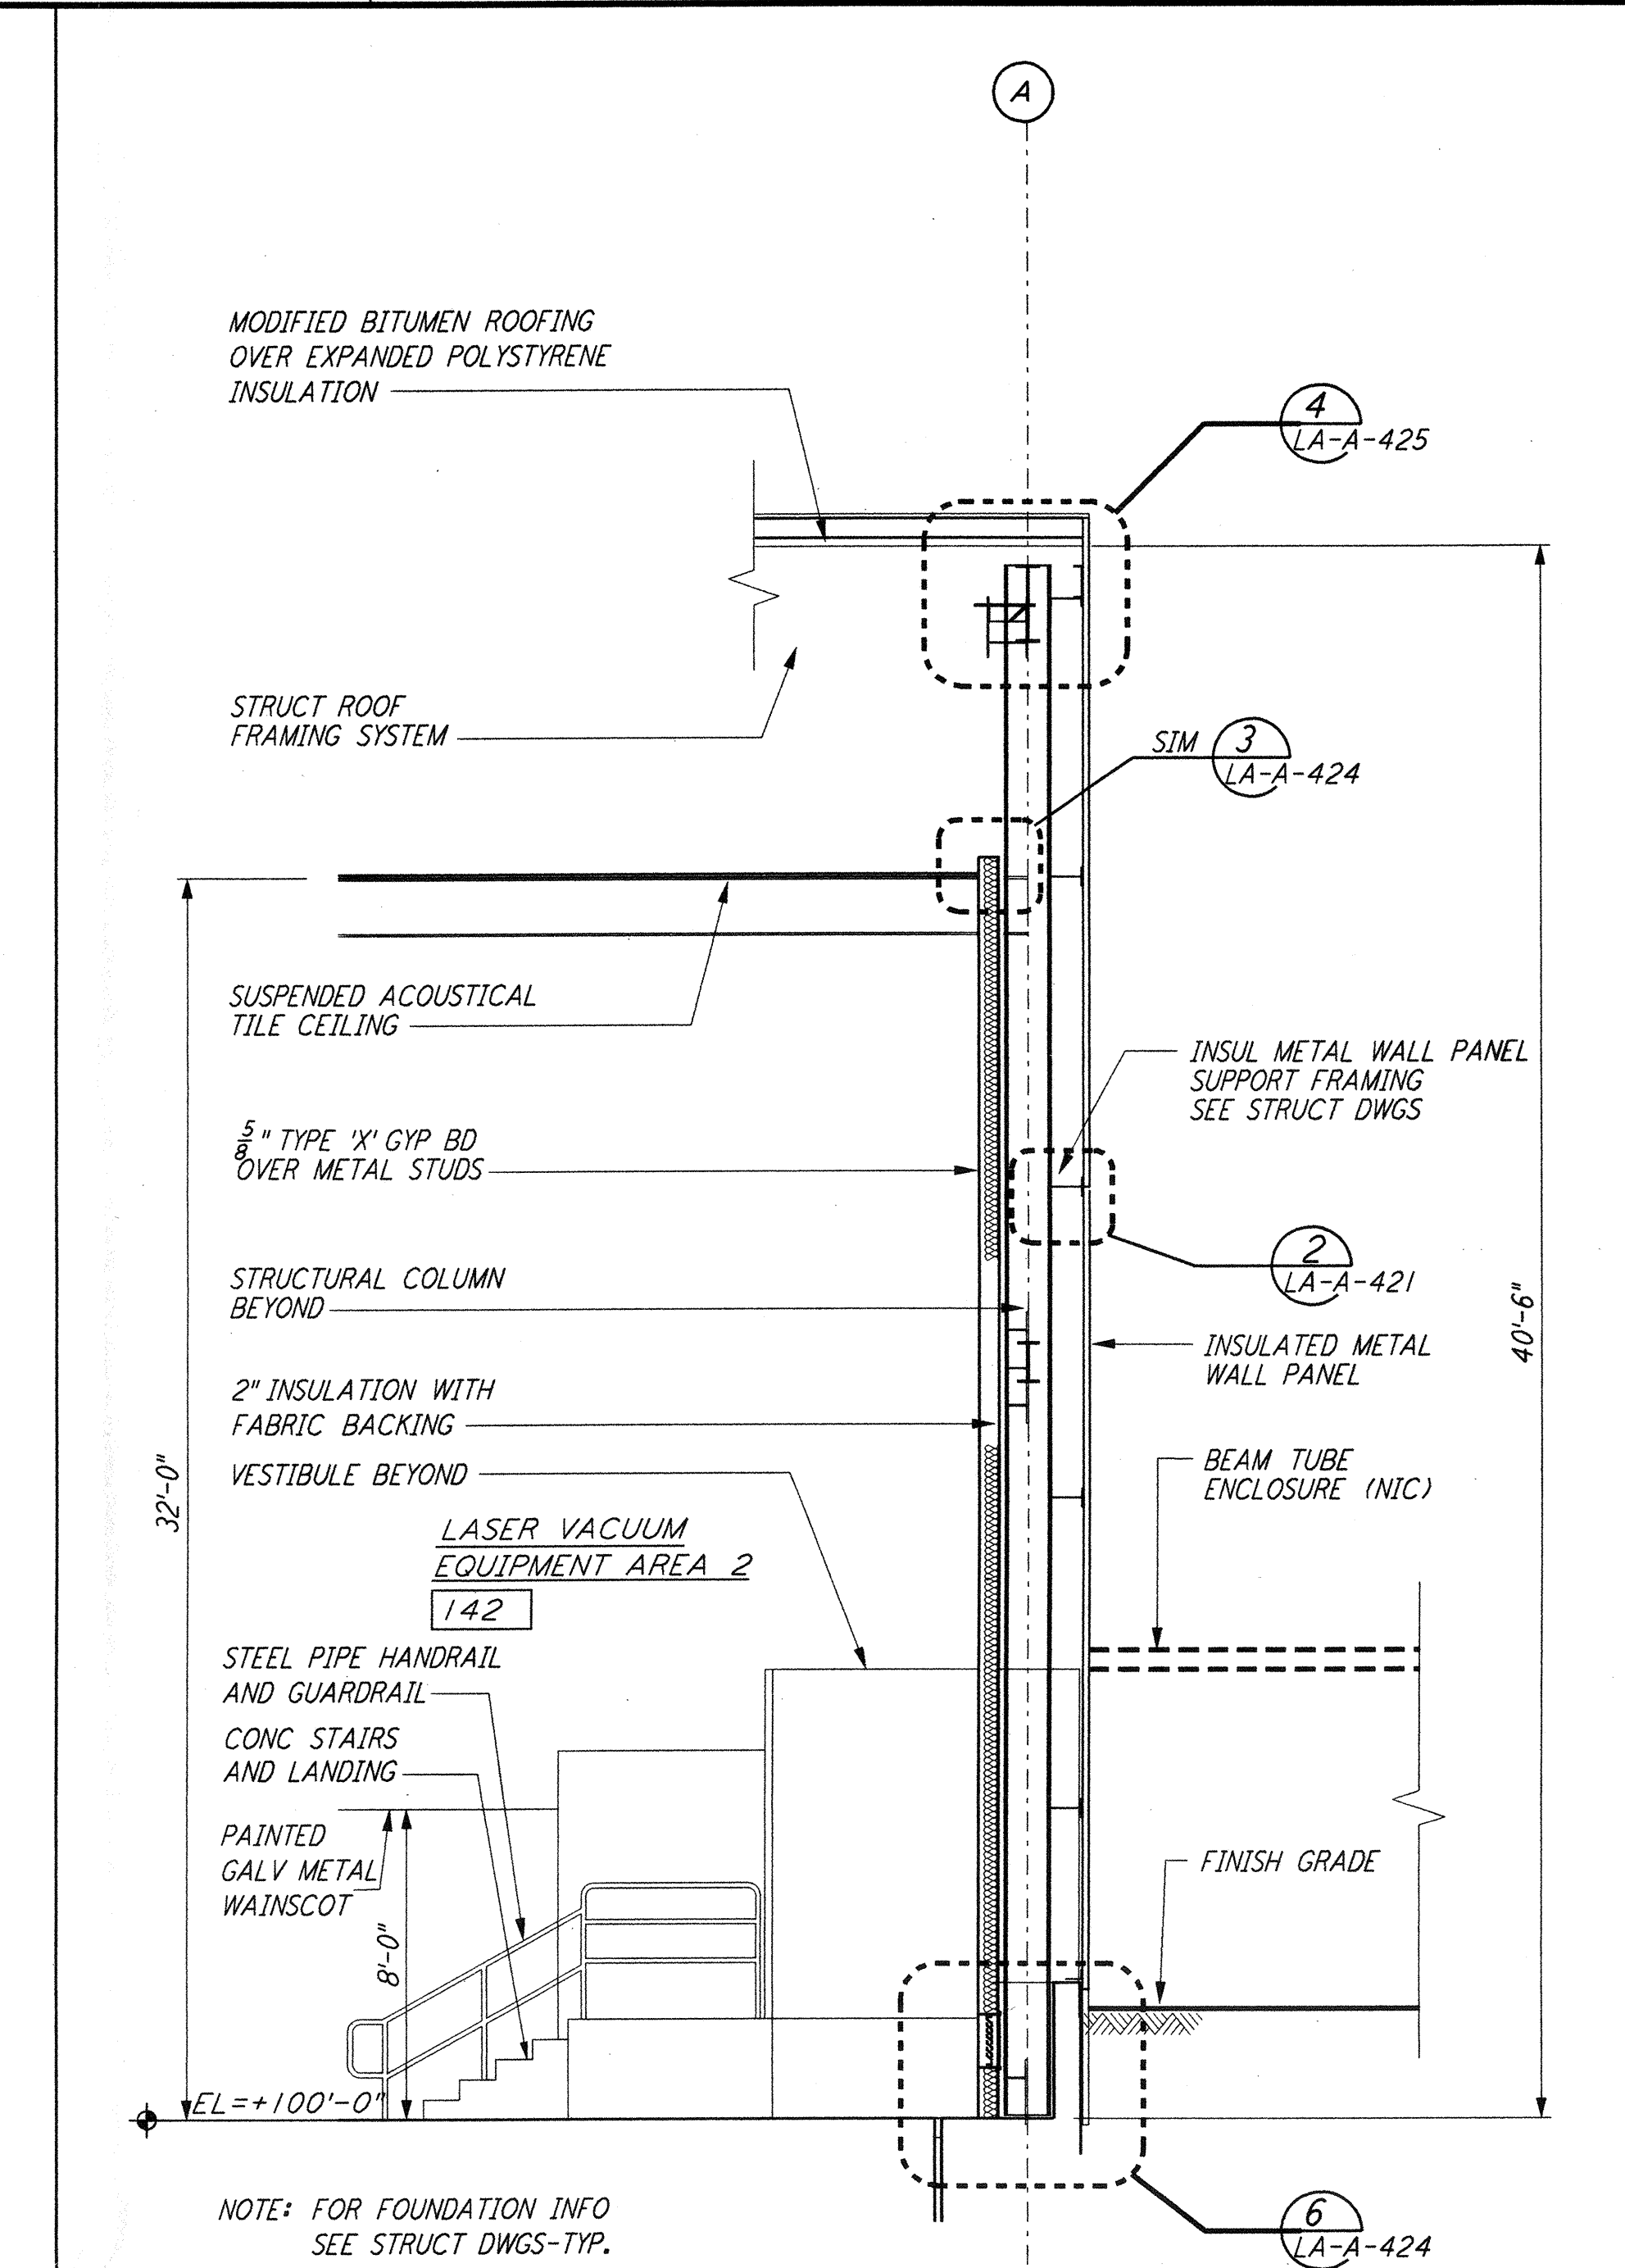
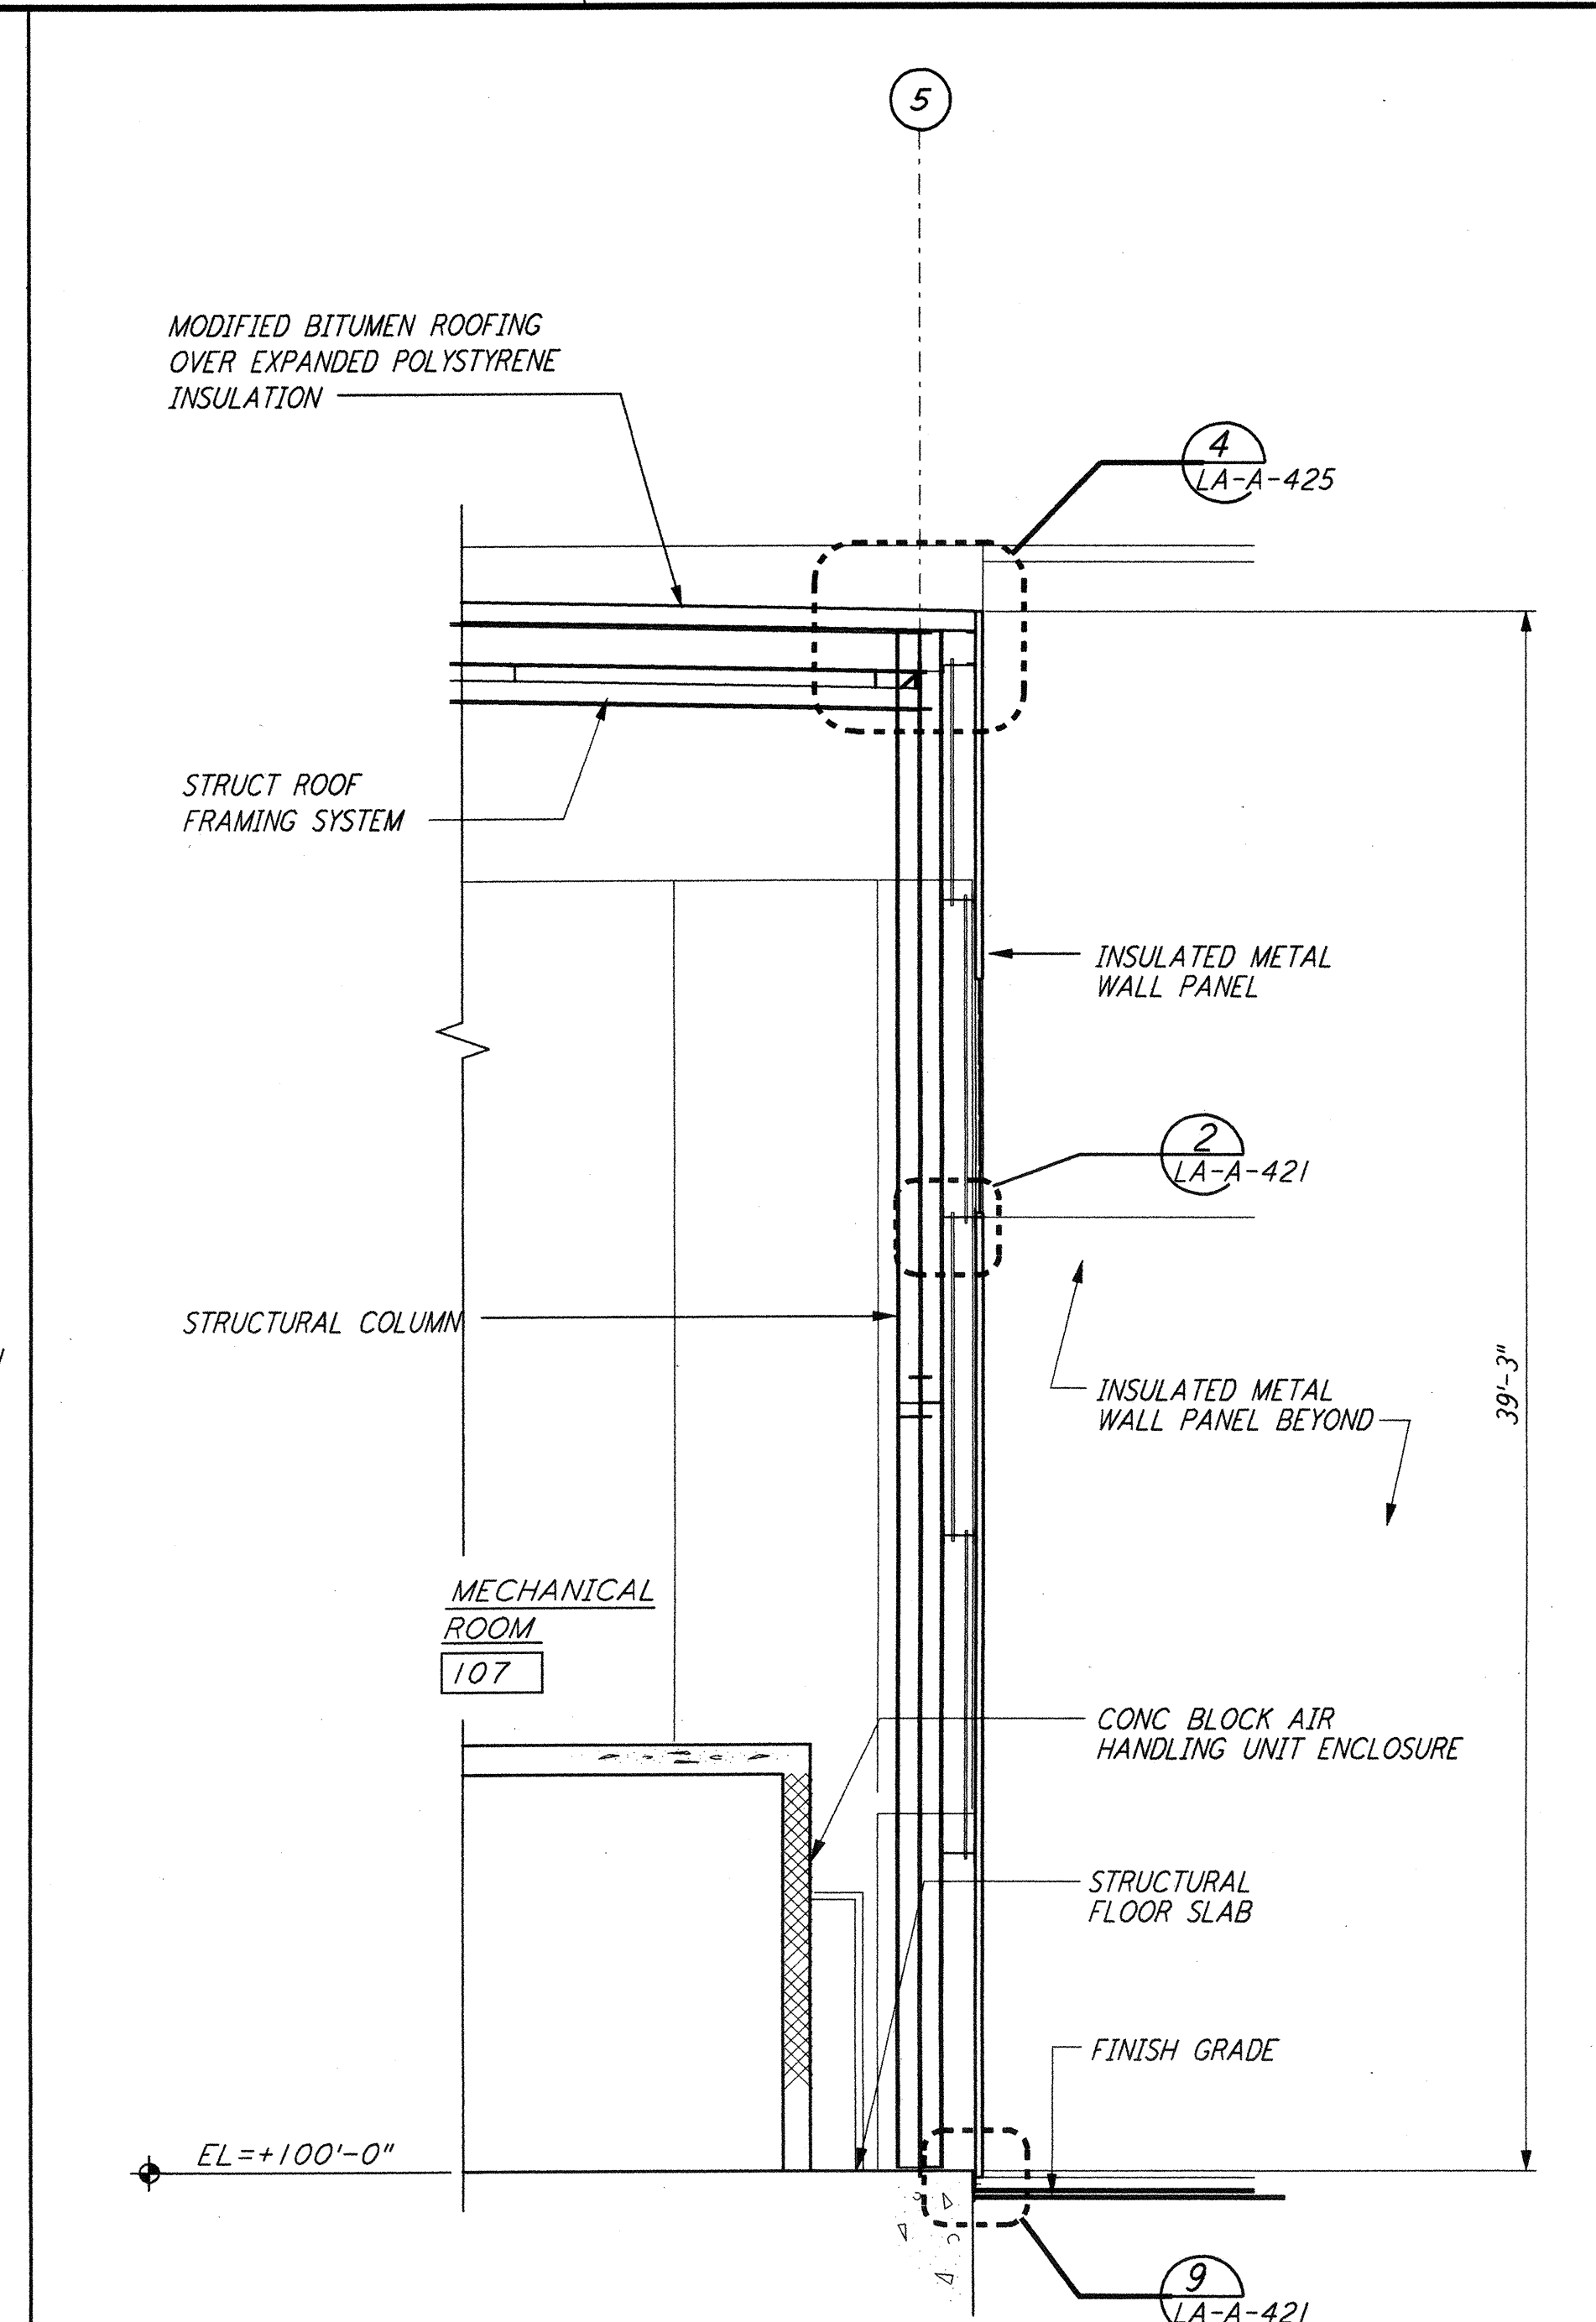
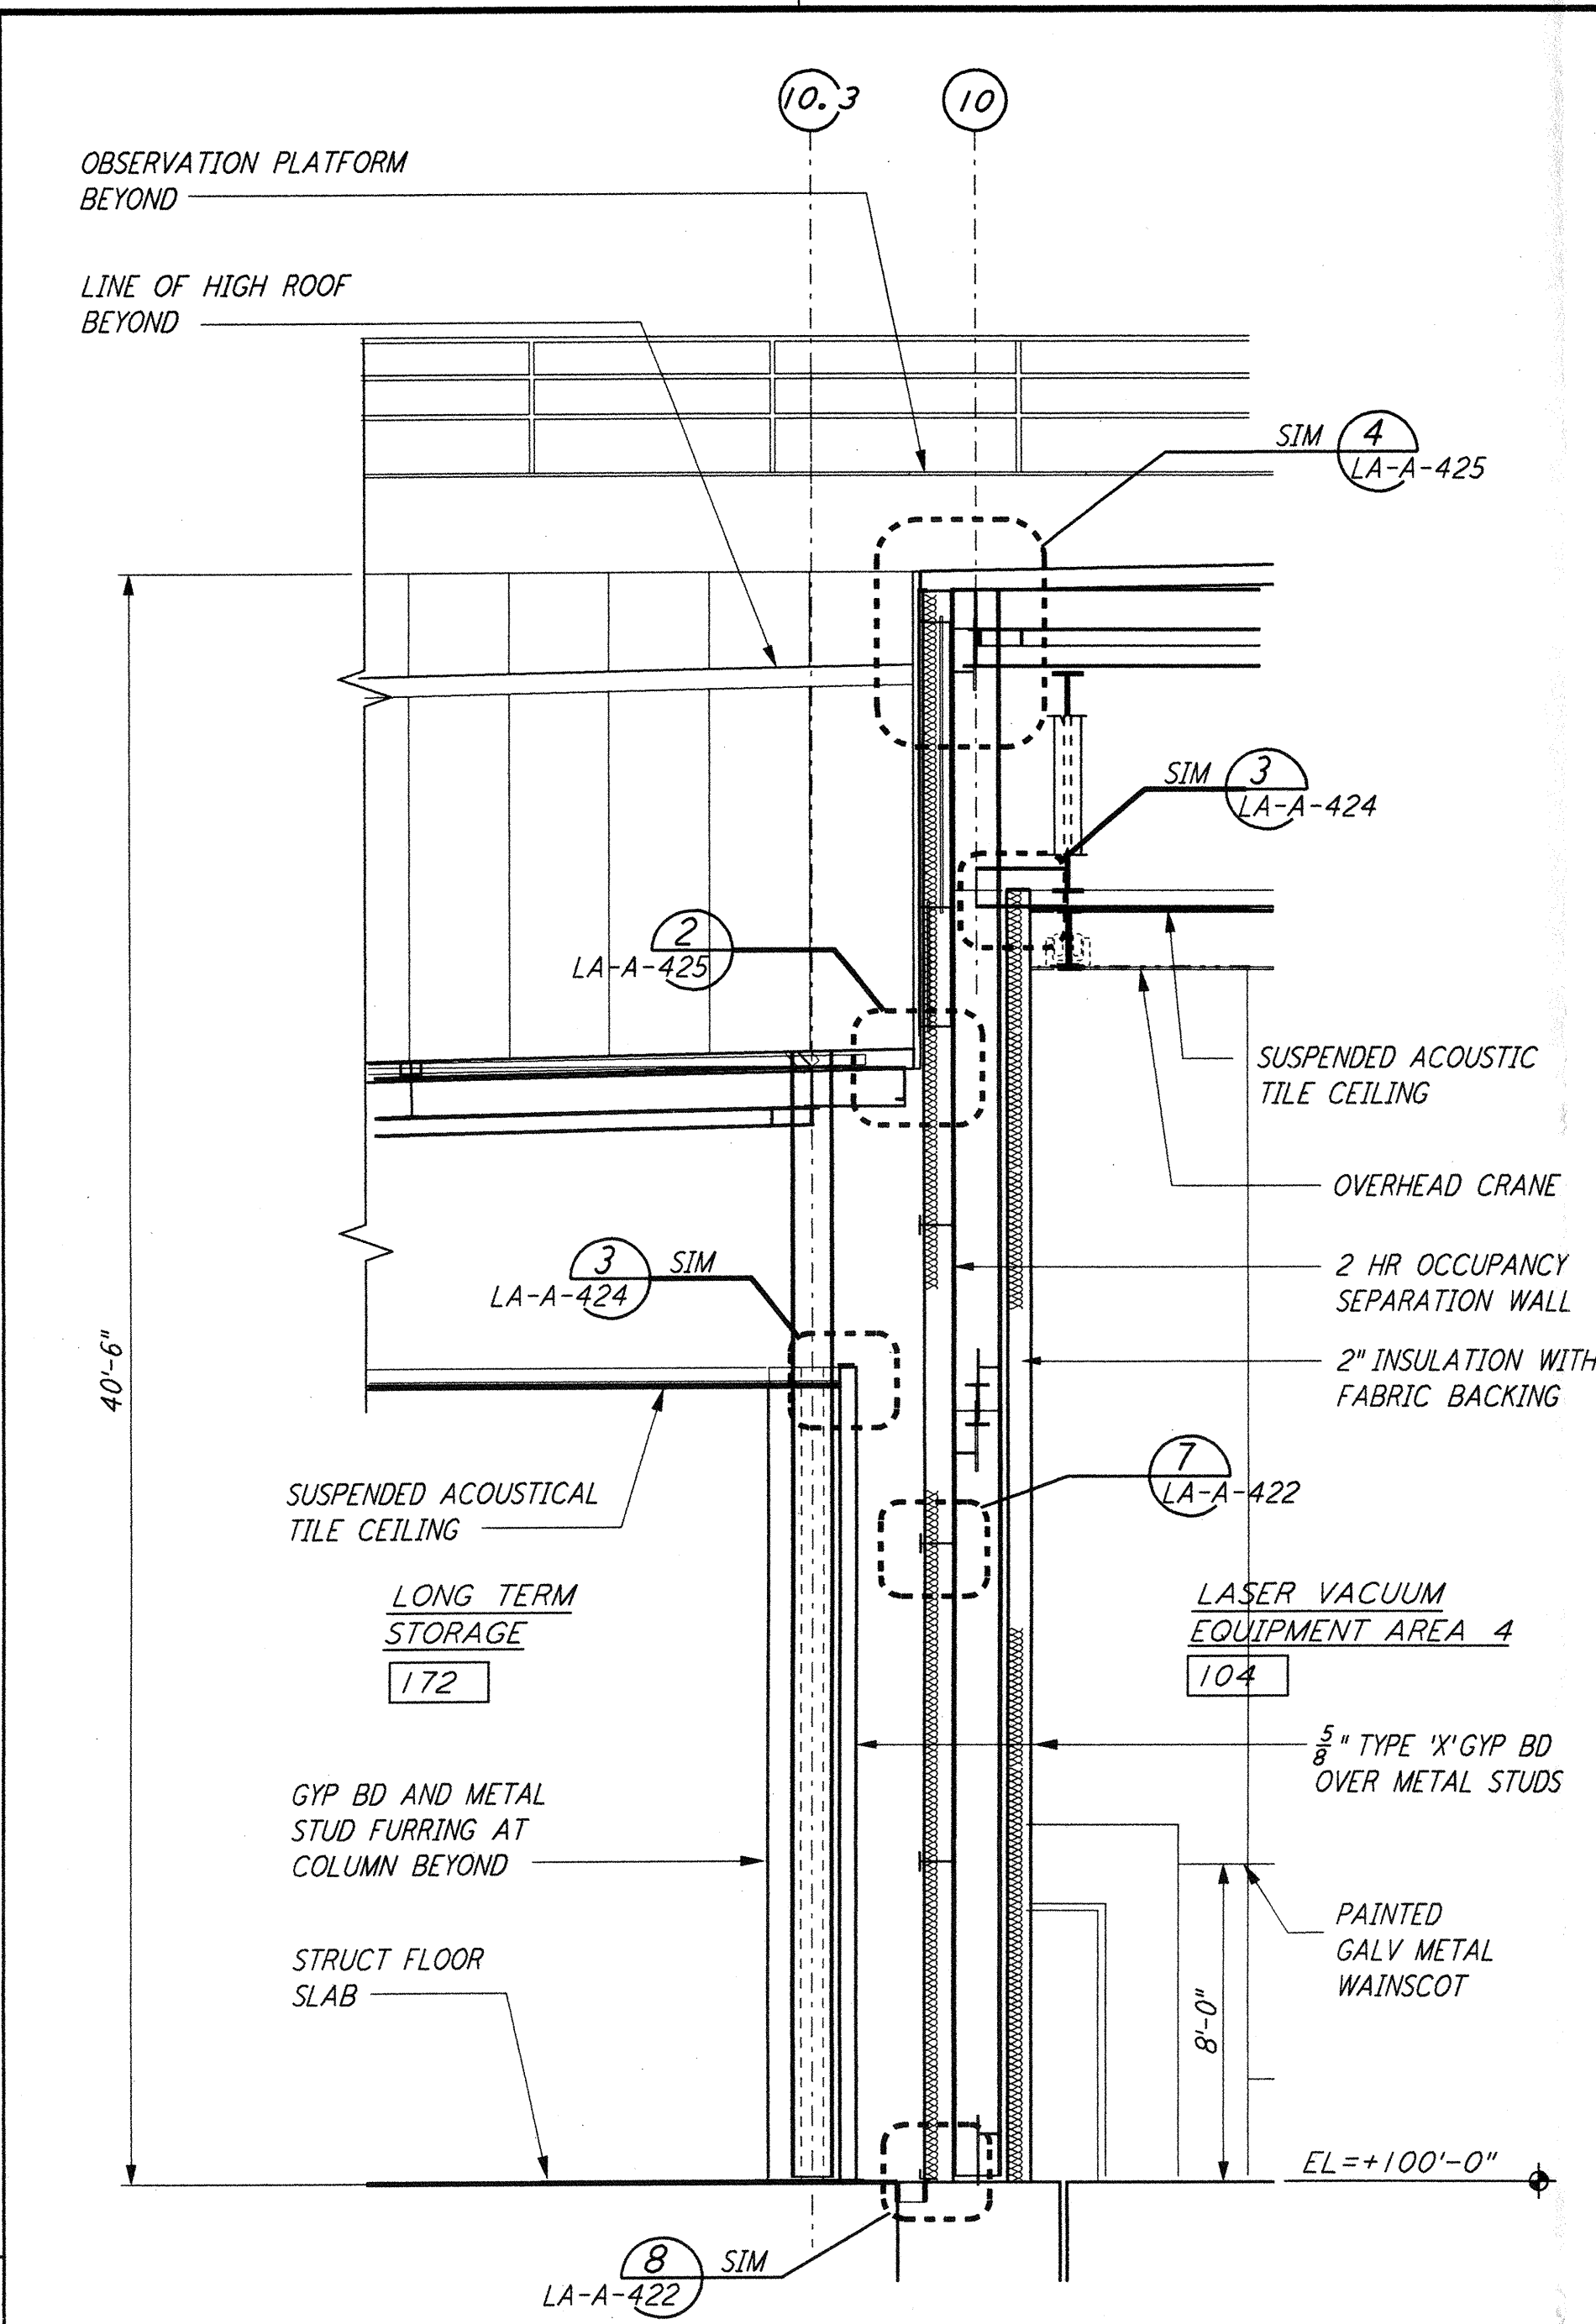


This document and the design it covers are the property of PARSONS. They are loaned only with the borrower's expressed written agreement that they will not be reproduced, copied, loaned, exhibited, or used in any other way, except by written consent from PARSONS to the borrower.

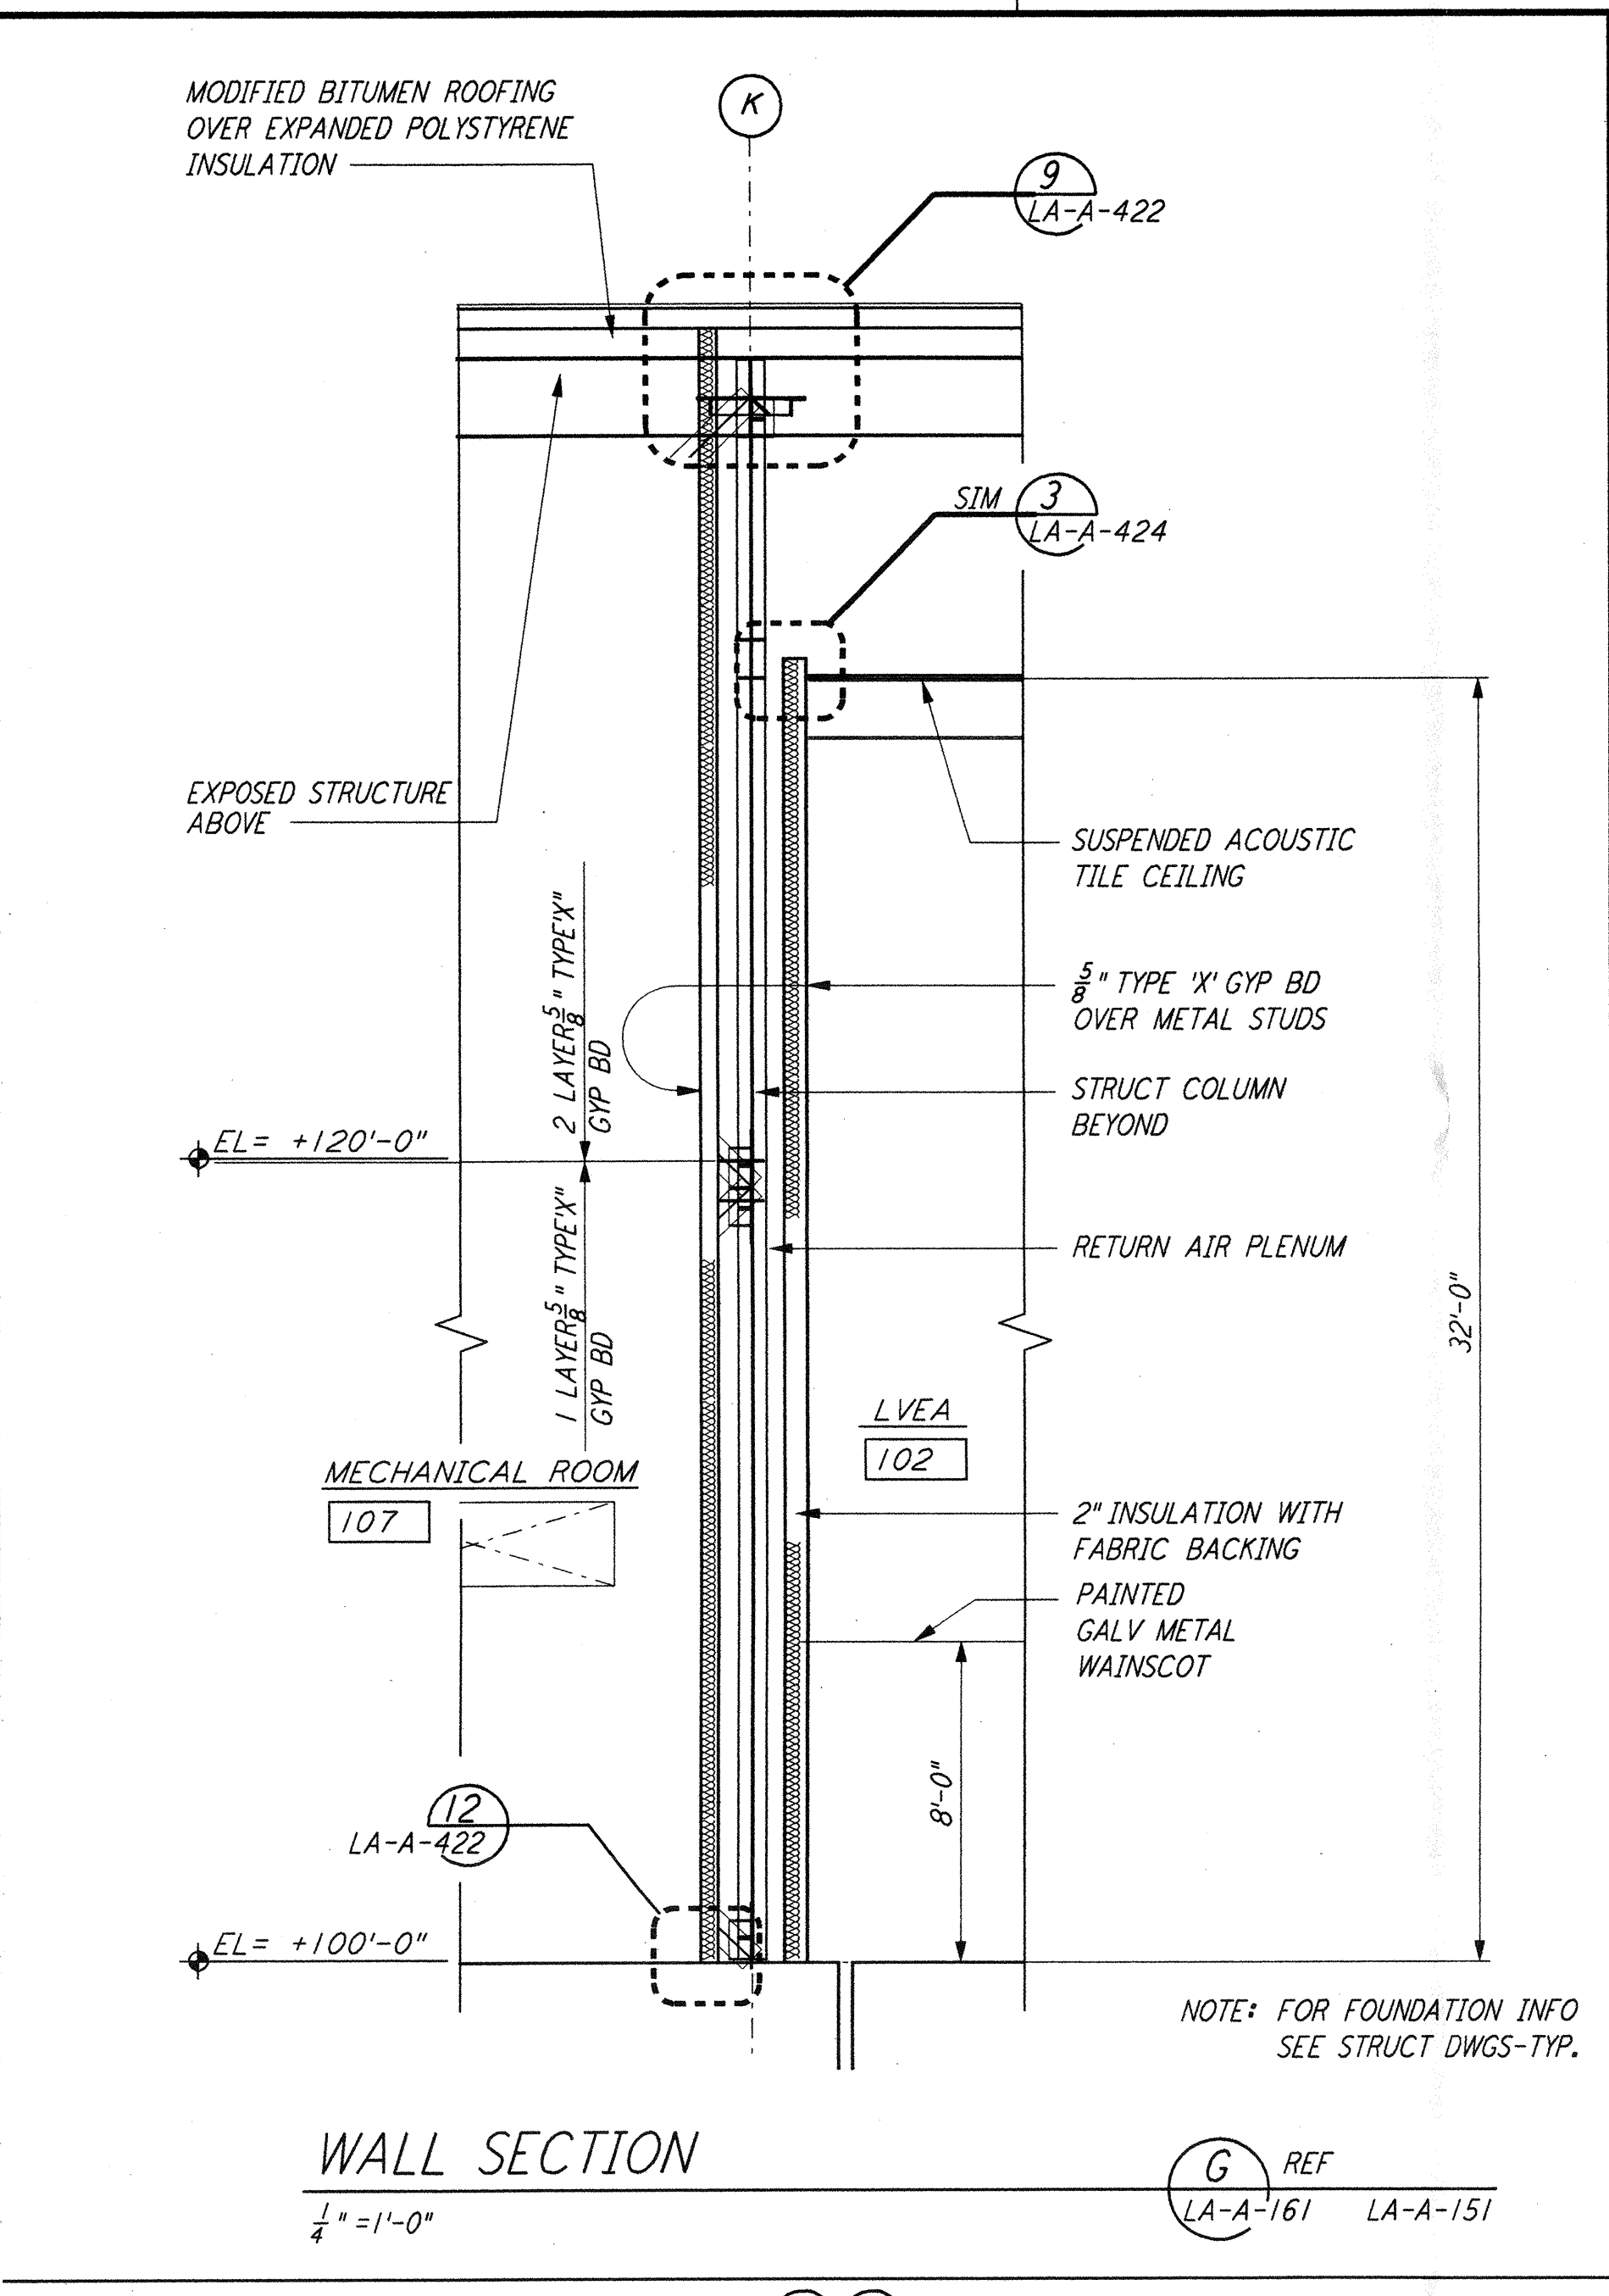

NO.	DATE	BY	CHKD	ENGR	PROJ	DESCRIPTION
1	2-28-97	CKT	TB	AK	TDM	ISSUED FOR AS-BUILT CORNER STATION VSEA PARTITION
2	08-07-98	SJM	CT	AK	TDM	ISSUED FOR CONSTRUCTION

ISSUED FOR CONSTRUCTION
 DRAWN: CKT 11-15-96
 CHECKED: TB 11-15-96
 ENGINEER: SF 11-15-96
 PROJ: MDW 11-15-96
AS-BUILT DRAWINGS

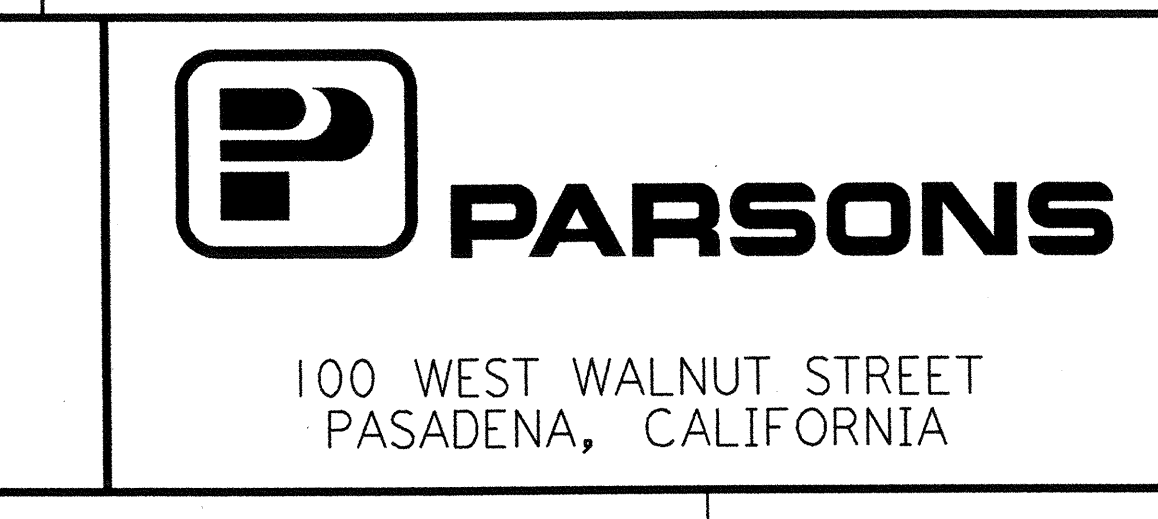

LIGO-D960889-02-0
 LASER INTERFEROMETER GRAVITATIONAL-WAVE OBSERVATORY SITE NO. 2 - LIVINGSTON, LOUISIANA
 ARCHITECTURAL CORNER STATION WALL SECTIONS SHEET 1
 CONTRACT NUMBER: PPI 50969
 PROJECT NUMBER: 8094
LA-A-161