




This document and the design it covers are the property of PARSONS. They are loaned only with the borrower's expressed written agreement that they will not be reproduced, copied, loaned, exhibited, or used in any other way, except by written consent from PARSONS to the borrower.

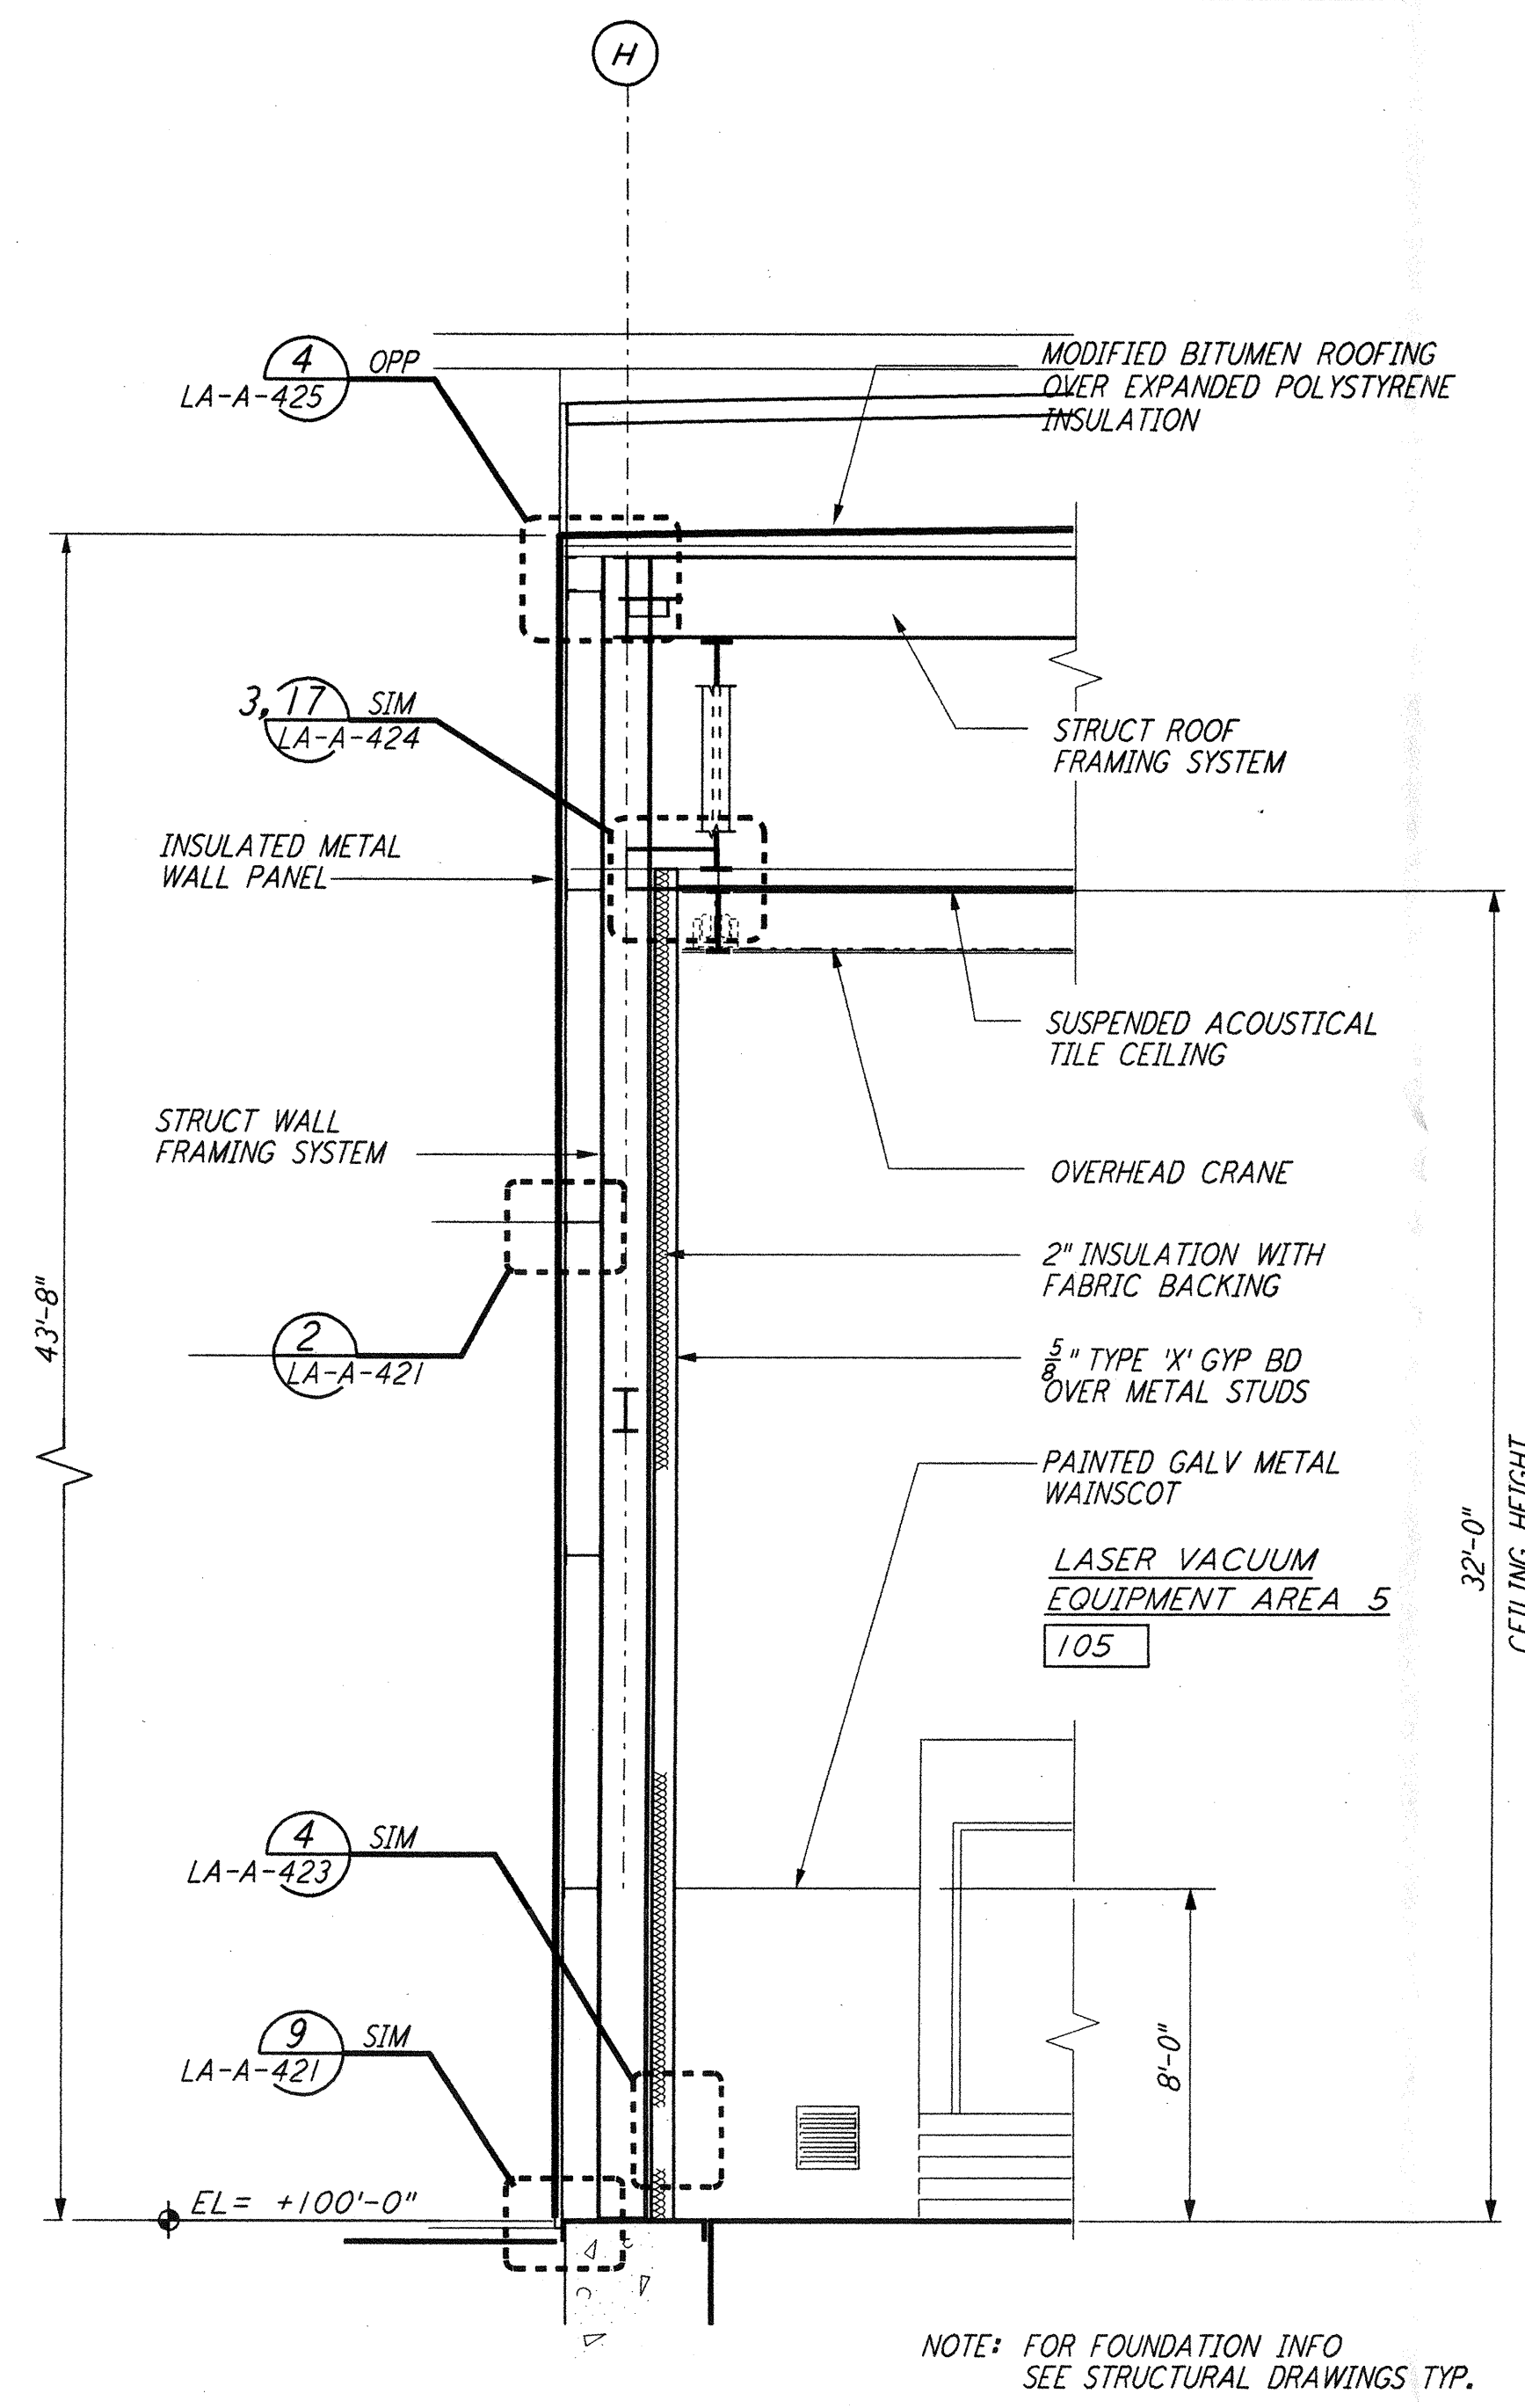


WALL SECTION
 1/4" = 1'-0" (G) REF LA-A-162 LA-A-152

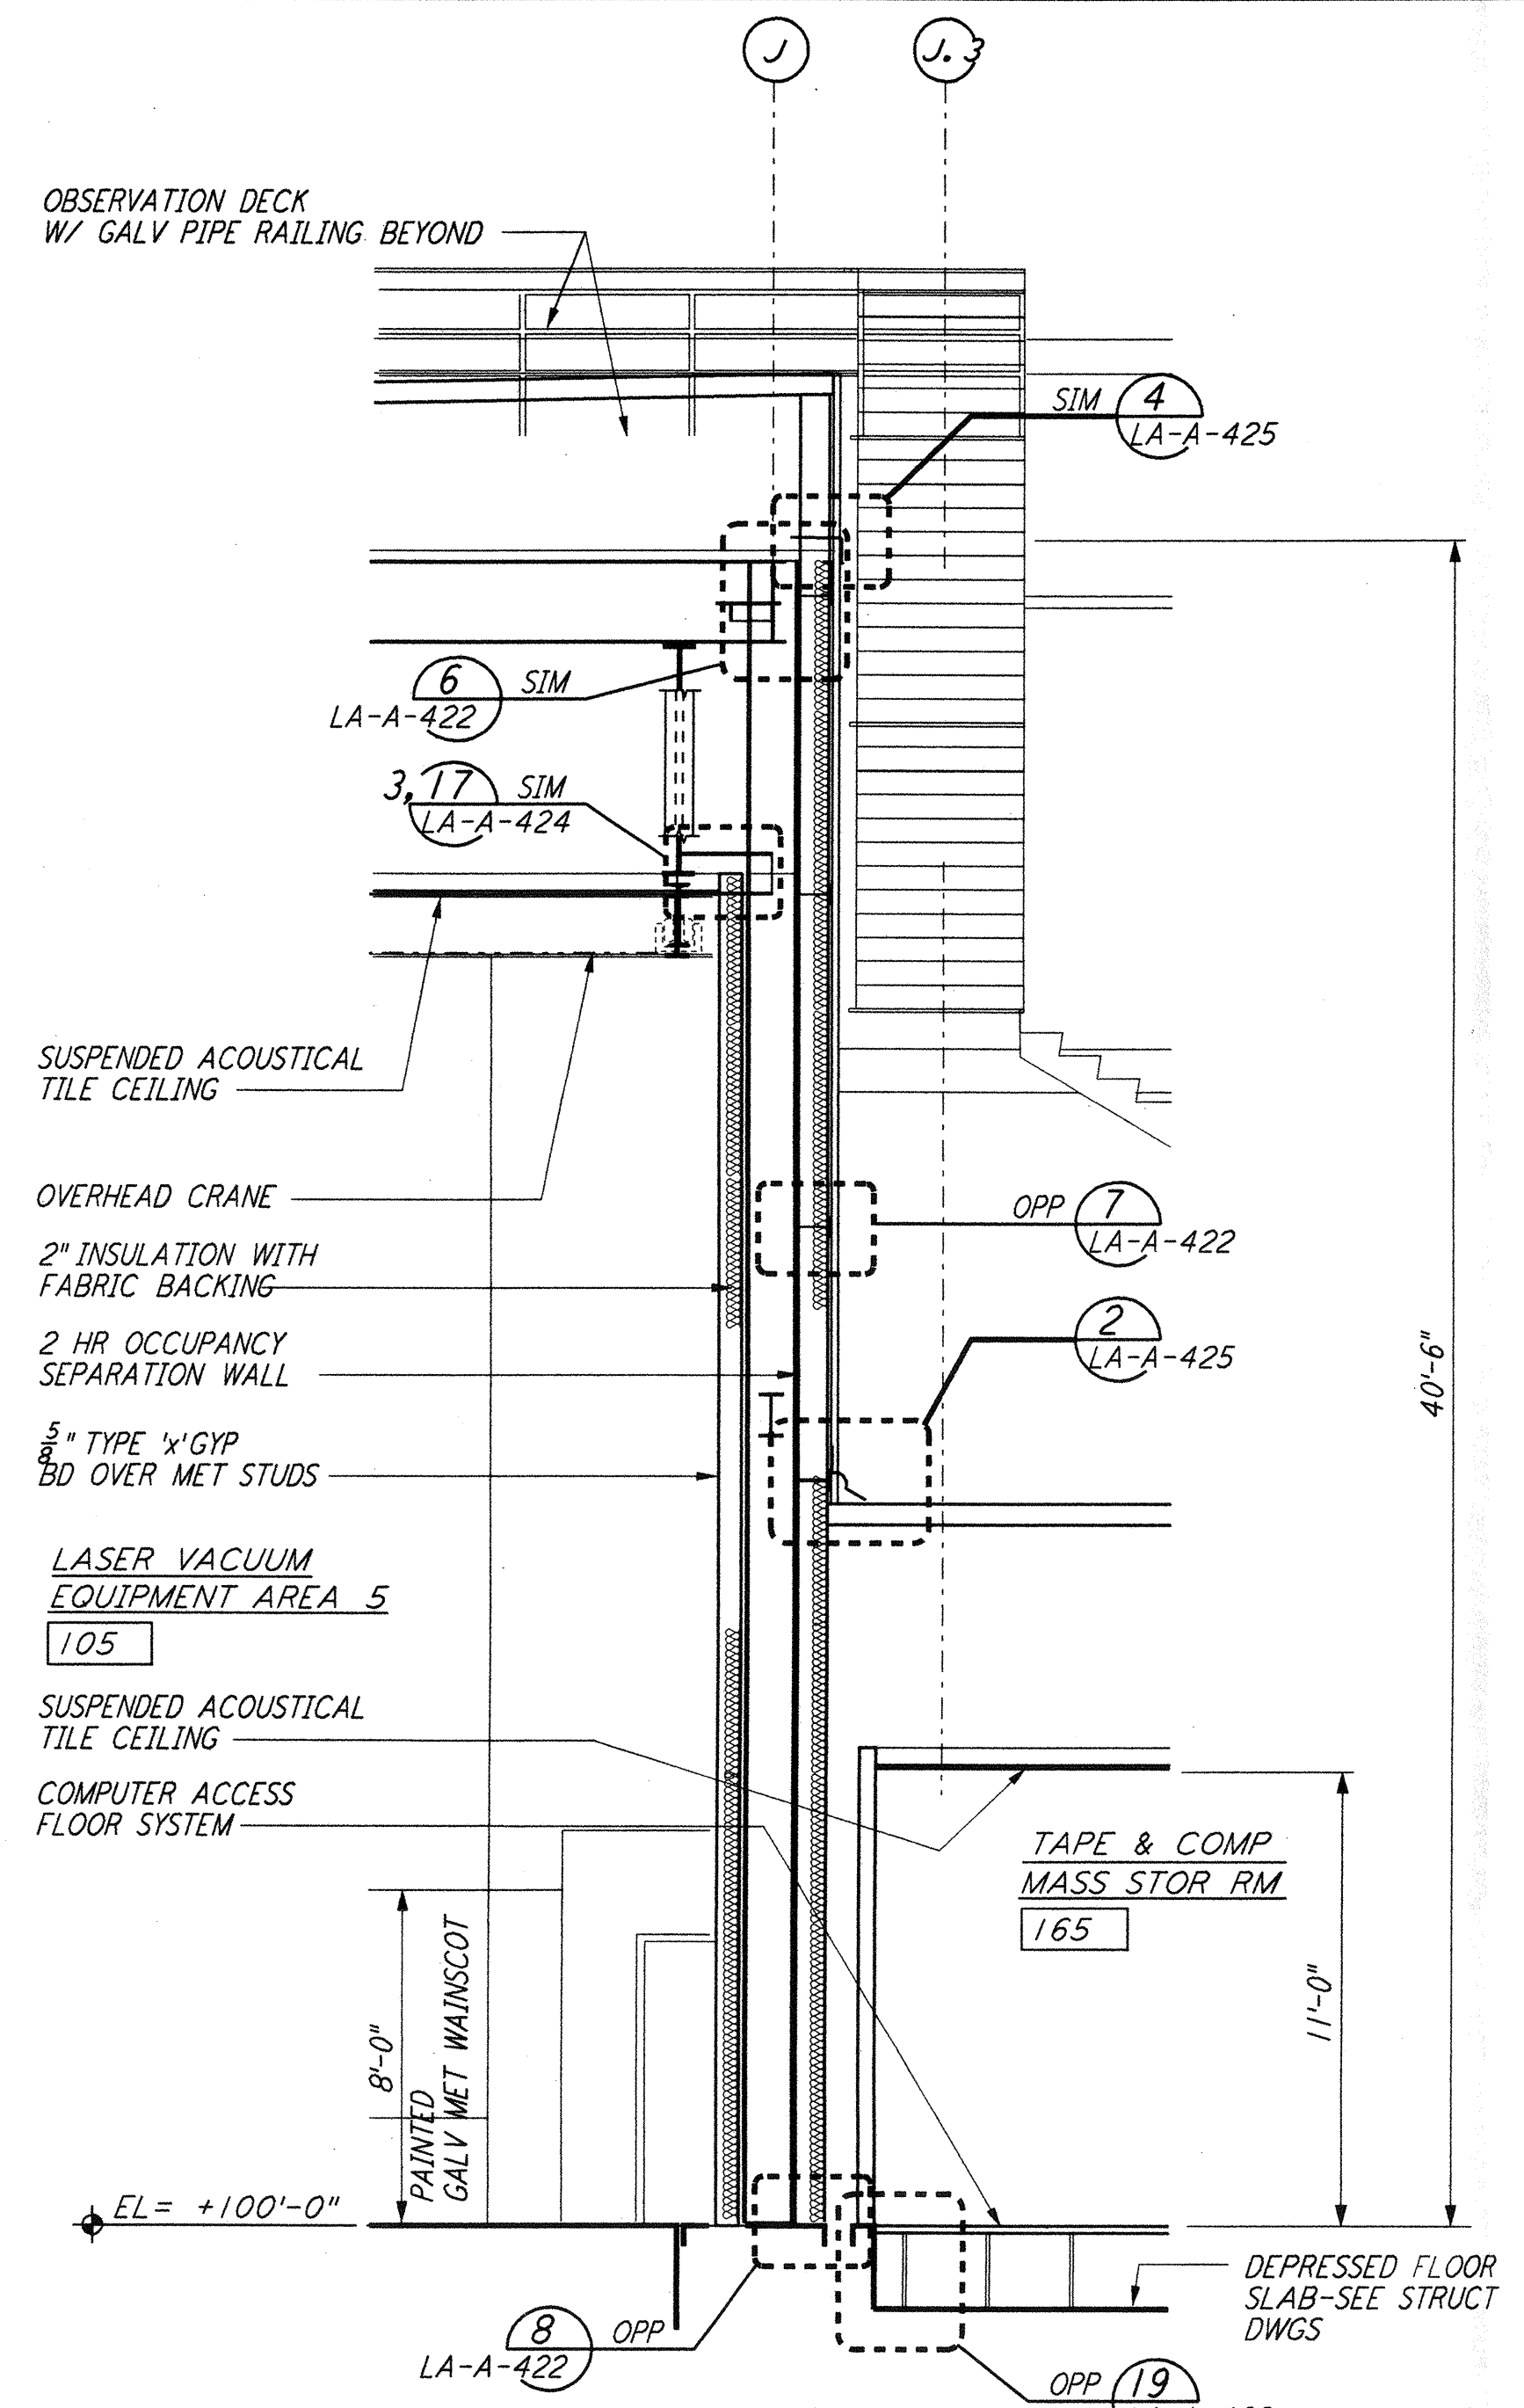


WALL SECTION
 1/4" = 1'-0" (E) REF LA-A-162 LA-A-152

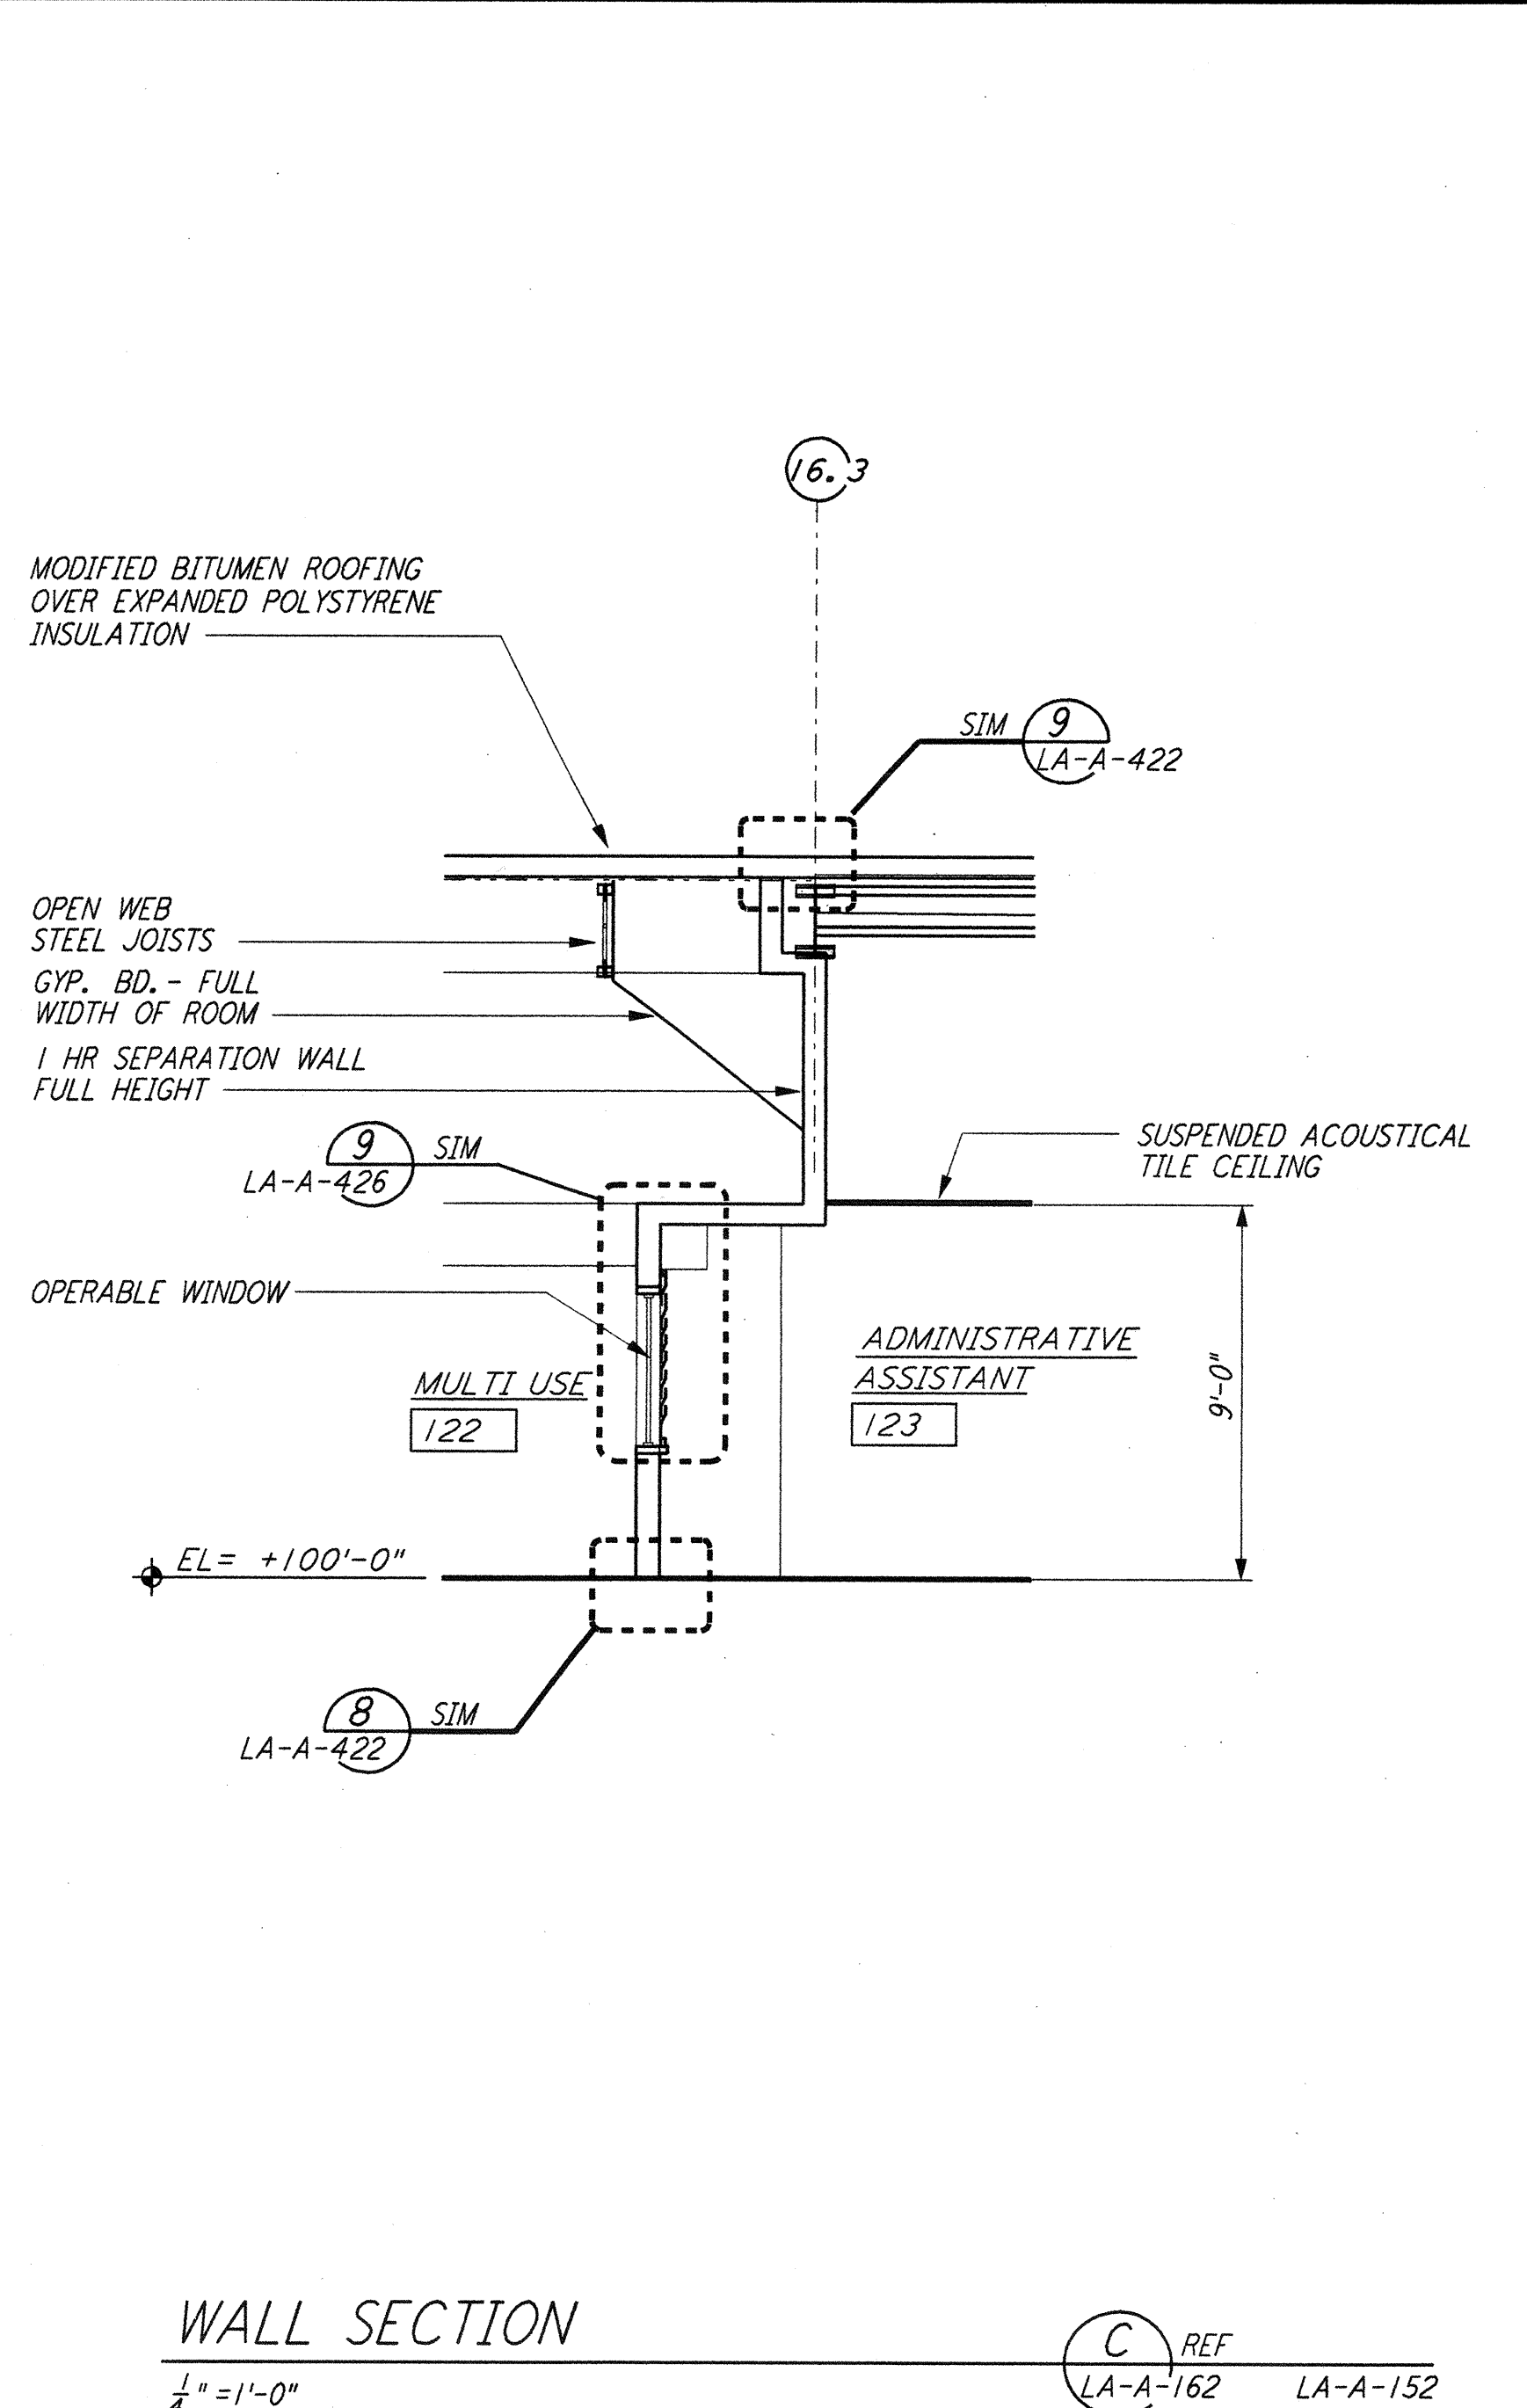


WALL SECTION
 1/4" = 1'-0" (C) REF LA-A-162 LA-A-152

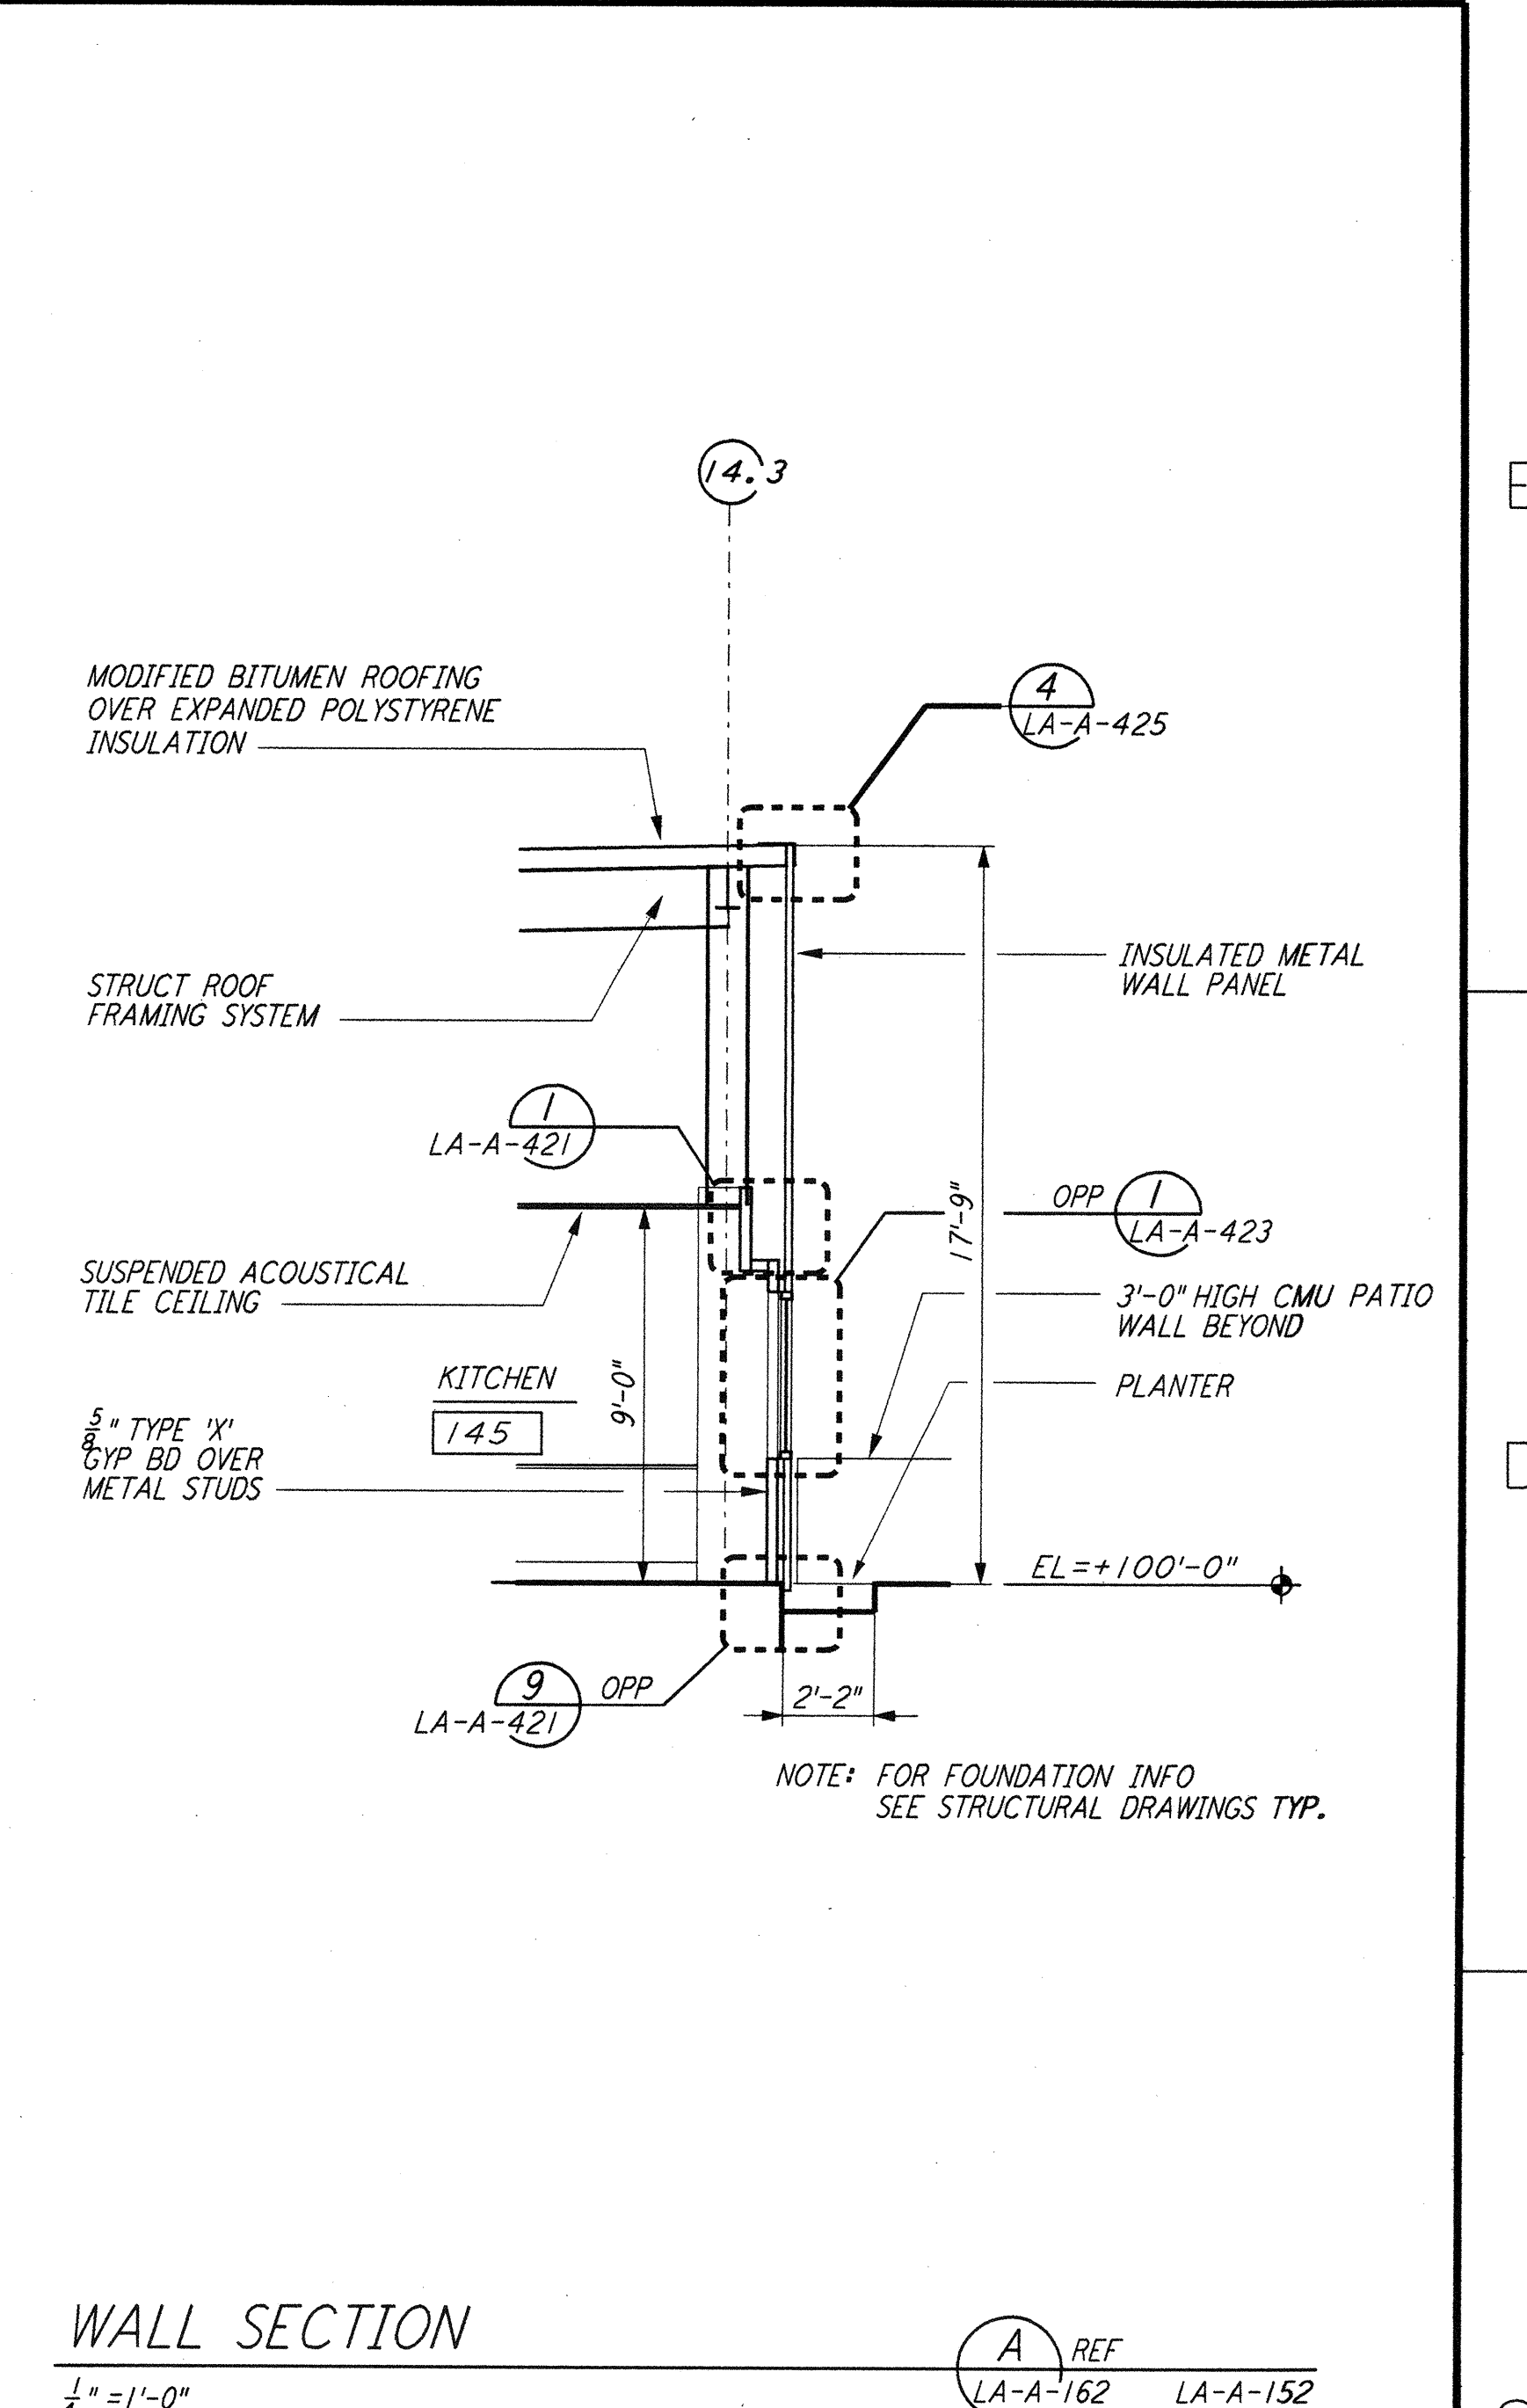


WALL SECTION
 1/4" = 1'-0" (A) REF LA-A-162 LA-A-152

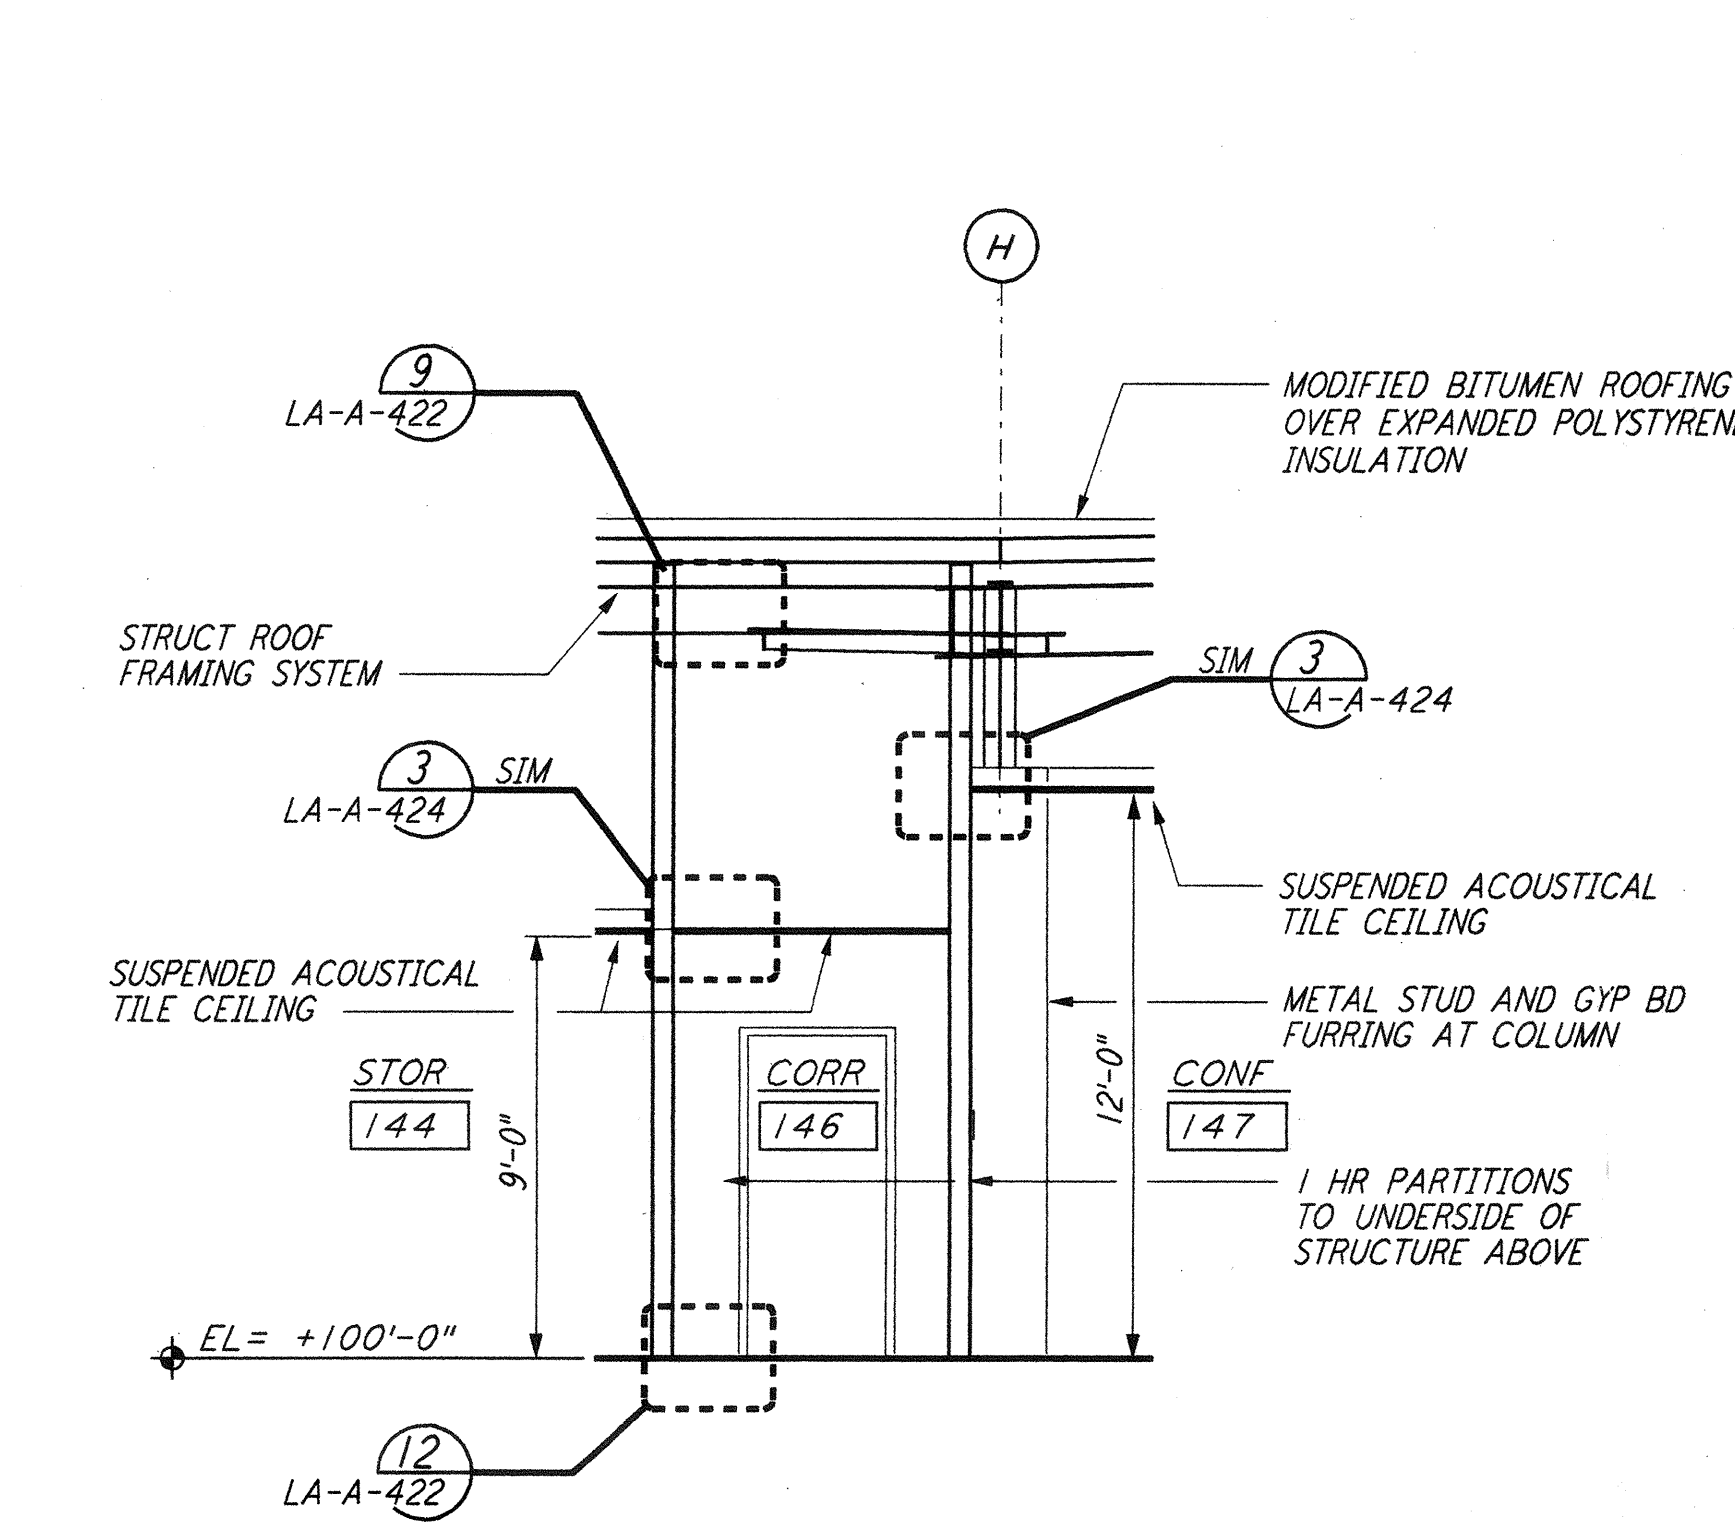


WALL SECTION
 1/4" = 1'-0" (H) REF LA-A-162 LA-A-152

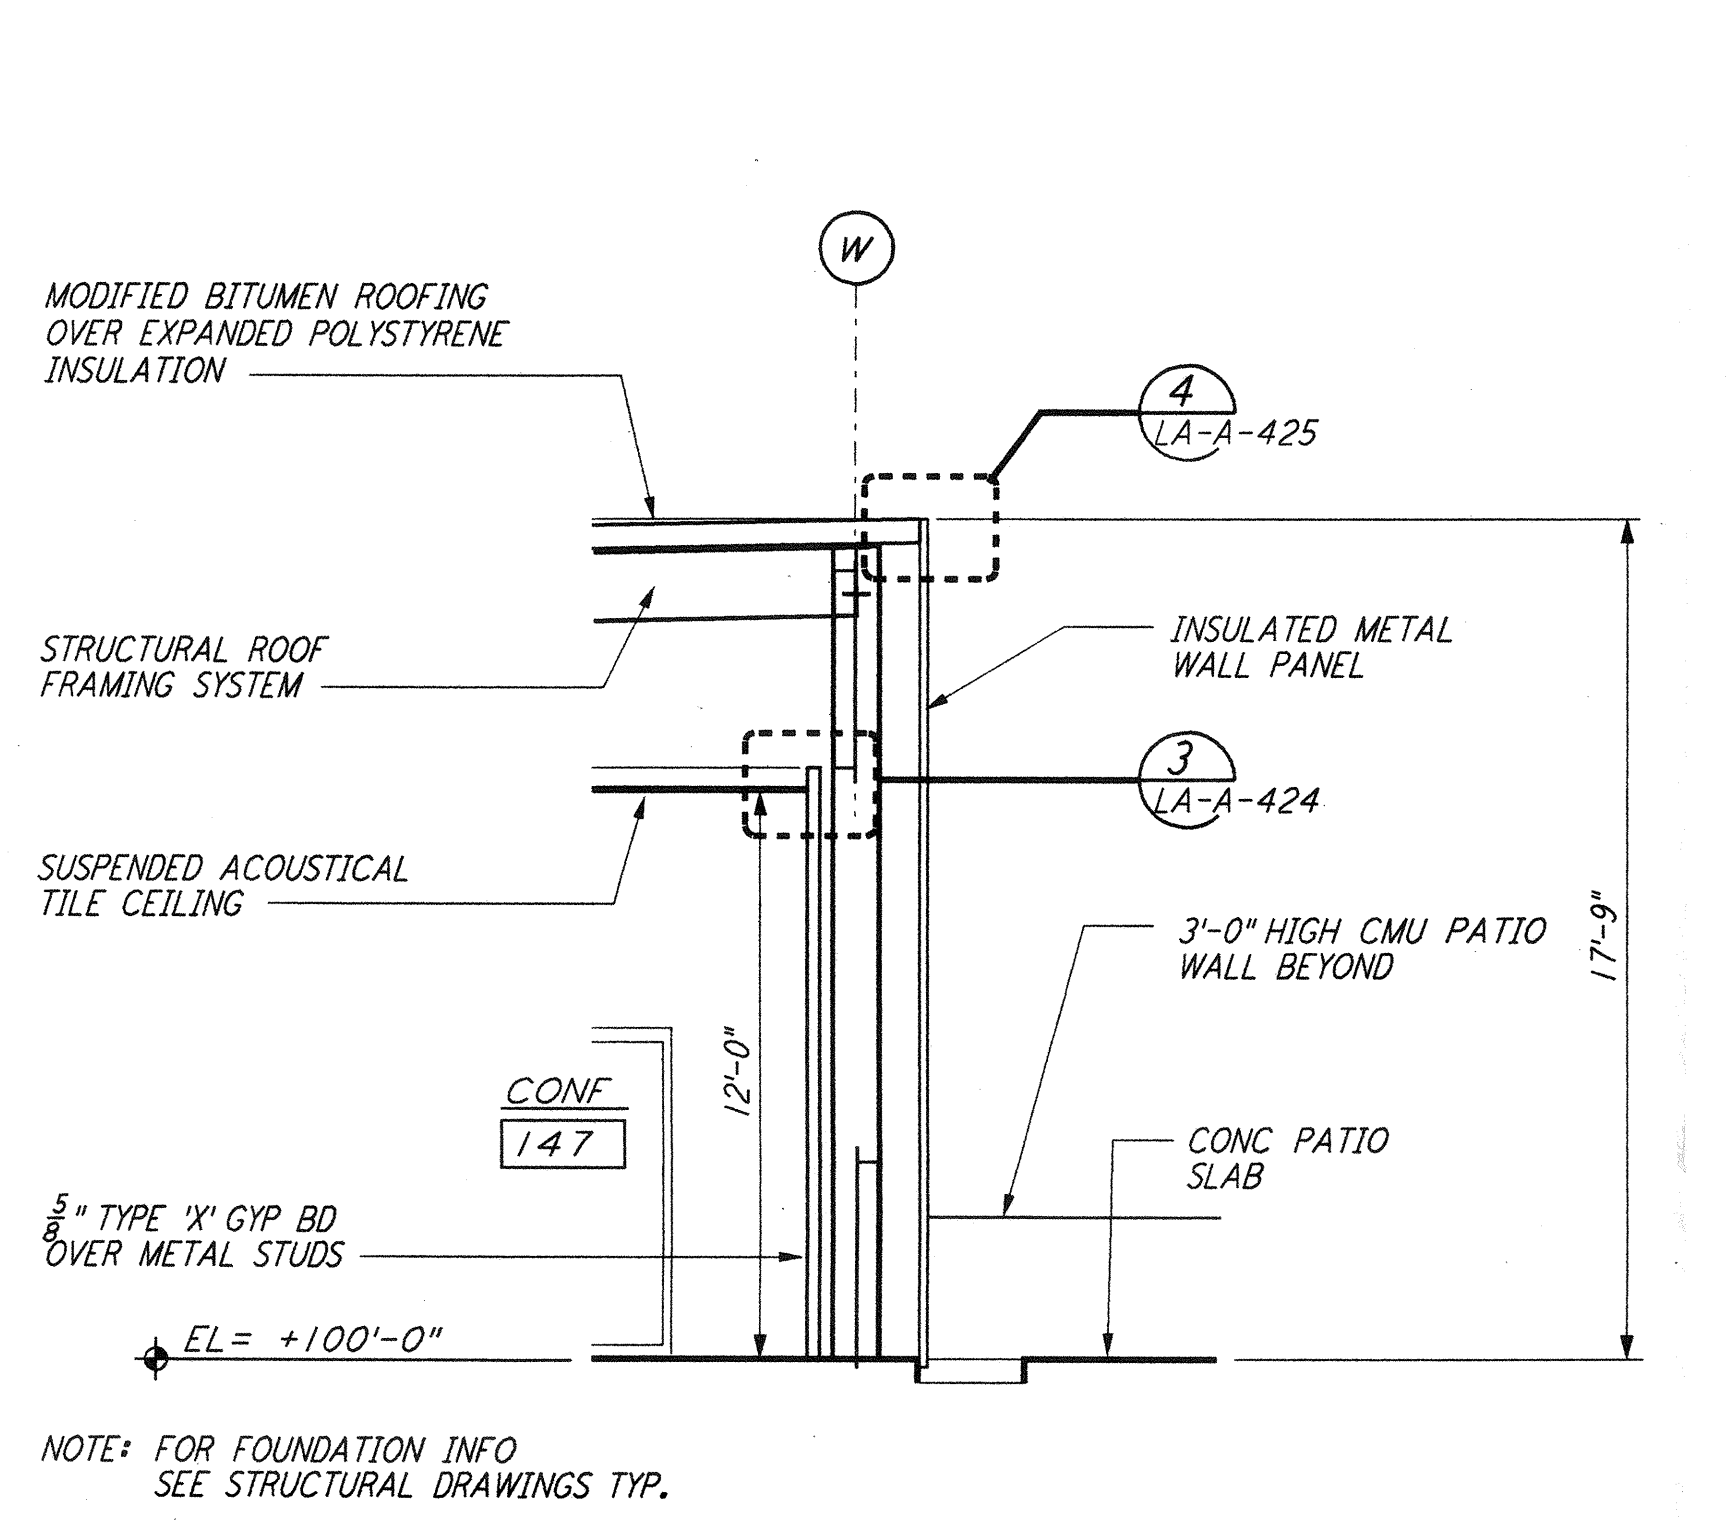


WALL SECTION
 1/4" = 1'-0" (F) REF LA-A-162 LA-A-152

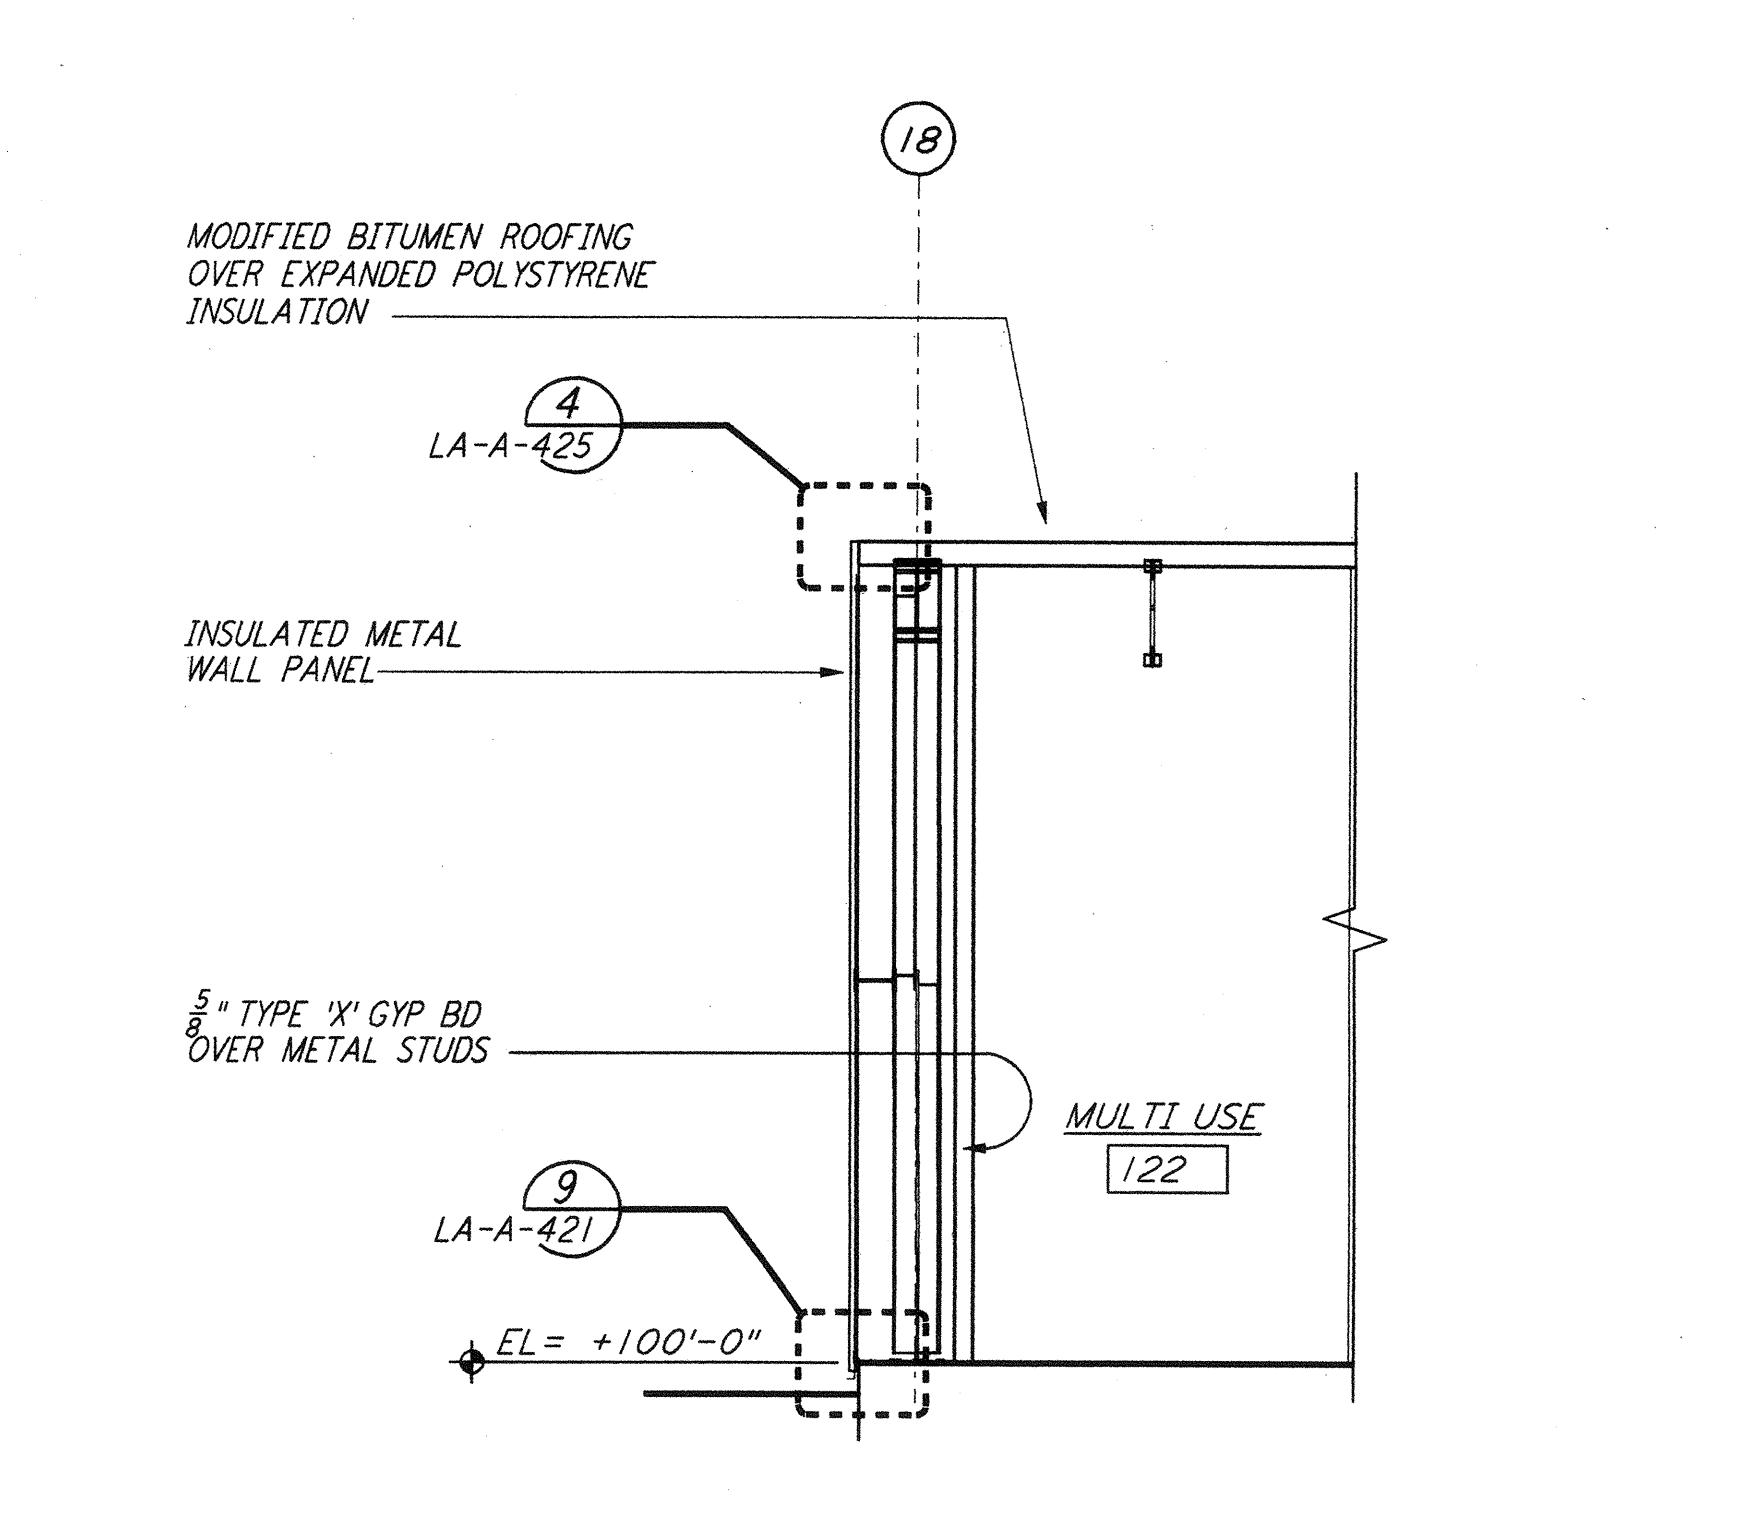

WALL SECTION
 1/4" = 1'-0" (D) REF LA-A-162 LA-A-152

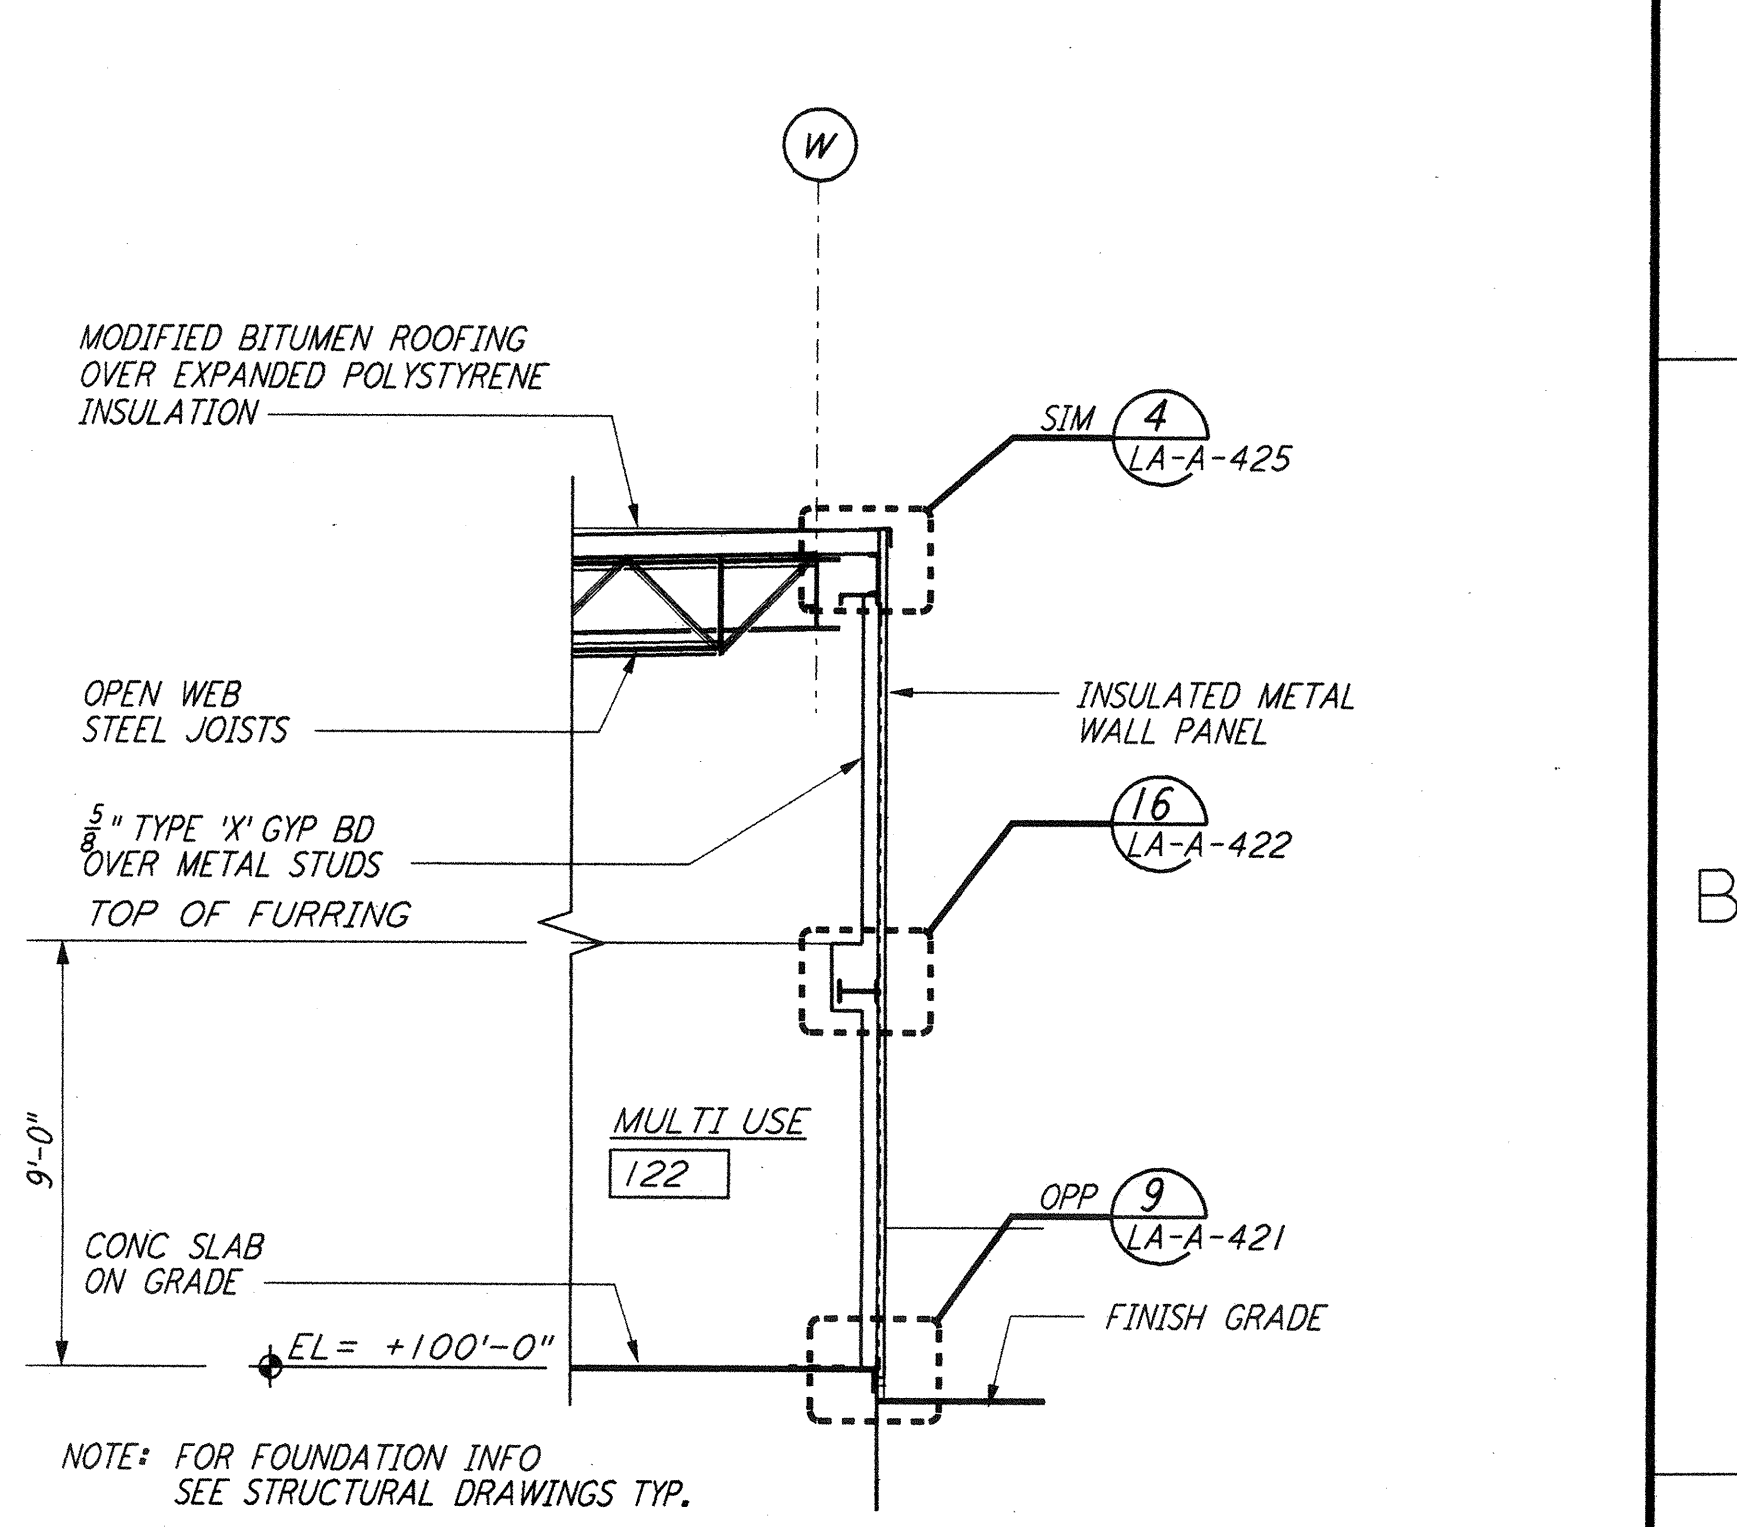

WALL SECTION
 1/4" = 1'-0" (B) REF LA-A-162 LA-A-152

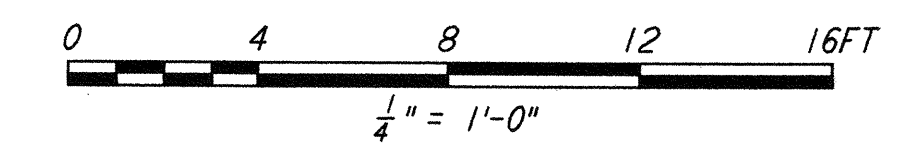

LIGO-D960890-02-0

NO.	DATE	BY	CHKD	ENGR	PROJ	DESCRIPTION
2	08-07-98	SJM	CTK	AK	TDM	ISSUED FOR AS-BUILT OSB REVISION
1	2-28-97	CTK	TB	AK	TDM	OSB REVISION

ISSUED FOR CONSTRUCTION
 DRAWN CKT 11-15-96
 CHECKED TB 11-15-96
 ENGINEER SF 11-15-96
 PROJ MDW 11-15-96

AS-BUILT DRAWINGS



LASER INTERFEROMETER
 GRAVITATIONAL-WAVE OBSERVATORY
 SITE NO. 2 - LIVINGSTON, LOUISIANA

TITLE	SCALE	CONTRACT NUMBER	PROJECT NUMBER
ARCHITECTURAL CORNER STATION WALL SECTIONS SHEET 2		PPI50969	8094
SHEET NUMBER	LA-A-162		REVISIONS