




FIRE EXTINGUISHER CABINET (17) REF
 1 1/2" = 1'-0" LA-A-422 LA-A-108 LA-A-109

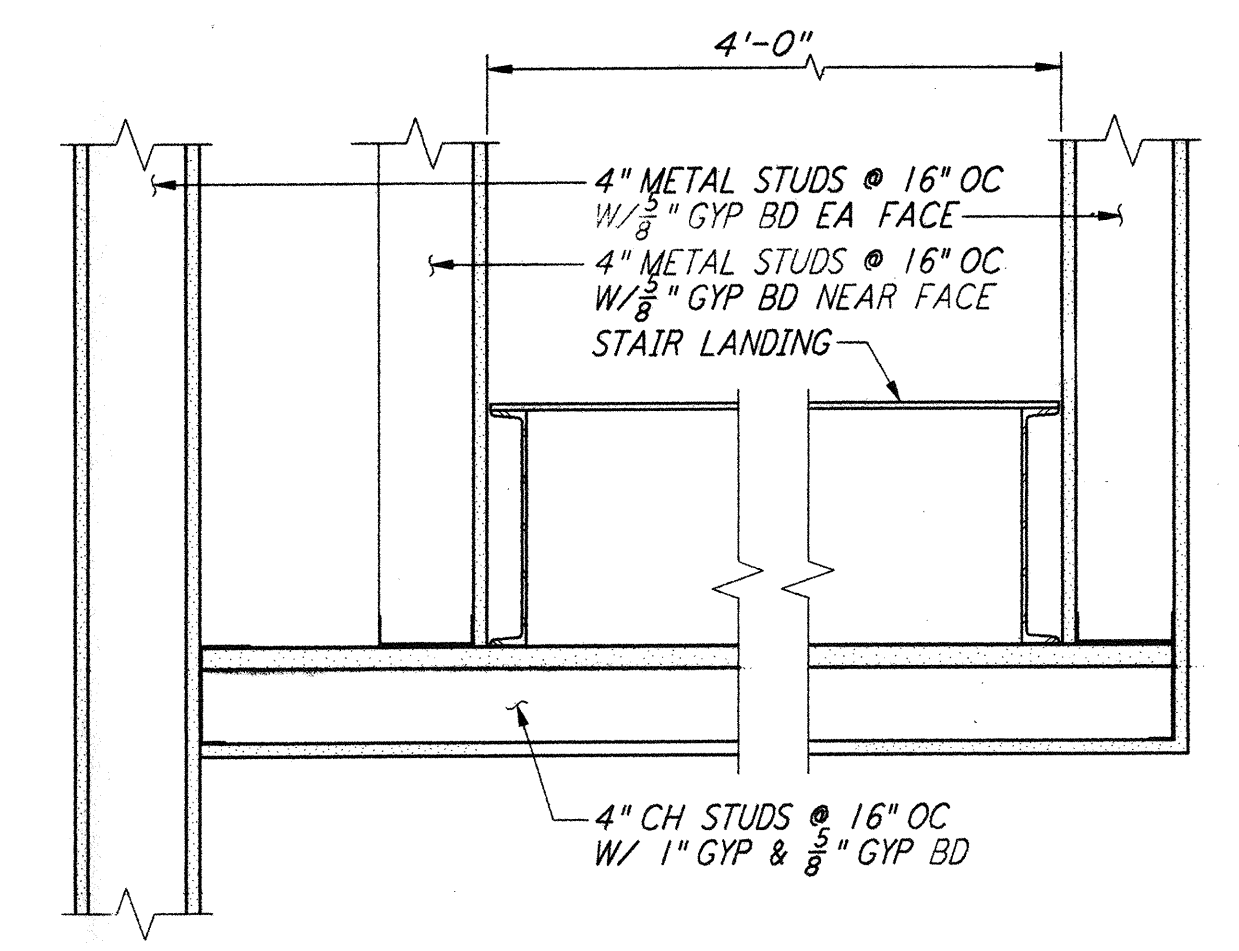


SECTION @ STAIR (13) REF
 1 1/2" = 1'-0" LA-A-422 LA-A-552

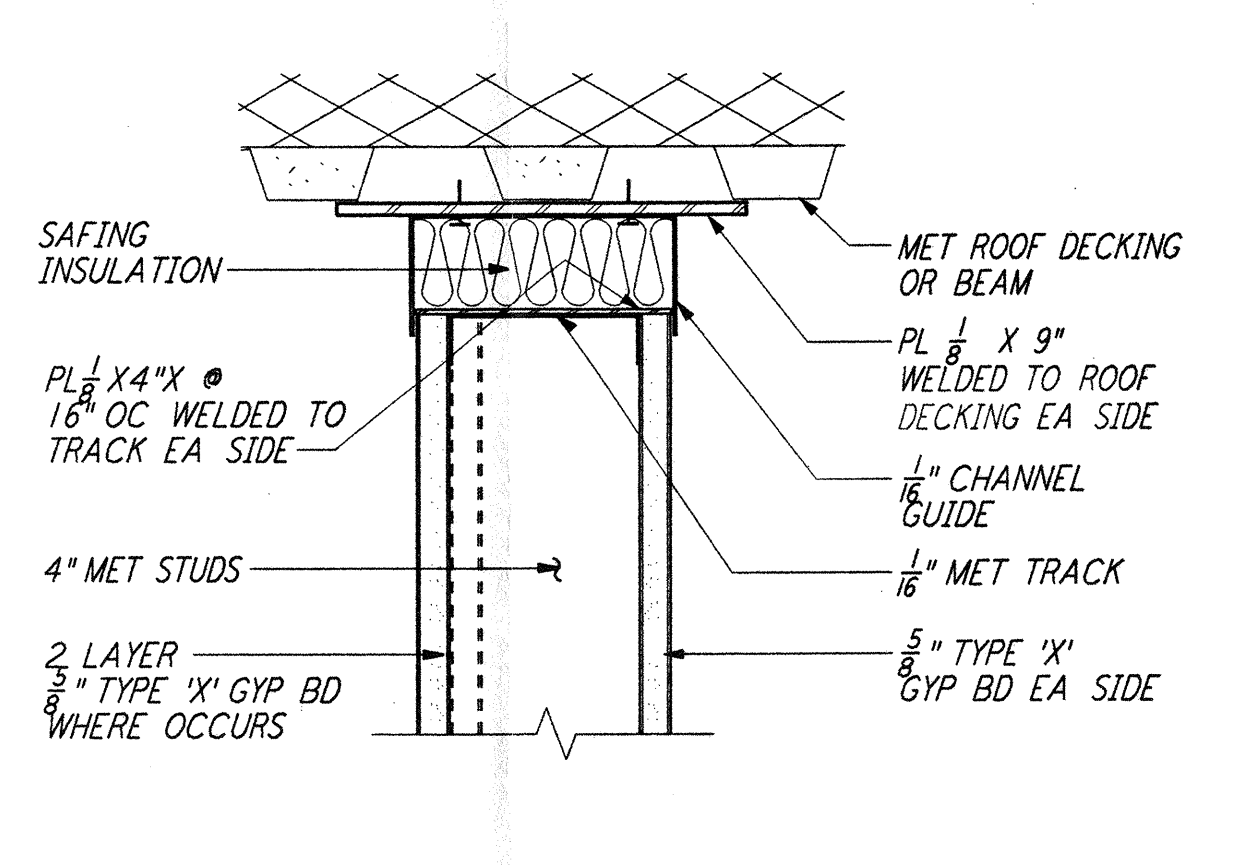


1-HR WALL @ ROOF DECK (9) REF
 3" = 1'-0" LA-A-422 LA-A-162

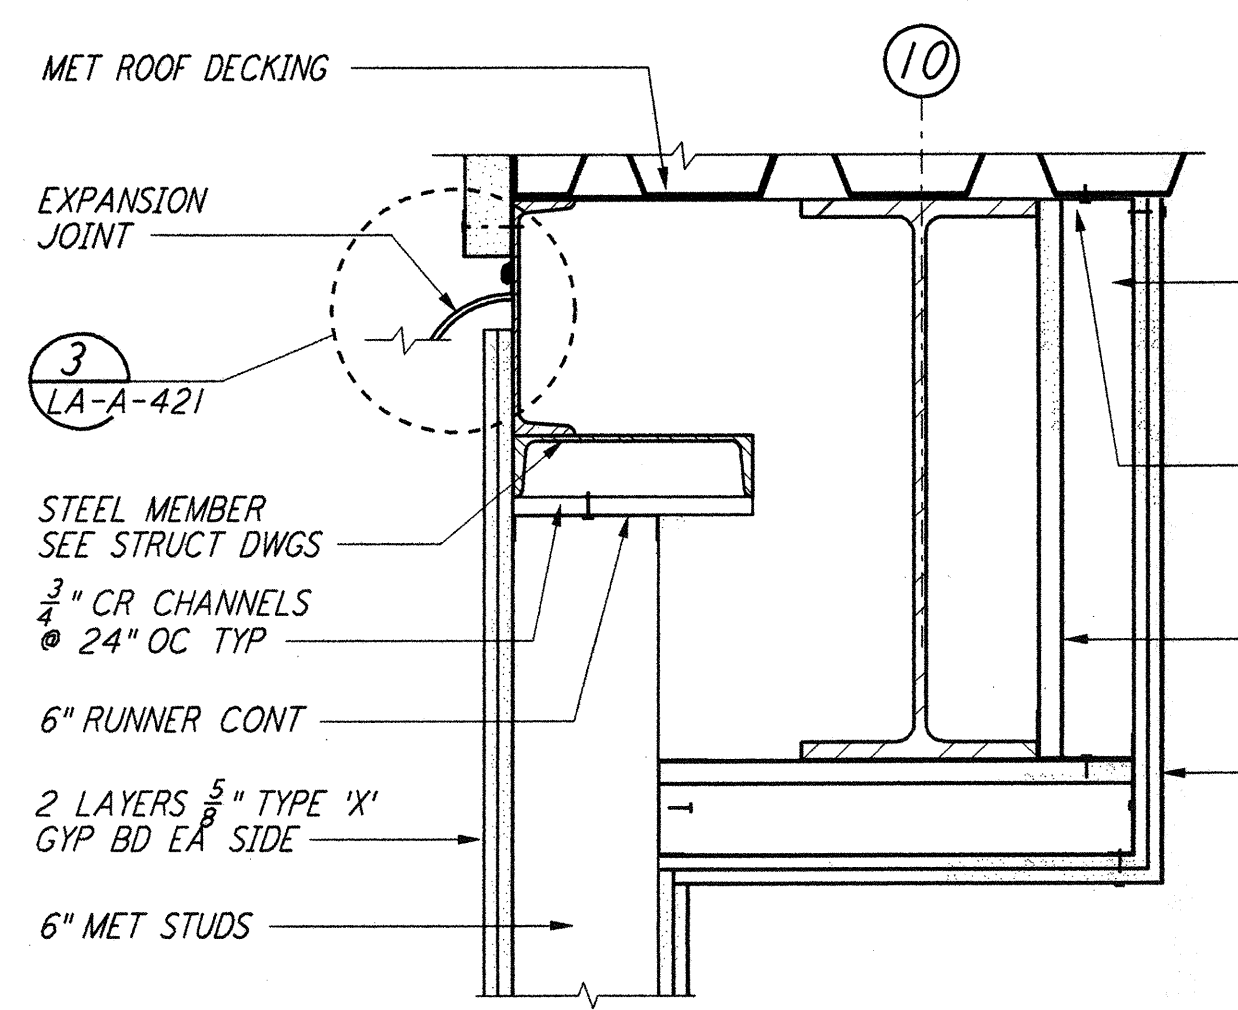


2-HR WALL @ ROOF DECK (5) REF
 1 1/2" = 1'-0" LA-A-422 LA-A-161

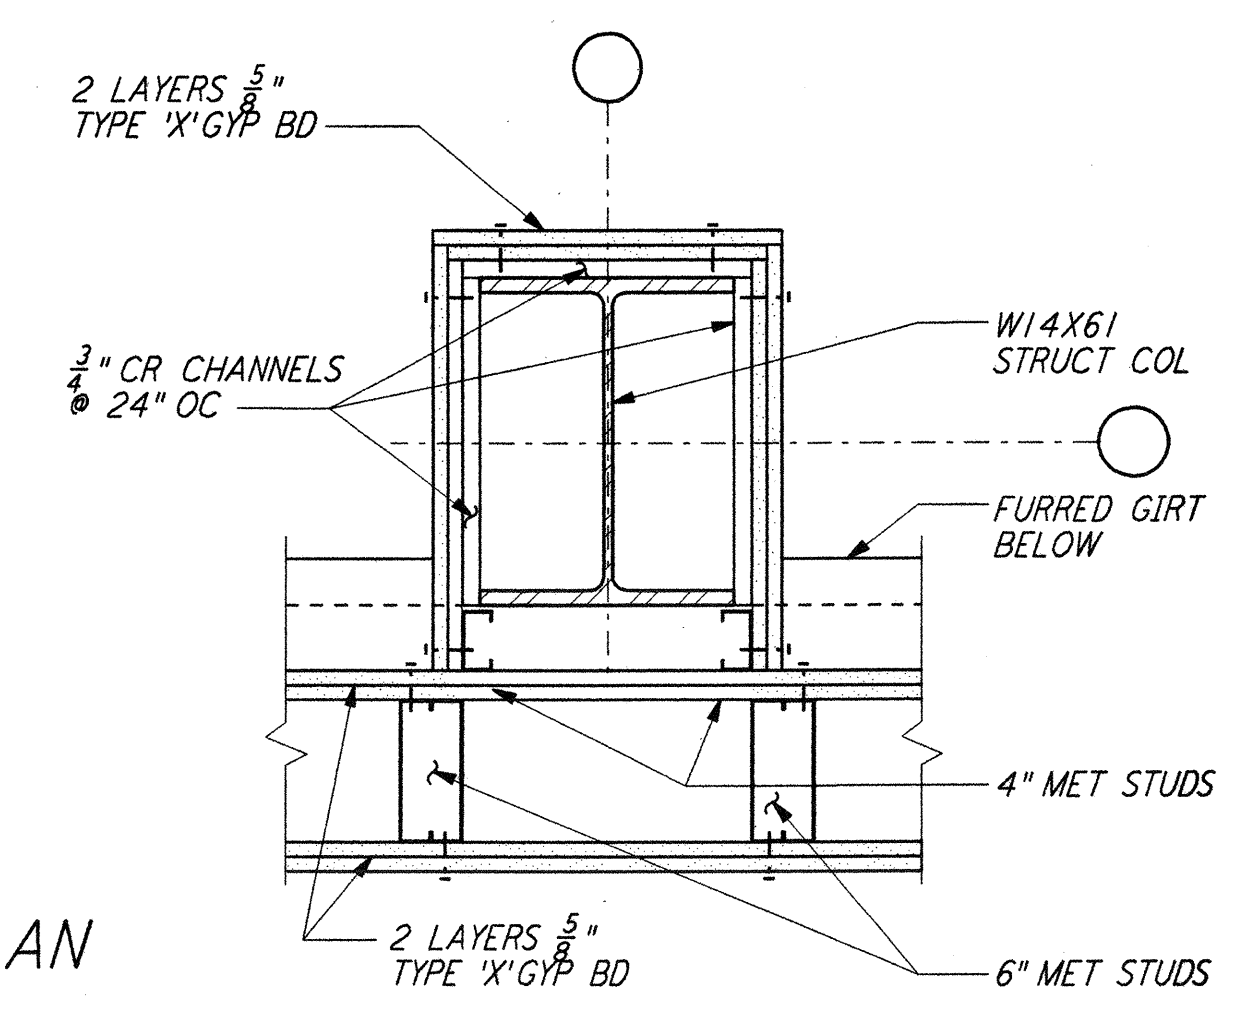


2-HR WALL @ COLUMN (1) REF
 1 1/2" = 1'-0" LA-A-422 LA-A-104 LA-A-105

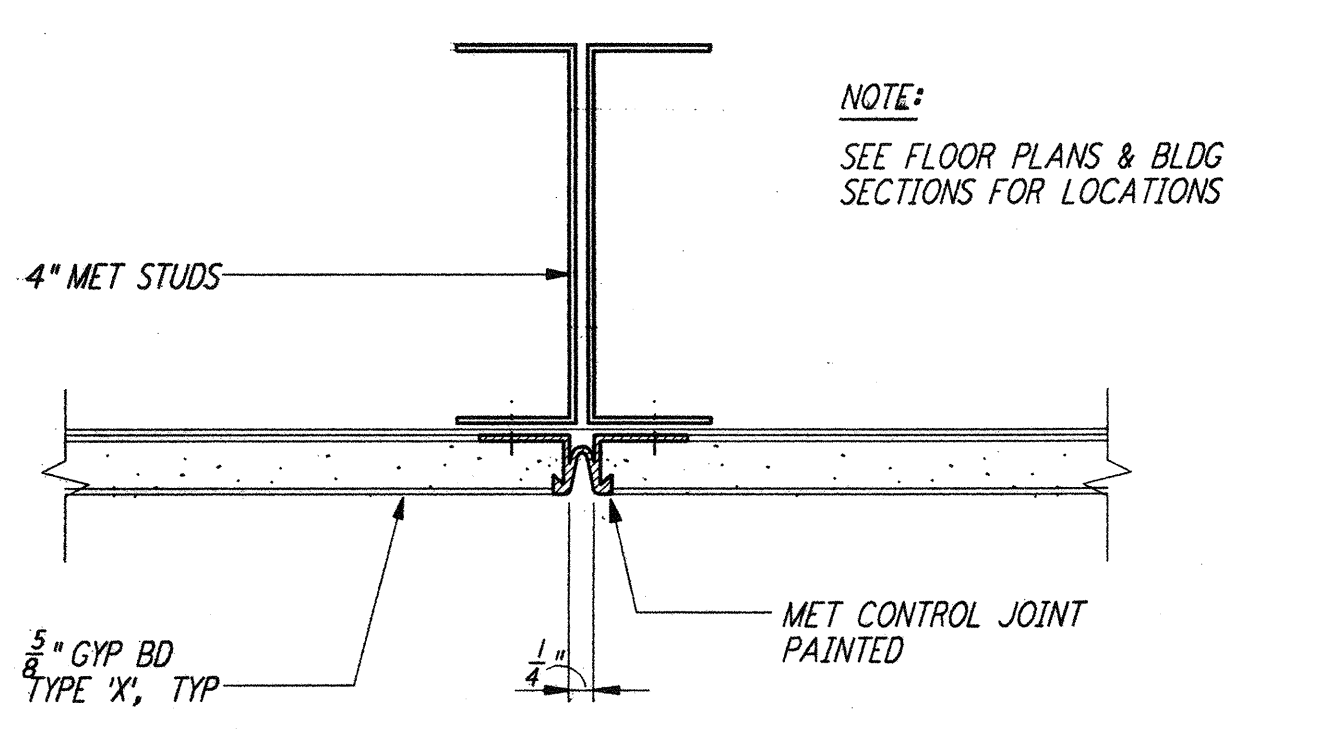


GYP BD CONTROL JOINT DTL (18) REF
 HALF SIZE LA-A-422 LA-A-151 LA-A-251

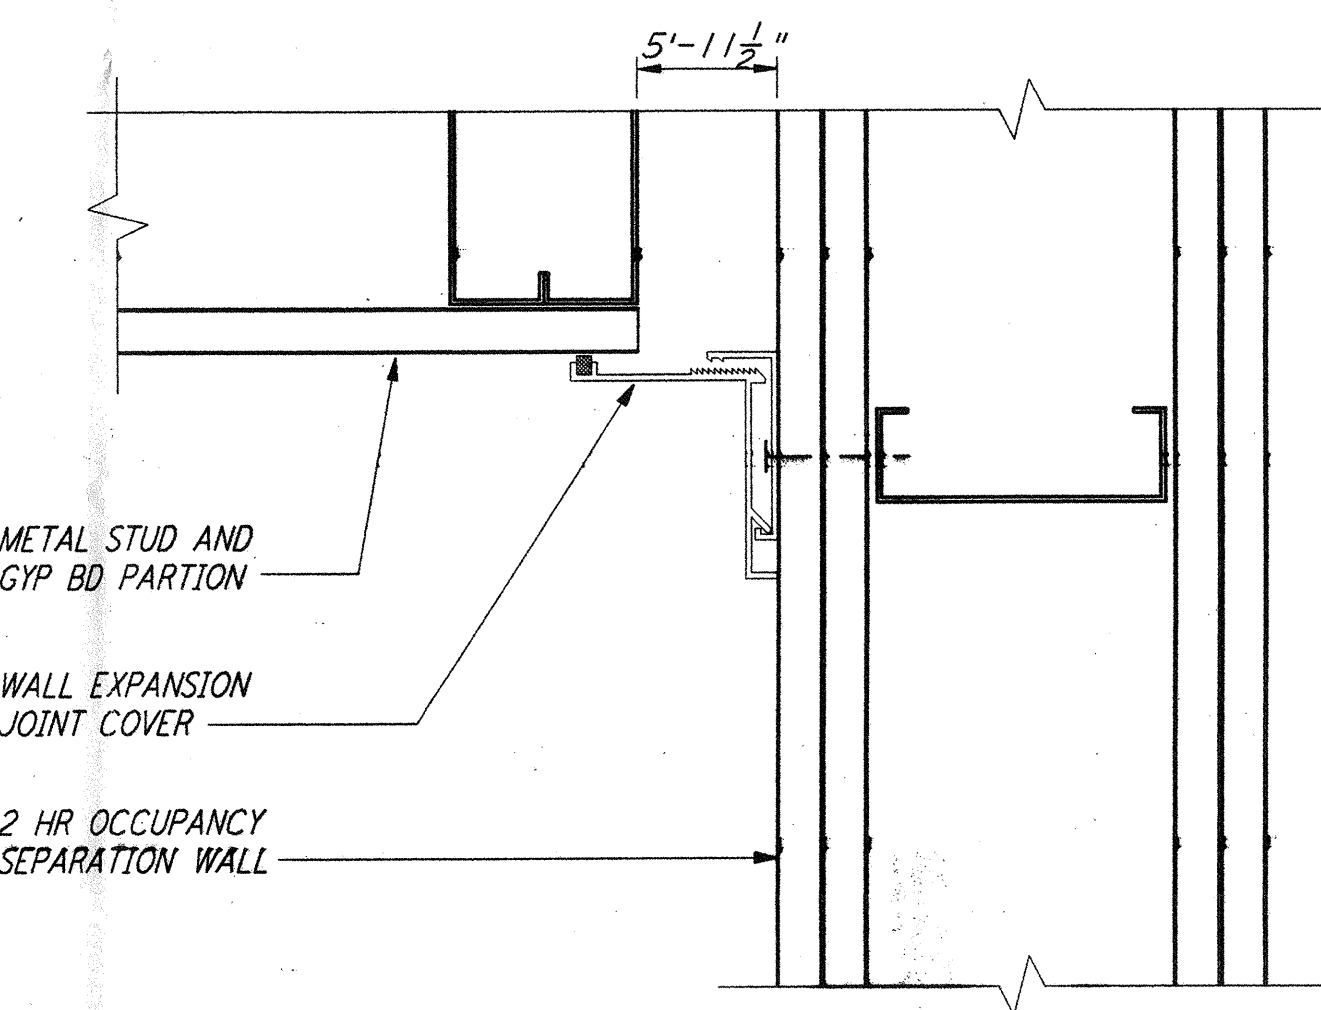


WALL EXPANSION JT COVER (14) REF
 3" = 1'-0" LA-A-422 LA-A-109

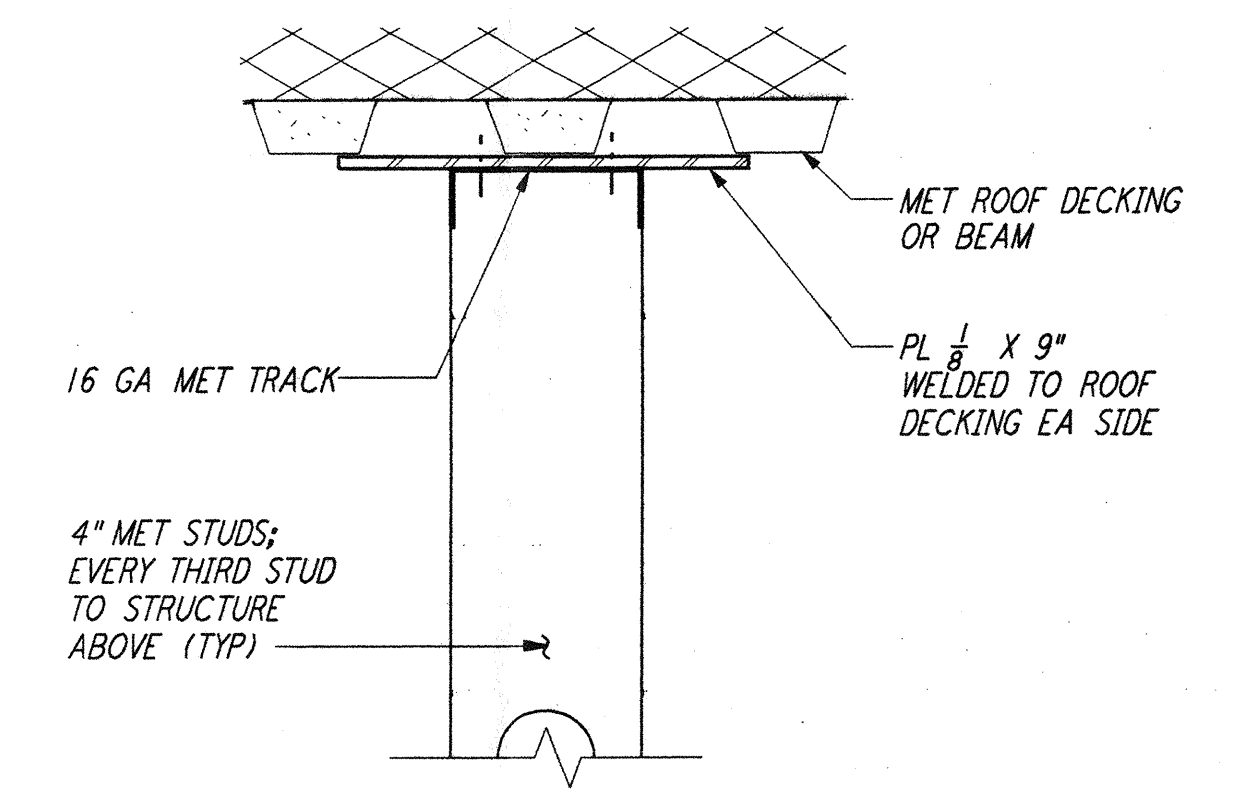


STUD FRAMING @ ROOF DECK (10) REF
 3" = 1'-0" LA-A-422 LA-A-163

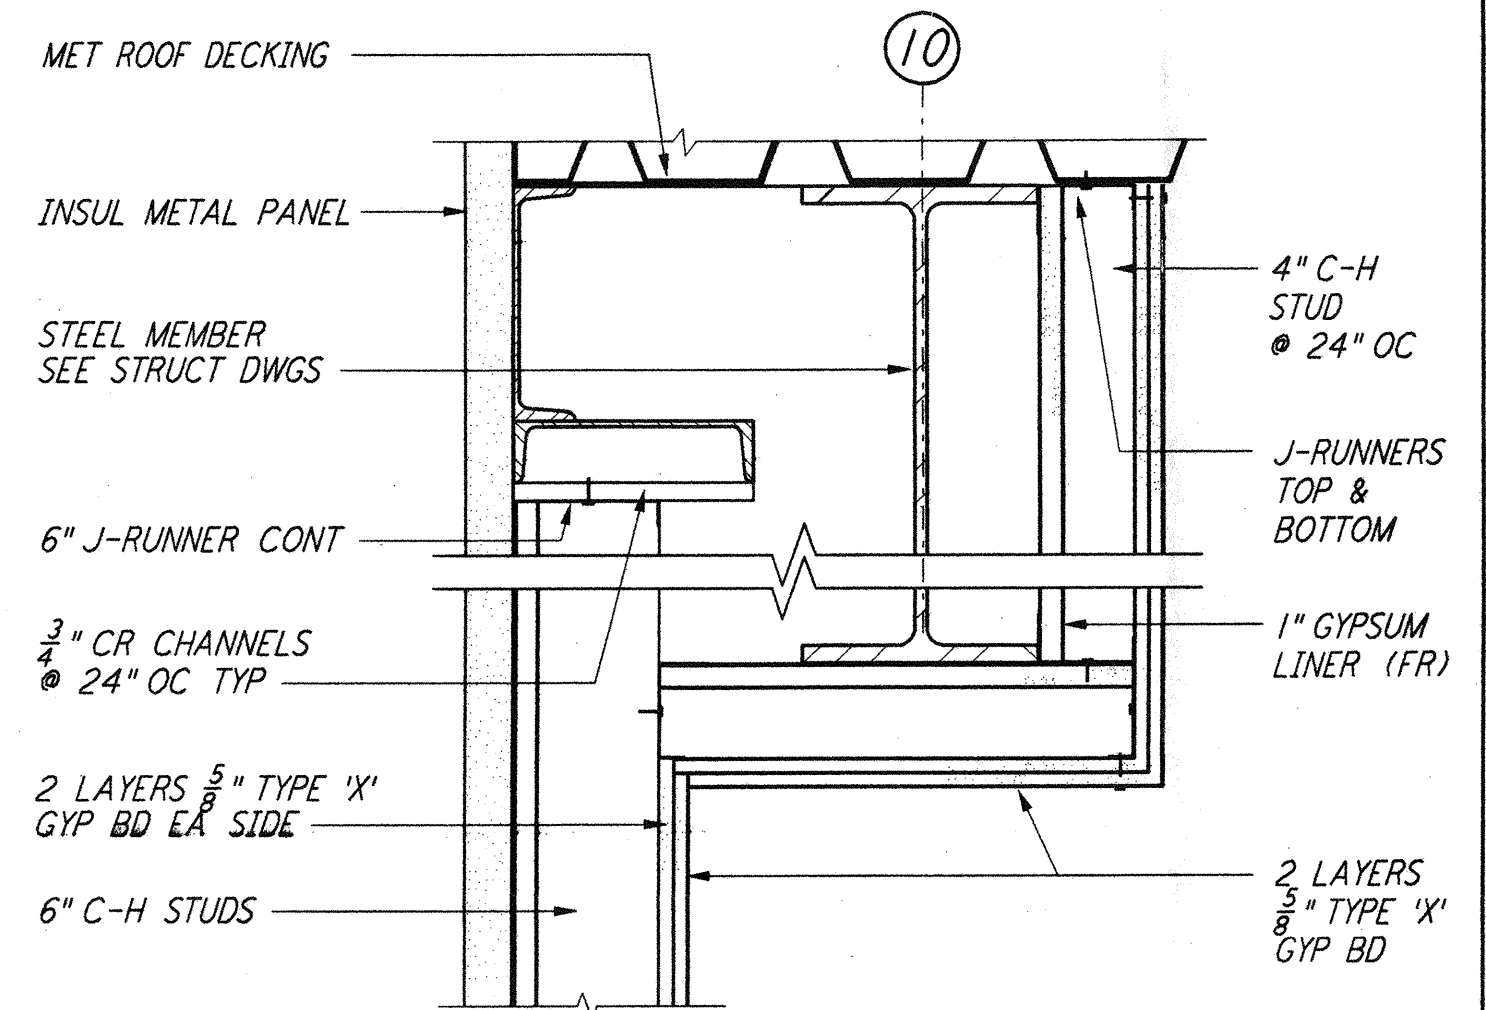


2-HR WALL @ ROOF DECK (6) REF
 1 1/2" = 1'-0" LA-A-422 LA-A-162

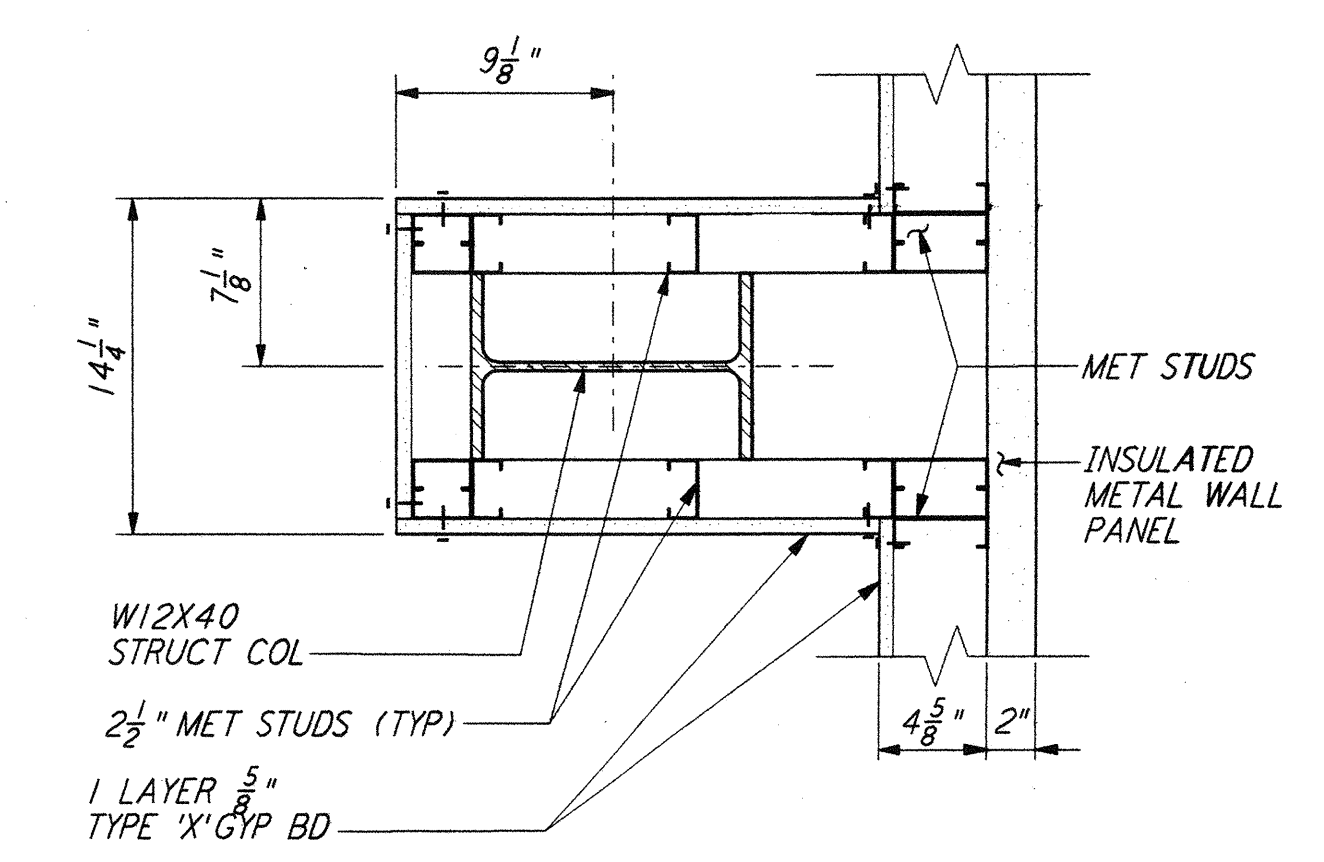


WALL @ COLUMN (2) REF
 1 1/2" = 1'-0" LA-A-422 LA-A-108

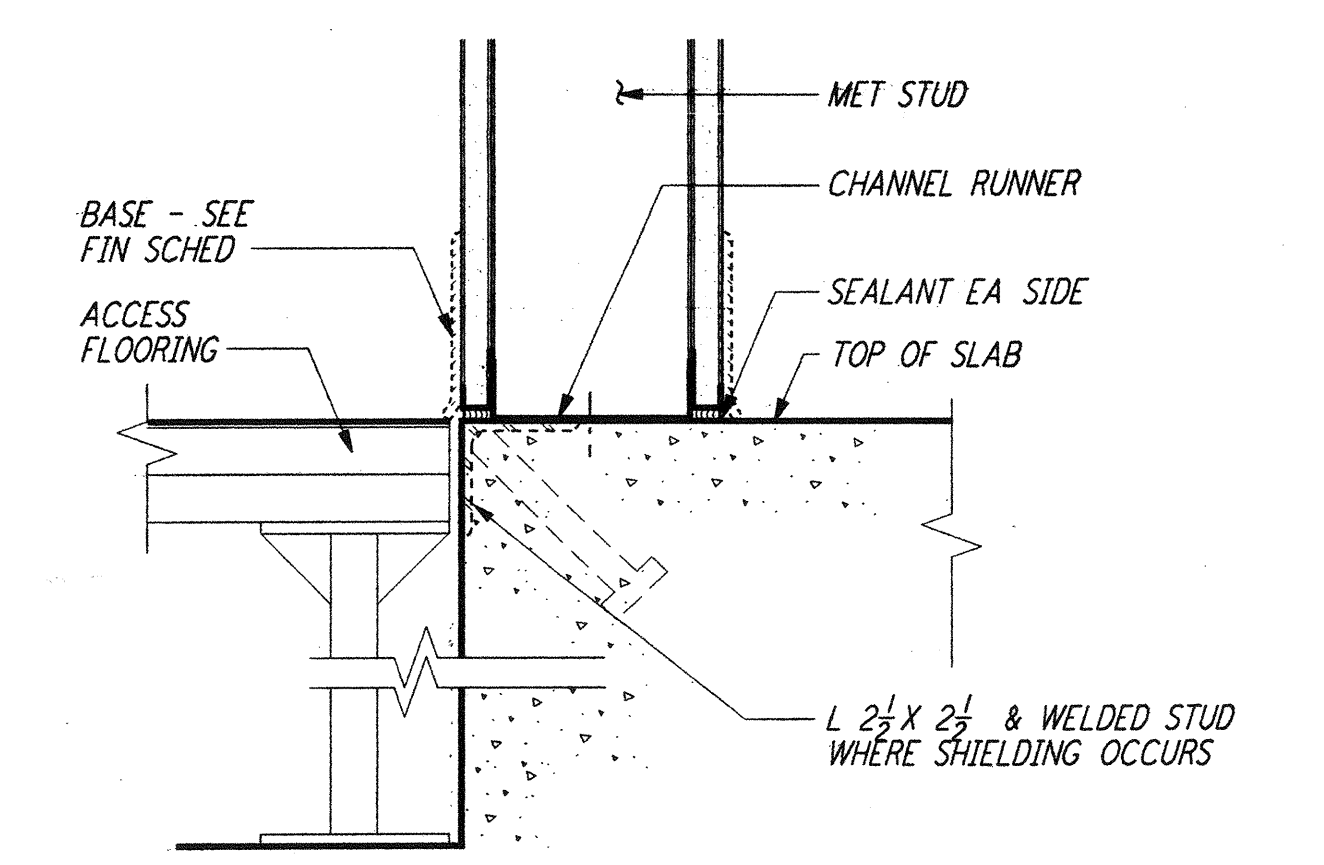


ELEVATED FLOOR SYSTEM (19) REF
 3" = 1'-0" LA-A-422 LA-A-162

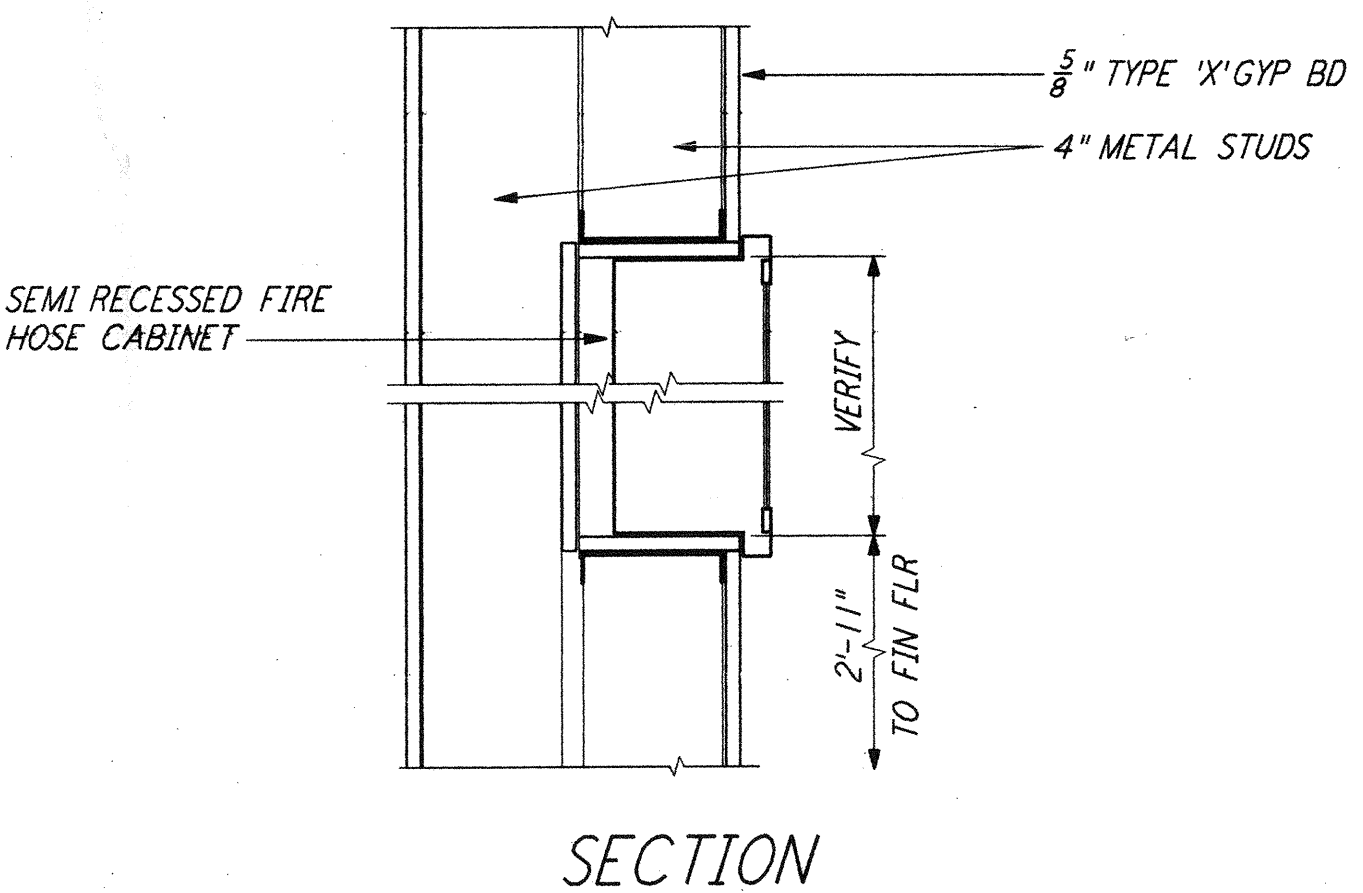


FIRE HOSE CABINET (15) REF
 3" = 1'-0" LA-A-422 LA-A-422

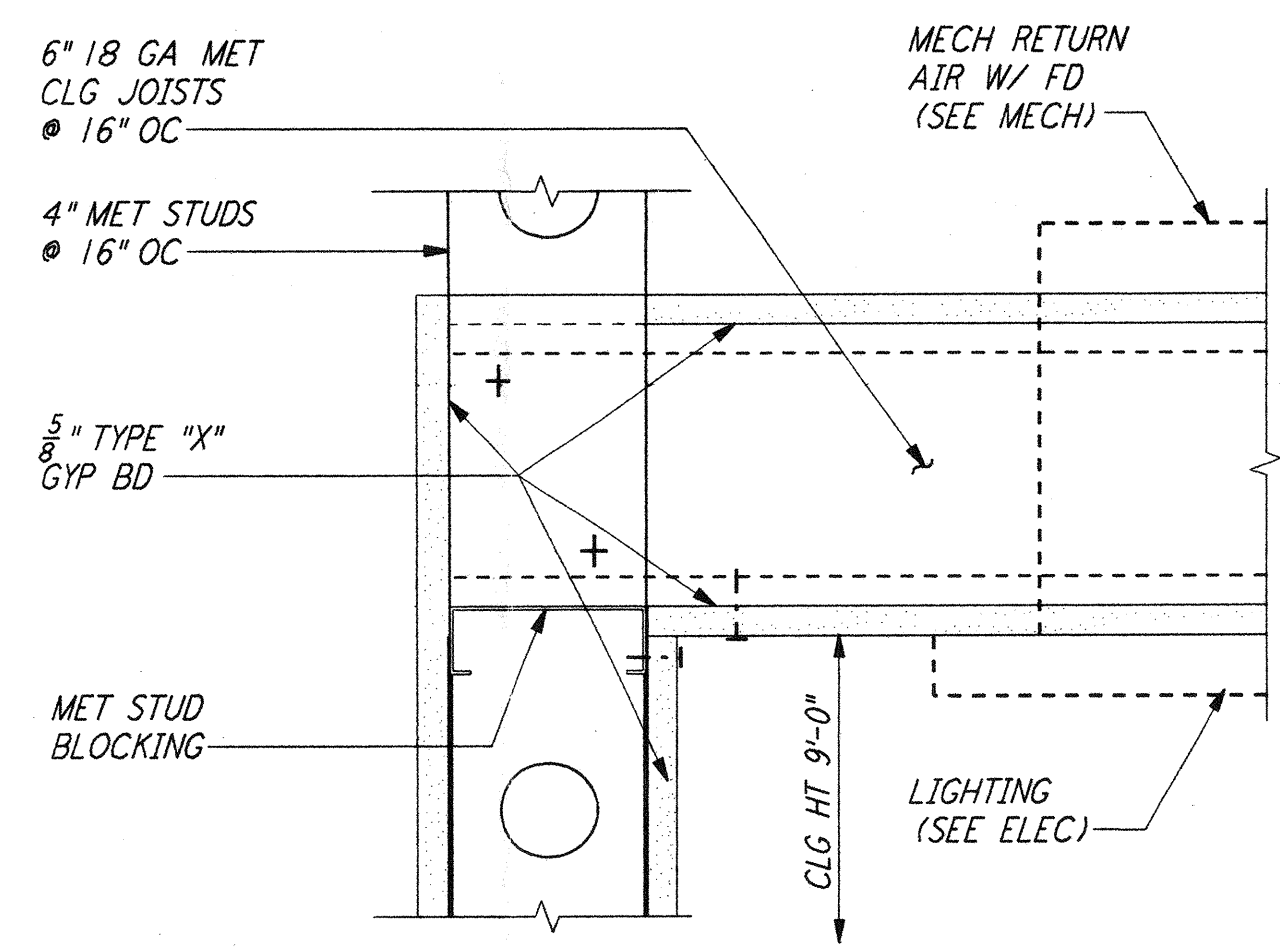


1-HR CORRIDOR (11) REF
 3" = 1'-0" LA-A-422 LA-A-161

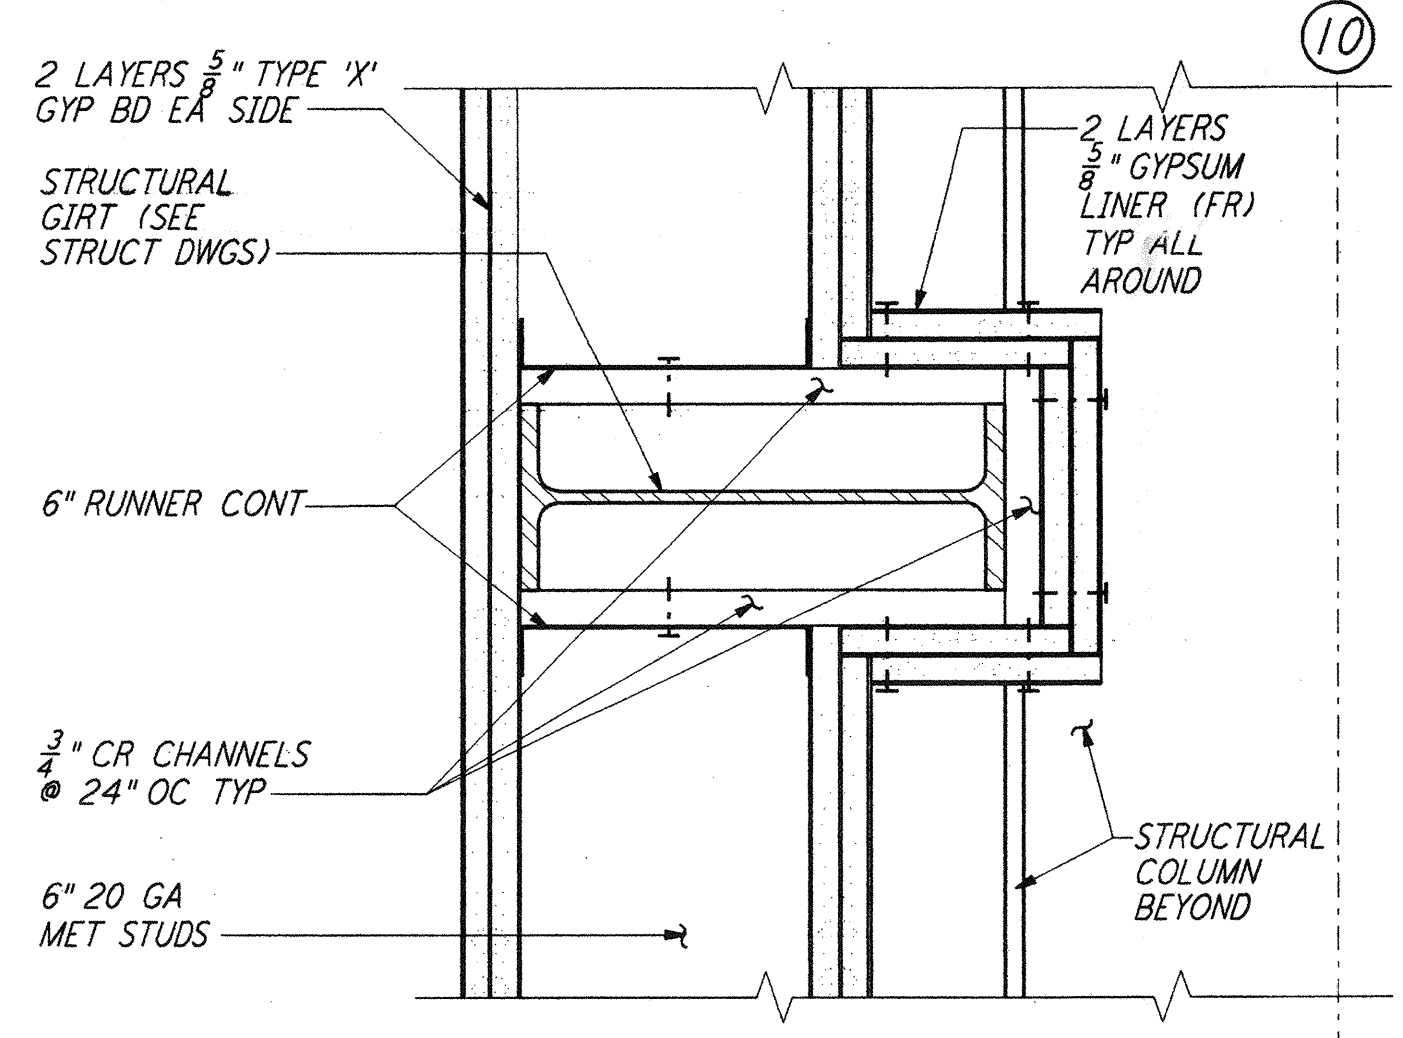


2-HR WALL @ STRUCT GIRT (7) REF
 3" = 1'-0" LA-A-422 LA-A-162

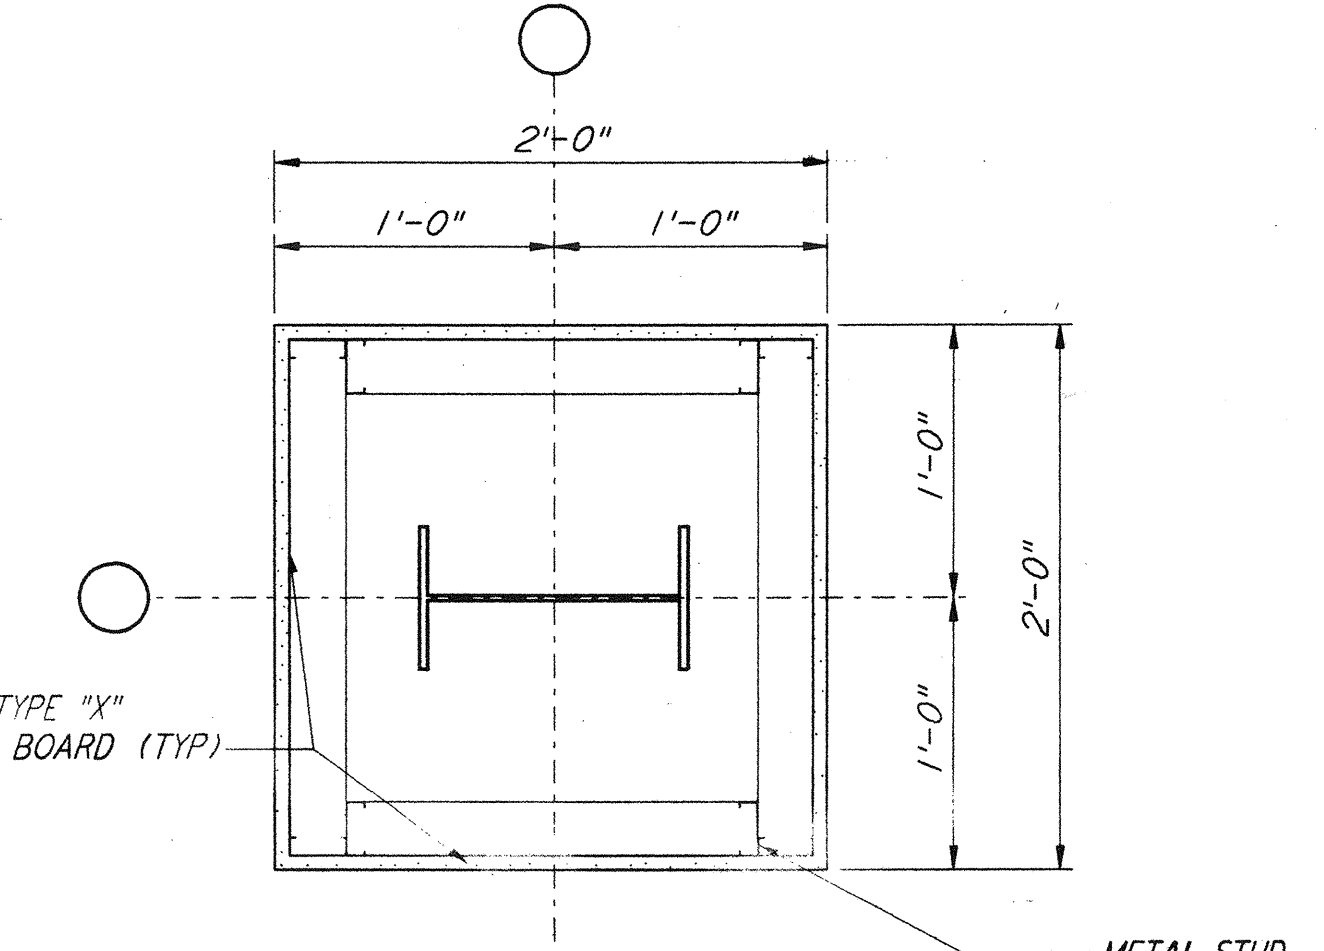


COLUMN FURRING DETAIL (3) REF
 1 1/2" = 1'-0" LA-A-422 LA-A-109

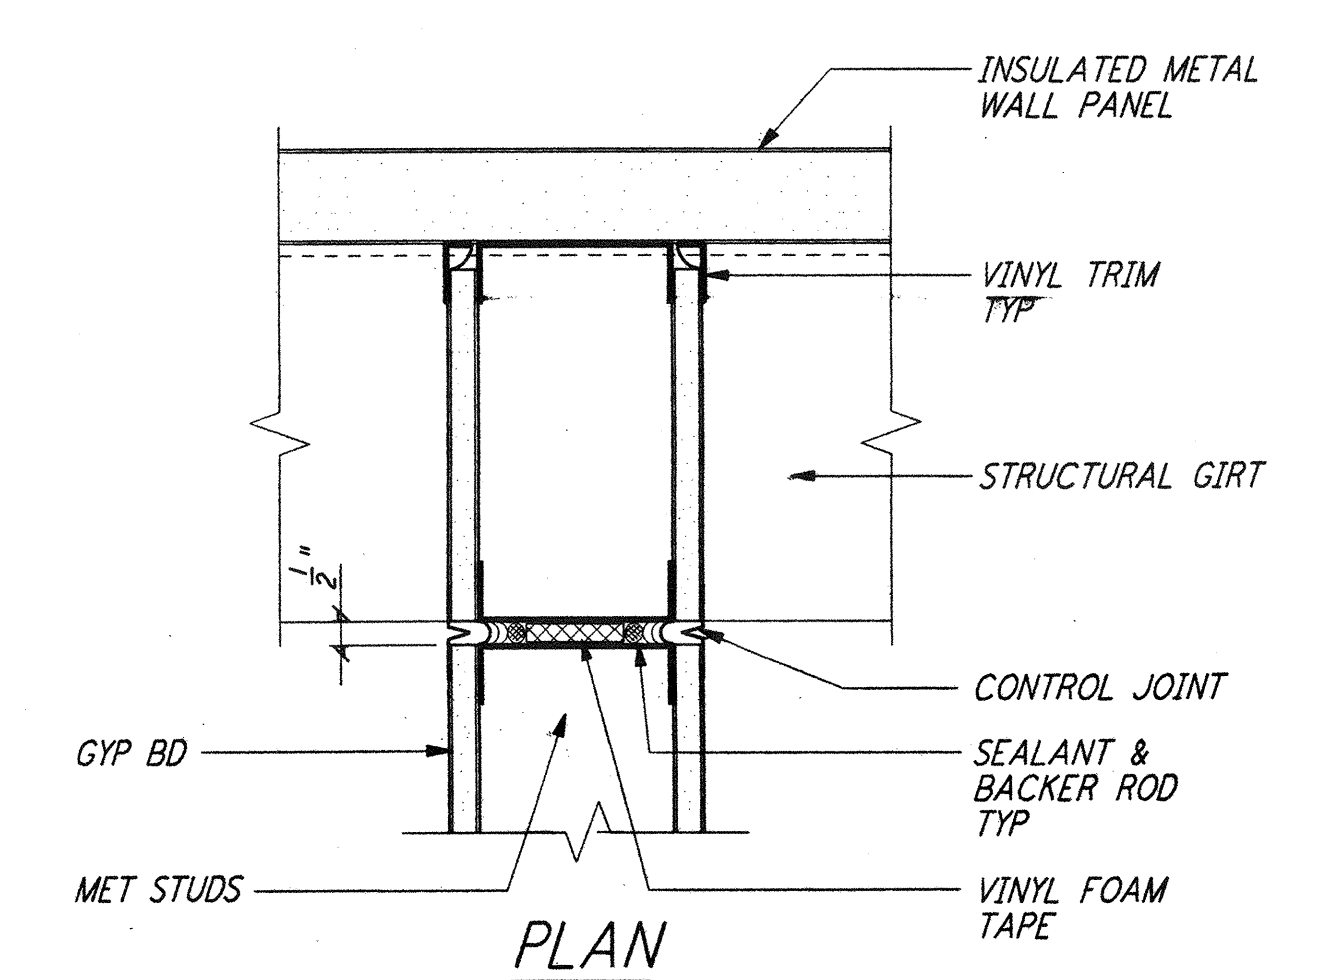


WALL DETAIL @ HORIZ GIRT (20) REF
 3" = 1'-0" LA-A-422 LA-A-112

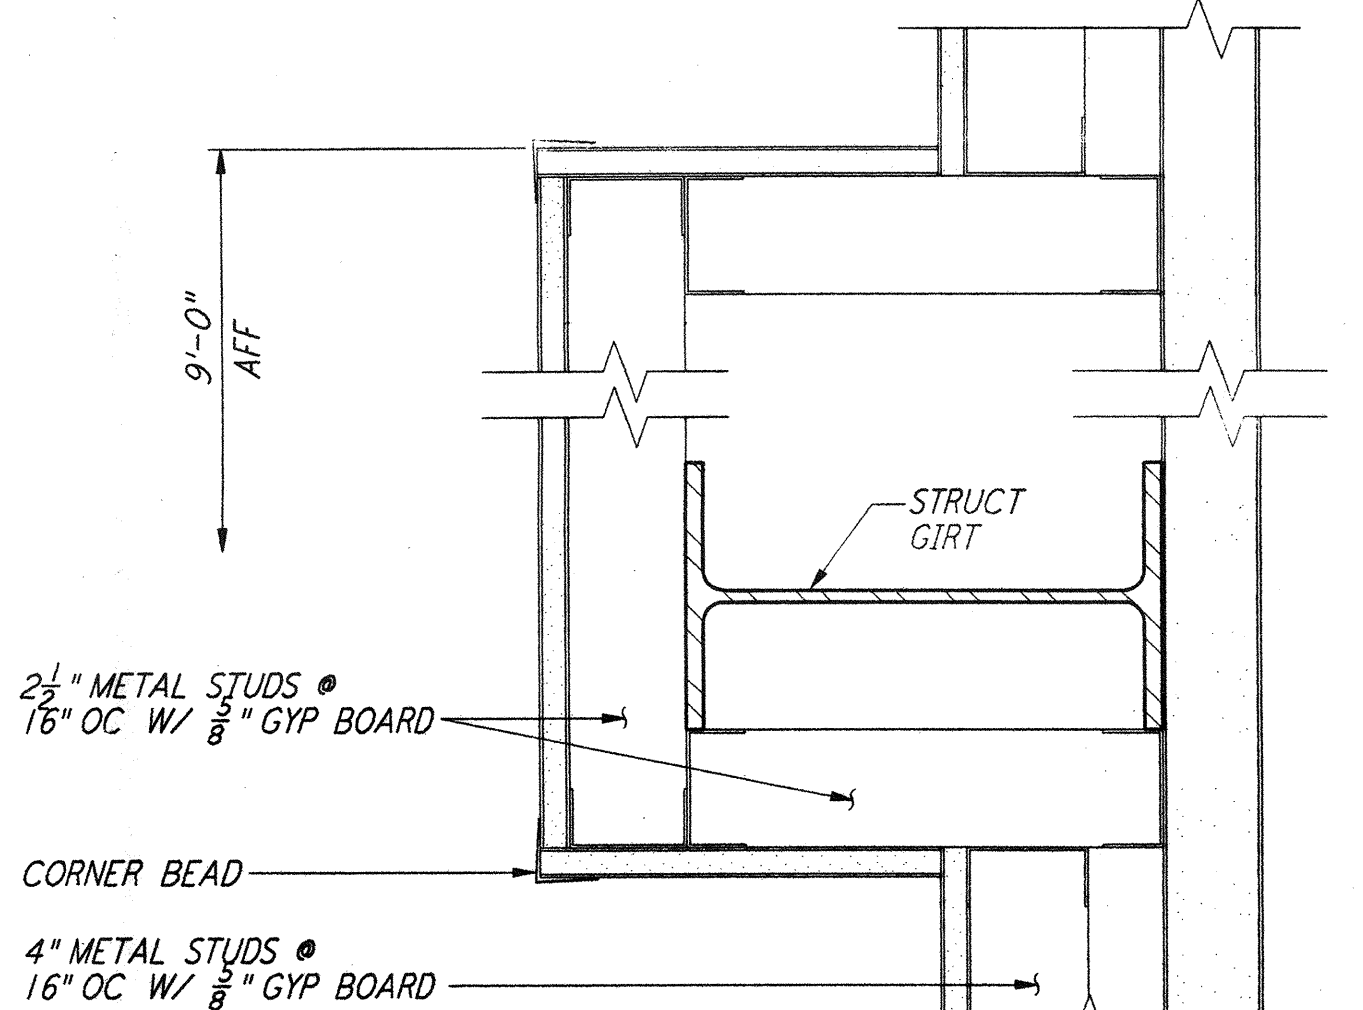


FURRING AT GIRT (16) REF
 3" = 1'-0" LA-A-422 LA-A-162

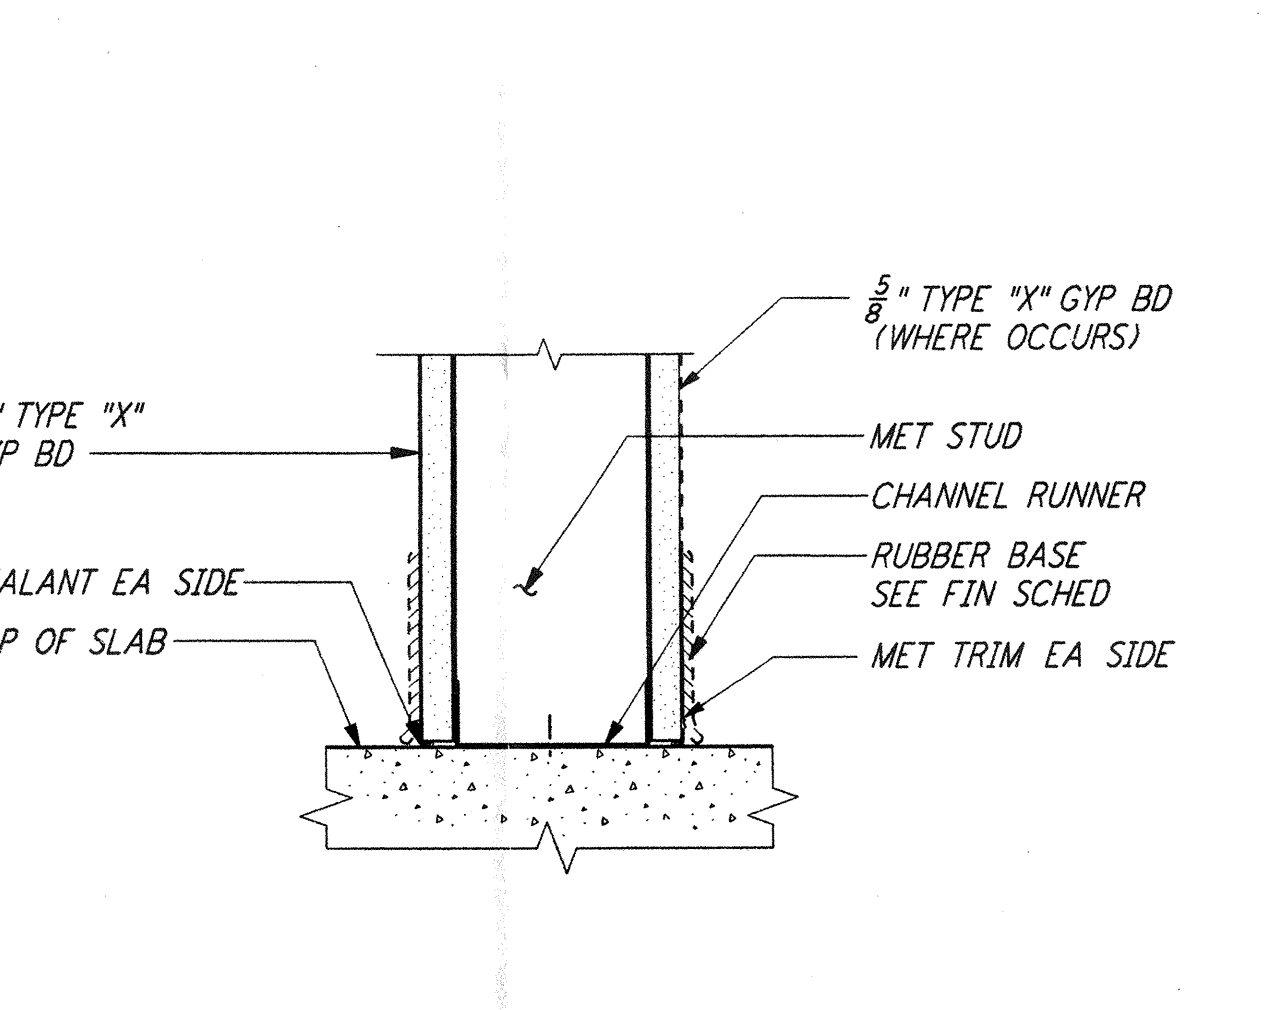

STUD WALL @ BASE (12) REF
 3" = 1'-0" LA-A-422 LA-A-161

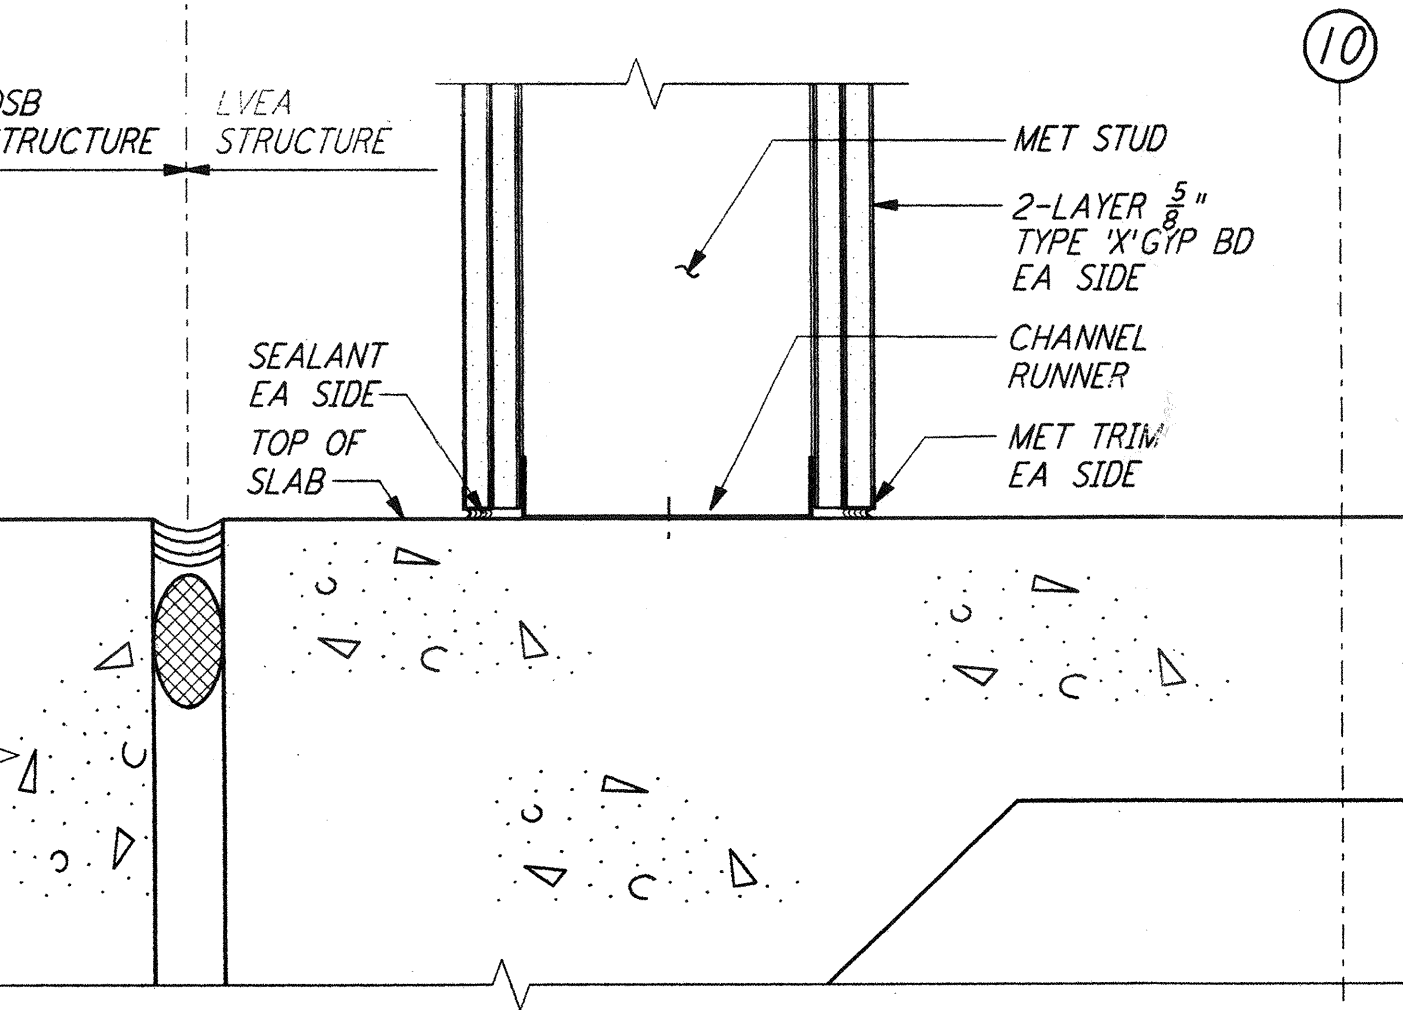

2-HR WALL @ BASE (8) REF
 3" = 1'-0" LA-A-422 LA-A-162

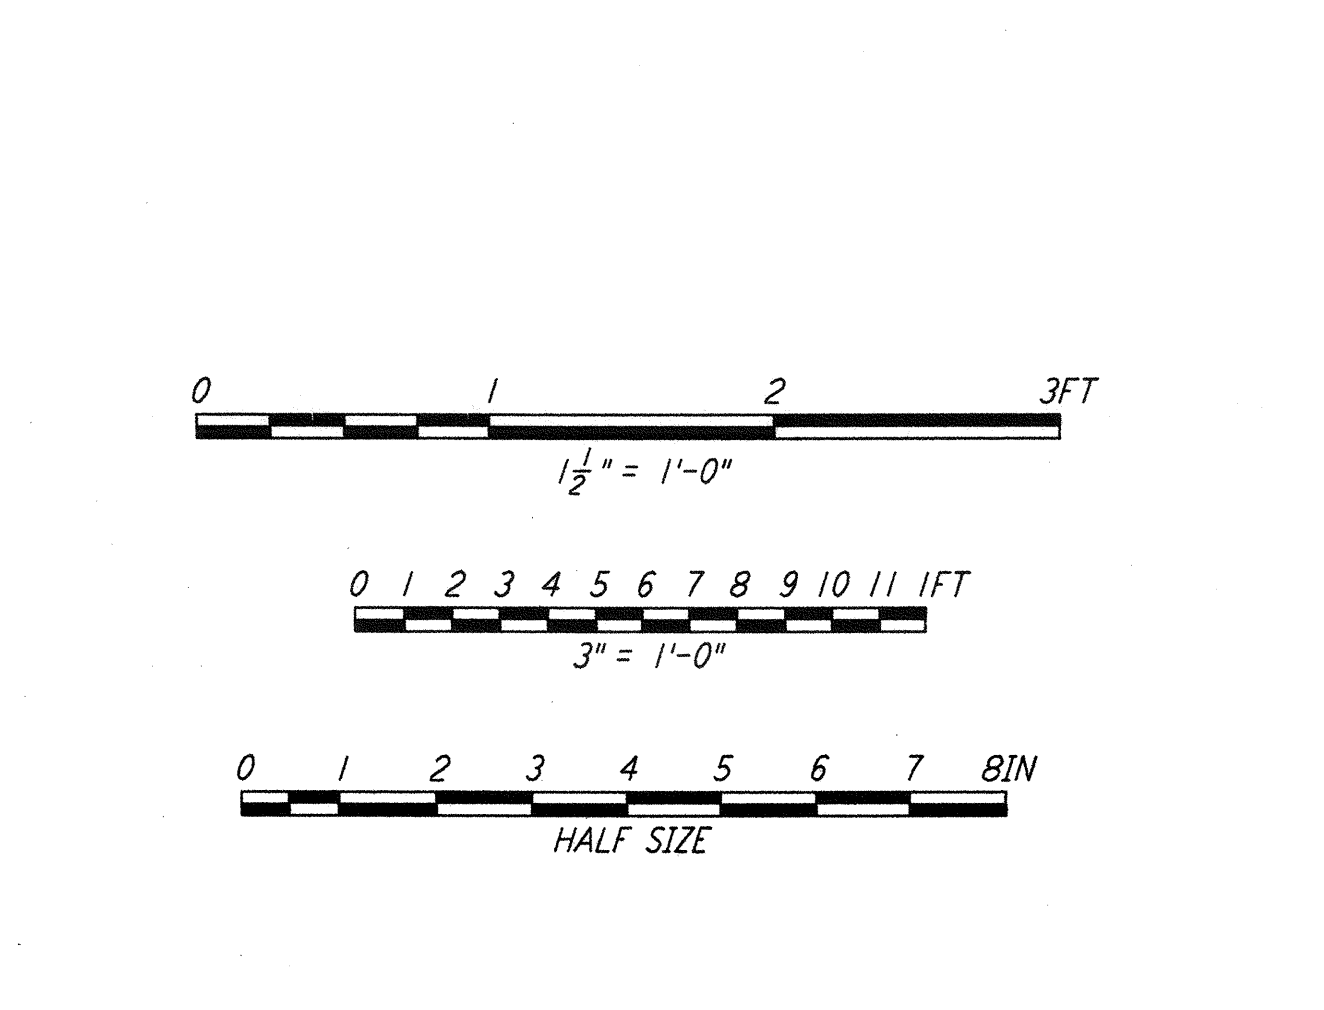

This document and the design it covers are the property of PARSONS. They are loaned only with the borrower's expressed written agreement that they will not be reproduced, copied, loaned, exhibited, or used in any other way, except by written consent from PARSONS to the borrower.

ISSUED FOR CONSTRUCTION	11-15-96
DRAWN	BK/RR
CHECKED	TB
ENGINEER	SF
PROJ	MDW

AS-BUILT DRAWINGS



100 WEST WALNUT STREET
 PASADENA, CALIFORNIA



CALIFORNIA INSTITUTE OF TECHNOLOGY
 MASSACHUSETTS INSTITUTE OF TECHNOLOGY

LASER INTERFEROMETER
 GRAVITATIONAL-WAVE OBSERVATORY
 SITE NO. 2 - LIVINGSTON, LOUISIANA

TITLE	SCALE	CONTRACT NUMBER	PROJECT NUMBER
ARCHITECTURAL INTERIOR WALL DETAILS	AS NOTED	PP150969	8094
SHEET NUMBER	LA-A-422		REVISIONS

NO.	DATE	BY	CHKD	ENGR	PROJ	DESCRIPTION
2	08-07-98	SJM	AKT	KRM	TDM	ISSUED FOR AS-BUILT
1	2-28-97	CKT	TB	AK	TDM	CORNER STATION VSEA PARTITION

LIGO-D960899-02-0