



### WALL TYPE SCHEDULE

### WALL TYPES LEGEND

WALL KEY	DETAIL PLAN	DESCRIPTION	WALL KEY	DETAIL PLAN	DESCRIPTION	WALL KEY	DETAIL PLAN	DESCRIPTION
18		EXTERIOR INSULATED METAL WALL PANELS (VERTICAL)	11		6" METAL STUDS 5/8" GYPSUM BOARD	4		4" METAL STUD 5/8" GYPSUM BOARD
19		7/8" SMOOTH PLASTER OVER METAL LATH 1/2" PLYWOOD 8" METAL STUDS 1/2" PLYWOOD 7/8" SMOOTH PLASTER OVER METAL LATH	12		6" METAL STUDS 1/4" CERAMIC TILE 1" GROUT/BACKER BOARD	5		( WIRE WHERE INSULATION OCCURS ) 4" METAL STUDS 1" GROUT/BACKER BOARD 1/4" CERAMIC TILE
20			13		5/8" GYPSUM BOARD 6" METAL STUDS 1" GROUT/BACKER BOARD 1/4" CERAMIC TILE	6		5/8" GYPSUM BOARD 4" METAL STUD 5/8" GYPSUM BOARD
21			14		1/4" CERAMIC TILE 1" GROUT/BACKER BOARD 6" METAL STUDS 1" GROUT/BACKER BOARD 1/4" CERAMIC TILE	7		5/8" GYPSUM BOARD 4" METAL STUD 1" GROUT/BACKER BOARD 1/4" CERAMIC TILE
22			15		6" METAL STUDS 5/8" GYPSUM BOARD 5/8" GYPSUM BOARD	8		4" METAL STUD 5/8" GYPSUM BOARD 5/8" GYPSUM BOARD
23			16		5/8" GYPSUM BOARD 6" METAL STUDS 5/8" GYPSUM BOARD	9		5/8" GYPSUM BOARD 5/8" GYPSUM BOARD 4" METAL STUD 5/8" GYPSUM BOARD 5/8" GYPSUM BOARD
24			17		5/8" GYPSUM BOARD 5/8" GYPSUM BOARD 6" METAL STUDS 5/8" GYPSUM BOARD 5/8" GYPSUM BOARD	10		5/8" GYPSUM BOARD 5/8" GYPSUM BOARD 4" METAL STUD 5/8" GYPSUM BOARD 1" GROUT/BACKER BOARD 1/4" CERAMIC TILE

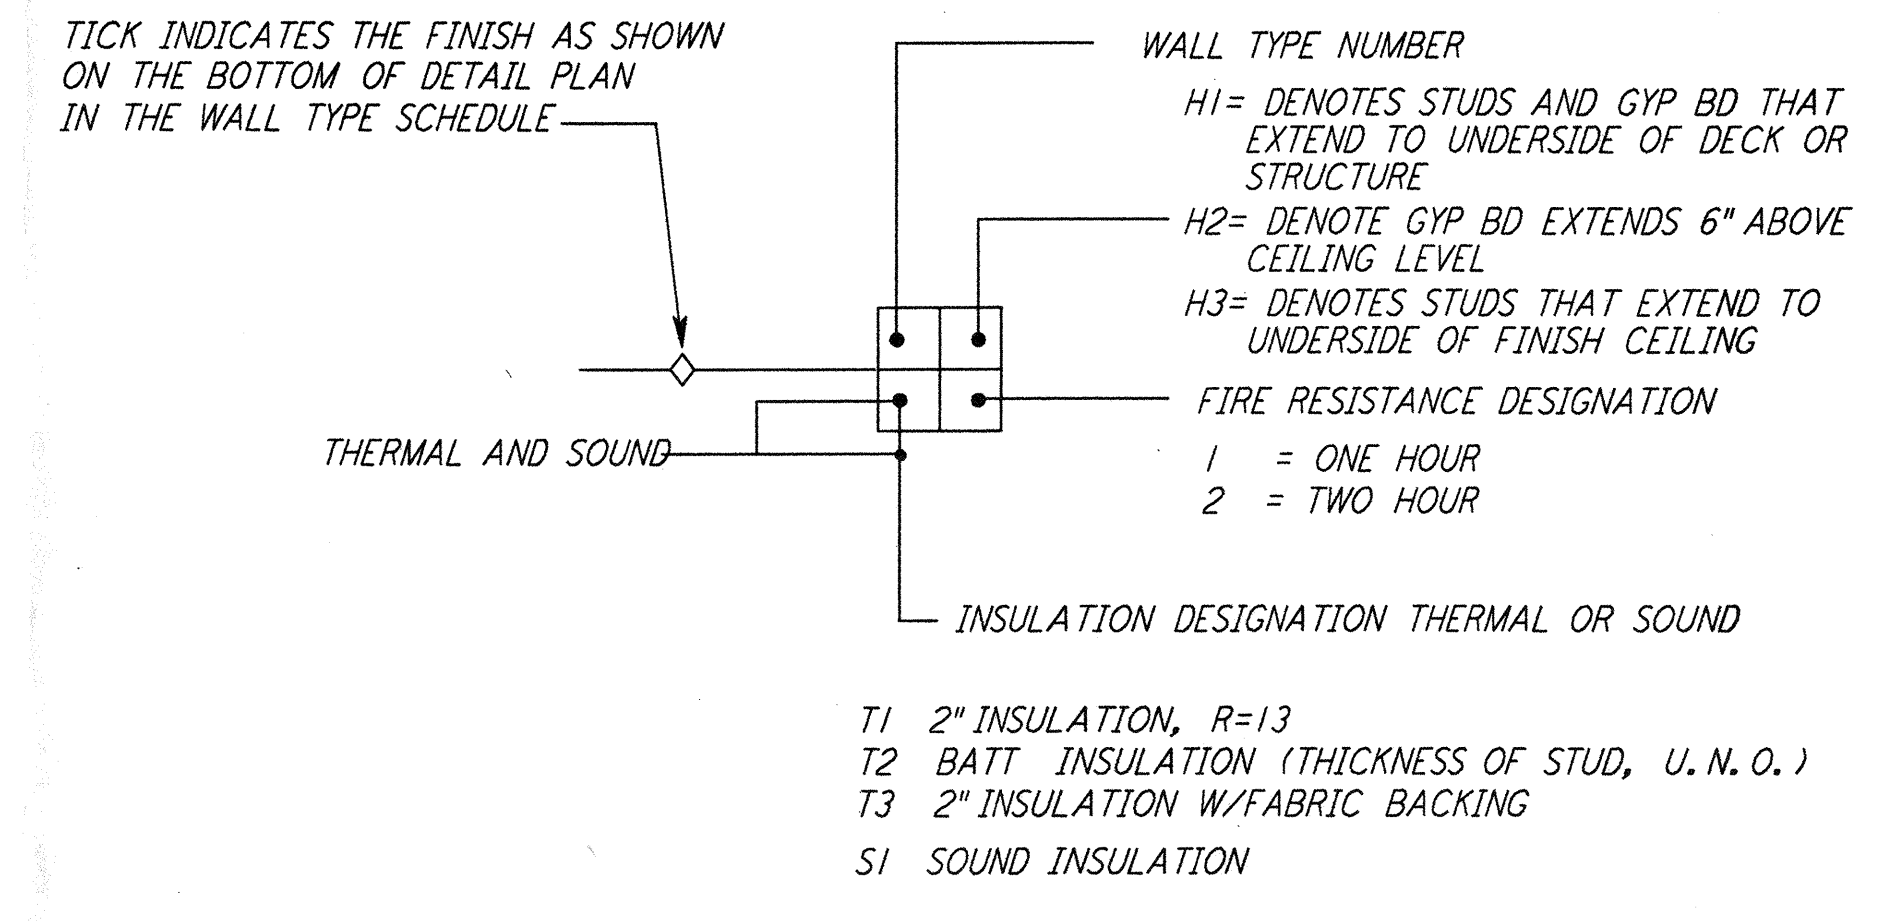

**NOTE :**  
 INDICATED INSULATION VALUES FOR THERMAL AND SOUND ARE THE MINIMUM REQUIRED VALUES

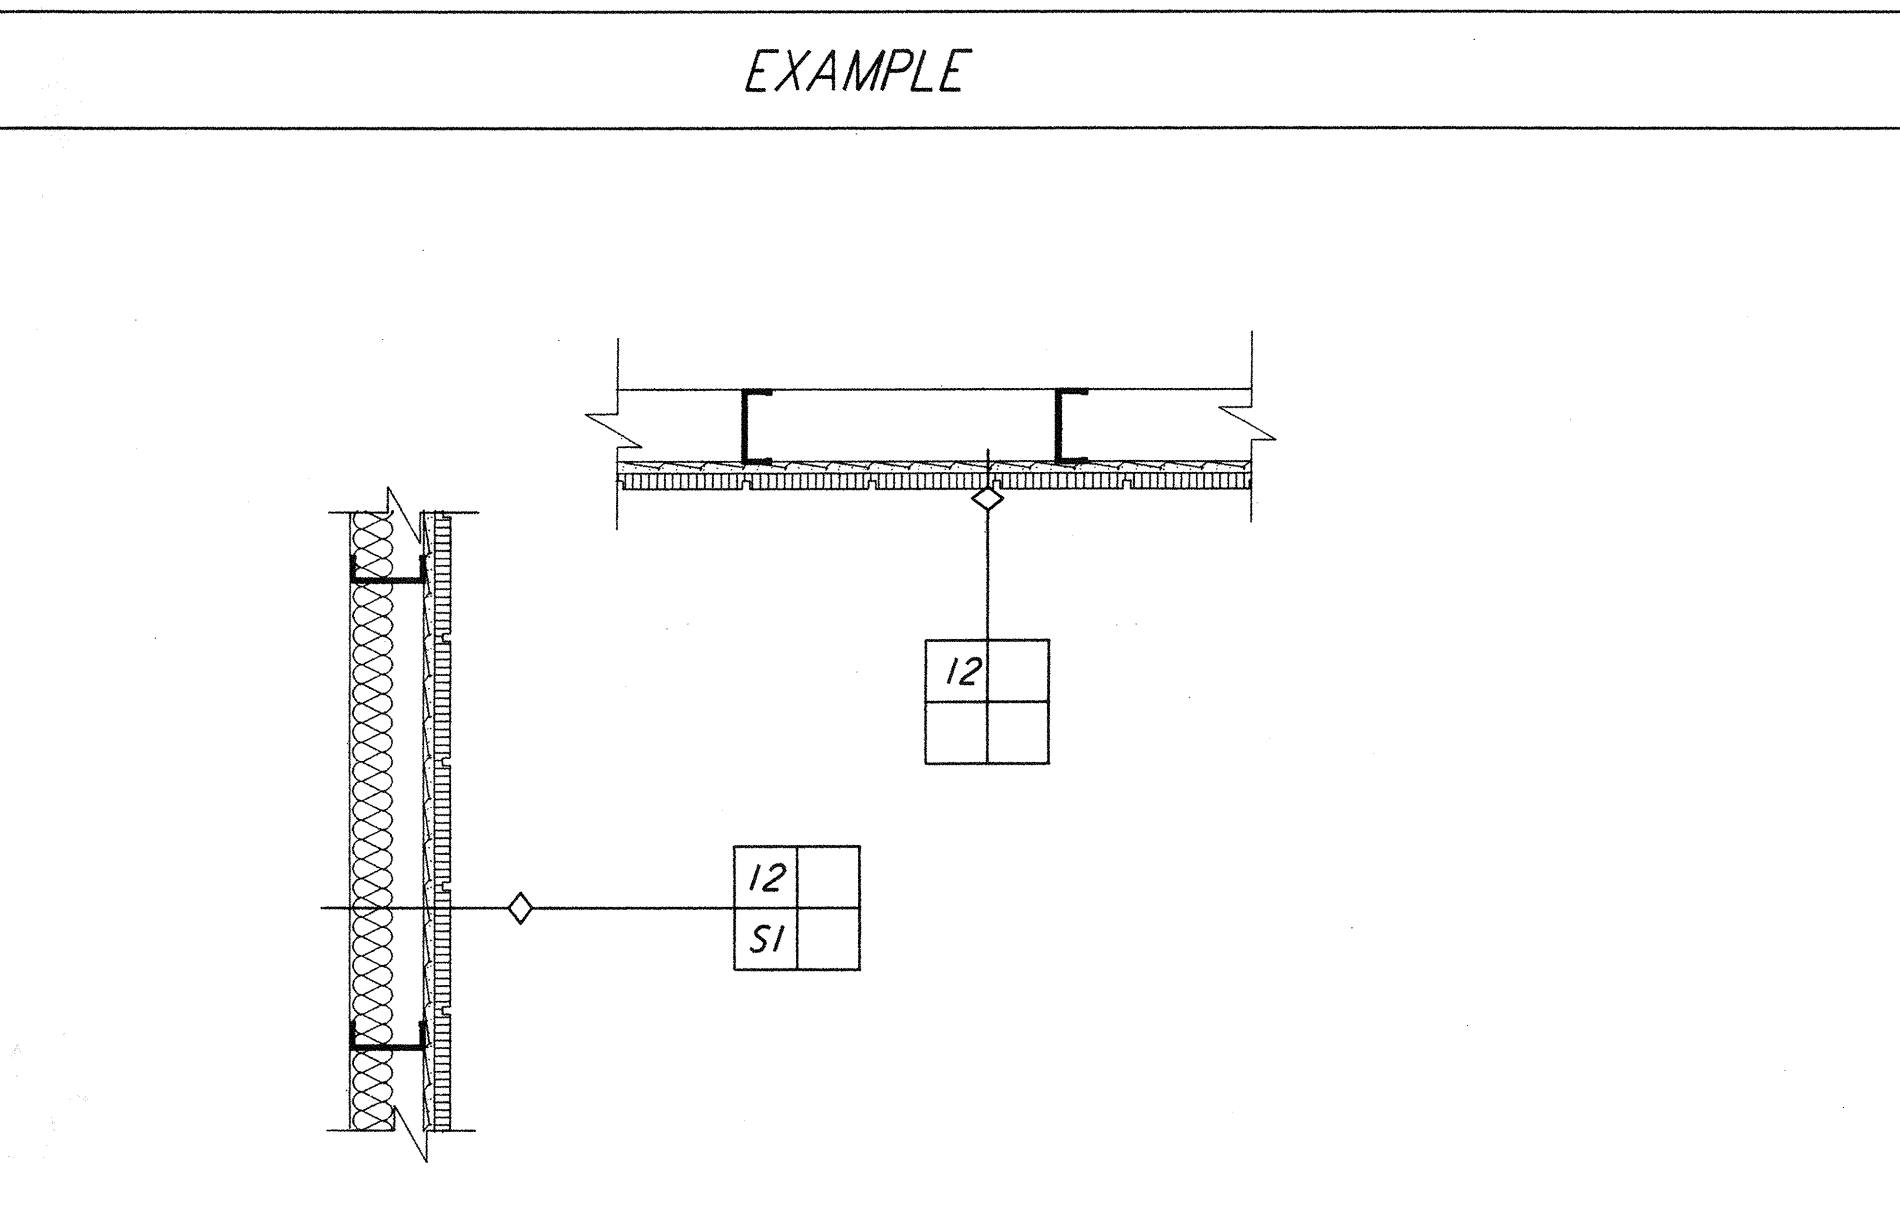

WALL KEY	DETAIL PLAN	DESCRIPTION
1		2 1/2" METAL STUD 5/8" GYPSUM BOARD
2		5/8" GYPSUM BOARD 2 1/2" METAL STUD 5/8" GYPSUM BOARD
3		( WIRE WHERE INSULATION OCCURS ) 2 1/2" METAL STUDS 1" GROUT/BACKER BOARD 1/4" CERAMIC TILE

This document and the design it covers are the property of PARSONS. They are loaned only with the borrower's expressed written agreement that they will not be reproduced, copied, loaned, exhibited, or used in any other way, except by written consent from PARSONS to the borrower.

ISSUED FOR CONSTRUCTION	CKT	11-15-96
DRAWN	TB	11-15-96
CHECKED	SF	11-15-96
ENGINEER	MDW	11-15-96
PROJ		

**AS-BUILT DRAWINGS**

100 WEST WALNUT STREET  
 PASADENA, CALIFORNIA

CALIFORNIA INSTITUTE OF TECHNOLOGY  
 MASSACHUSETTS INSTITUTE OF TECHNOLOGY

**LIGO-D960905-02-O**

LASER INTERFEROMETER  
 GRAVITATIONAL-WAVE OBSERVATORY  
 SITE NO. 2 - LIVINGSTON, LOUISIANA

TITLE	SCALE	CONTRACT NUMBER	PROJECT NUMBER
ARCHITECTURAL WALL TYPE SCHEDULES		PP150969	8094
SHEET NUMBER	REVISIONS		
LA-A-428			

NO.	DATE	BY	CHKD	ENGR	PROJ	DESCRIPTION
2	08-07-98	SJM	CKT	AK	TDM	ISSUED FOR AS-BUILT
1	2-28-97	CKT	TB	AK	TDM	CORNER STATION VSEA PARTITION