




This document and the design it covers are the property of PARSONS. They are loaned only with the borrower's expressed written agreement that they will not be reproduced, copied, loaned, exhibited, or used in any other way, except by written consent from PARSONS to the borrower.

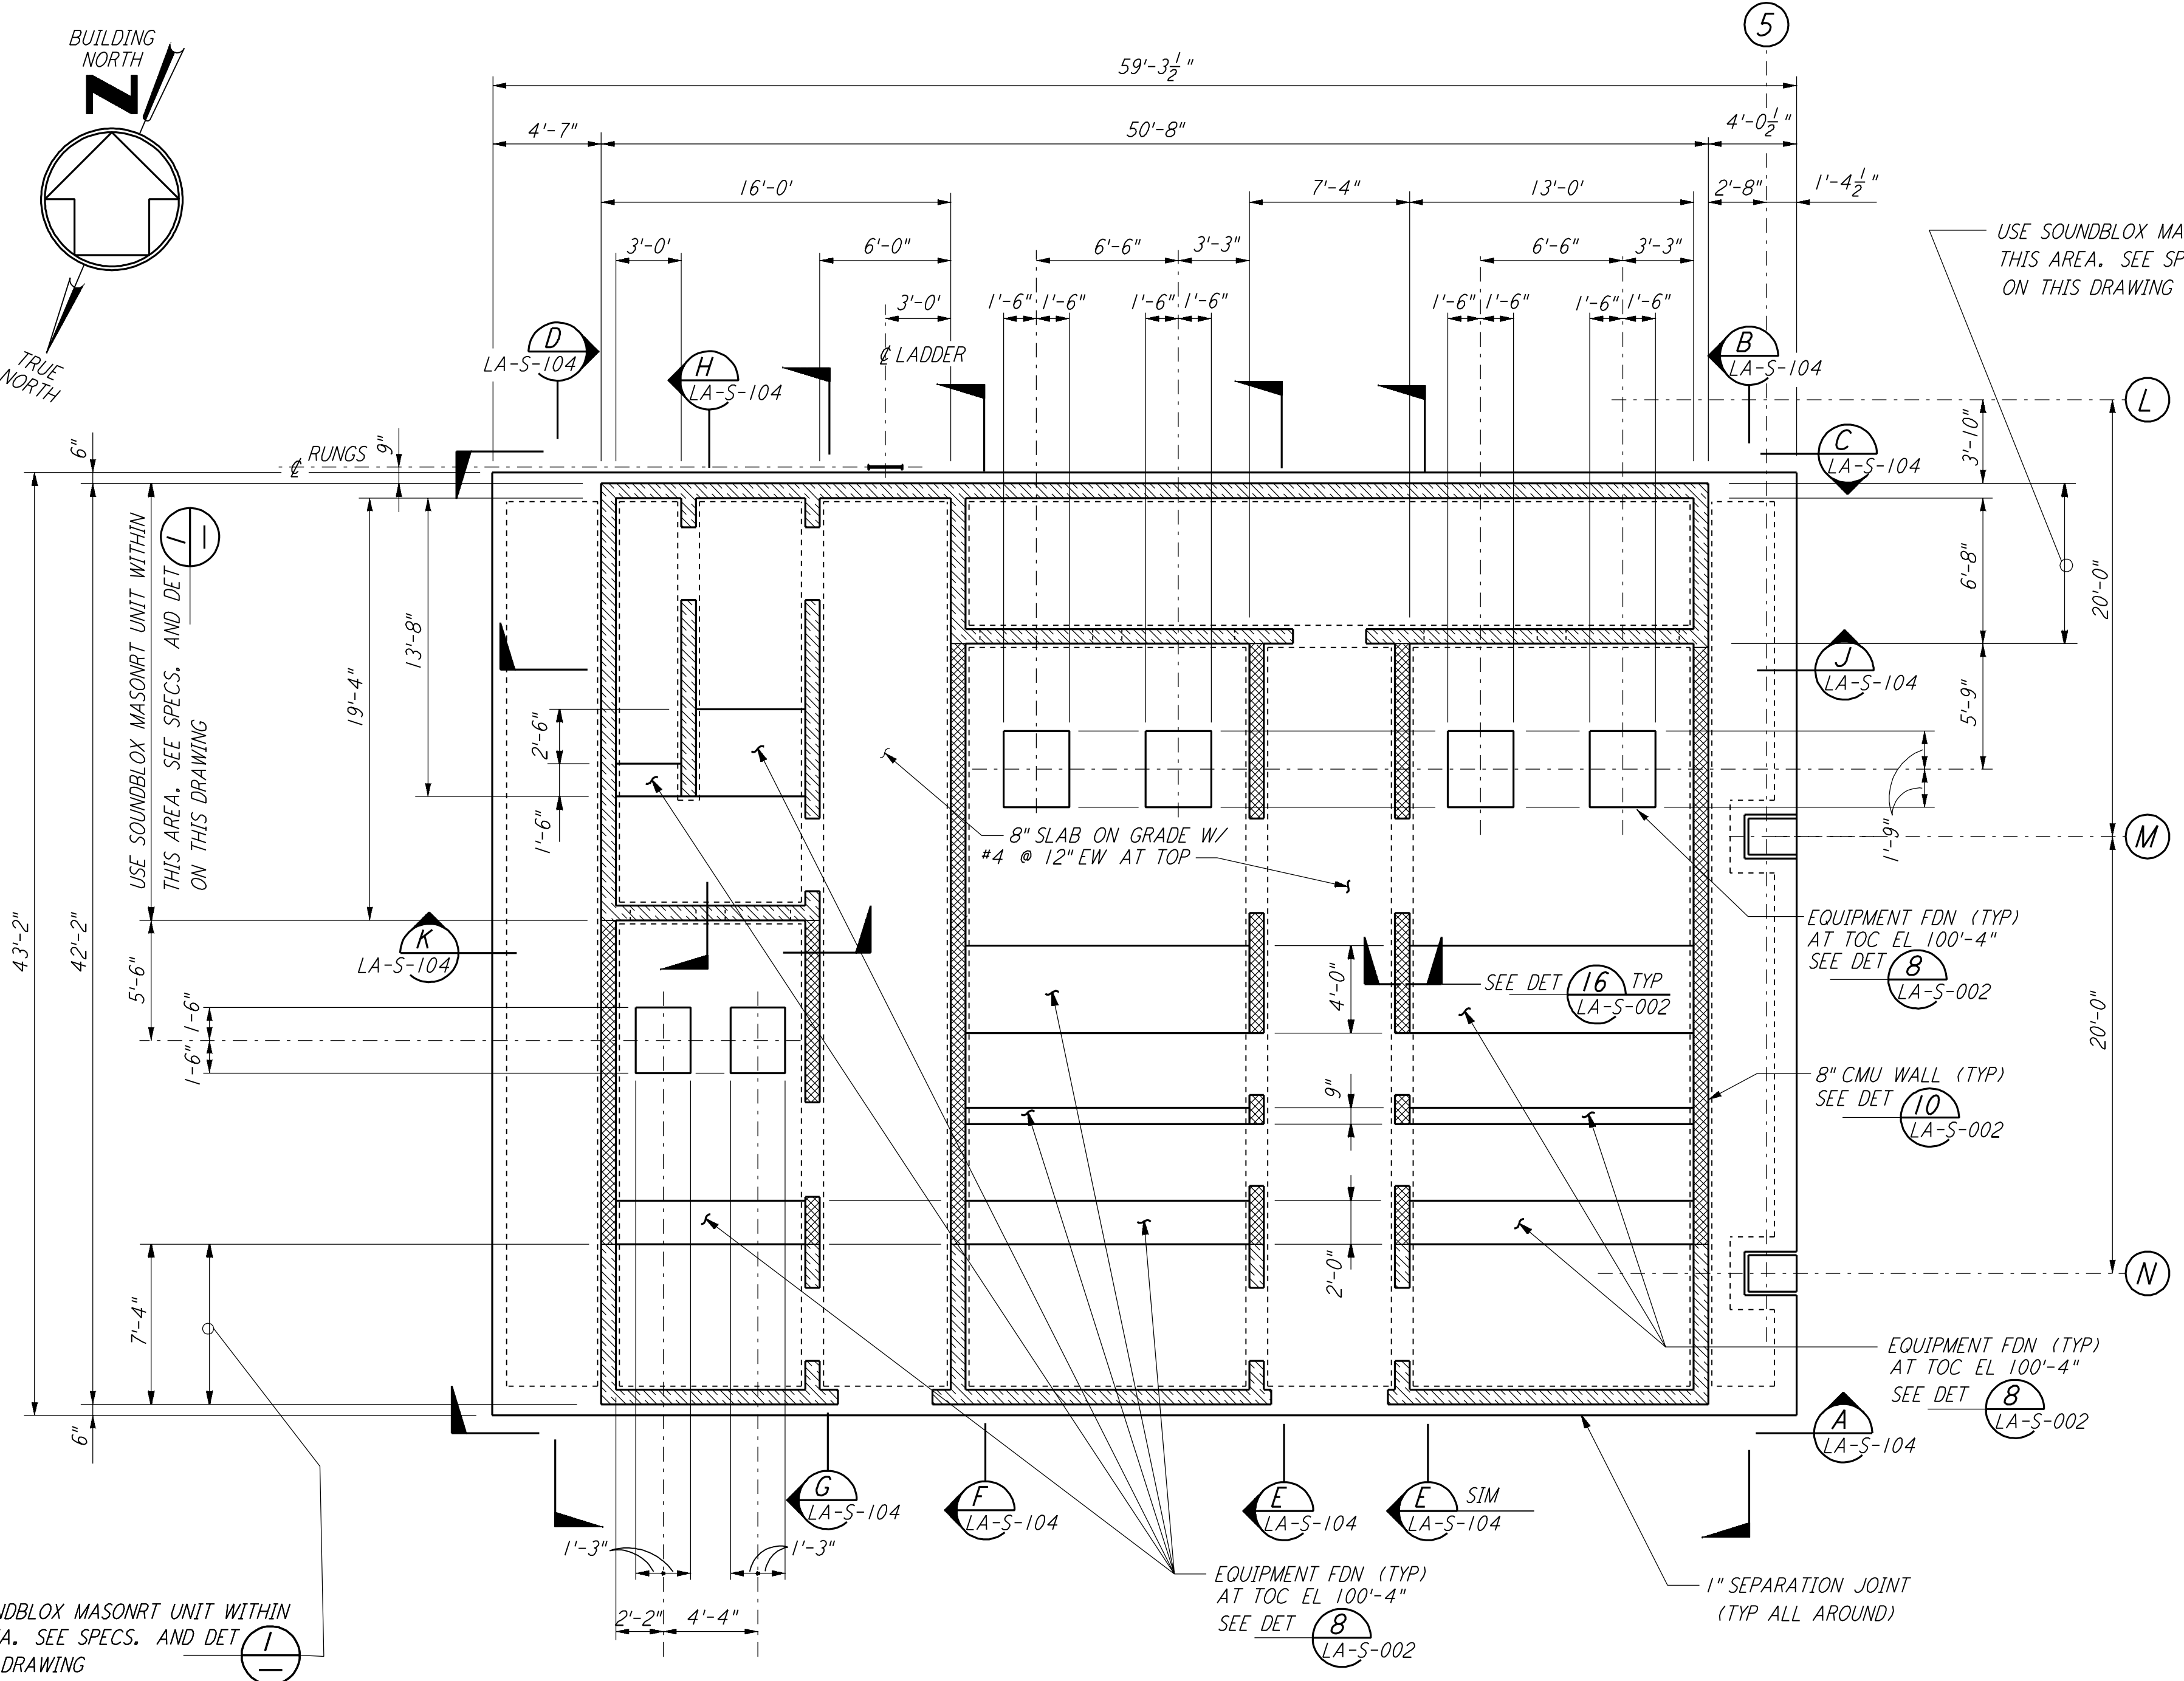


**AIR HANDLING UNIT STRUCTURE  
 FOUNDATION PLAN**  
 $\frac{3}{16}'' = 1'-0''$

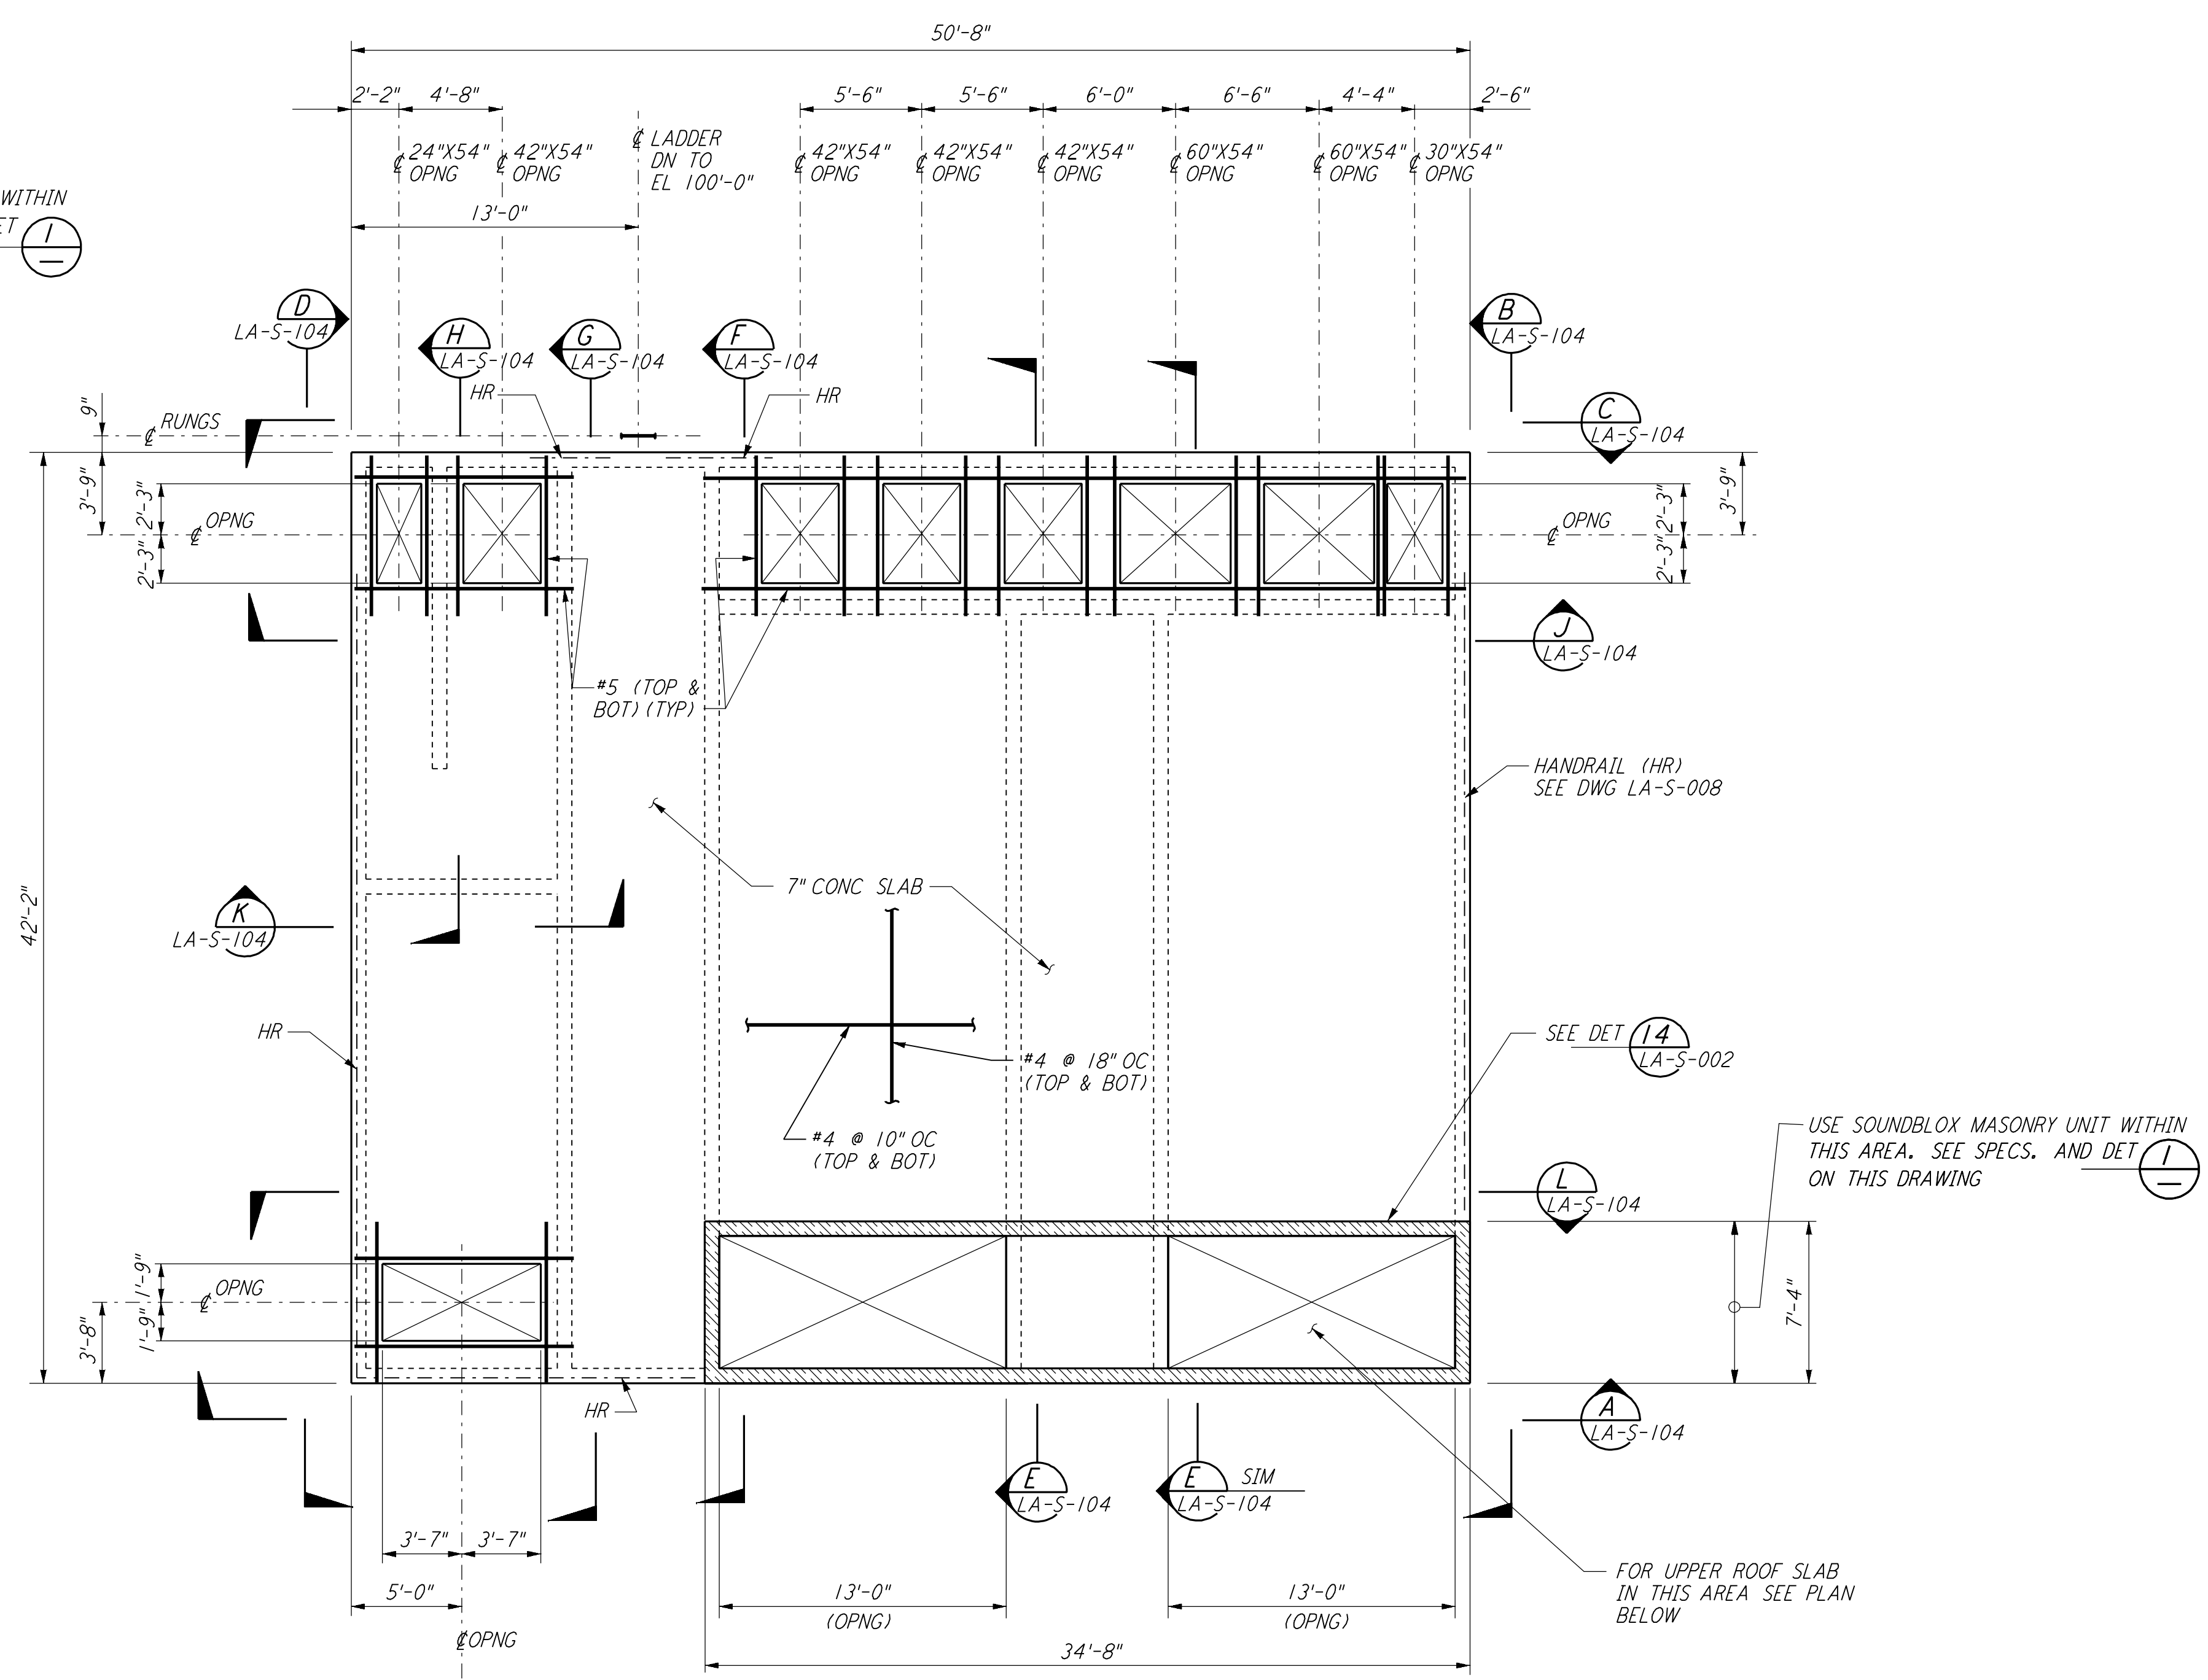

**AIR HANDLING UNIT STRUCTURE  
 LOWER CONCRETE ROOF SLAB PLAN**  
 $\frac{3}{16}'' = 1'-0''$   
 TOC EL 110'-7''

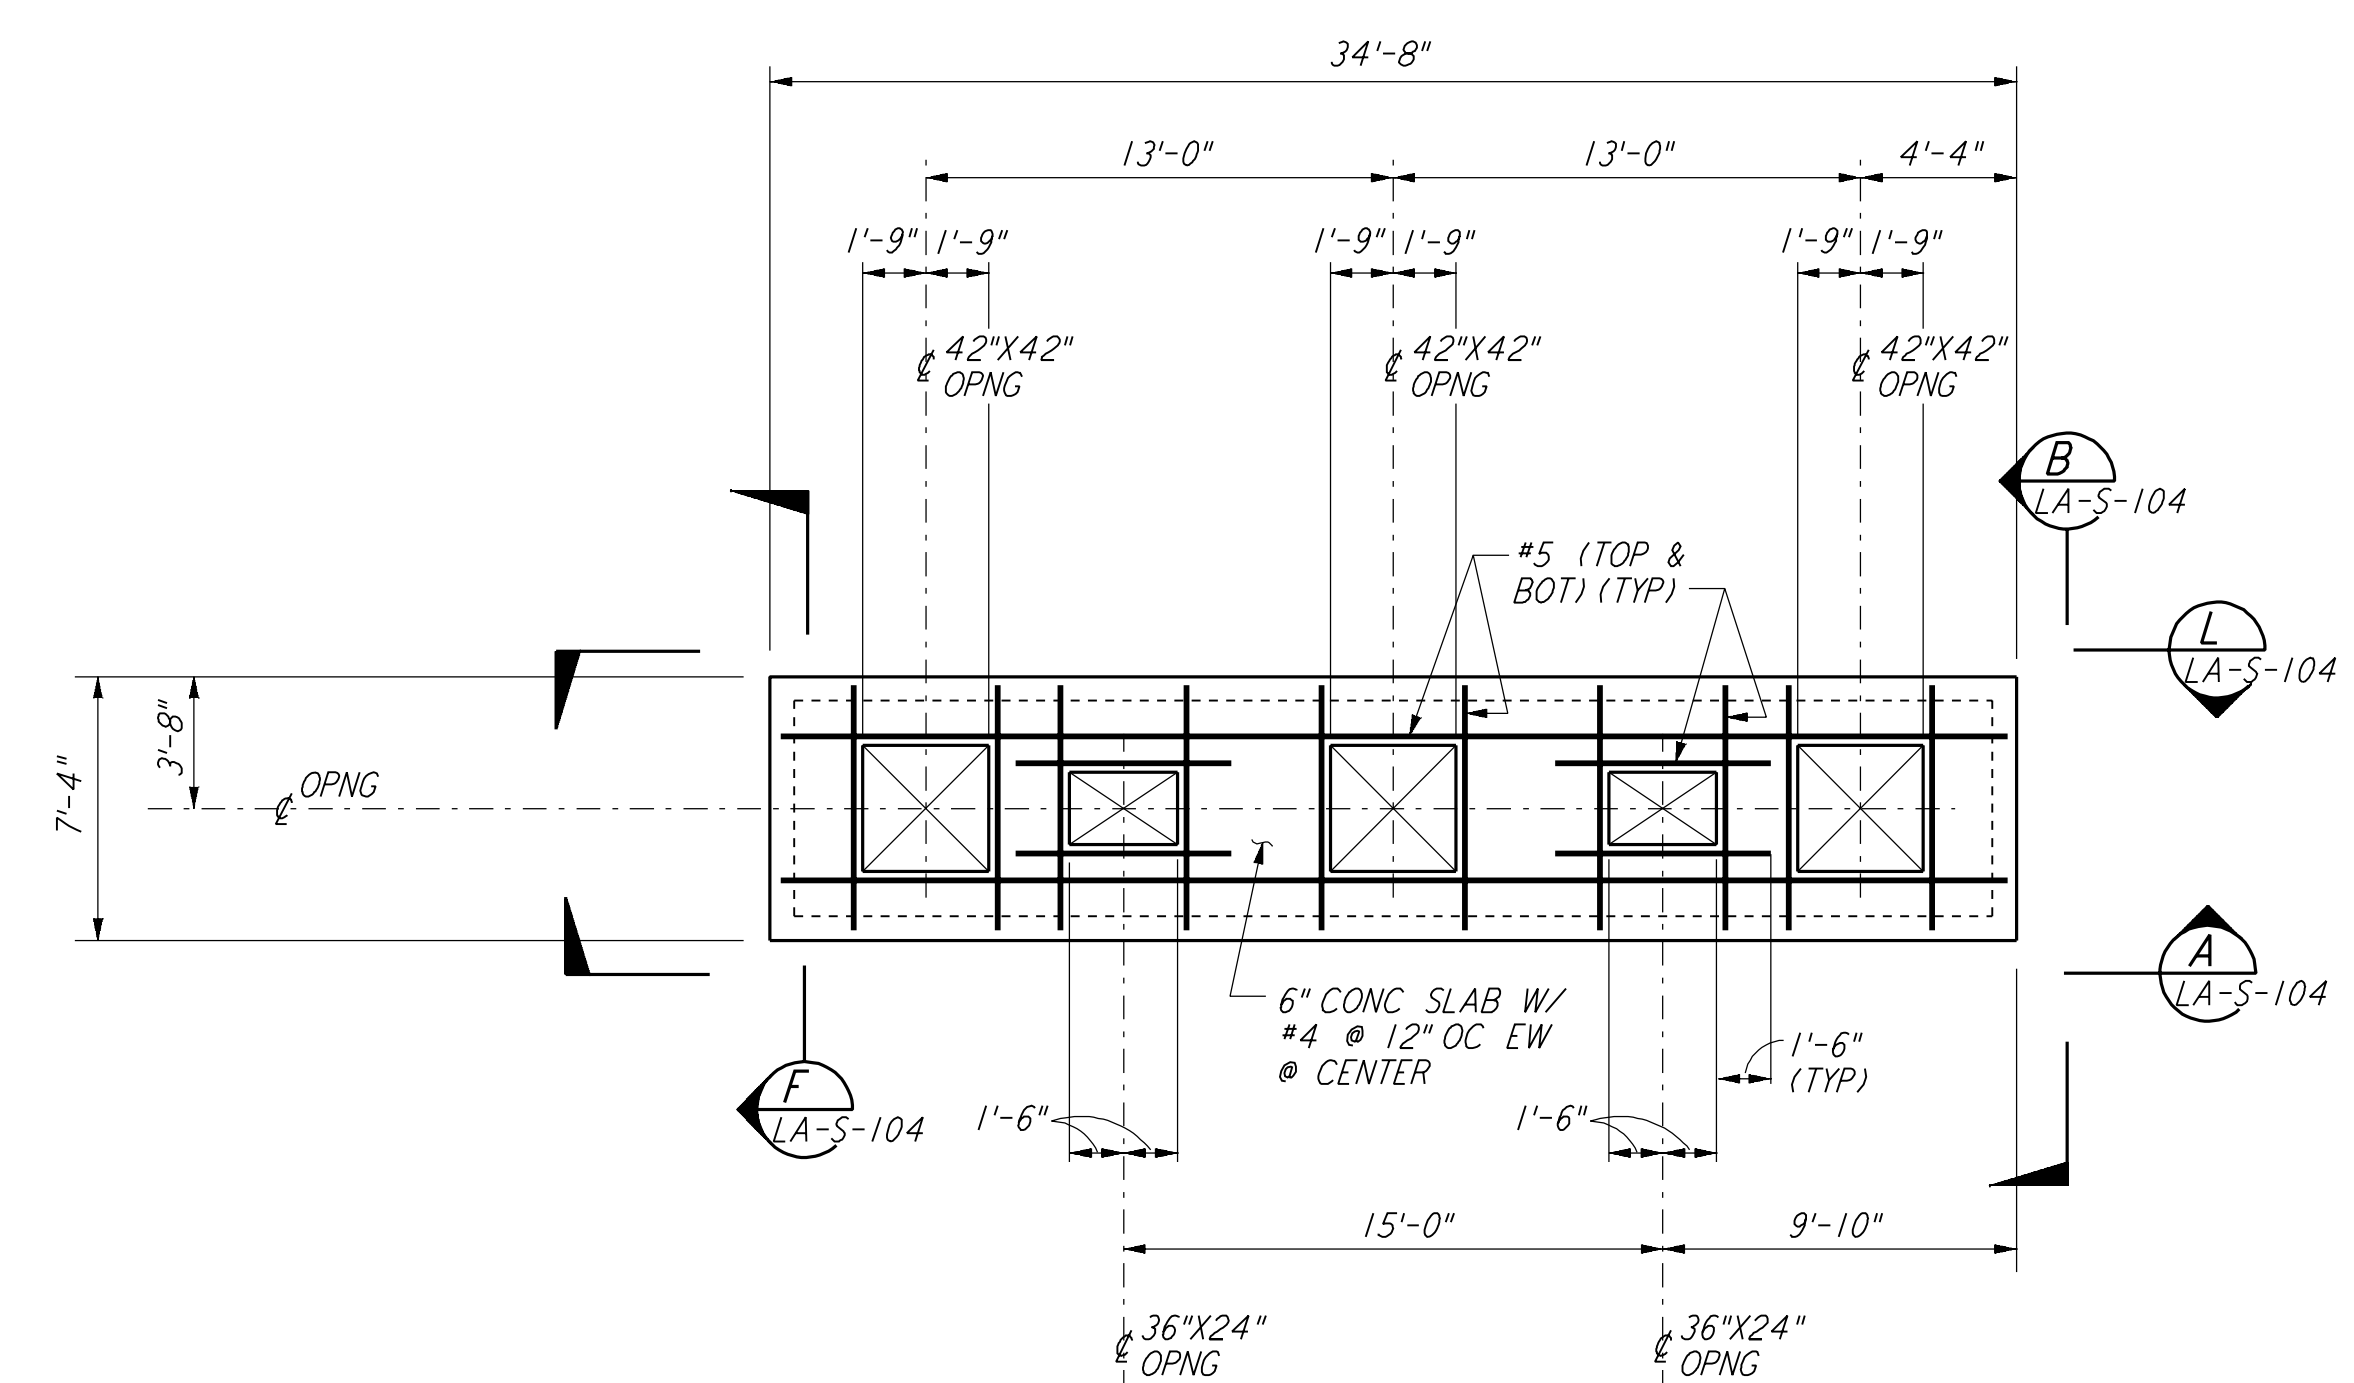


**AIR HANDLING UNIT STRUCTURE  
 UPPER CONCRETE ROOF SLAB PLAN**  
 $\frac{3}{16}'' = 1'-0''$   
 TOC EL 115'-2''

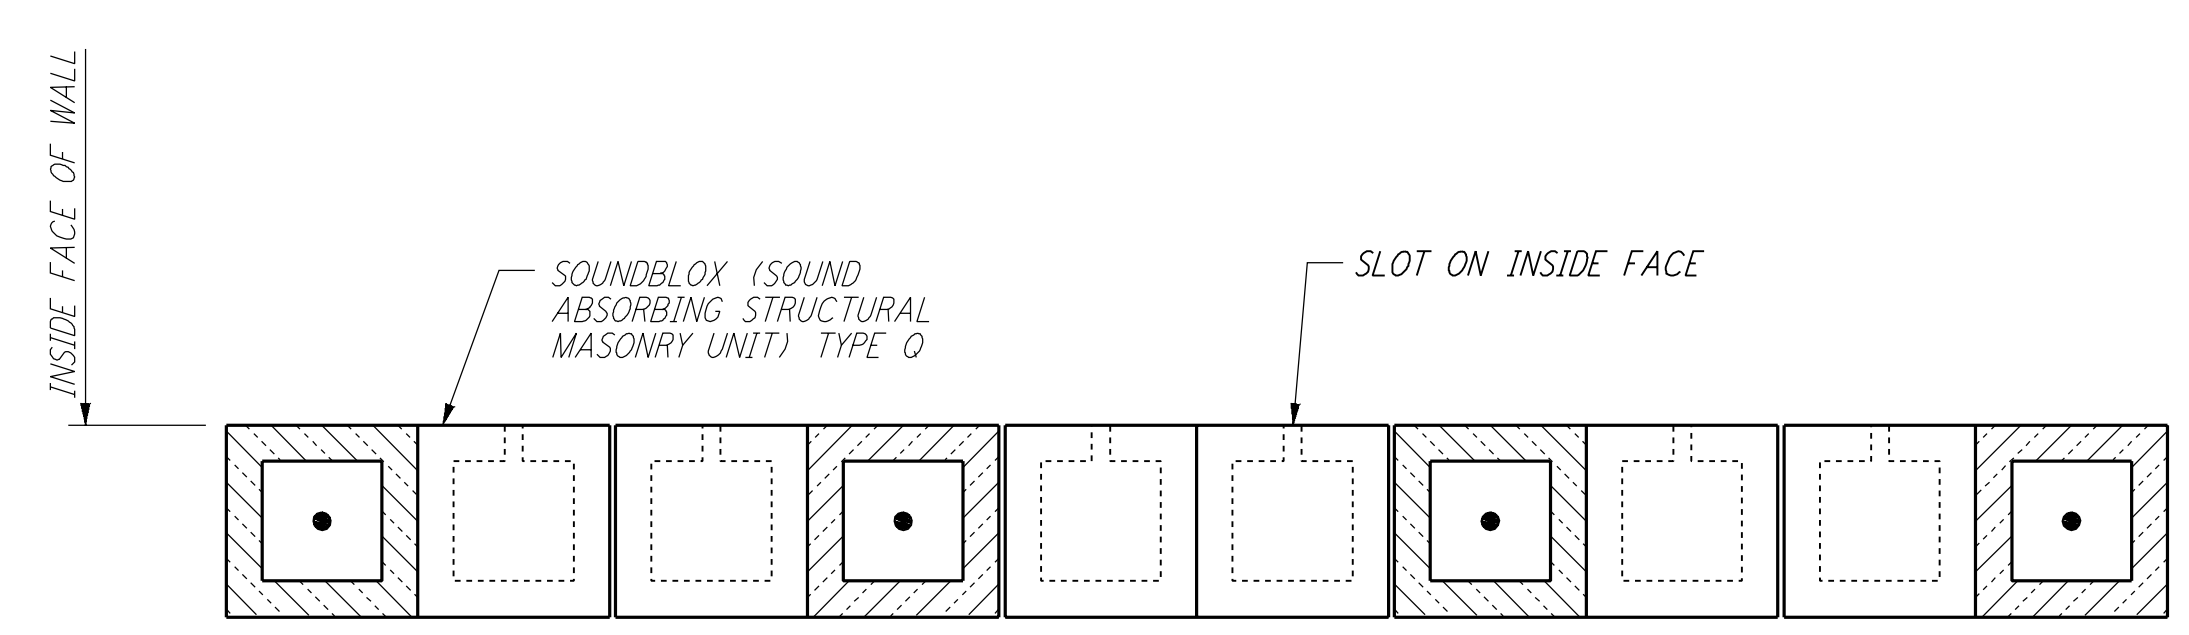

**TYPICAL SECTION OF SOUNDBLOSS MASONRY WALL  
 DETAIL**  
 $\frac{1}{2}'' = 1'-0''$

- NOTES:**
- FOR GENERAL NOTES, ABBREVIATIONS & SYMBOLS SEE DRAWING LA-S-001.
  - CONTRACTOR SHALL ADJUST LOCATION AND SIZE OF ALL EQUIPMENT PADS TO SUIT ACTUAL VENDOR EQUIPMENTS.

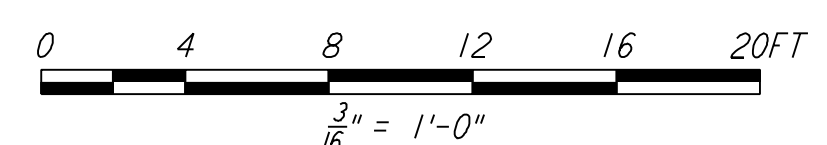

**LIGO-D960919-01-O**

NO.	DATE	BY	CHKD	ENGR	PROJ	DESCRIPTION
1	08-07-98	WA				ISSUED FOR AS-BUILT

ISSUED FOR CONSTRUCTION		
DRAWN	MCS	11-15-96
CHECKED	DDM	11-15-96
ENGINEER	BP	11-15-96
PROJ	TDM	11-15-96

**AS-BUILT DRAWINGS**

**PARSONS**  
 100 WEST WALNUT STREET  
 PASADENA, CALIFORNIA

**LIGO**  
 CALIFORNIA INSTITUTE OF TECHNOLOGY  
 MASSACHUSETTS INSTITUTE OF TECHNOLOGY

LASER INTERFEROMETER  
 GRAVITATIONAL-WAVE OBSERVATORY  
 SITE NO. 2 - LIVINGSTON, LOUISIANA

**STRUCTURAL CORNER STATION AIR HANDLING UNIT ENCLOSURE PLAN**

SCALE AS NOTED  
 CONTRACT NUMBER PP150969  
 PROJECT NUMBER 8094

**LA-S-103**