




This document and the design it covers are the property of PARSONS. They are loaned only with the borrower's expressed written agreement that they will not be reproduced, copied, loaned, exhibited, or used in any other way, except by written consent from PARSONS to the borrower.

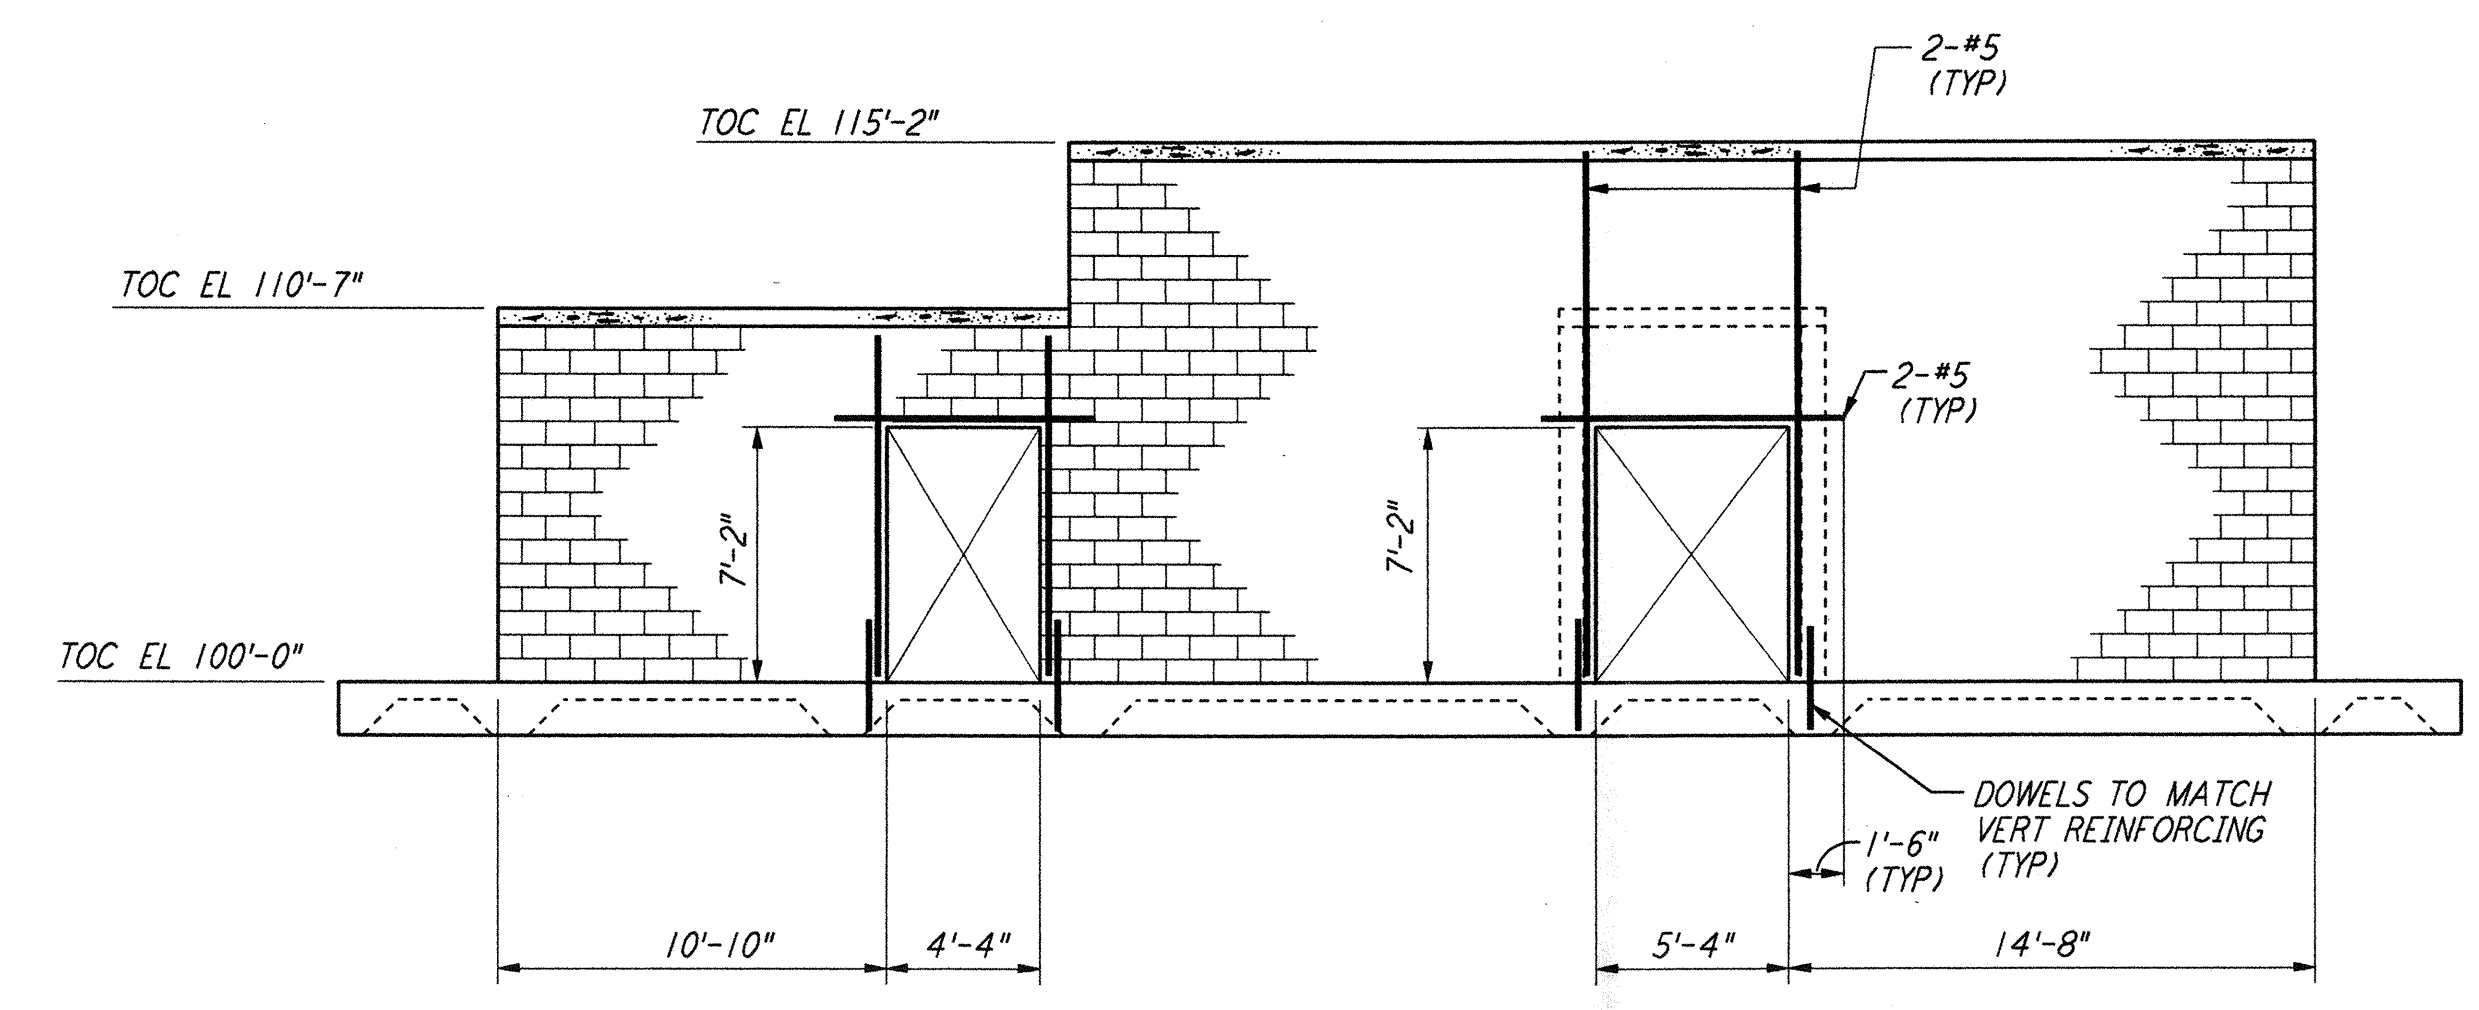


ELEVATION A REF
 $\frac{3}{8}'' = 1'-0''$
 LA-S-104 LA-S-103

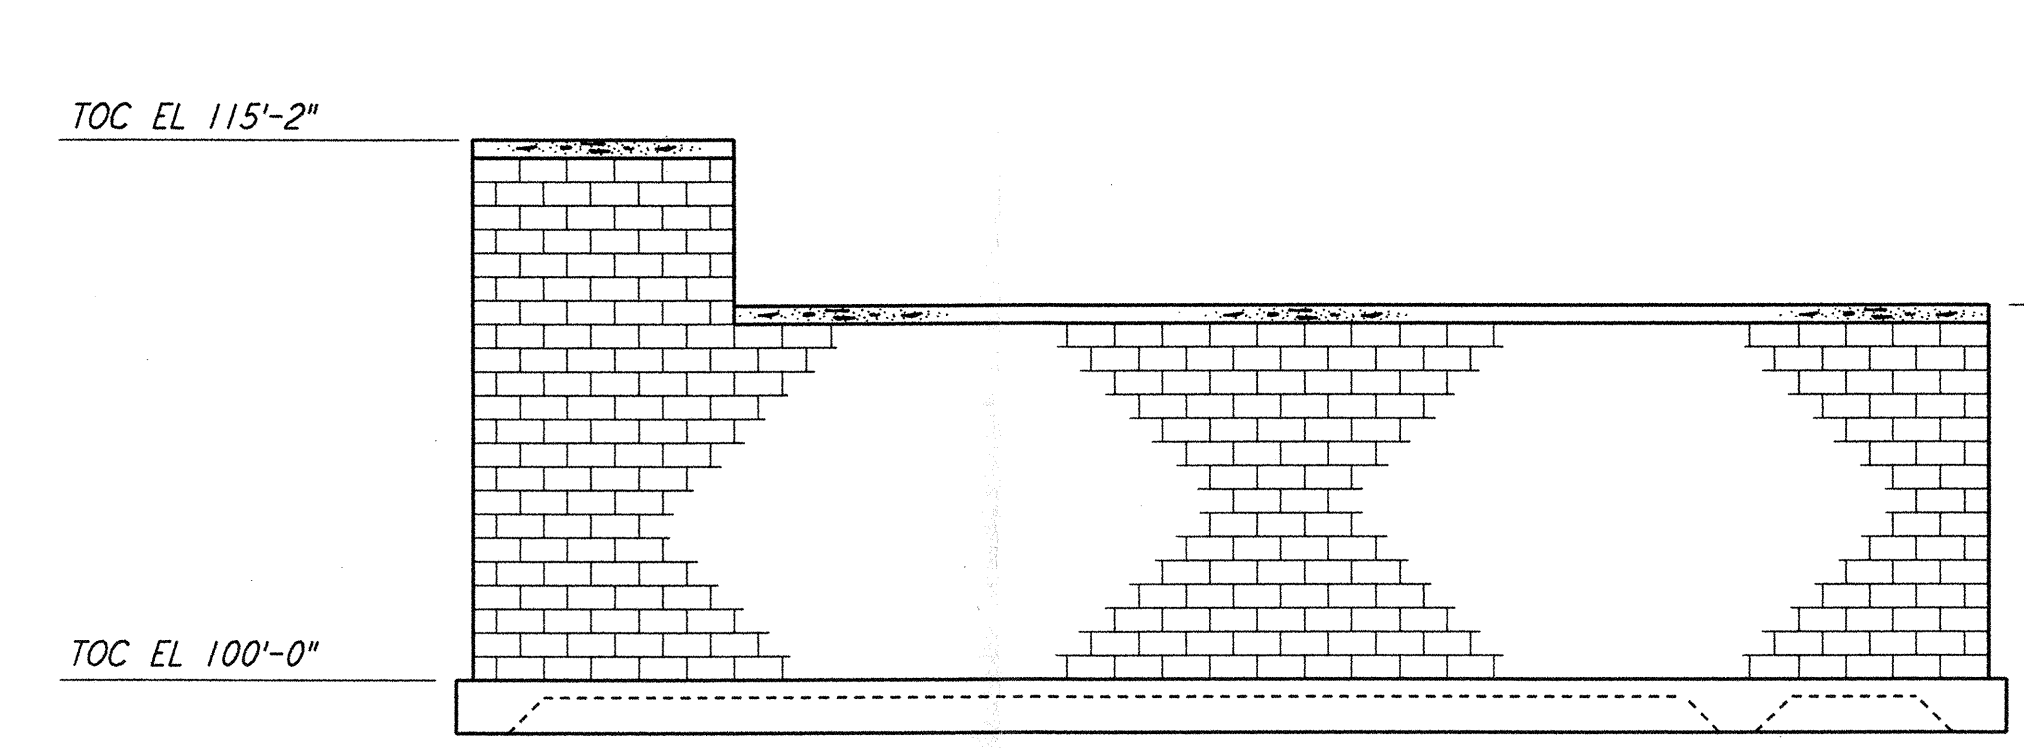


ELEVATION B REF
 $\frac{3}{8}'' = 1'-0''$
 LA-S-104 LA-S-103

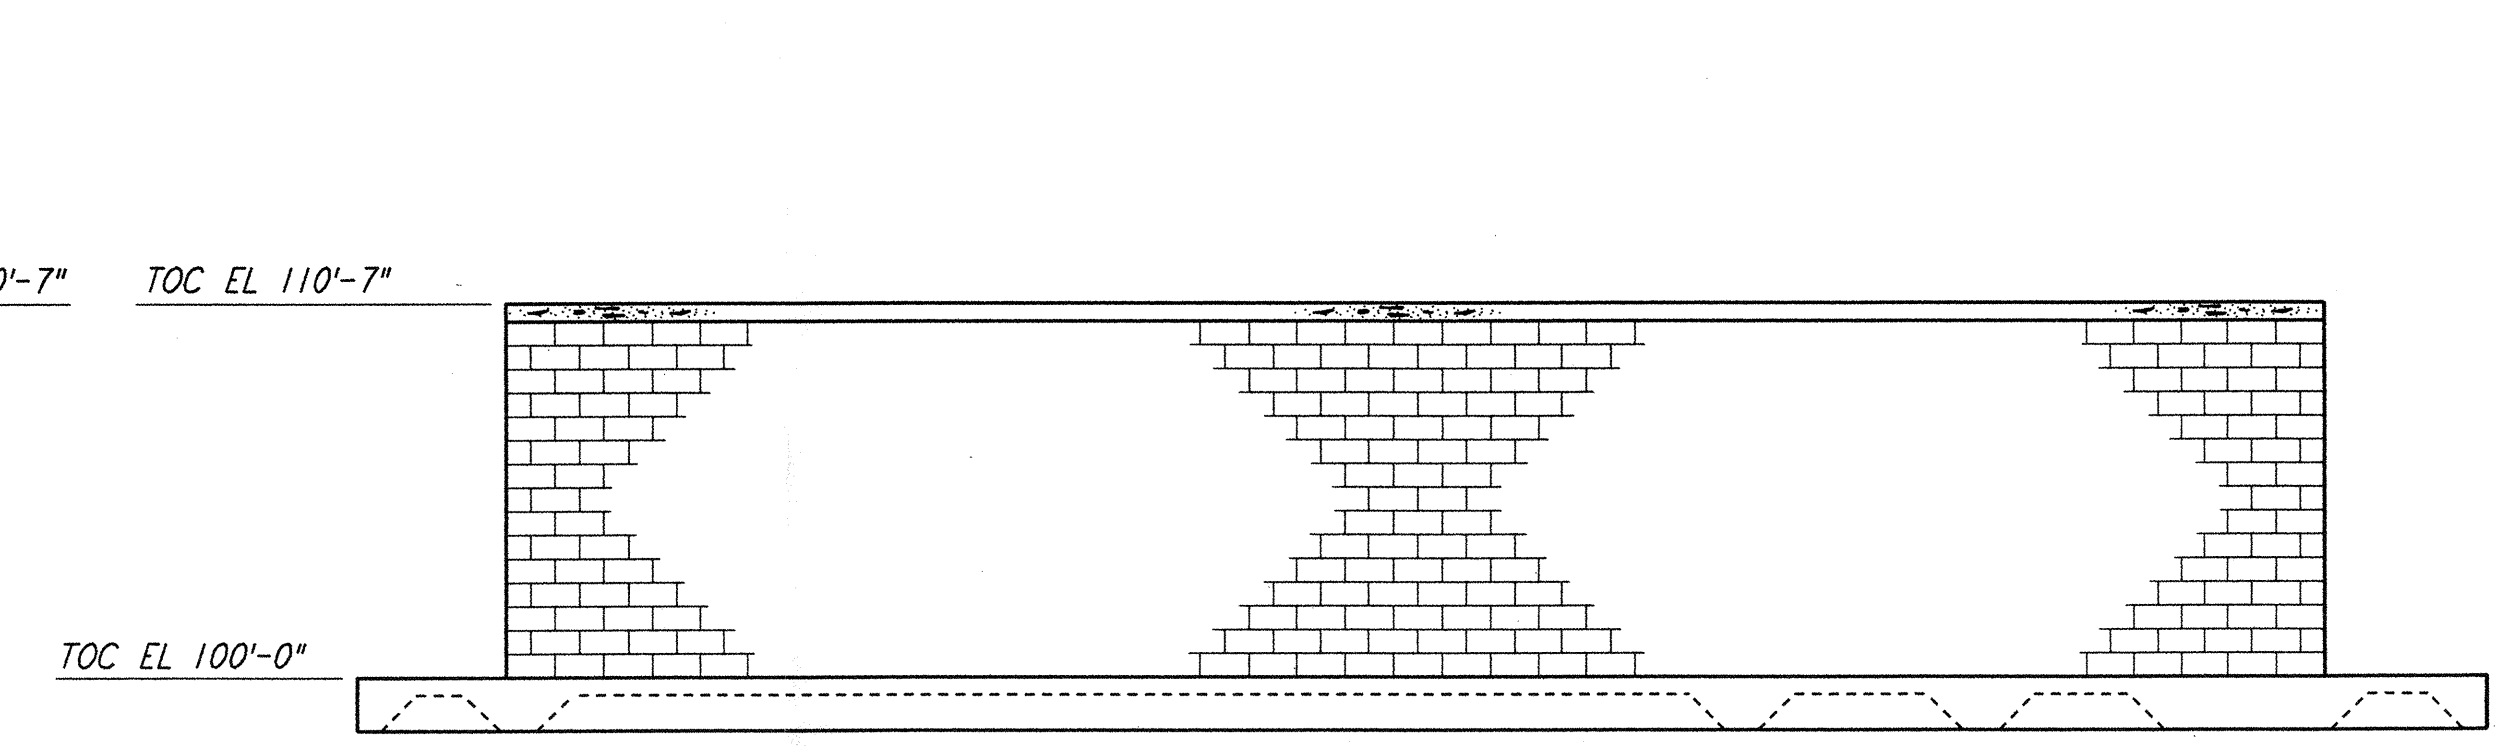


ELEVATION C REF
 $\frac{3}{8}'' = 1'-0''$
 LA-S-104 LA-S-103

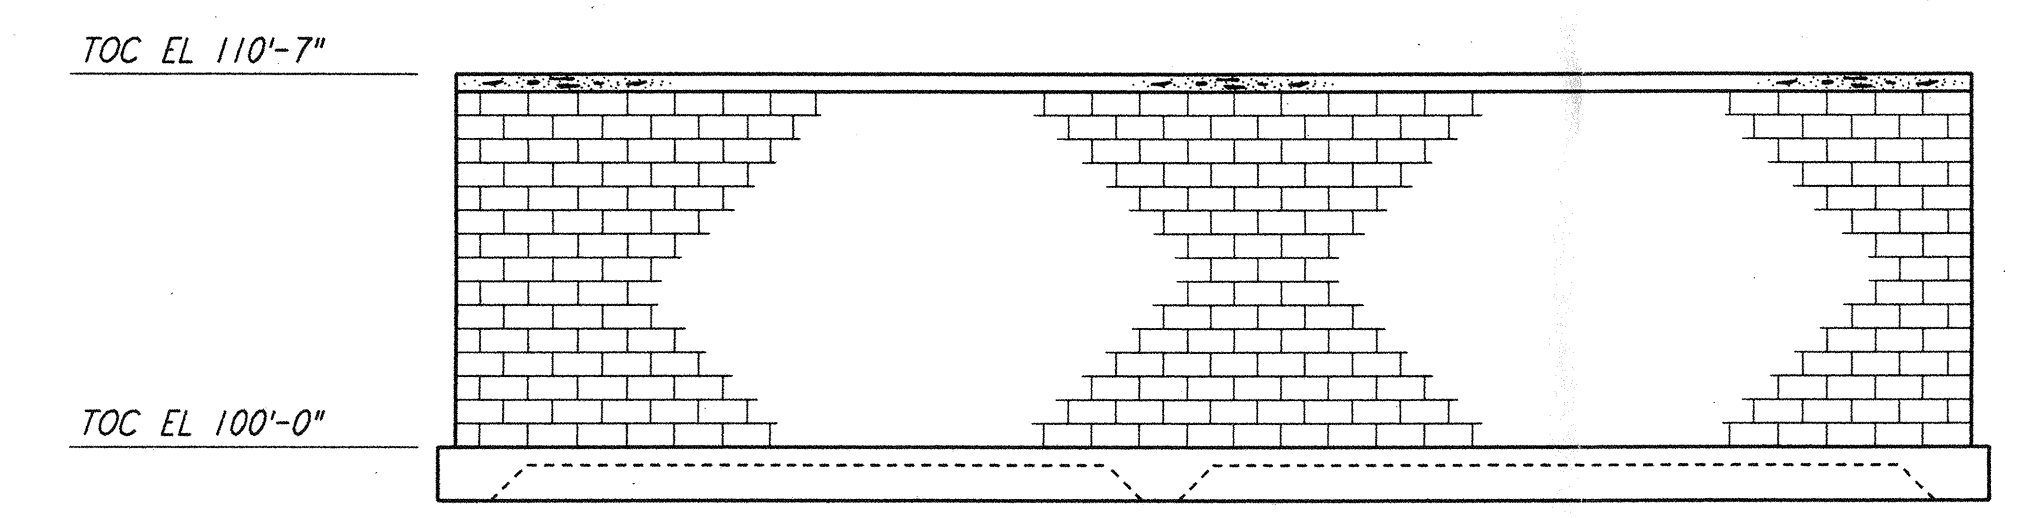


ELEVATION D REF
 $\frac{3}{8}'' = 1'-0''$
 LA-S-104 LA-S-103

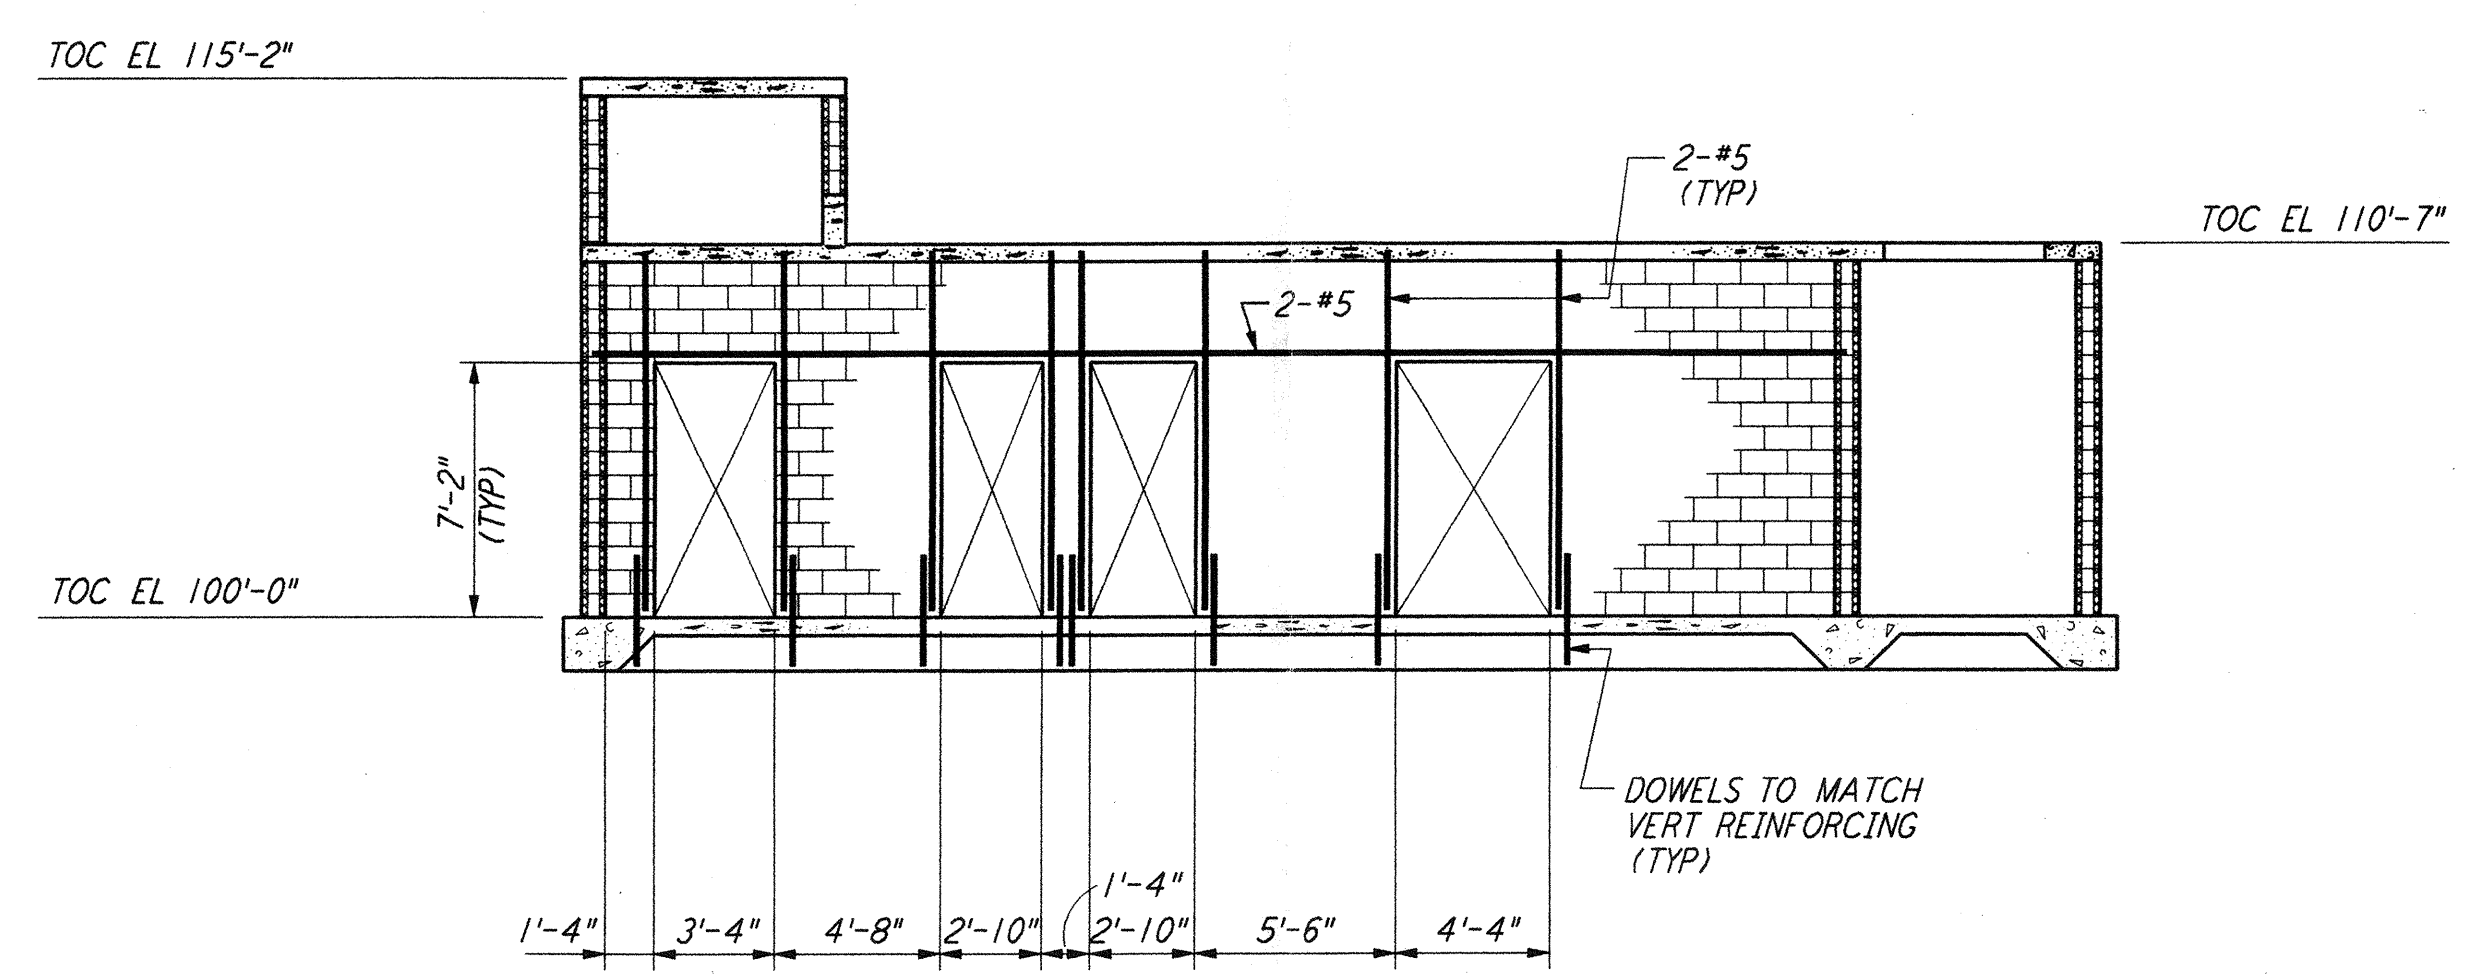


SECTION E REF
 $\frac{3}{8}'' = 1'-0''$
 LA-S-104 LA-S-103

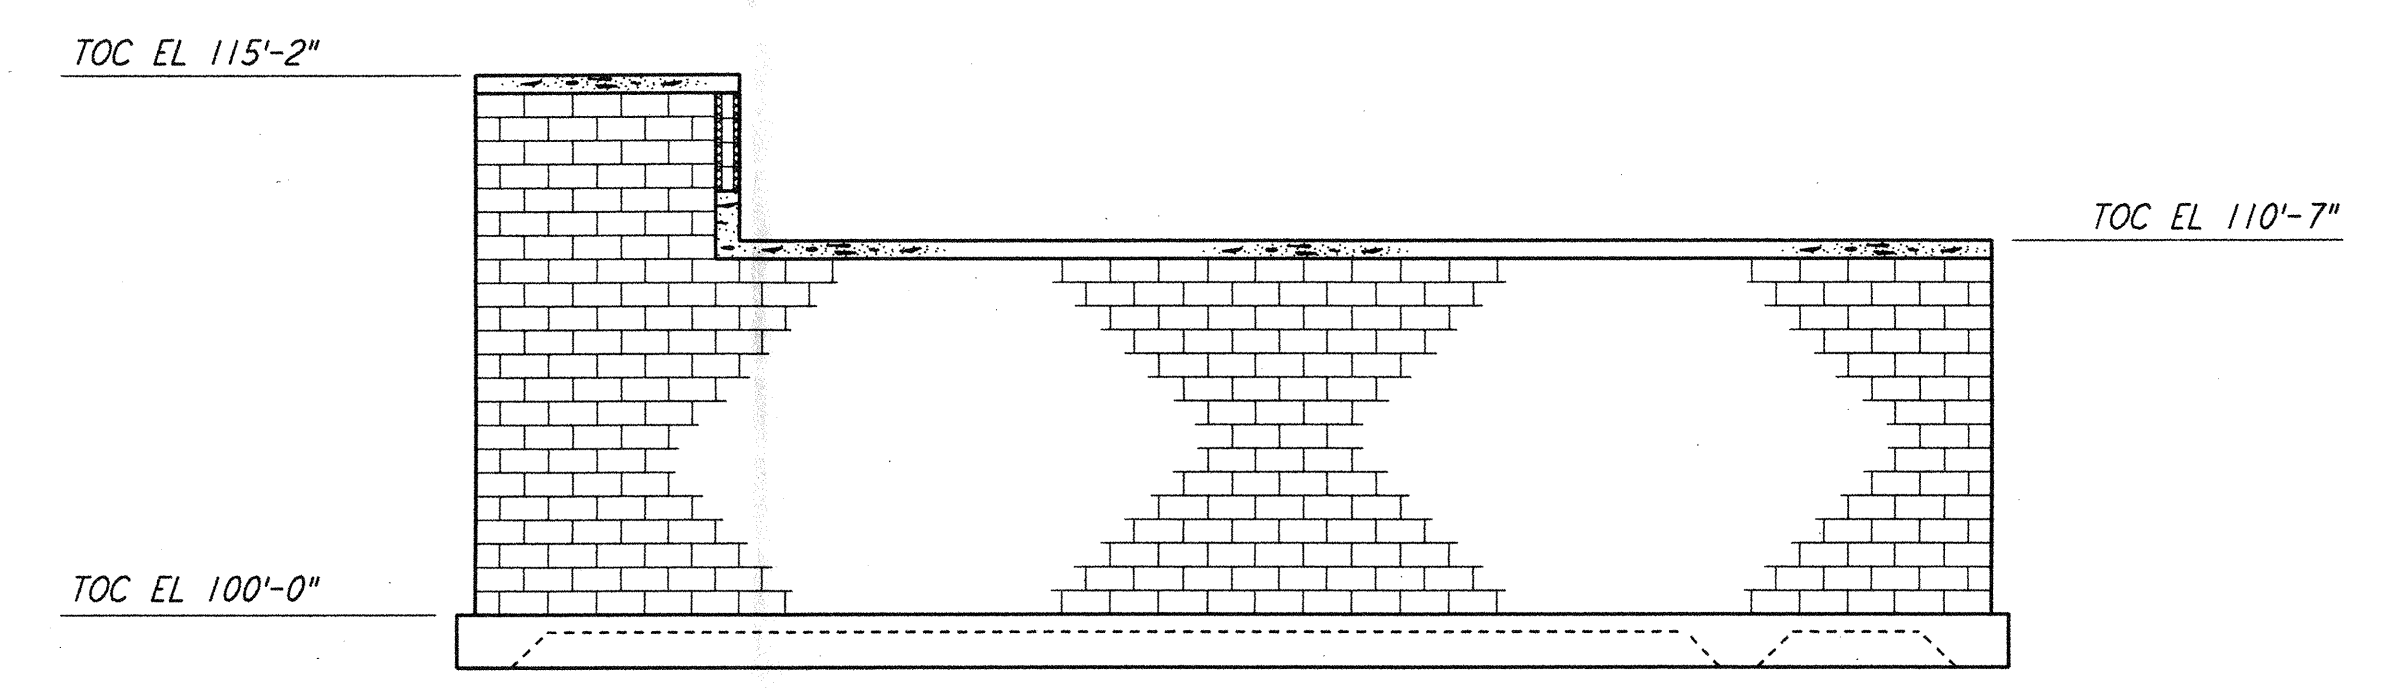


SECTION F REF
 $\frac{3}{8}'' = 1'-0''$
 LA-S-104 LA-S-103

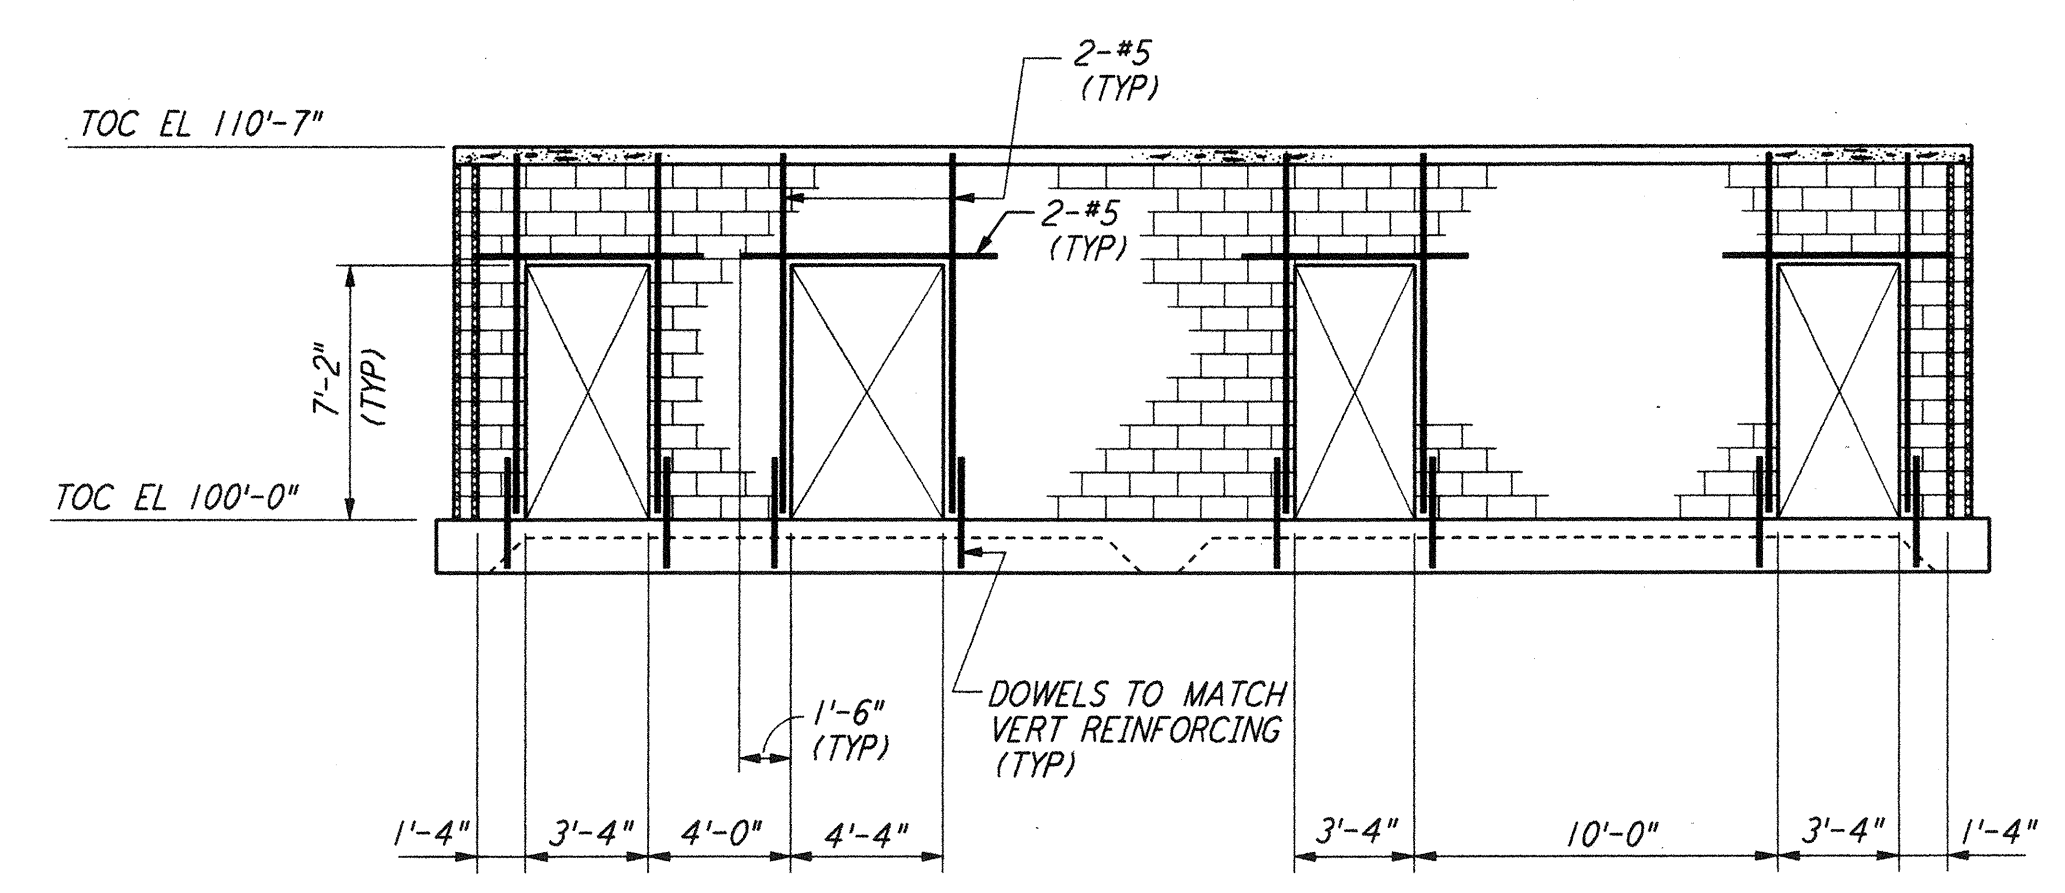


SECTION G REF
 $\frac{3}{8}'' = 1'-0''$
 LA-S-104 LA-S-103

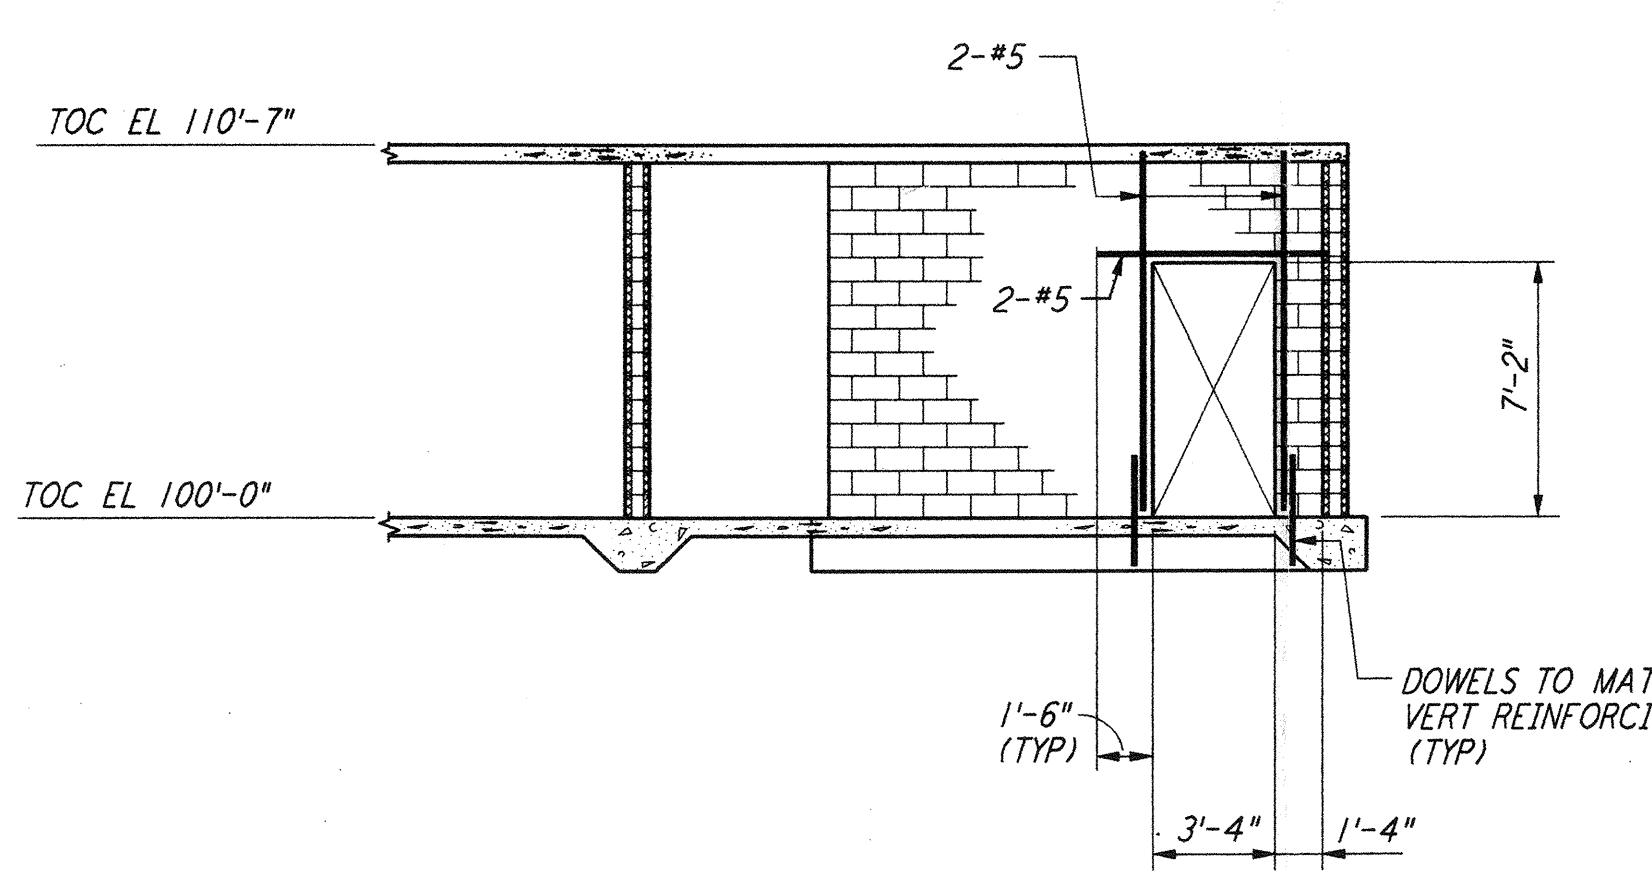


SECTION H REF
 $\frac{3}{8}'' = 1'-0''$
 LA-S-104 LA-S-103

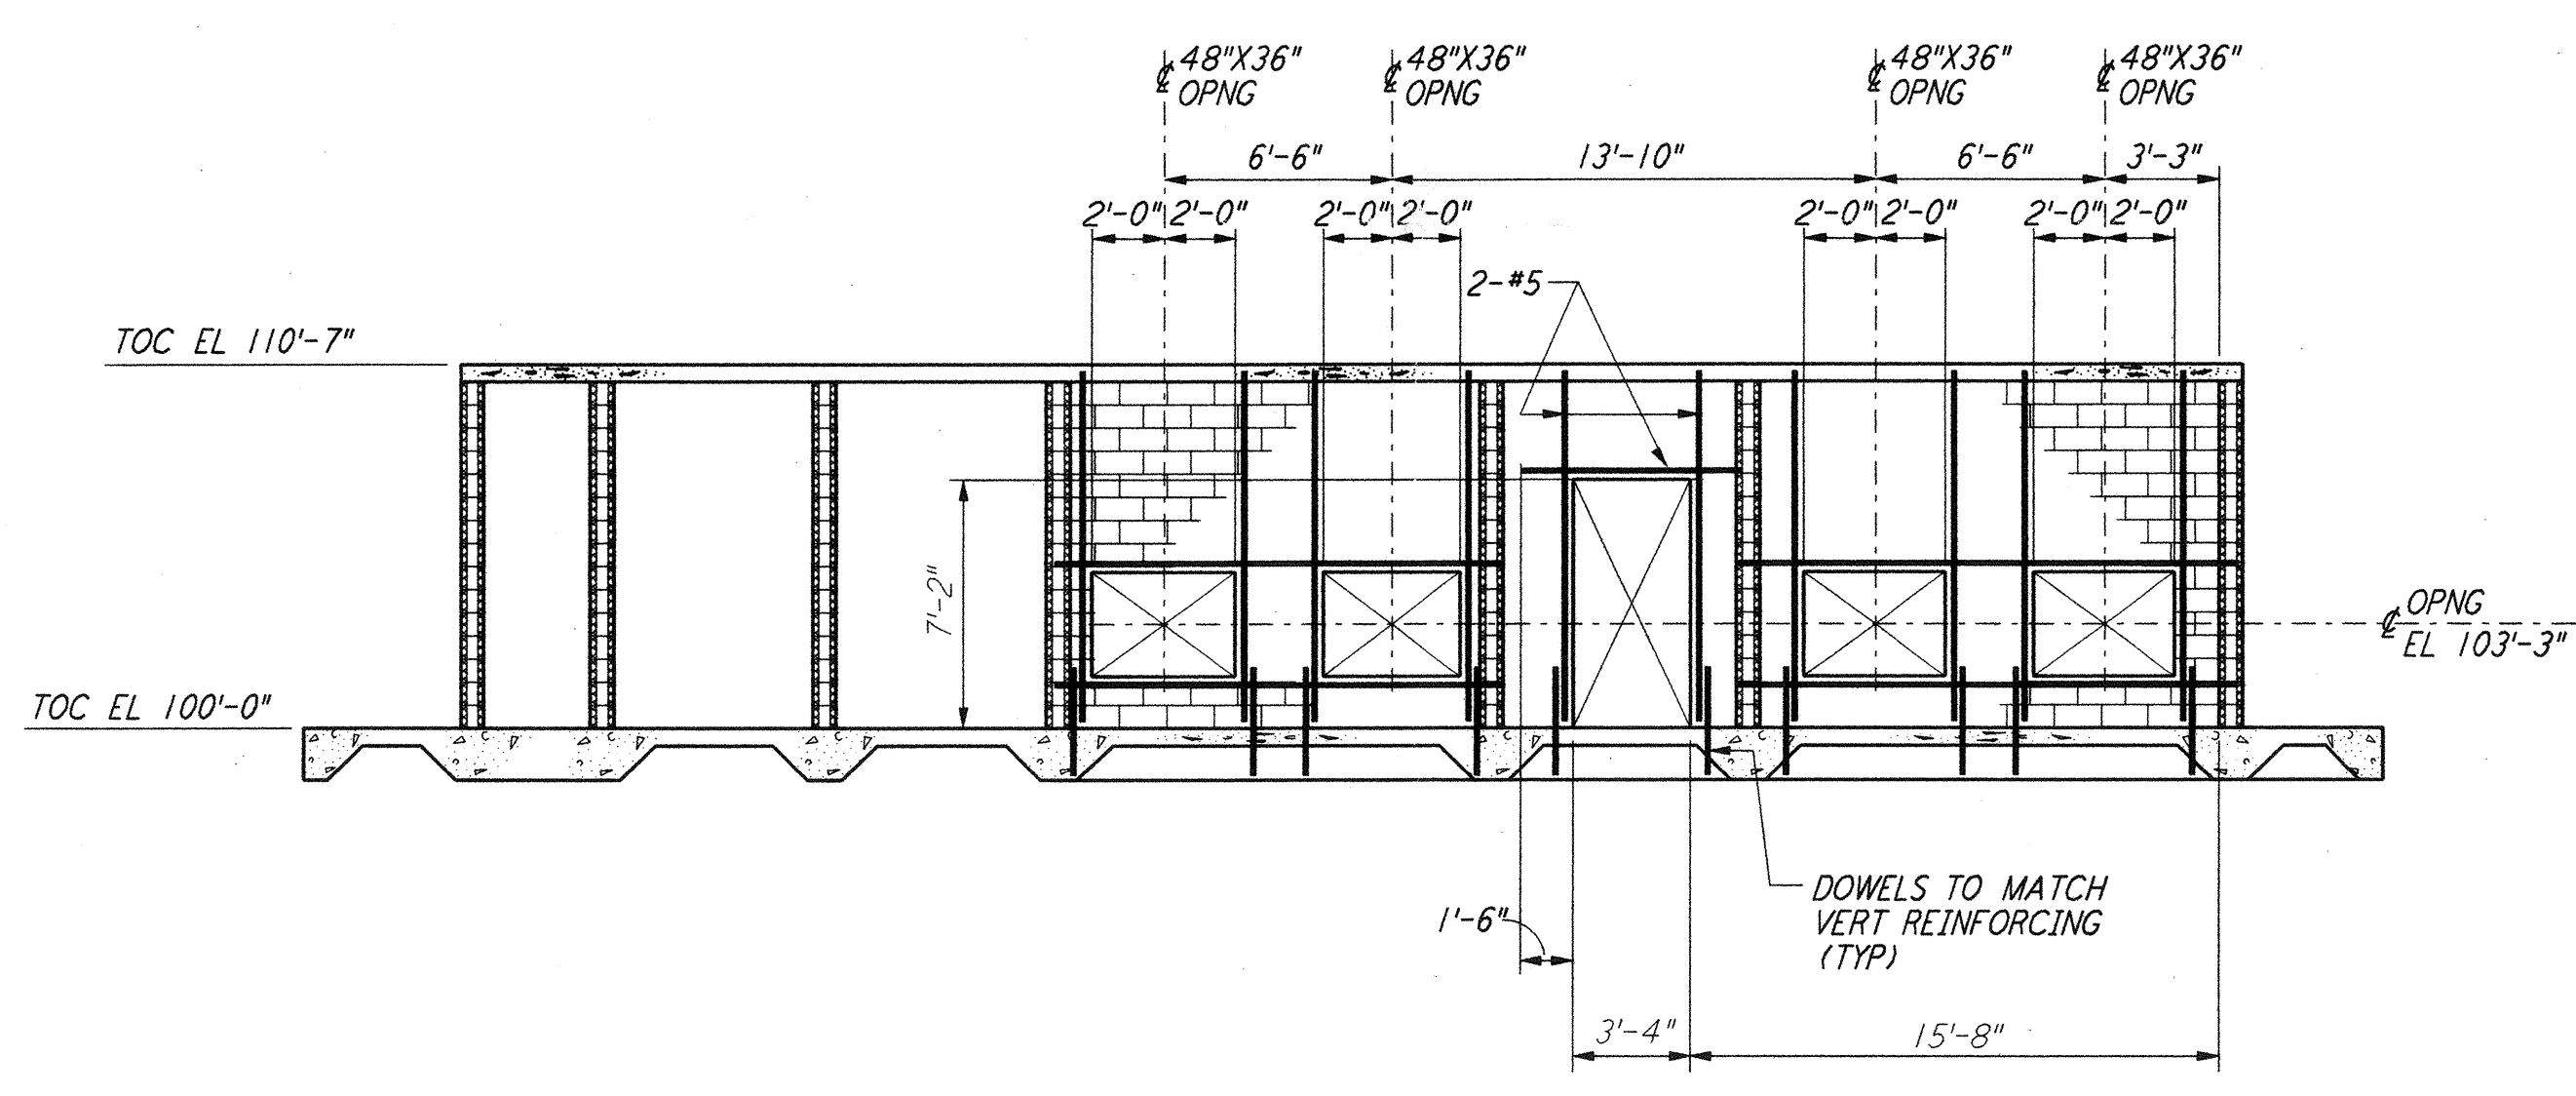

SECTION J REF
 $\frac{3}{8}'' = 1'-0''$
 LA-S-104 LA-S-103

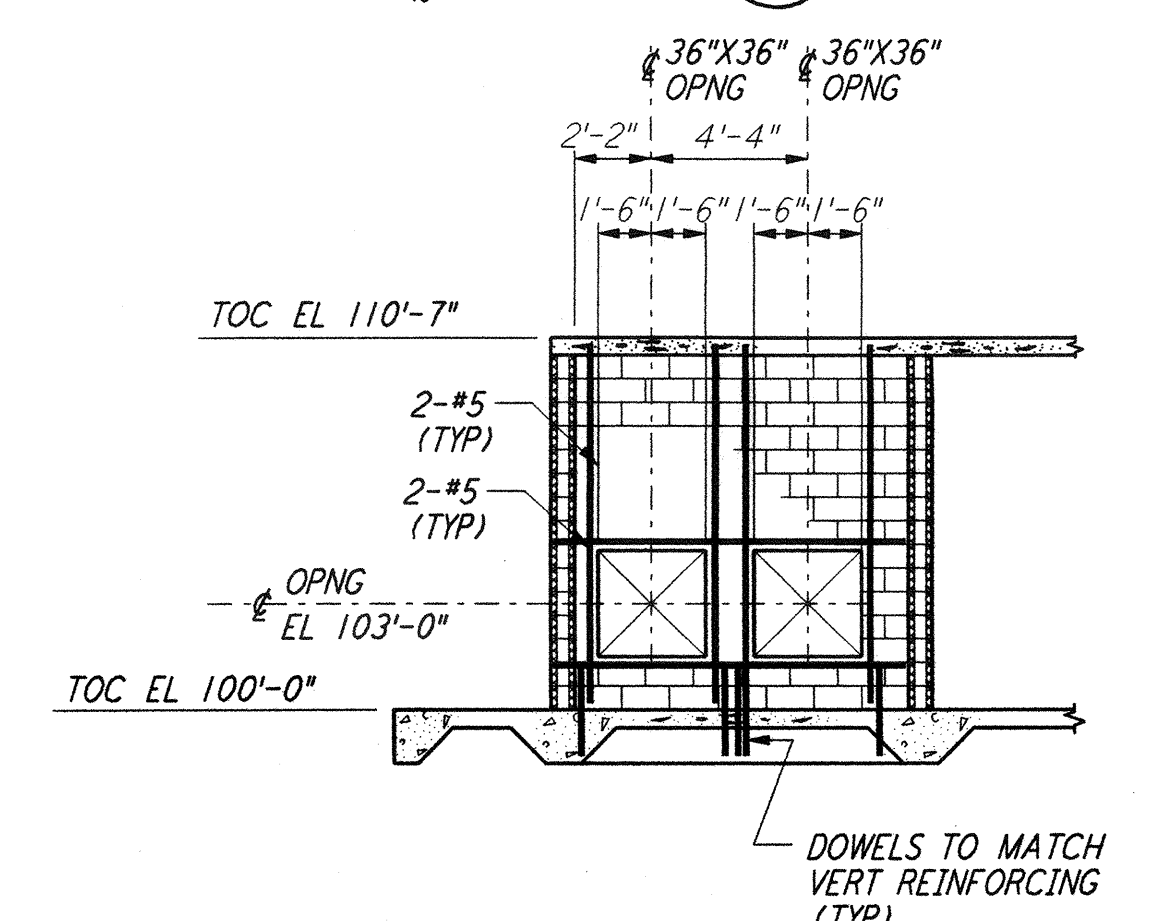


SECTION K REF
 $\frac{3}{8}'' = 1'-0''$
 LA-S-104 LA-S-103

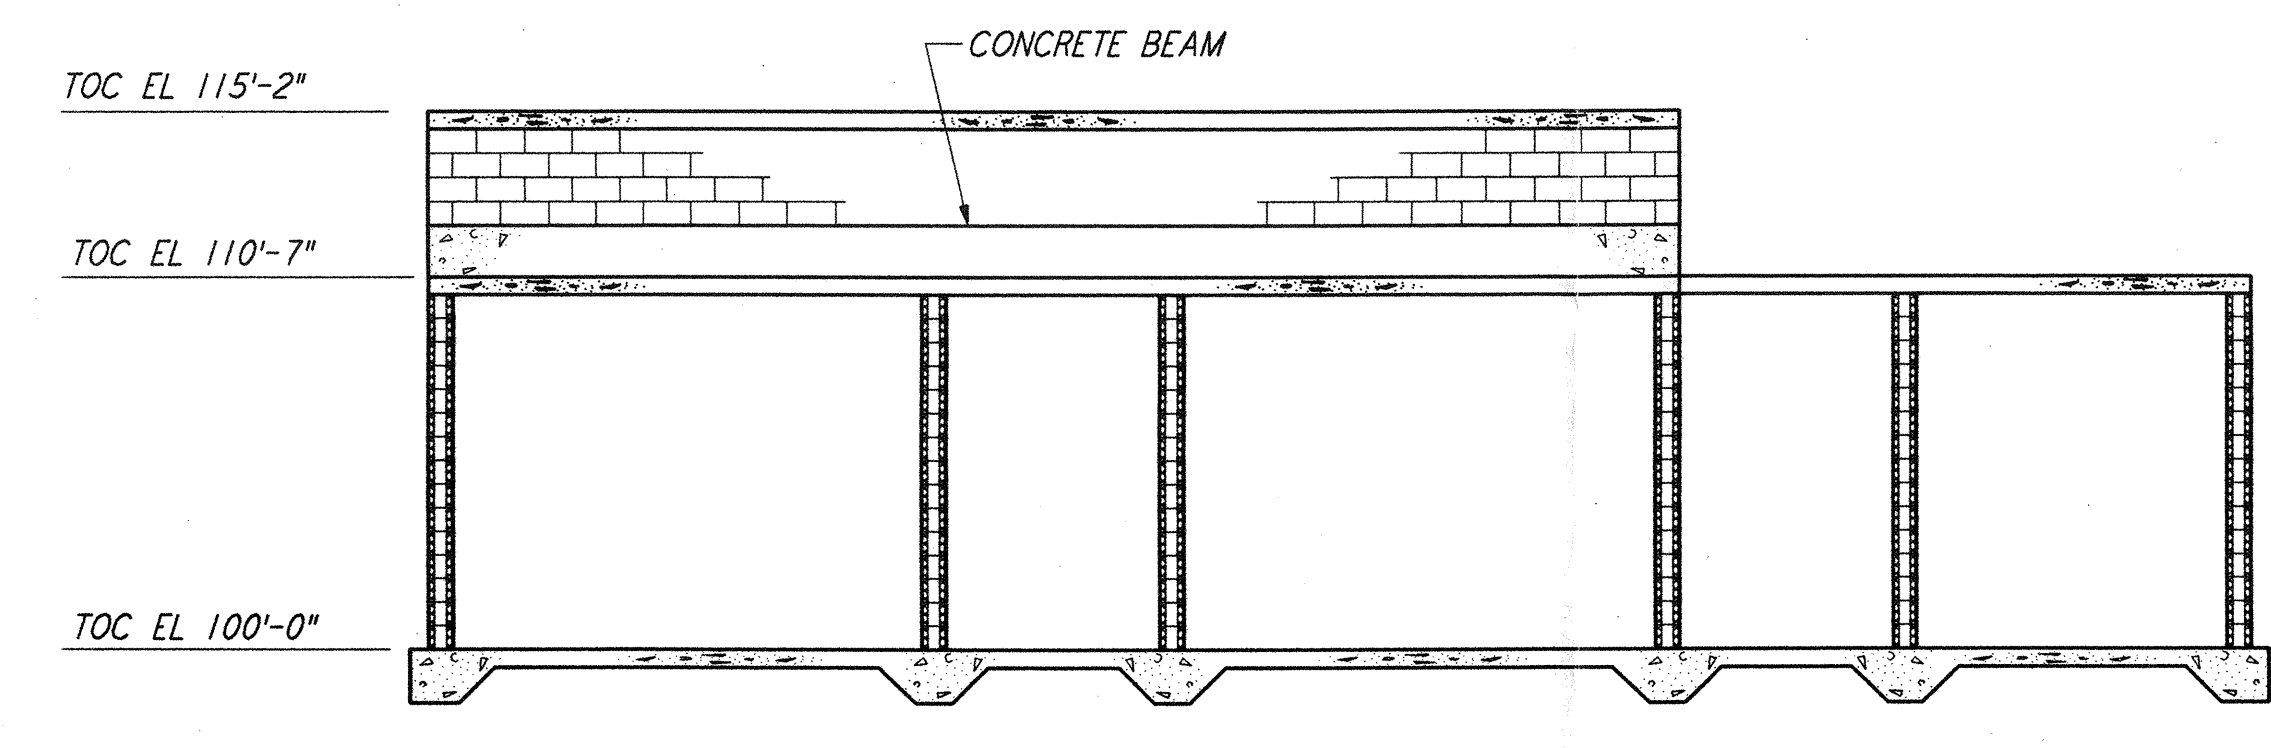

SECTION L REF
 $\frac{3}{8}'' = 1'-0''$
 LA-S-104 LA-S-103

NOTE:
 1. FOR NOTES SEE DRAWING LA-S-103.

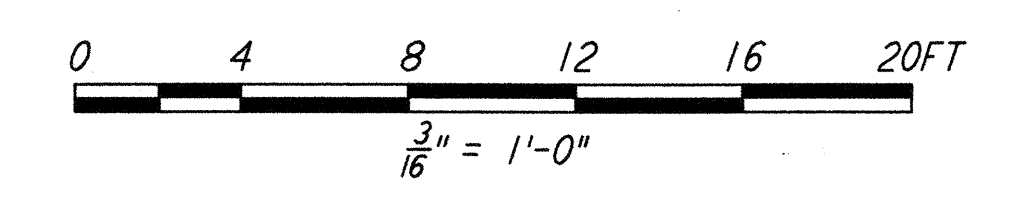

NO.	DATE	BY	CHKD	ENGR	PROJ	DESCRIPTION
1	08-07-98	WA	gmm	gmm	WVV	ISSUED FOR AS-BUILT

ISSUED FOR CONSTRUCTION
 DRAWN MCS 11-15-96
 CHECKED DDM 11-15-96
 ENGINEER BP 11-15-96
 PROJ TDM 11-15-96

AS-BUILT DRAWINGS

PARSONS
 100 WEST WALNUT STREET
 PASADENA, CALIFORNIA

LIGO
 CALIFORNIA INSTITUTE OF TECHNOLOGY
 MASSACHUSETTS INSTITUTE OF TECHNOLOGY

LIGO-D960920-01-O

LASER INTERFEROMETER
 GRAVITATIONAL-WAVE OBSERVATORY
 SITE NO. 2 - LIVINGSTON, LOUISIANA

TITLE	SCALE	CONTRACT NUMBER	PROJECT NUMBER
STRUCTURAL CORNER STATION AIR HANDLING UNIT ENCLOSURE ELV'S & SECTS	AS NOTED	PP150969	8094
SHEET NUMBER	REVISIONS		
LA-S-104			