



This document and the design it covers are the property of PARSONS. They are loaned only with the borrower's expressed written agreement that they will not be reproduced, copied, loaned, exhibited, or used in any other way, except by written consent from PARSONS to the borrower.


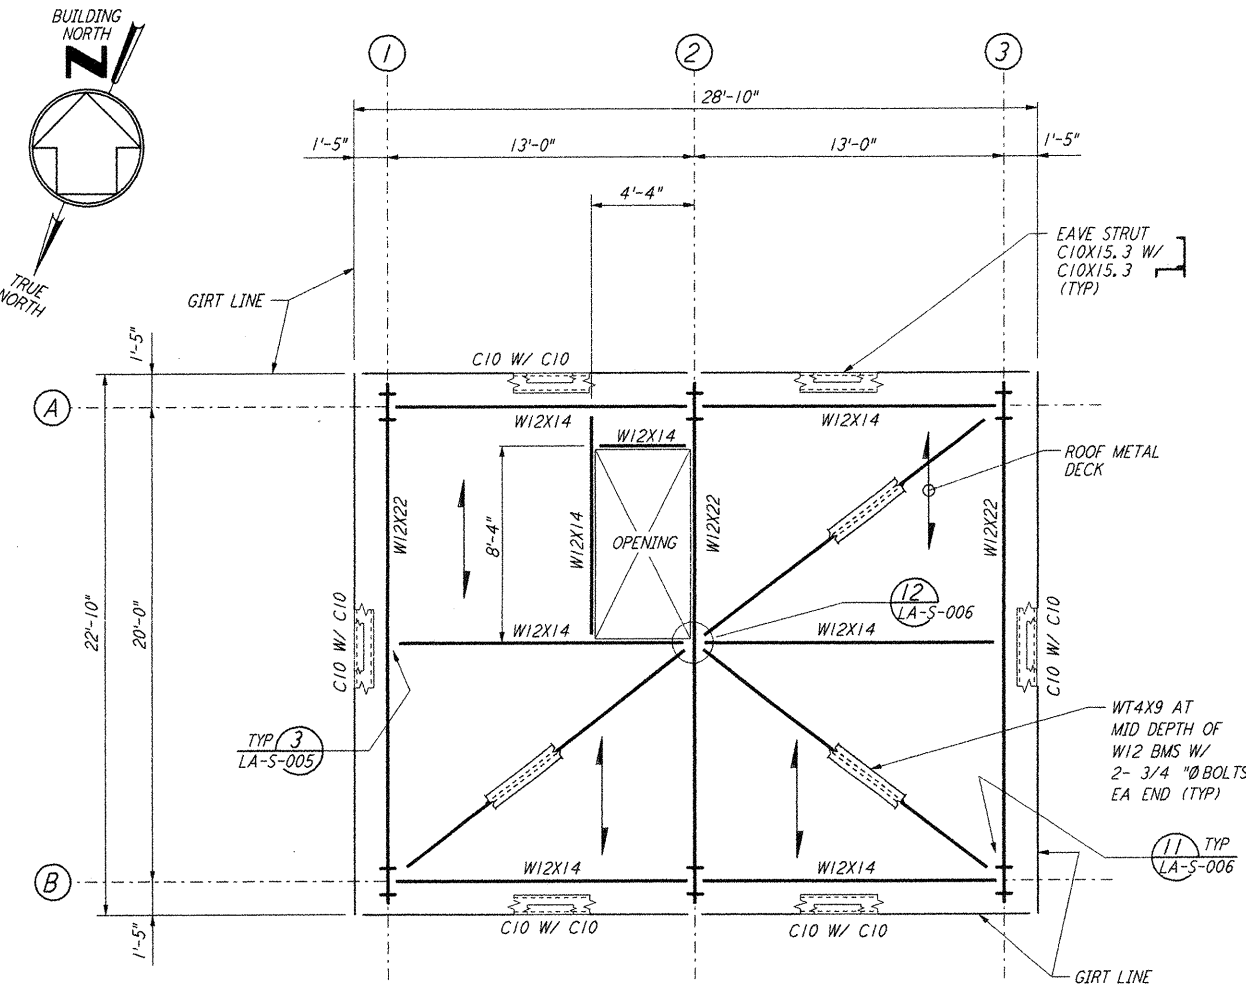


ARM 2  
 MID STATION "A" - ROOF FRAMING PLAN  
 $\frac{1}{4}'' = 1'-0''$

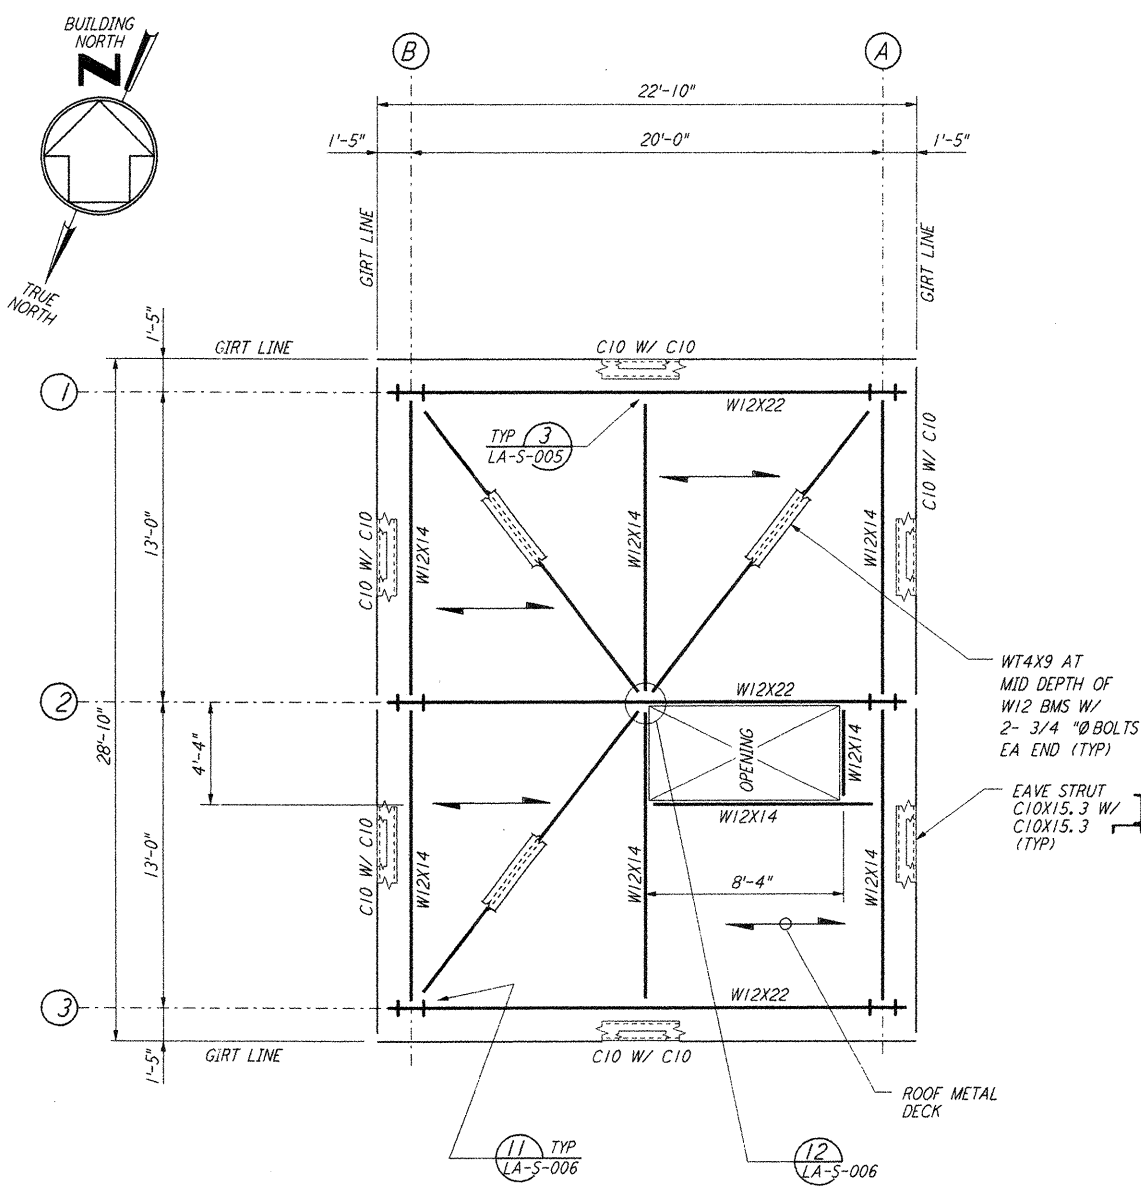

ARM 1  
 MID STATION "B" - ROOF FRAMING PLAN  
 $\frac{1}{4}'' = 1'-0''$

- NOTES:**
- FOR GENERAL NOTES, ABBREVIATIONS AND SYMBOLS, SEE DRAWING LA-5-001.
  - FOR EAVE STRUT CONNECTION DETAILS, SEE DRAWING LA-5-005.

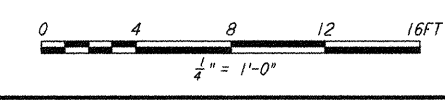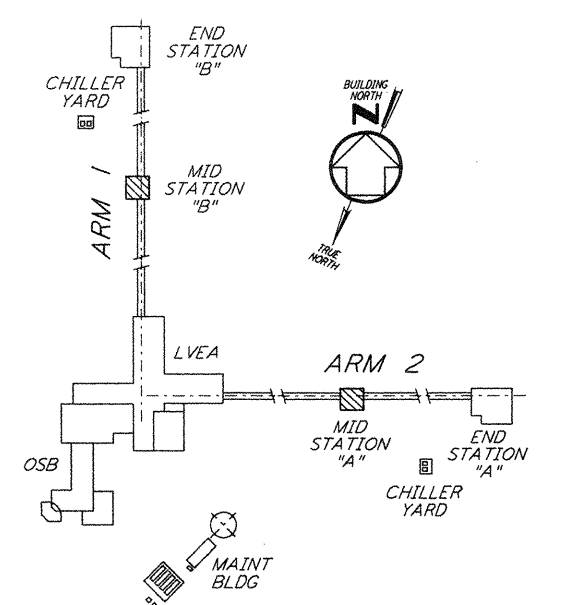

NO.	DATE	BY	CHKD	ENGR	PROJ	DESCRIPTION
2	08-07-98	WA	GP	GP	WLD	ISSUED FOR AS-BUILT
1	2-28-97	RM	TDM	GP	TDM	REV RF FRMG PLAN FOR MID STA "A & B"

ISSUED FOR CONSTRUCTION	
DRAWN	MCS 11-15-96
CHECKED	DDM 11-15-96
ENGINEER	BP 11-15-96
PROJ	TDM 11-15-96

**AS-BUILT DRAWINGS**

100 WEST WALNUT STREET  
 PASADENA, CALIFORNIA

CALIFORNIA INSTITUTE OF TECHNOLOGY  
 MASSACHUSETTS INSTITUTE OF TECHNOLOGY

LASER INTERFEROMETER  
 GRAVITATIONAL-WAVE OBSERVATORY  
 SITE NO. 2 - LIVINGSTON, LOUISIANA

TITLE: STRUCTURAL MID STATIONS "A" & "B" ROOF FRAMING PLANS

SCALE: AS NOTED

PROJECT NUMBER: 8094

SHEET NUMBER: PPI50969

REVISIONS: LA-S-202