



This document and the design it covers are the property of PARSONS. They are loaned only with the borrower's expressed written agreement that they will not be reproduced, copied, loaned, exhibited, or used in any other way, except by written consent from PARSONS to the borrower.


This document and the design it covers are the property of PARSONS. They are loaned only with the borrower's expressed written agreement that they will not be reproduced, copied, loaned, exhibited, or used in any other way, except by written consent from PARSONS to the borrower.

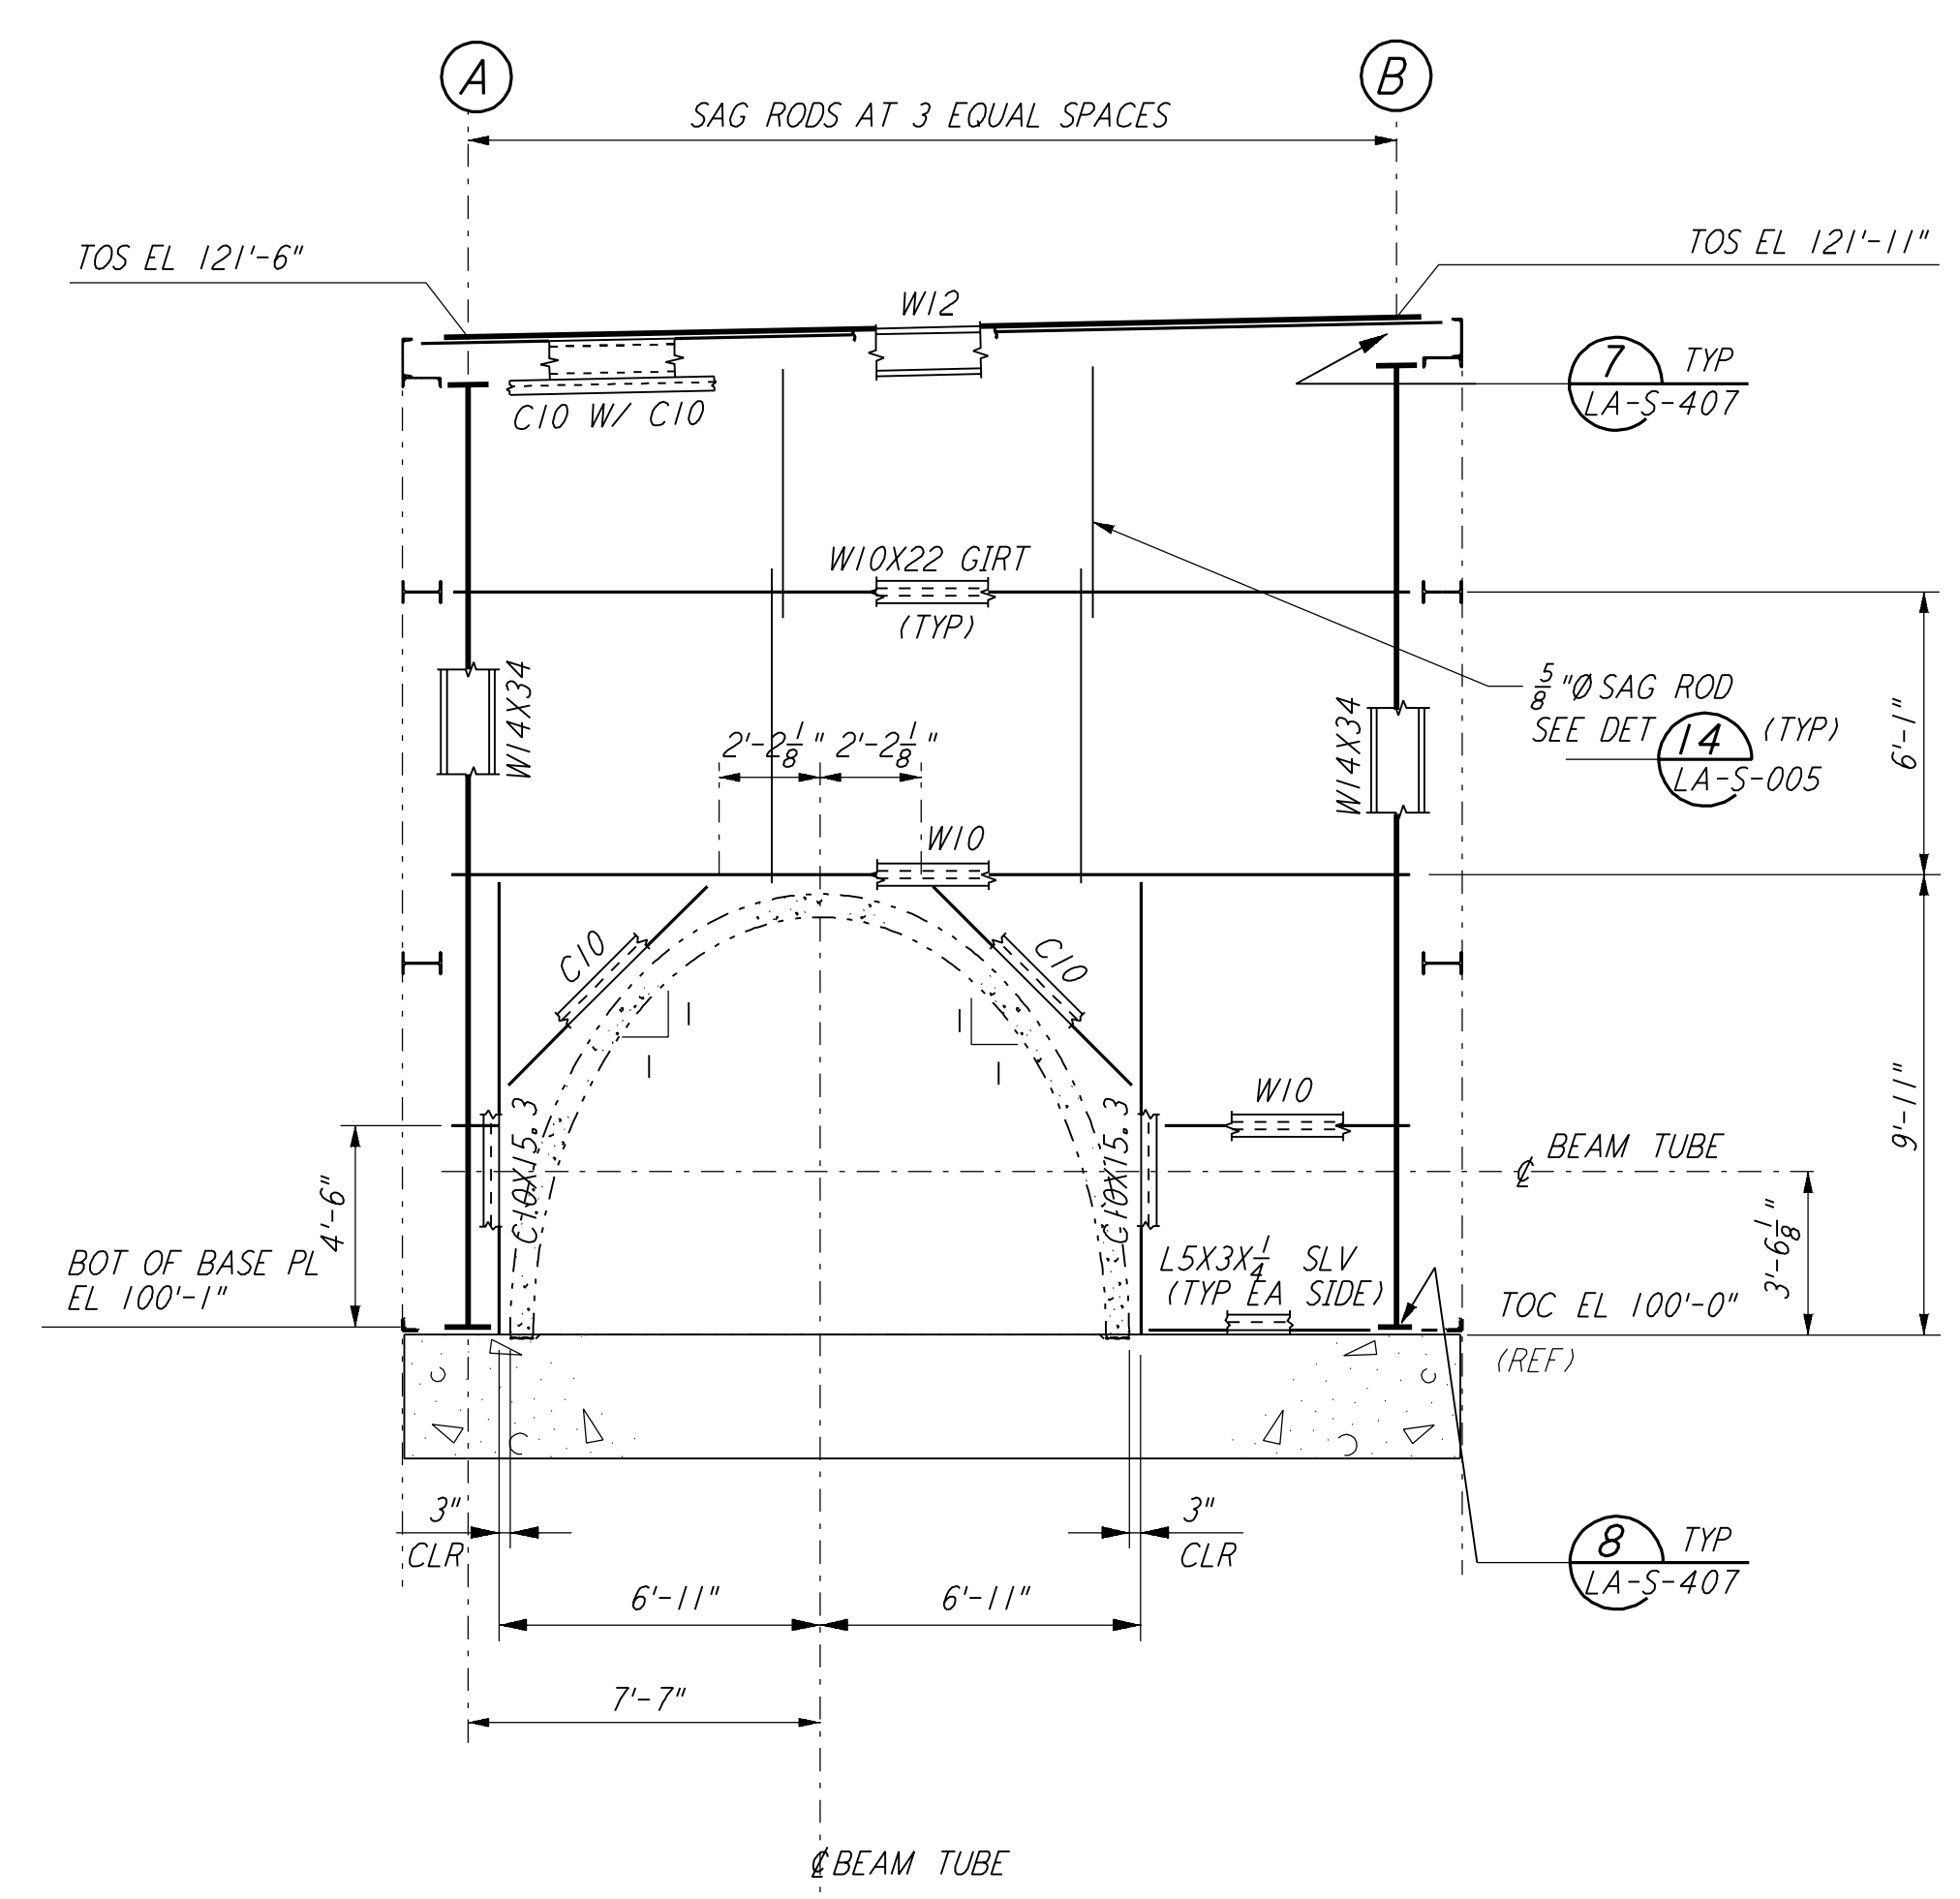


LOOKING EAST - FOR MID STATION "A" ON ARM 2  
 LOOKING SOUTH - FOR MID STATION "B" ON ARM 1  
 ELEVATION AT COLUMN LINE 1  
 $\frac{1}{4}'' = 1'-0''$

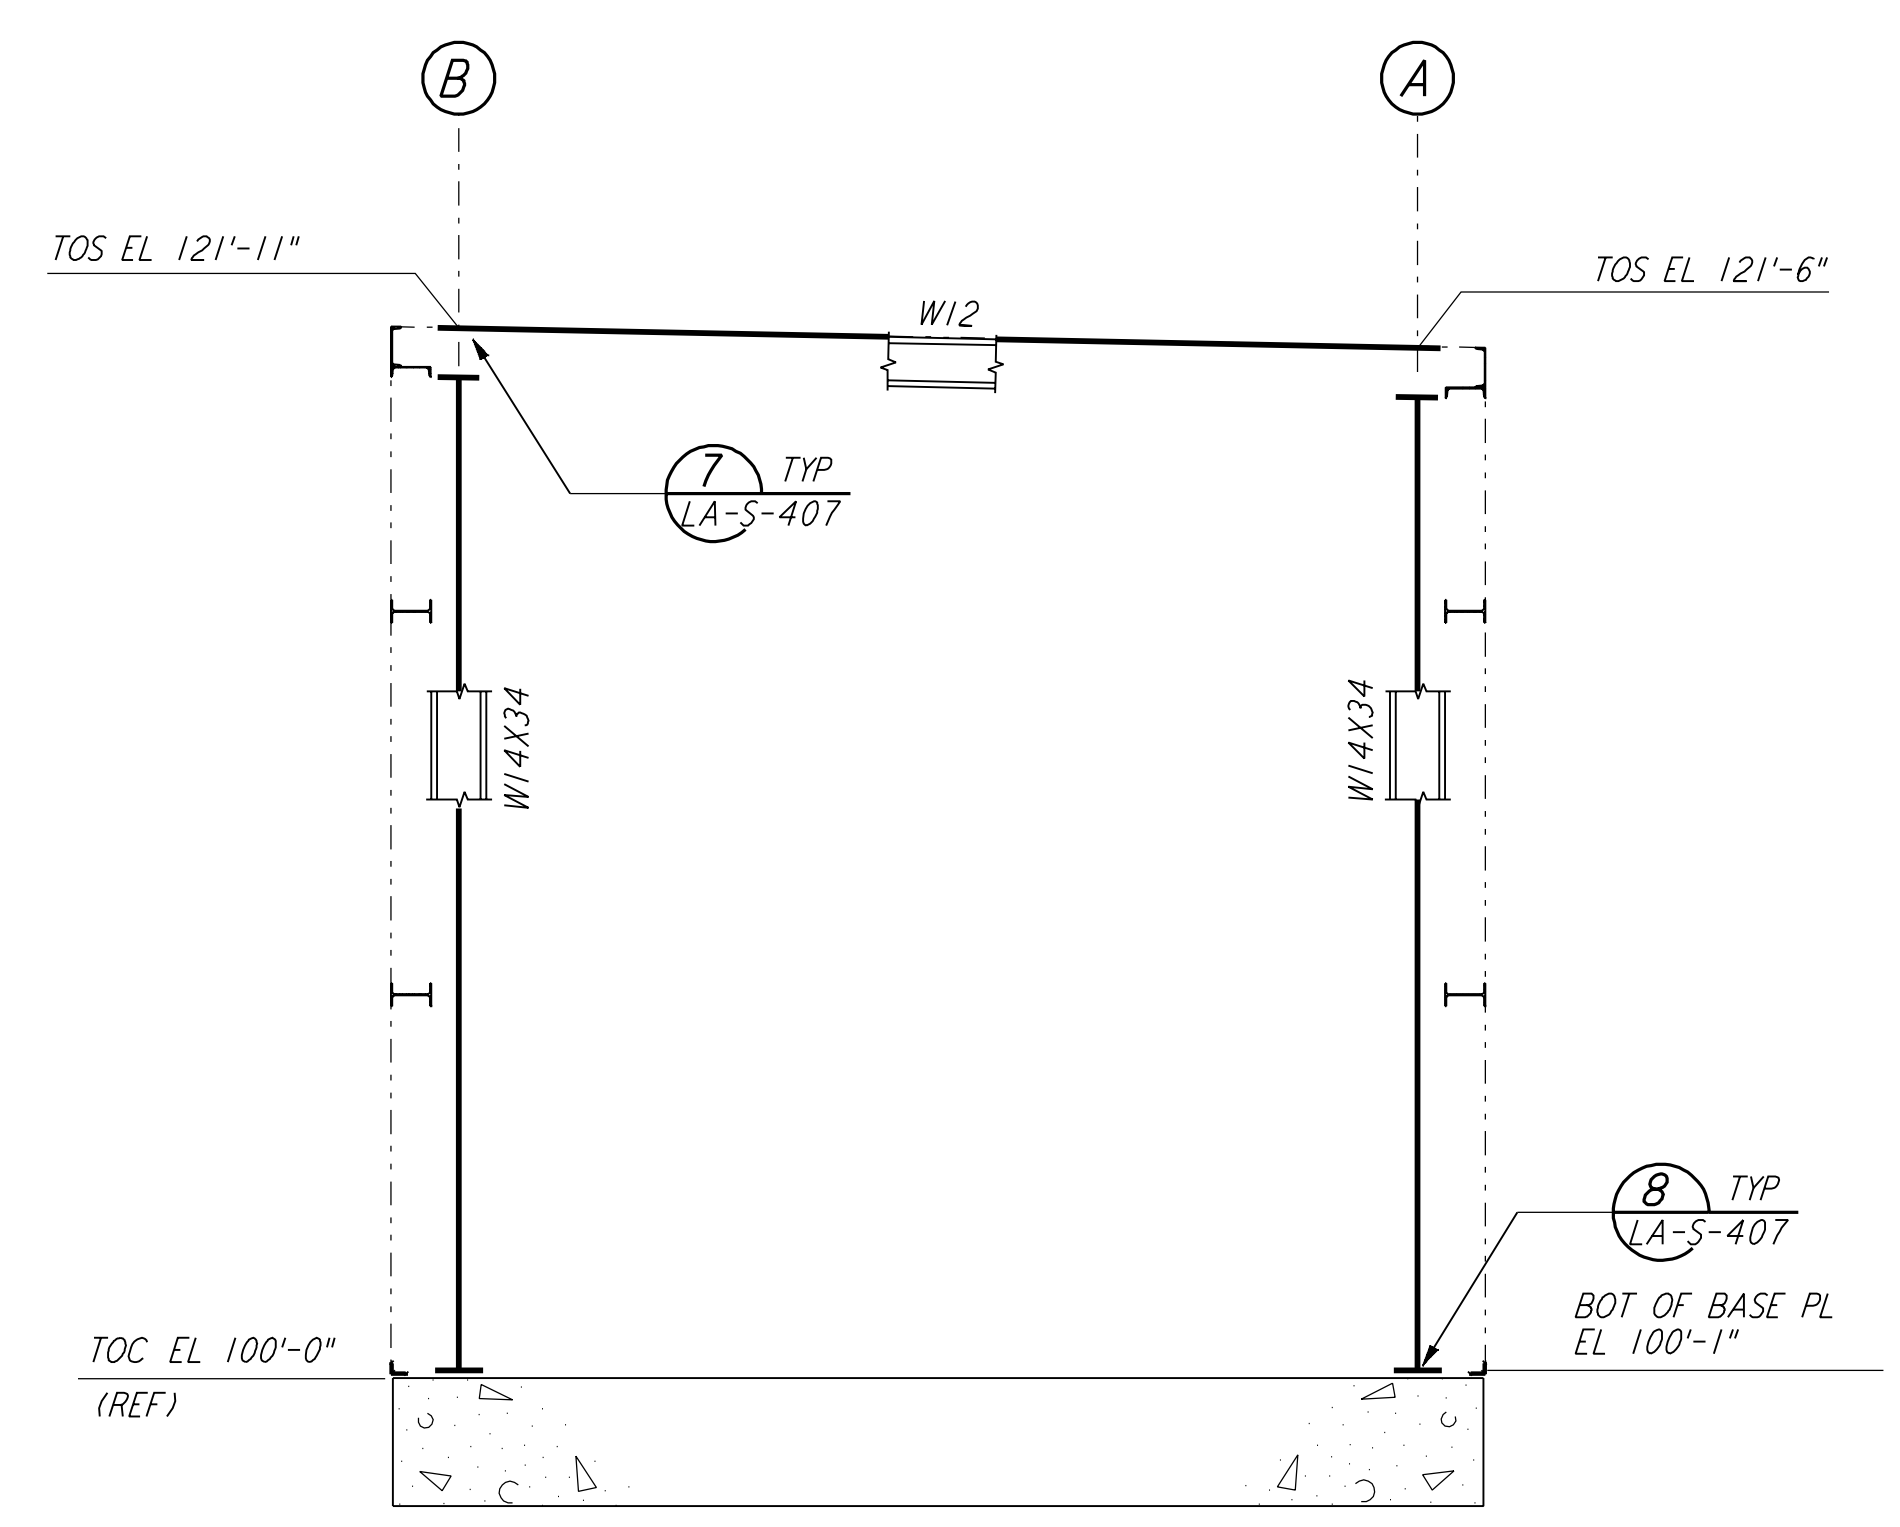


LOOKING WEST - FOR MID STATION "A" ON ARM 2  
 LOOKING NORTH - FOR MID STATION "B" ON ARM 1  
 ELEVATION AT COLUMN LINE 2  
 $\frac{1}{4}'' = 1'-0''$

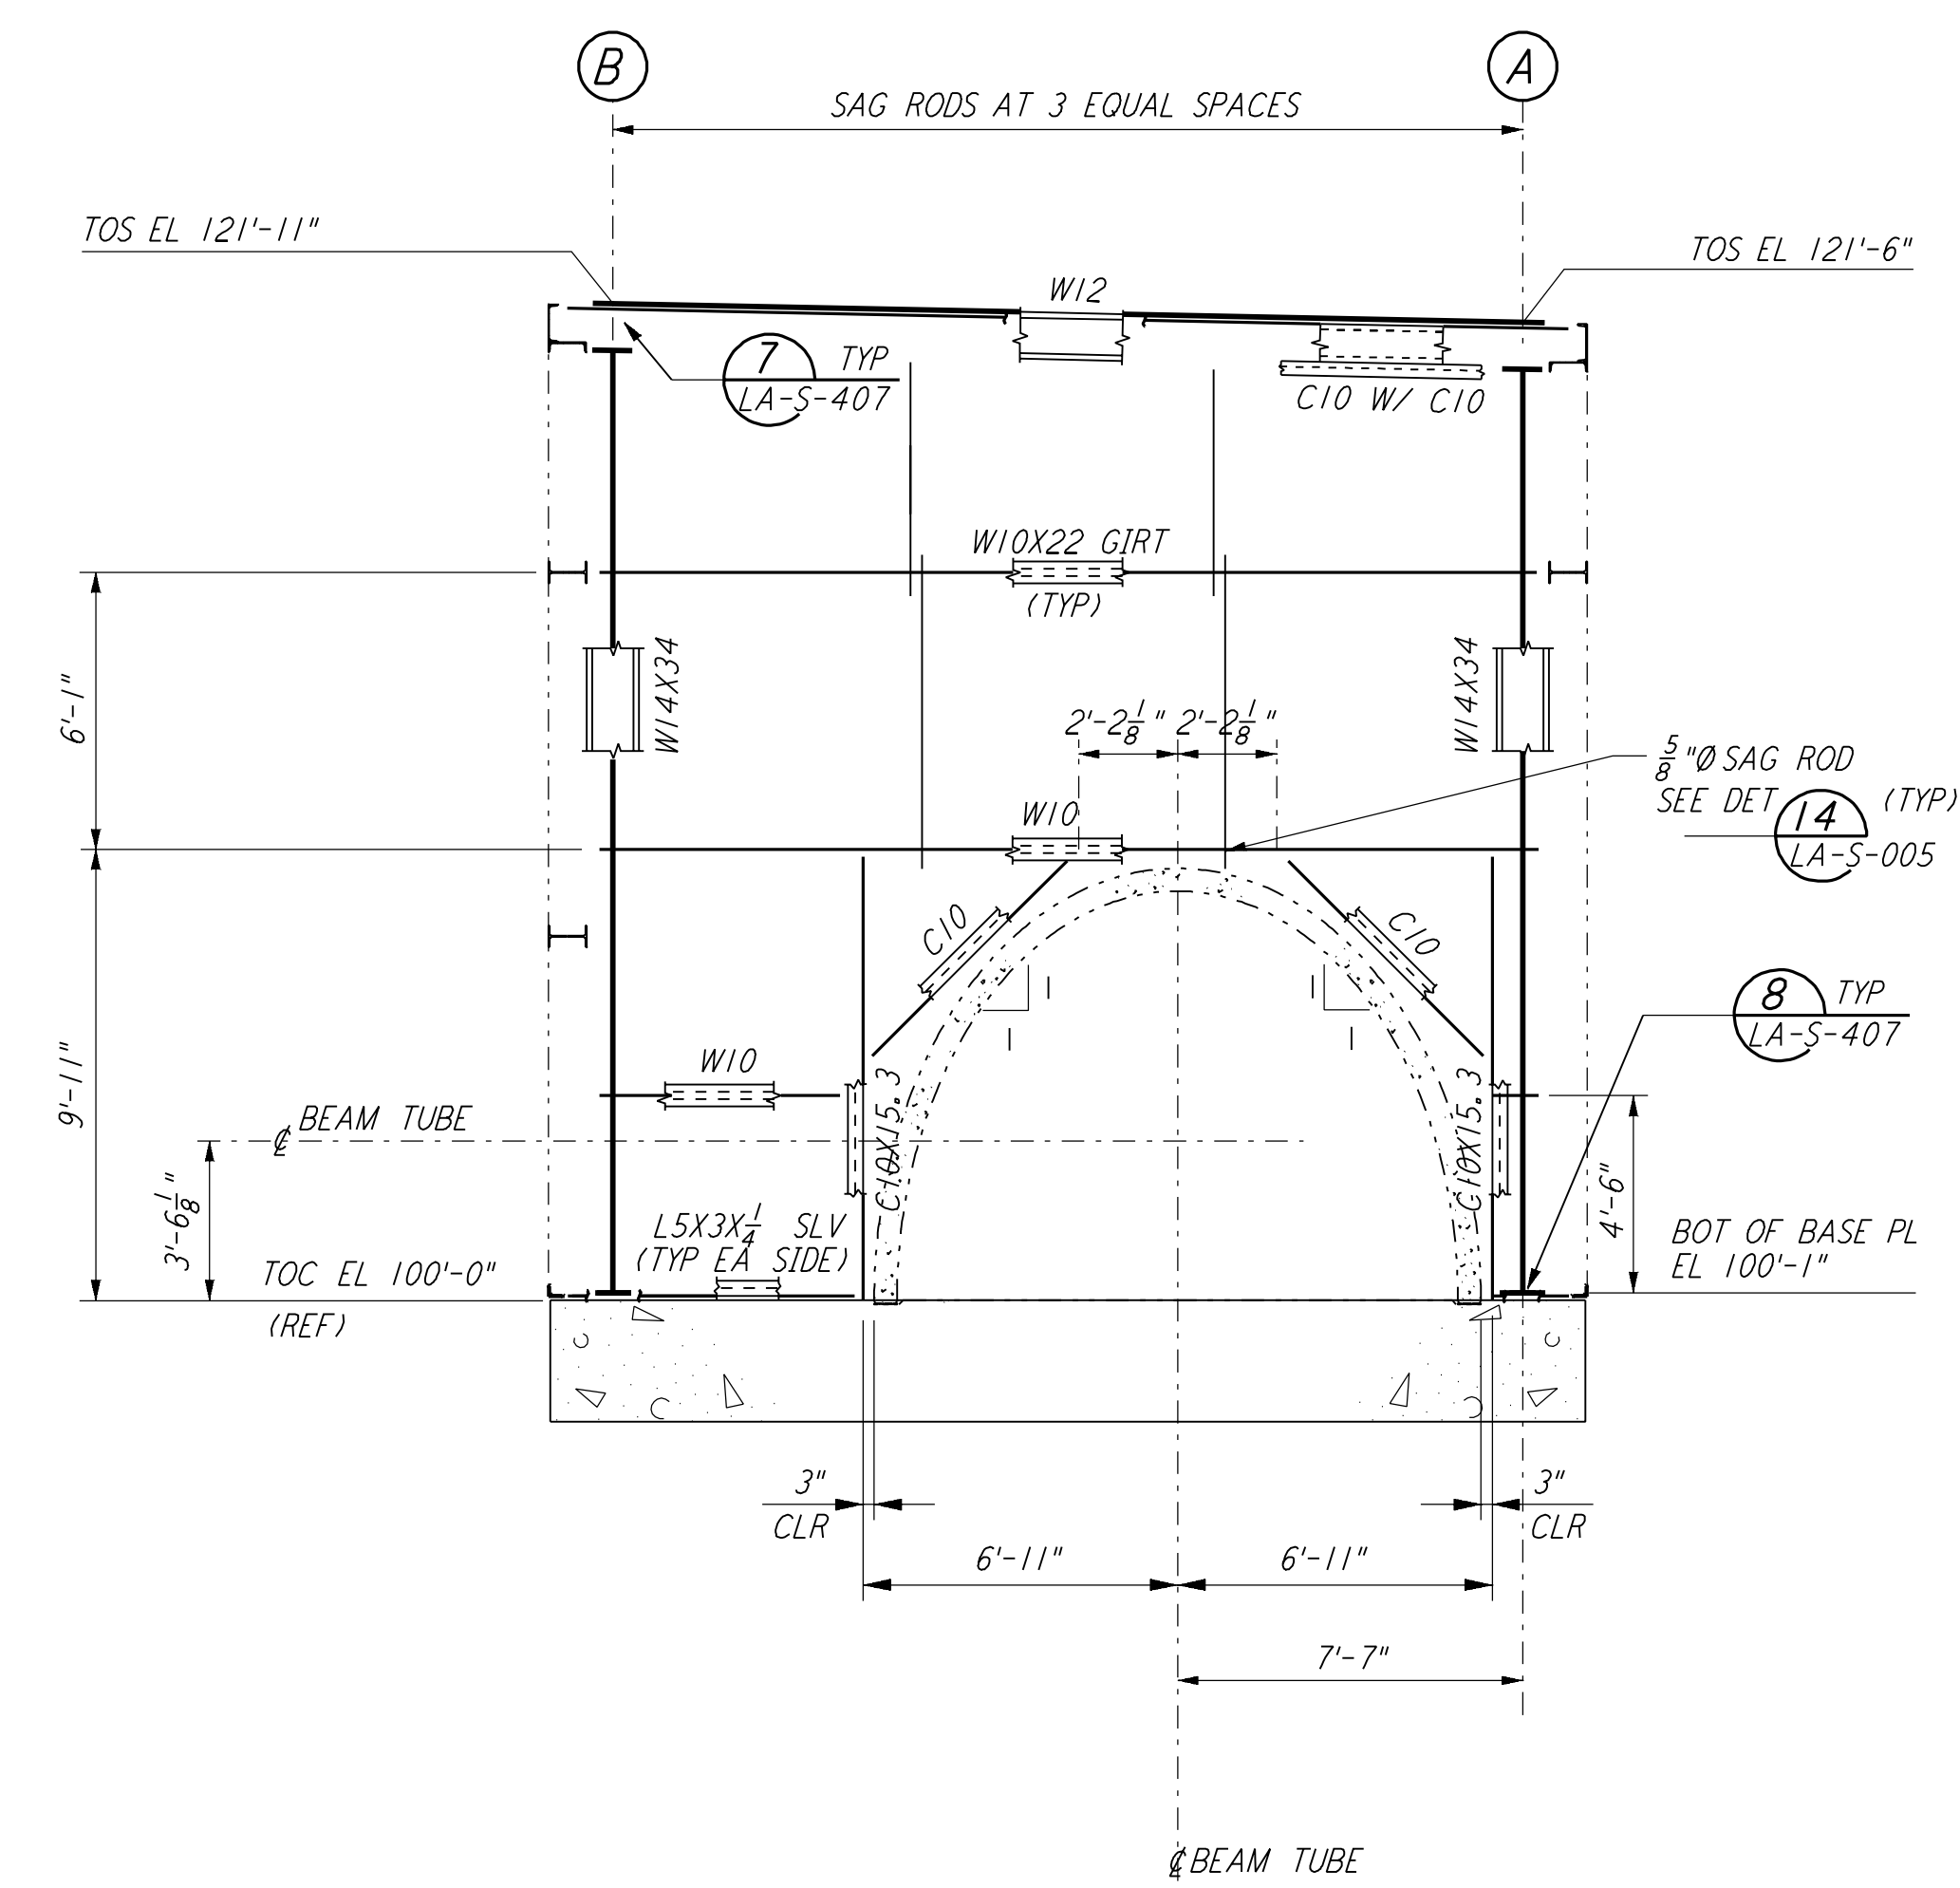

LOOKING WEST - FOR MID STATION "A" ON ARM 2  
 LOOKING NORTH - FOR MID STATION "B" ON ARM 1  
 ELEVATION AT COLUMN LINE 3  
 $\frac{1}{4}'' = 1'-0''$

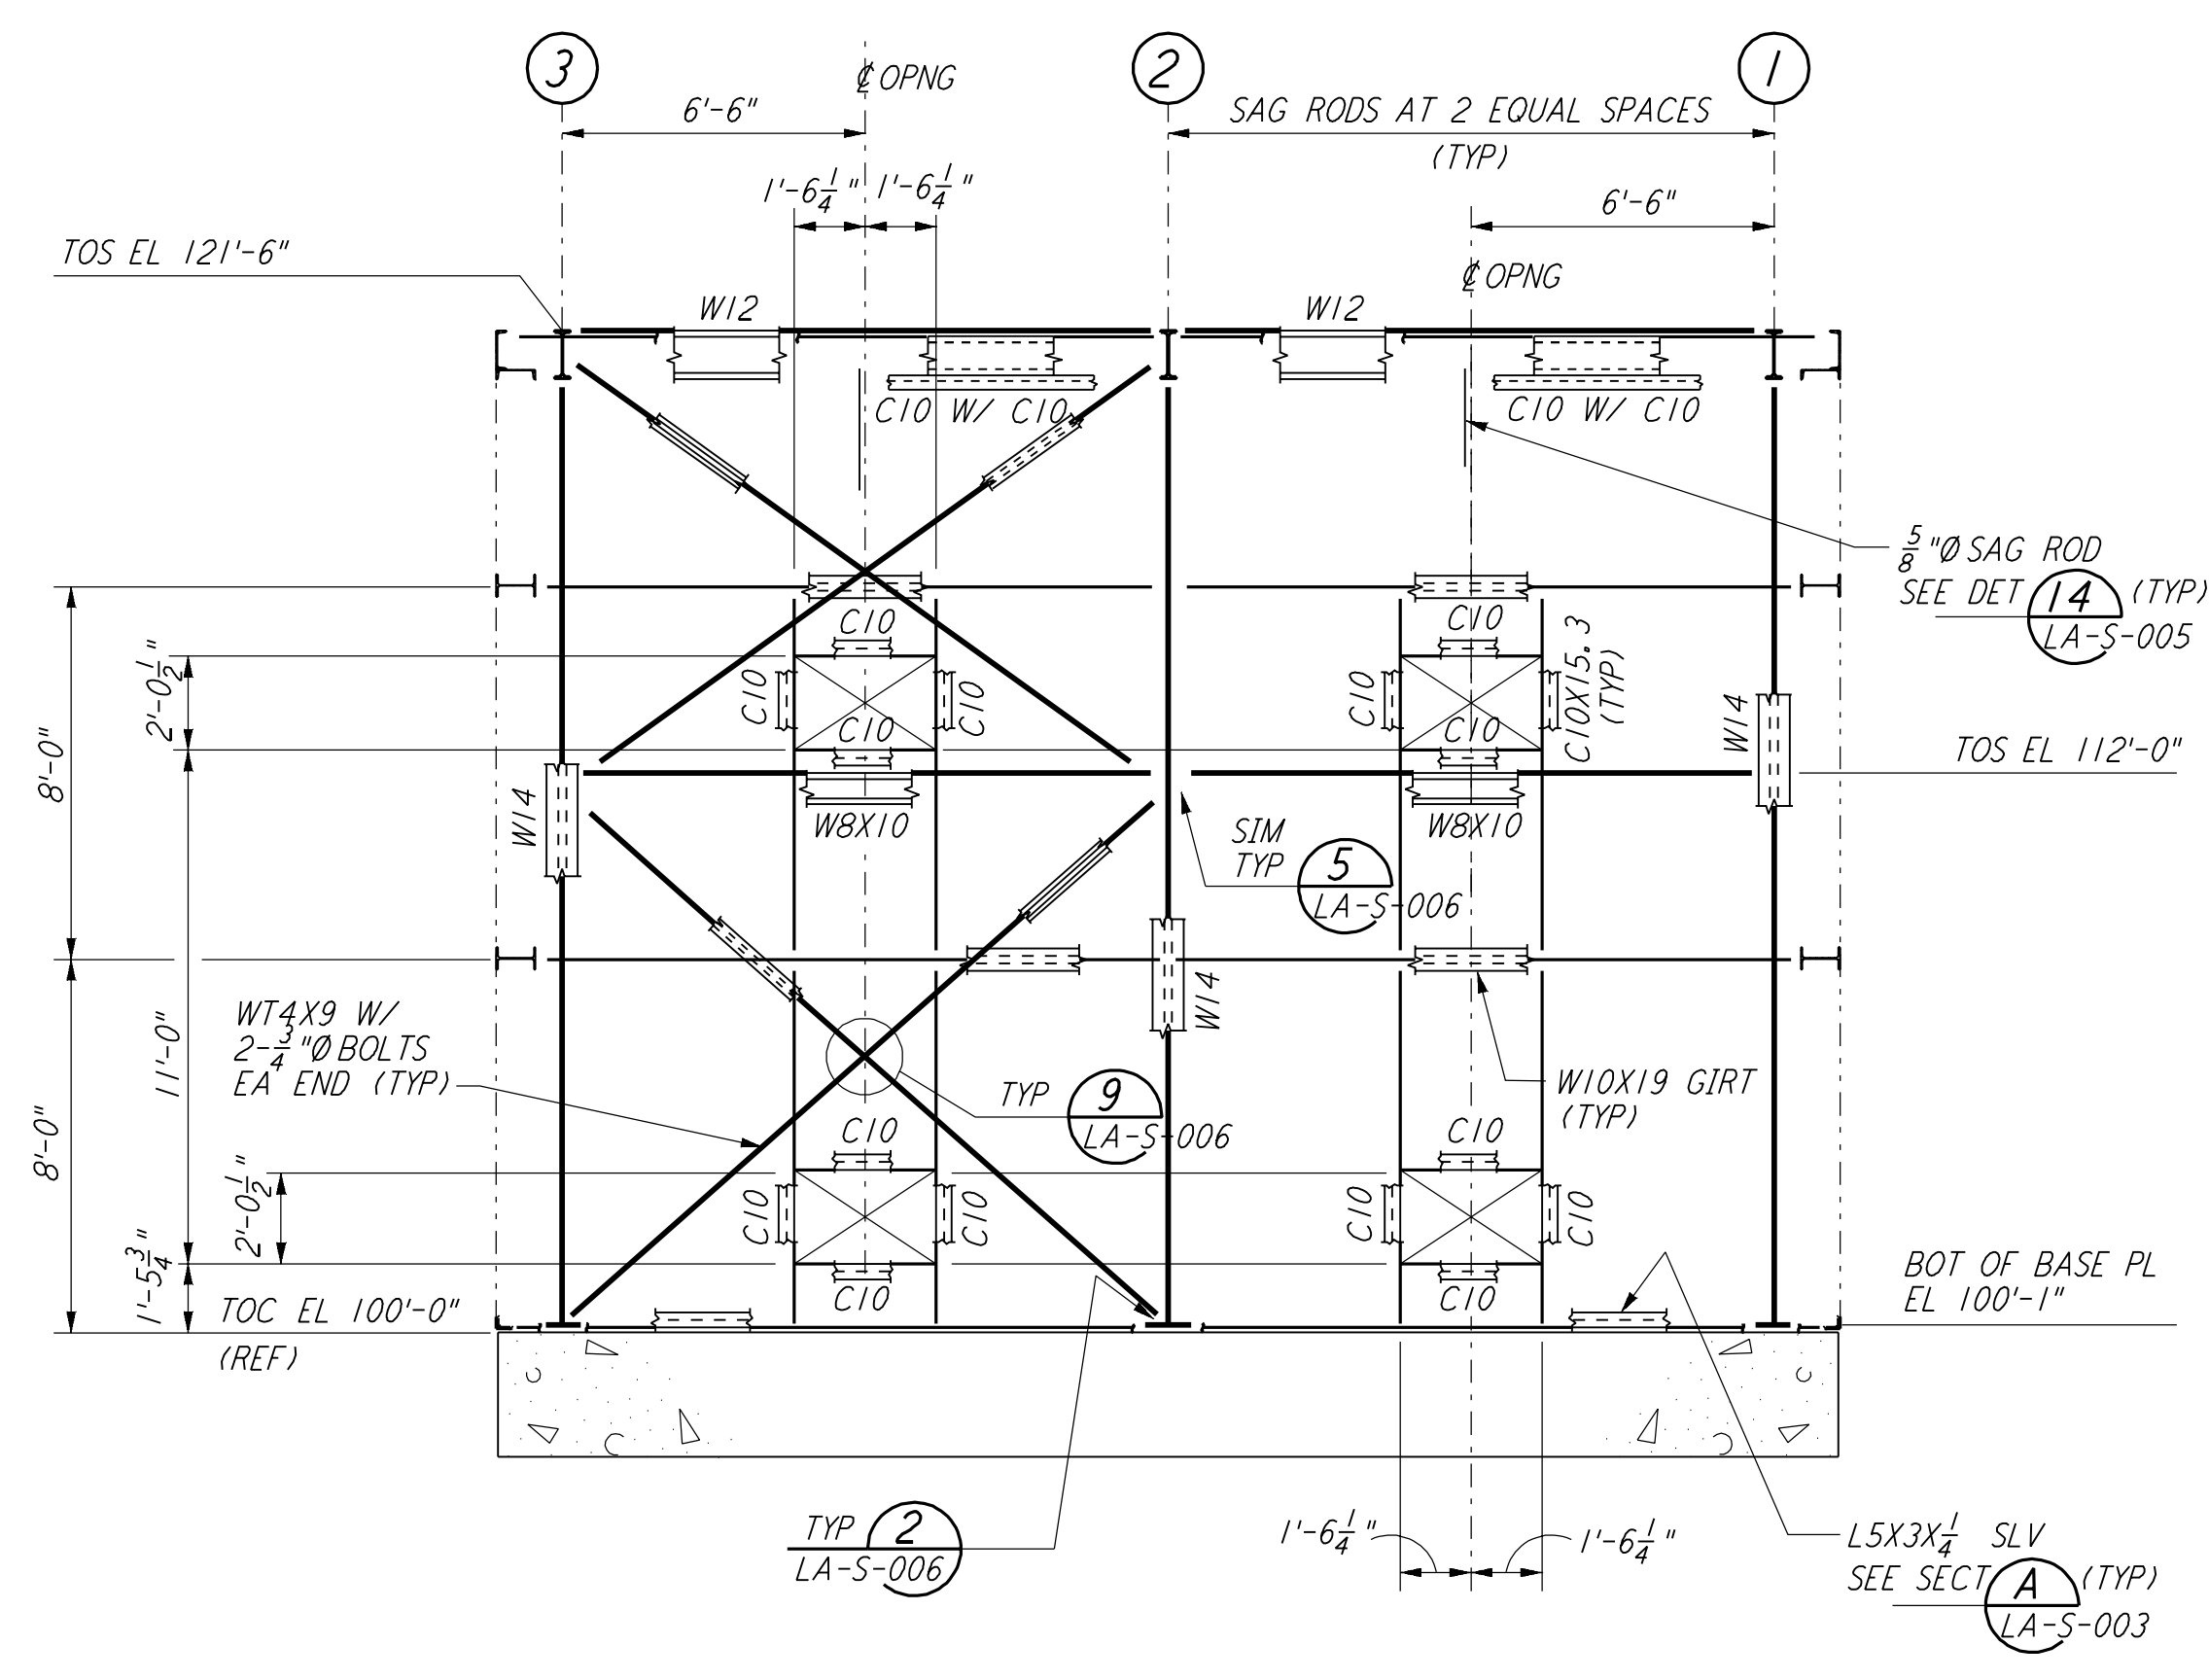


LOOKING SOUTH - FOR MID STATION "A" ON ARM 2  
 LOOKING EAST - FOR MID STATION "B" ON ARM 1  
 ELEVATION AT COLUMN LINE A  
 $\frac{1}{4}'' = 1'-0''$

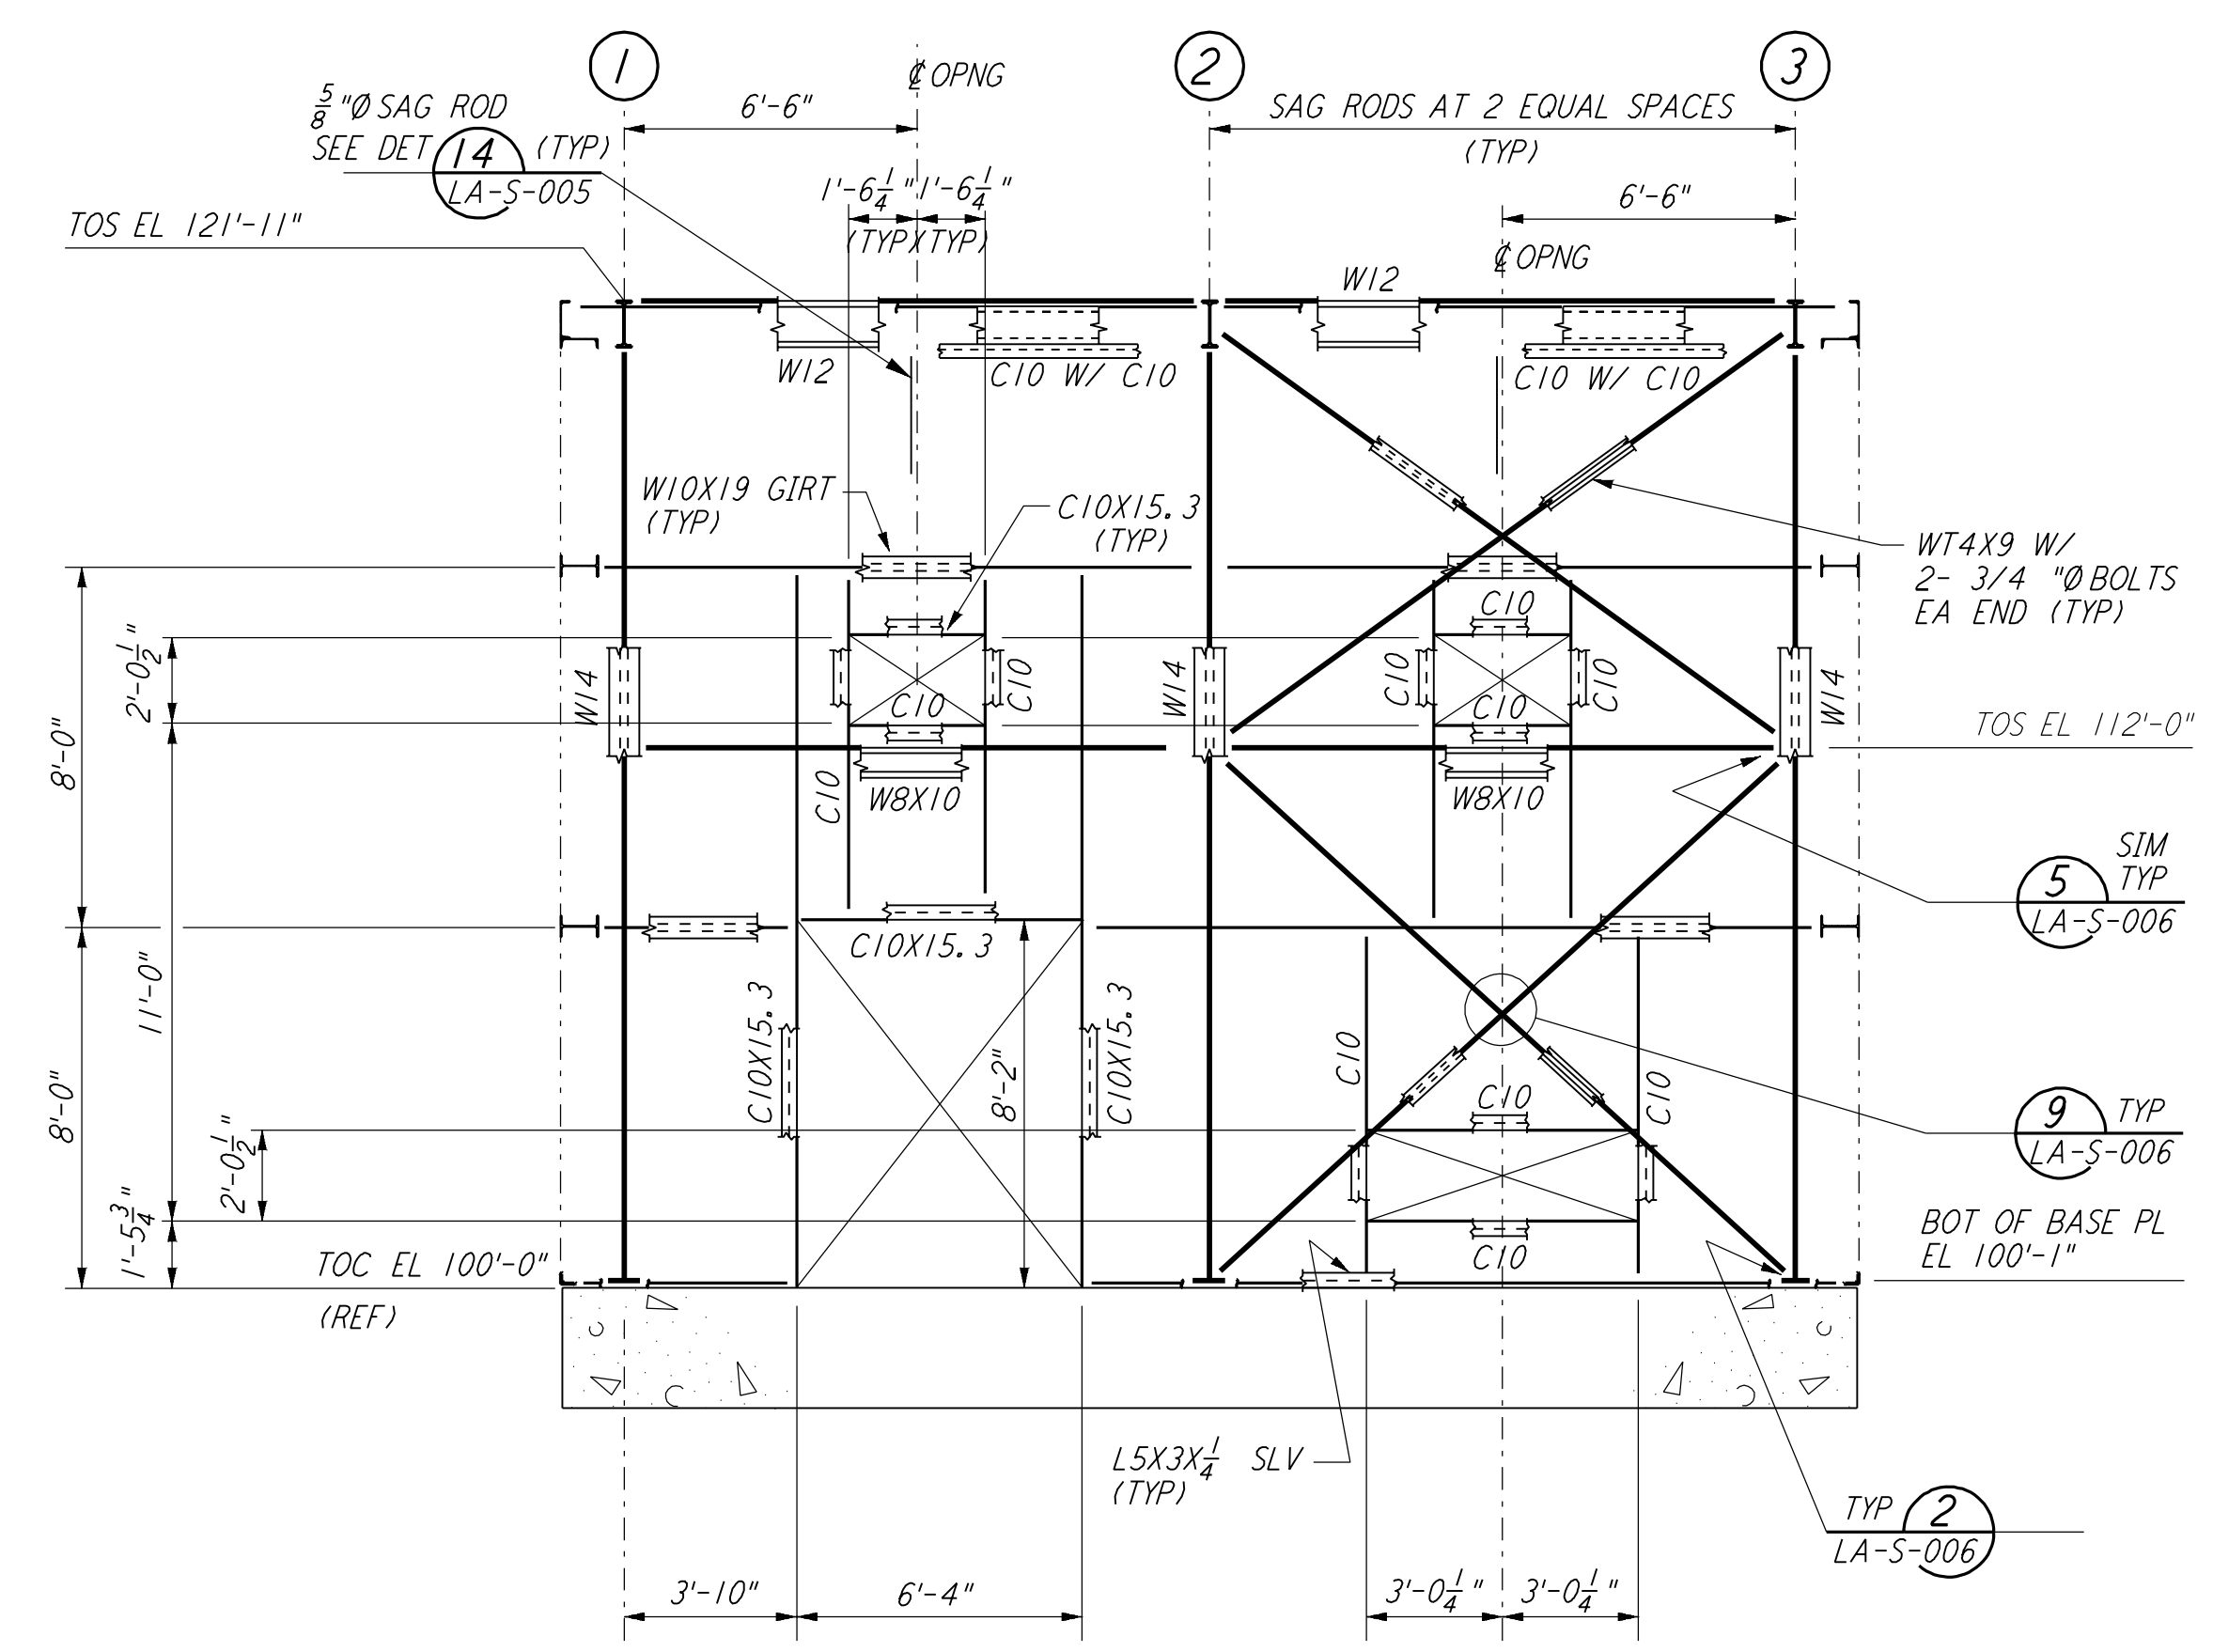

LOOKING NORTH - FOR MID STATION "A" ON ARM 2  
 LOOKING WEST - FOR MID STATION "B" ON ARM 1  
 ELEVATION AT COLUMN LINE B  
 $\frac{1}{4}'' = 1'-0''$

- NOTES:**
- FOR GENERAL NOTES, ABBREVIATIONS AND SYMBOLS, SEE DRAWING LA-S-001.
  - FOR CHANNEL, GIRT AND EAVE STRUT CONNECTION DETAILS, SEE DRAWING LA-S-005.
  - FOR BASE ANGLE (L5X3) CONNECTION, SEE (A) LA-S-003.

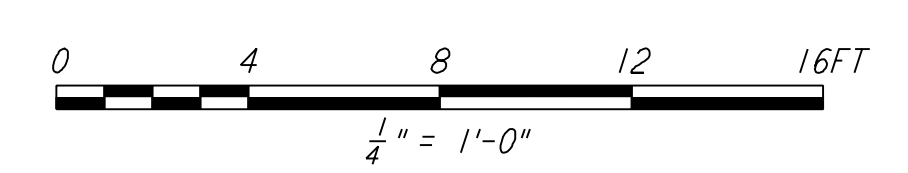

NO.	DATE	BY	CHKD	ENGR	PROJ	DESCRIPTION
2	08-07-98	WA				ISSUED FOR AS-BUILT
1	2-28-97	RM	AB	BP		REV ELEV AT LN 1, 2, 3, A & B

ISSUED FOR CONSTRUCTION			
DRAWN	MCS	11-15-96	
CHECKED	DDM	11-15-96	
ENGINEER	BP	11-15-96	
PROJ	TDM	11-15-96	

**AS-BUILT DRAWINGS**

**PARSONS**  
 100 WEST WALNUT STREET  
 PASADENA, CALIFORNIA

**LIGO**  
 CALIFORNIA INSTITUTE OF TECHNOLOGY  
 MASSACHUSETTS INSTITUTE OF TECHNOLOGY

LASER INTERFEROMETER  
 GRAVITATIONAL-WAVE OBSERVATORY  
 SITE NO. 2 - LIVINGSTON, LOUISIANA

**STRUCTURAL MID STATIONS "A" & "B" FRAMING ELEVATIONS**

SCALE: AS NOTED  
 CONTRACT NUMBER: PP150969  
 PROJECT NUMBER: 8094

SHEET NUMBER: **LA-S-203**