


**NOTES:**  
 1. FOR LEGEND, ABBREVIATIONS AND GENERAL NOTES SEE SHEETS LA-H-001 AND LA-H-002.

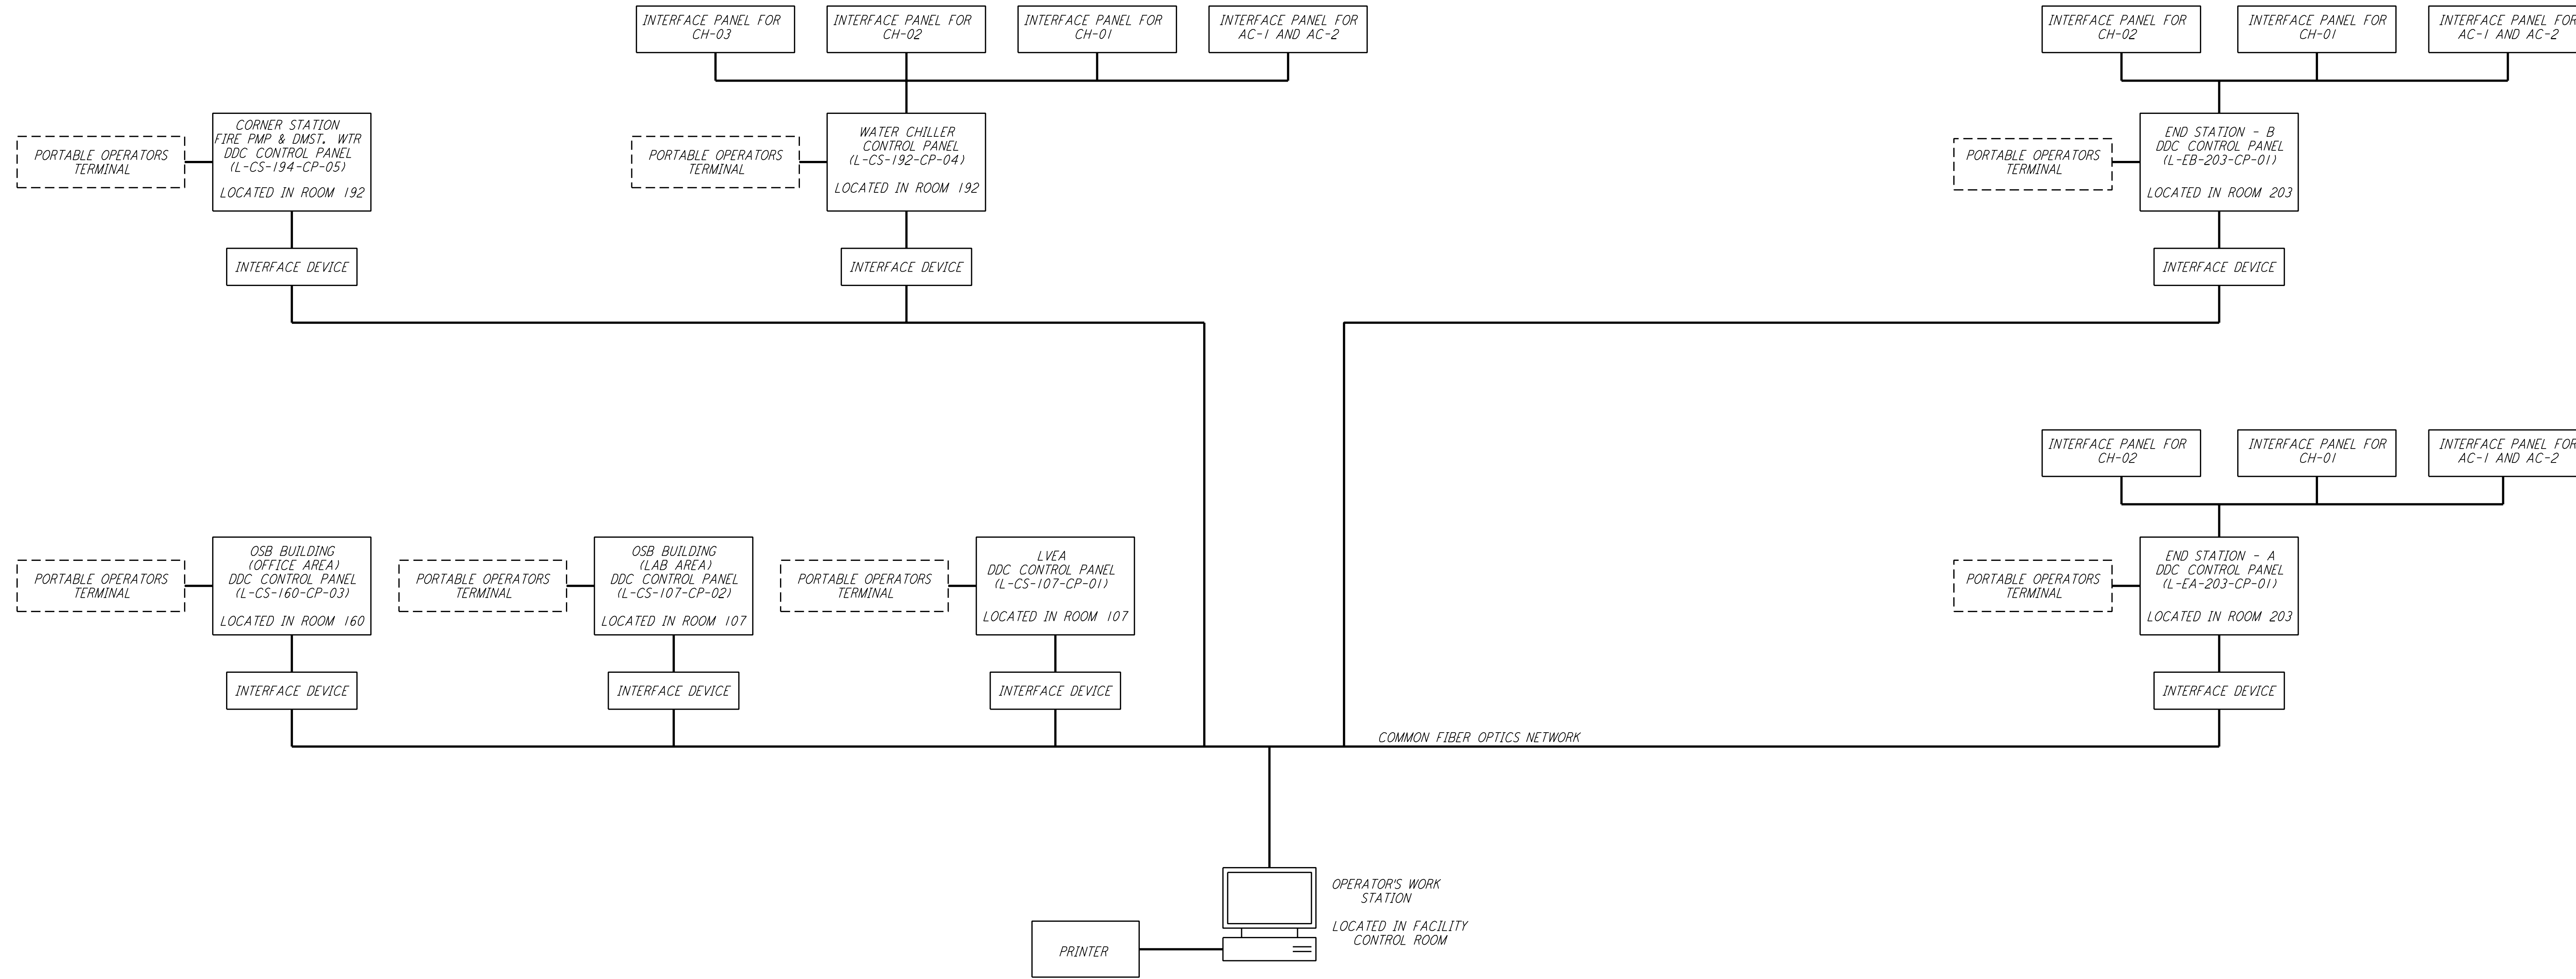

**CONTROL SYSTEM DIAGRAM**

This document and the design it covers are the property of PARSONS. They are loaned only with the borrower's expressed written agreement that they will not be reproduced, copied, loaned, exhibited, or used in any other way, except by written consent from PARSONS to the borrower.

NO.	DATE	BY	CHKD	ENGR	PROJ	DESCRIPTION
1	8-7-98	DJB				ISSUED FOR AS-BUILT

ISSUED FOR CONSTRUCTION		
DRAWN	CLP	11-15-96
CHECKED	MN	10-25-96
ENGINEER	AA	1-23-96
PROJ	TDM	11-15-96
<b>AS-BUILT DRAWINGS</b>		



**LIGO-D960966-01-0**

**LASER INTERFEROMETER GRAVITATIONAL-WAVE OBSERVATORY SITE NO.2 - LIVINGSTON, LOUISIANA**

TITLE	SCALE	CONTRACT NUMBER	PROJECT NUMBER
HVAC CONTROL SYSTEM DIAGRAM	NONE	PP150969	8094
<b>LA-H-007</b>			

Wed Oct 7 14:11:07 1998 c:\lhb007\ref\53-28.dwg V:\DDES\ES\2082\lhb007.dwg

*Note 1, LIGO, 04/07/99 07:42:47 PM*  
LIGO-D960966-01-O