


NOTES:
 1. FOR LEGEND, ABBREVIATIONS AND GENERAL NOTES SEE SHEETS LA-H-001 AND LA-H-002.

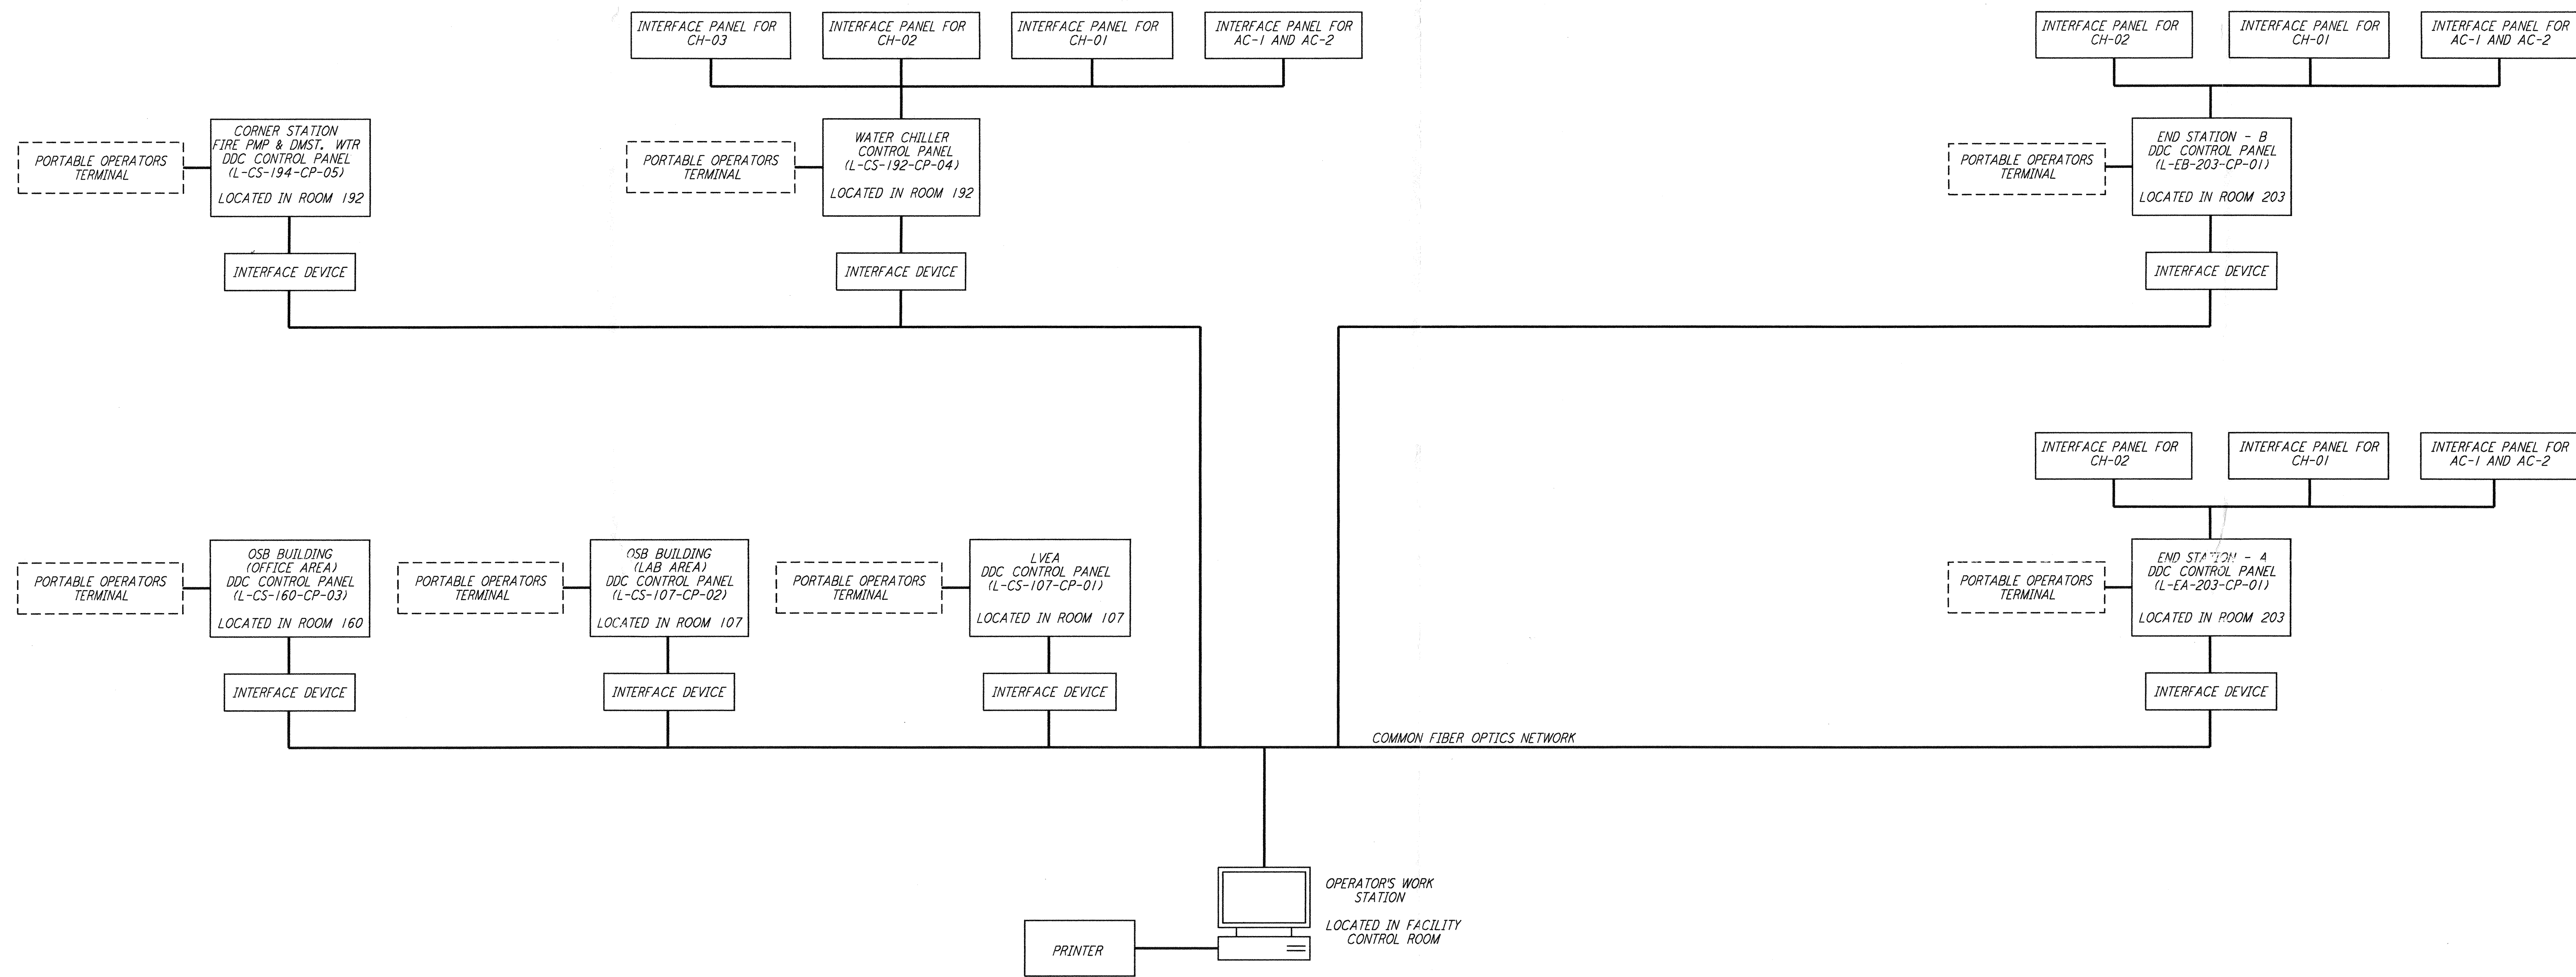

CONTROL SYSTEM DIAGRAM
 BY LANDIS-STAEFA
 (504) 466-9300
 NEW ORLEANS, LA

This document and the design it covers are the property of PARSONS. They are loaned only with the borrower's expressed written agreement that they will not be reproduced, copied, loaned, exhibited, or used in any other way, except by written consent from PARSONS to the borrower.

| NO. | DATE | BY | CHKD | ENGR | PROJ | DESCRIPTION |
|-----|---------|-----|------|------|------|----------------------------|
| 2 | 5-21-99 | AO | AA | AA | MDW | ISSUED AS REVISED AS-BUILT |
| 1 | 8-7-98 | DJB | AA | AA | MDW | ISSUED FOR AS-BUILT |

ISSUED FOR CONSTRUCTION
 DRAWN CLP 11-15-96
 CHECKED MN 10-25-96
 ENGINEER AA 1-23-96
 PROJ TDM 11-15-96

AS-BUILT DRAWINGS



LIGO-D960966-02-0

LASER INTERFEROMETER GRAVITATIONAL-WAVE OBSERVATORY
 SITE NO.2 - LIVINGSTON, LOUISIANA

| | | | |
|-----------------------------|-------|-----------------|----------------|
| TITLE | SCALE | CONTRACT NUMBER | PROJECT NUMBER |
| HVAC CONTROL SYSTEM DIAGRAM | NONE | PP150969 | 8094 |
| SHEET NUMBER | | REVISIONS | |
| LA-H-007 | | | |

C:\PLOT\JOB\ES3\T3882.dwg 52885 KAT3882.dwg 08/07/99