


NOTES:
 1. FOR LEGEND, ABBREVIATIONS AND GENERAL NOTES SEE SHEETS LA-H-001 AND LA-H-002.

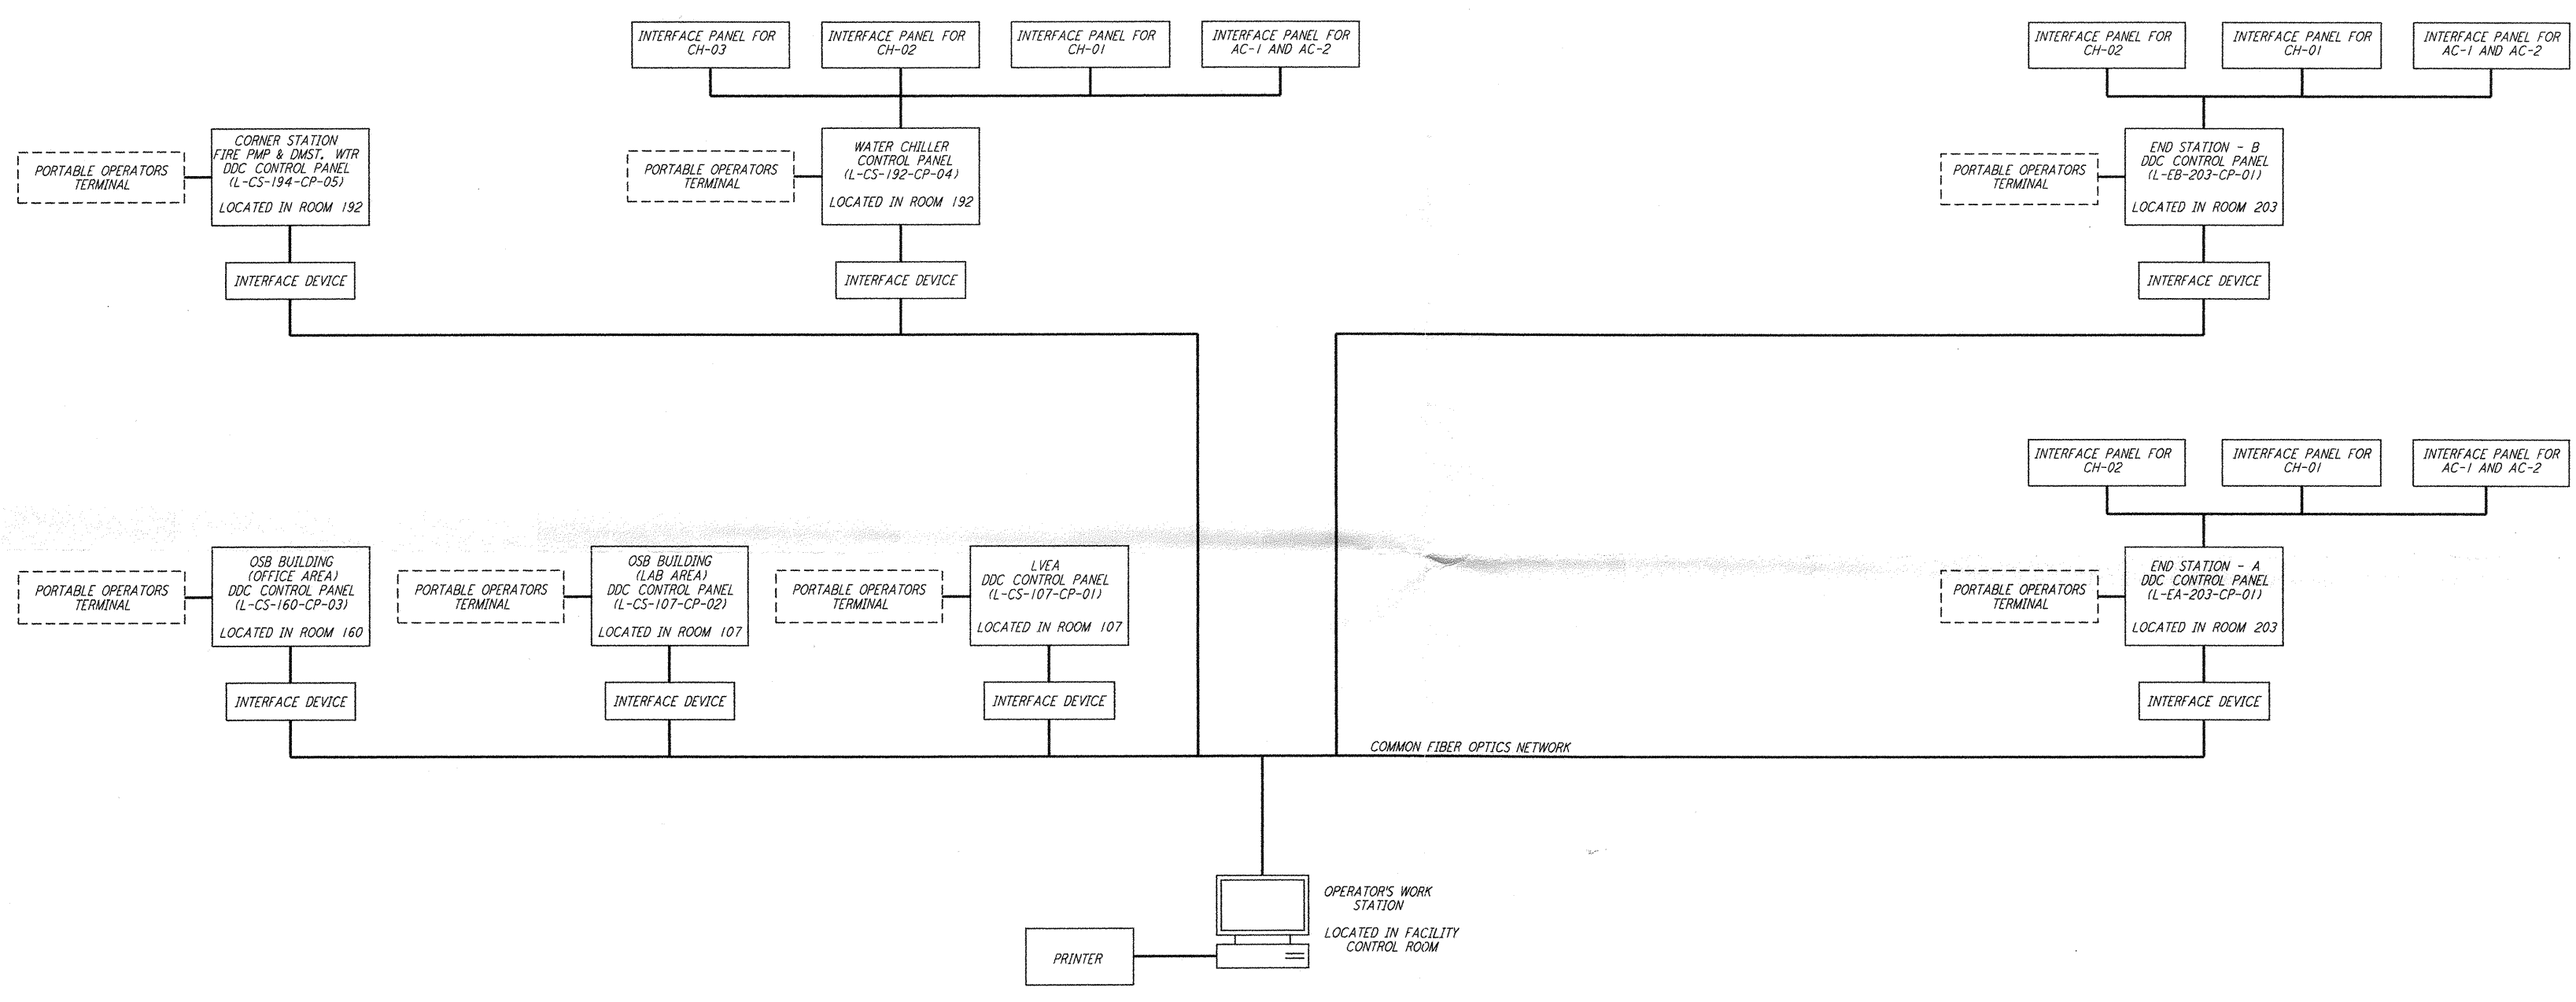


CONTROL SYSTEM DIAGRAM
 BY LANDIS-STAEFA
 (504) 466-9300
 NEW ORLEANS, LA

This document and the design it covers are the property of PARSONS. They are loaned only with the borrower's expressed written agreement that they will not be reproduced, copied, loaned, exhibited, or used in any other way, except by written consent from PARSONS to the borrower.

NO.	DATE	BY	CHKD	ENGR	PROJ	DESCRIPTION
2	5-21-99	AO	AA	AA		ISSUED AS REVISED AS-BUILT
1	8-7-98	DJB	AA	AA	MDW	ISSUED FOR AS-BUILT

ISSUED FOR CONSTRUCTION
 DRAWN CLP 11-15-96
 CHECKED MN 10-25-96
 ENGINEER AA 1-23-96
 PROJ TDM 11-15-96

AS-BUILT DRAWINGS

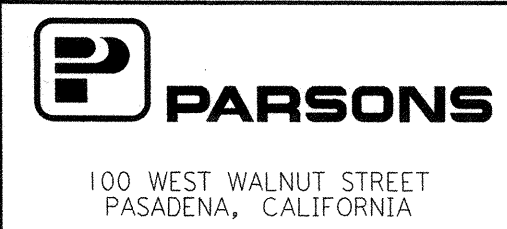

LIGO-D960966-02-0

LASER INTERFEROMETER GRAVITATIONAL-WAVE OBSERVATORY
 SITE NO. 2 - LIVINGSTON, LOUISIANA

HVAC CONTROL SYSTEM DIAGRAM

SHEET NUMBER	NONE	CONTRACT NUMBER	PP150969	PROJECT NUMBER	8094
LA-H-007					

5/2/99 2:43:04 PM C:\PLOT\QUE\33713862.dwg 52085 KAT1862.mdb\pbf L100LAF.BDR