


END STATION "A" CHILLER YARD PLAN
 1/4" = 1'-0"

- NOTES:**
1. FOR LEGEND, ABBREVIATIONS AND GENERAL NOTES SEE SHEET LA-H-001 AND LA-H-002.
 2. MAINTAIN 6"-8" CLEAR HEIGHT UNDER PIPES, FOR PIPE SUPPORT DETAILS SEE STRUCTURAL DRAWING WA-S-407.
 3. PROVIDE FLOOR MOUNTED ELBOW SUPPORT AT THE PUMP SUCTION. CONTRACTOR MAY USE SUCTION DIFFUSER/STRAINER.
 4. REFER TO SPECIFICATIONS FOR PIPE SUPPORT REQUIREMENTS.
 5. SUPPORT PIPING TO ELIMINATE ANY LOADS TRANSMITTED FROM PIPING TO PUMPS AND CHILLERS.
 6. FOR PIPING FLOW DIAGRAM SEE SHEET LA-H-221.
 7. FOR CHILLERS AND PUMPS PIPING DETAILS SEE SHEETS LA-H-411 AND LA-H-412.
 8. FOR EXACT LOCATION OF THE CHILLERS AND PUMPS SEE CIVIL DRAWINGS.

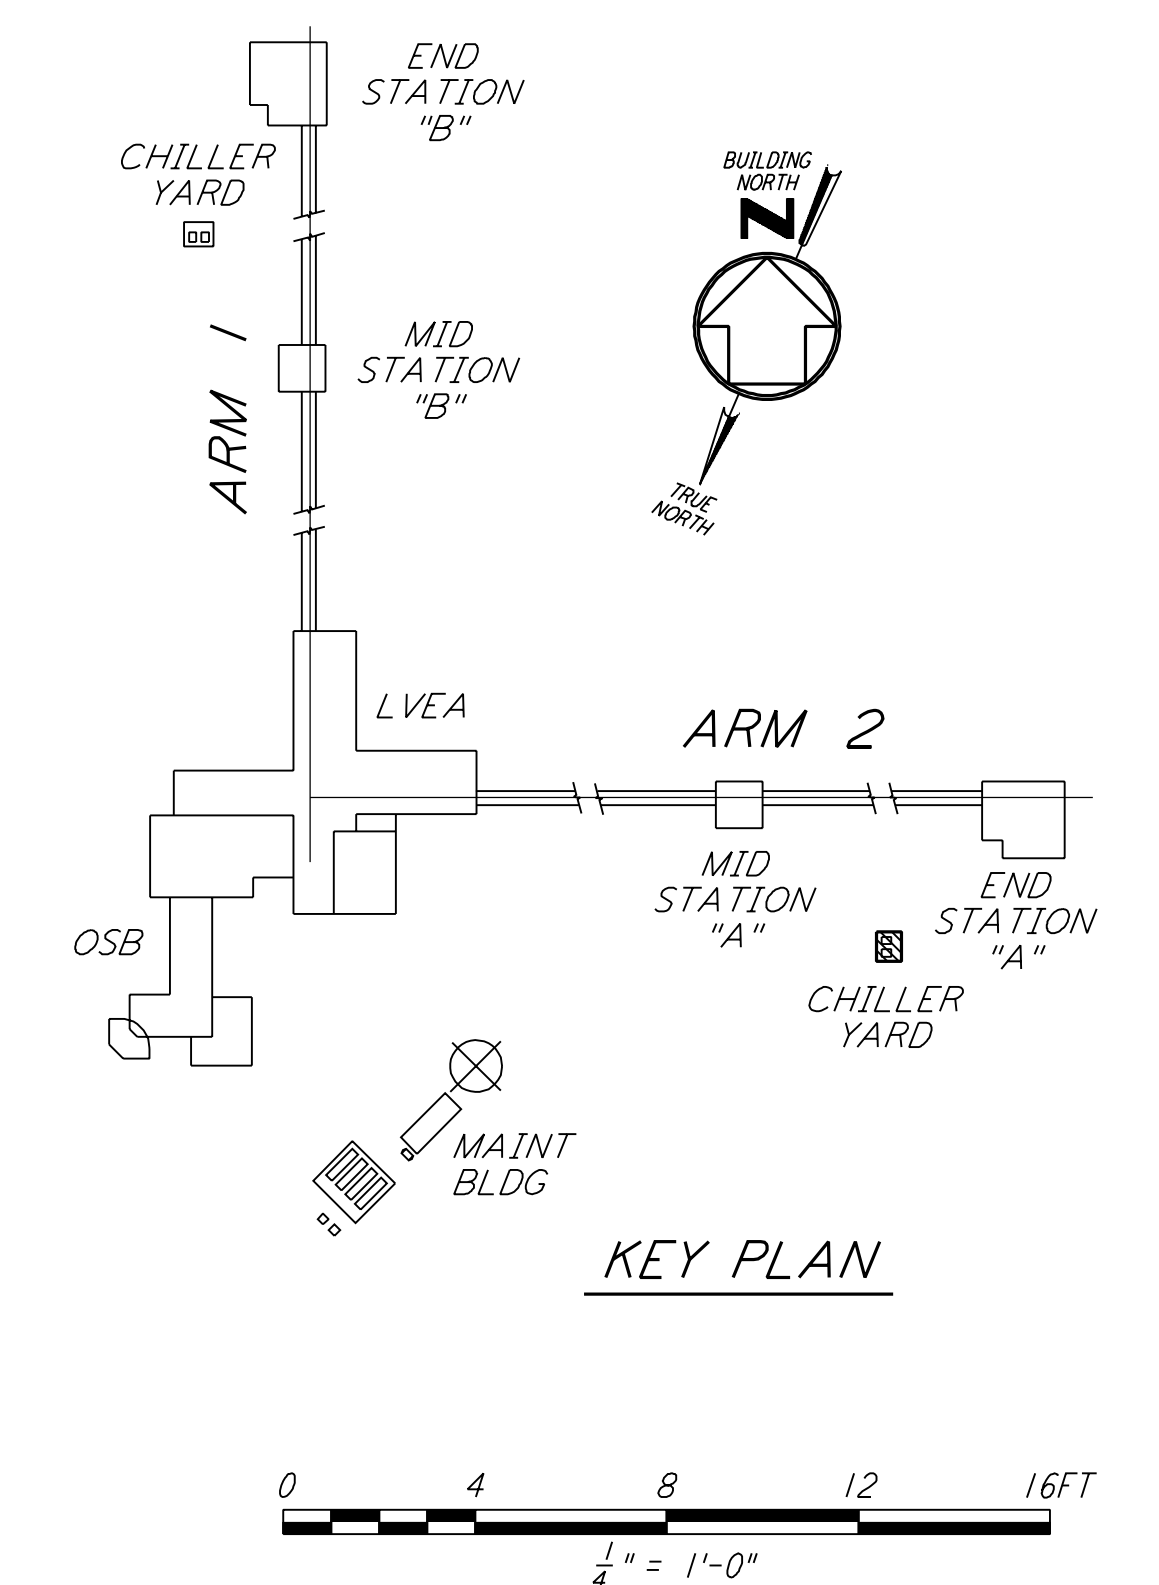

LIGO-D960984-01-O

LASER INTERFEROMETER GRAVITATIONAL-WAVE OBSERVATORY SITE NO. 2 - LIVINGSTON, LOUISIANA		SCALE AS NOTED	CONTRACT NUMBER PP150969	PROJECT NUMBER 8094
HVAC END STATION "A" CHILLER YARD PLAN		SHEET NUMBER LA-H-213		REVISIONS 1

PARSONS
 100 WEST WALNUT STREET
 PASADENA, CALIFORNIA

LIGO
 CALIFORNIA INSTITUTE OF TECHNOLOGY
 MASSACHUSETTS INSTITUTE OF TECHNOLOGY

ISSUED FOR CONSTRUCTION	DRAWN	CLP	11-15-96
	CHECKED	MN	10-25-96
	ENGINEER	AA	1-23-96
	PROJ	TDM	11-15-96
AS-BUILT DRAWINGS			
ISSUED FOR AS-BUILT			
NO.	DATE	BY	DESCRIPTION
1	8-7-98	DJB	

This document and the design it covers are the property of **PARSONS**. They are loaned only with the borrower's expressed written agreement that they will not be reproduced, copied, loaned, exhibited, or used in any other way, except by written consent from **PARSONS** to the borrower.

Wed Oct 7 14:51:55 1998 c:\lgo\site2\mu\lah213.d3z.ppp

Note 1, LIGO, 04/07/99 07:57:05 PM
LIGO-D960984-01-O