




WALL MOUNTED FIRE DAMPER (1) REF
 NTS LA-H-411

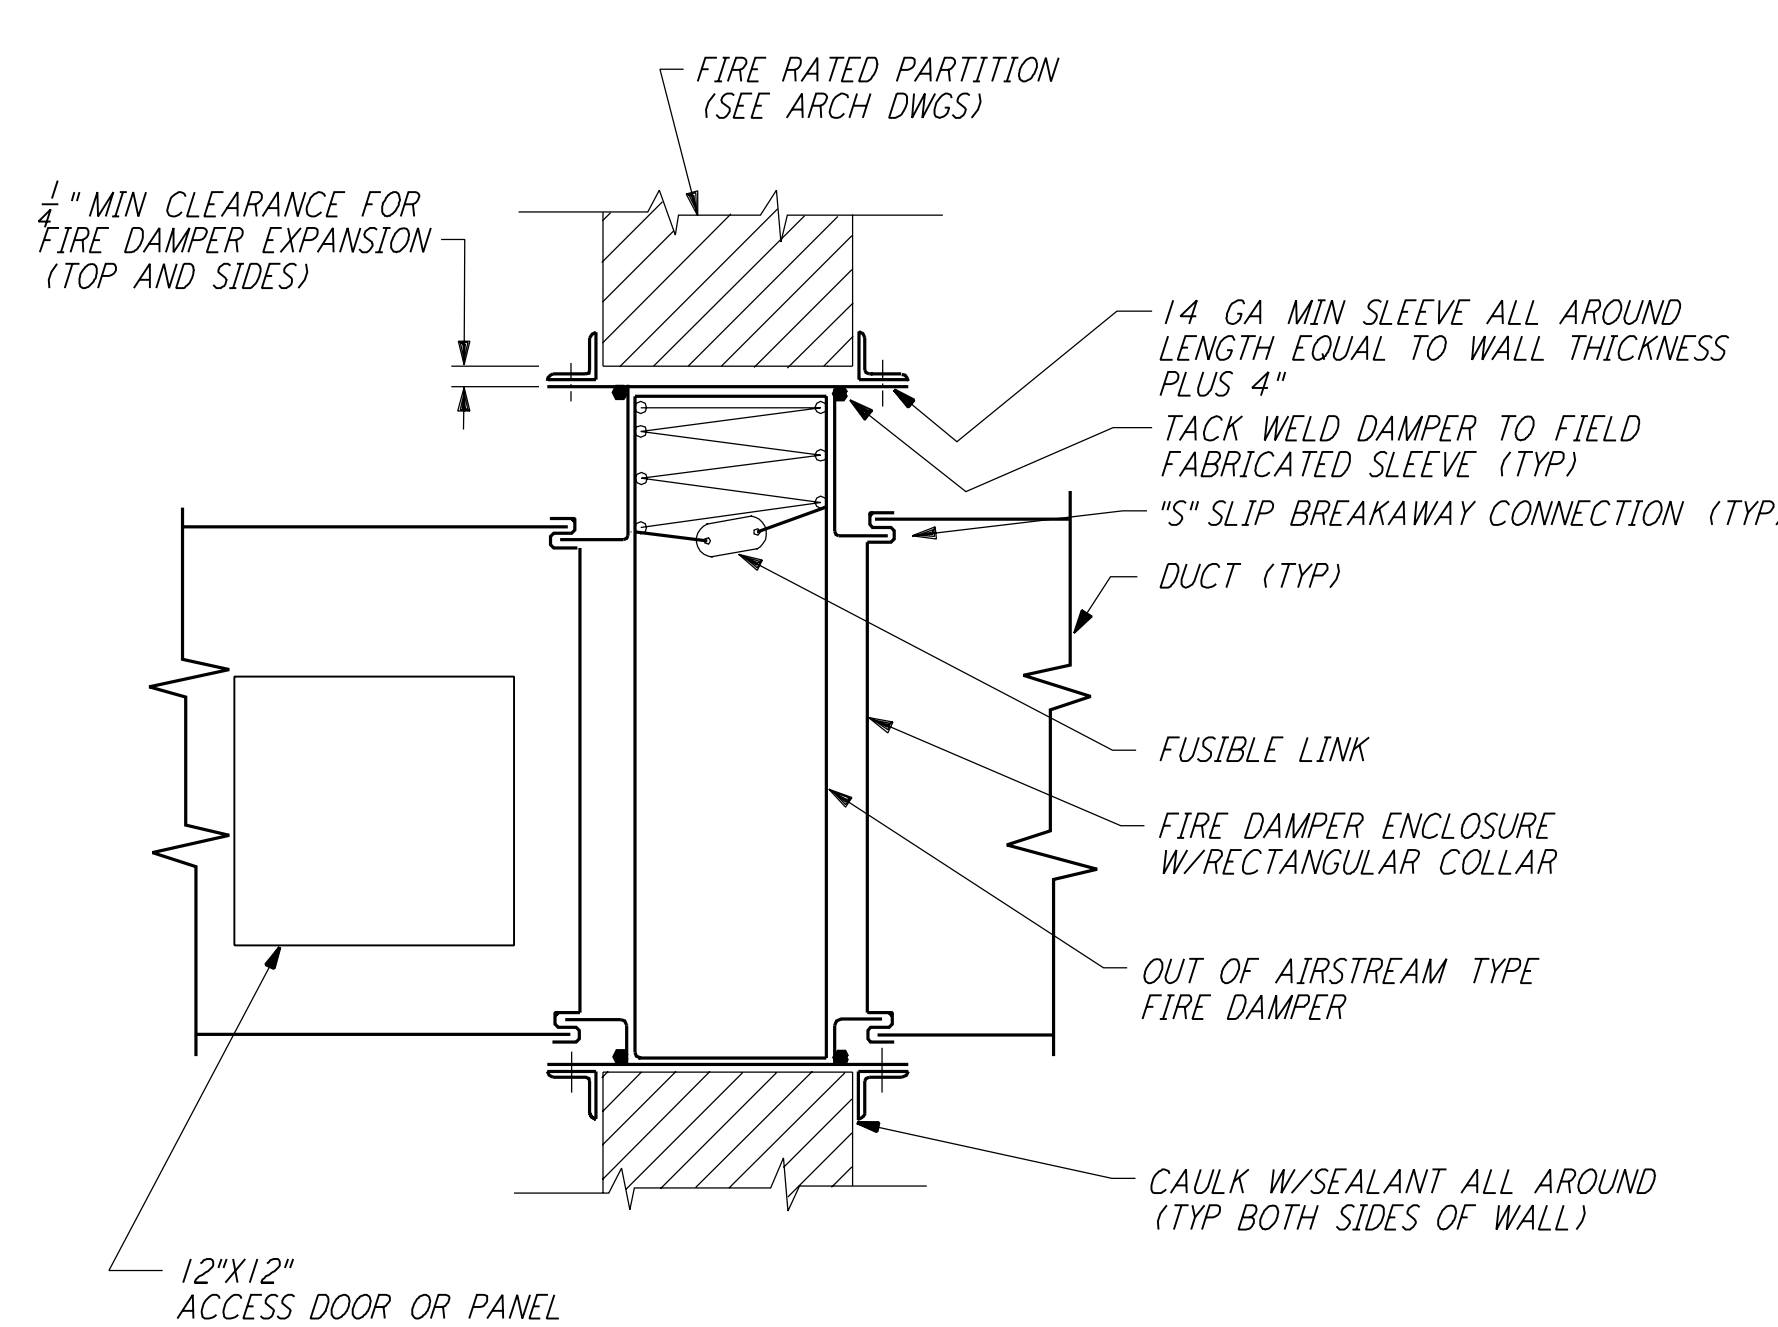


RECTANGULAR DUCT FIRE DAMPER (2) REF
 NTS LA-H-411

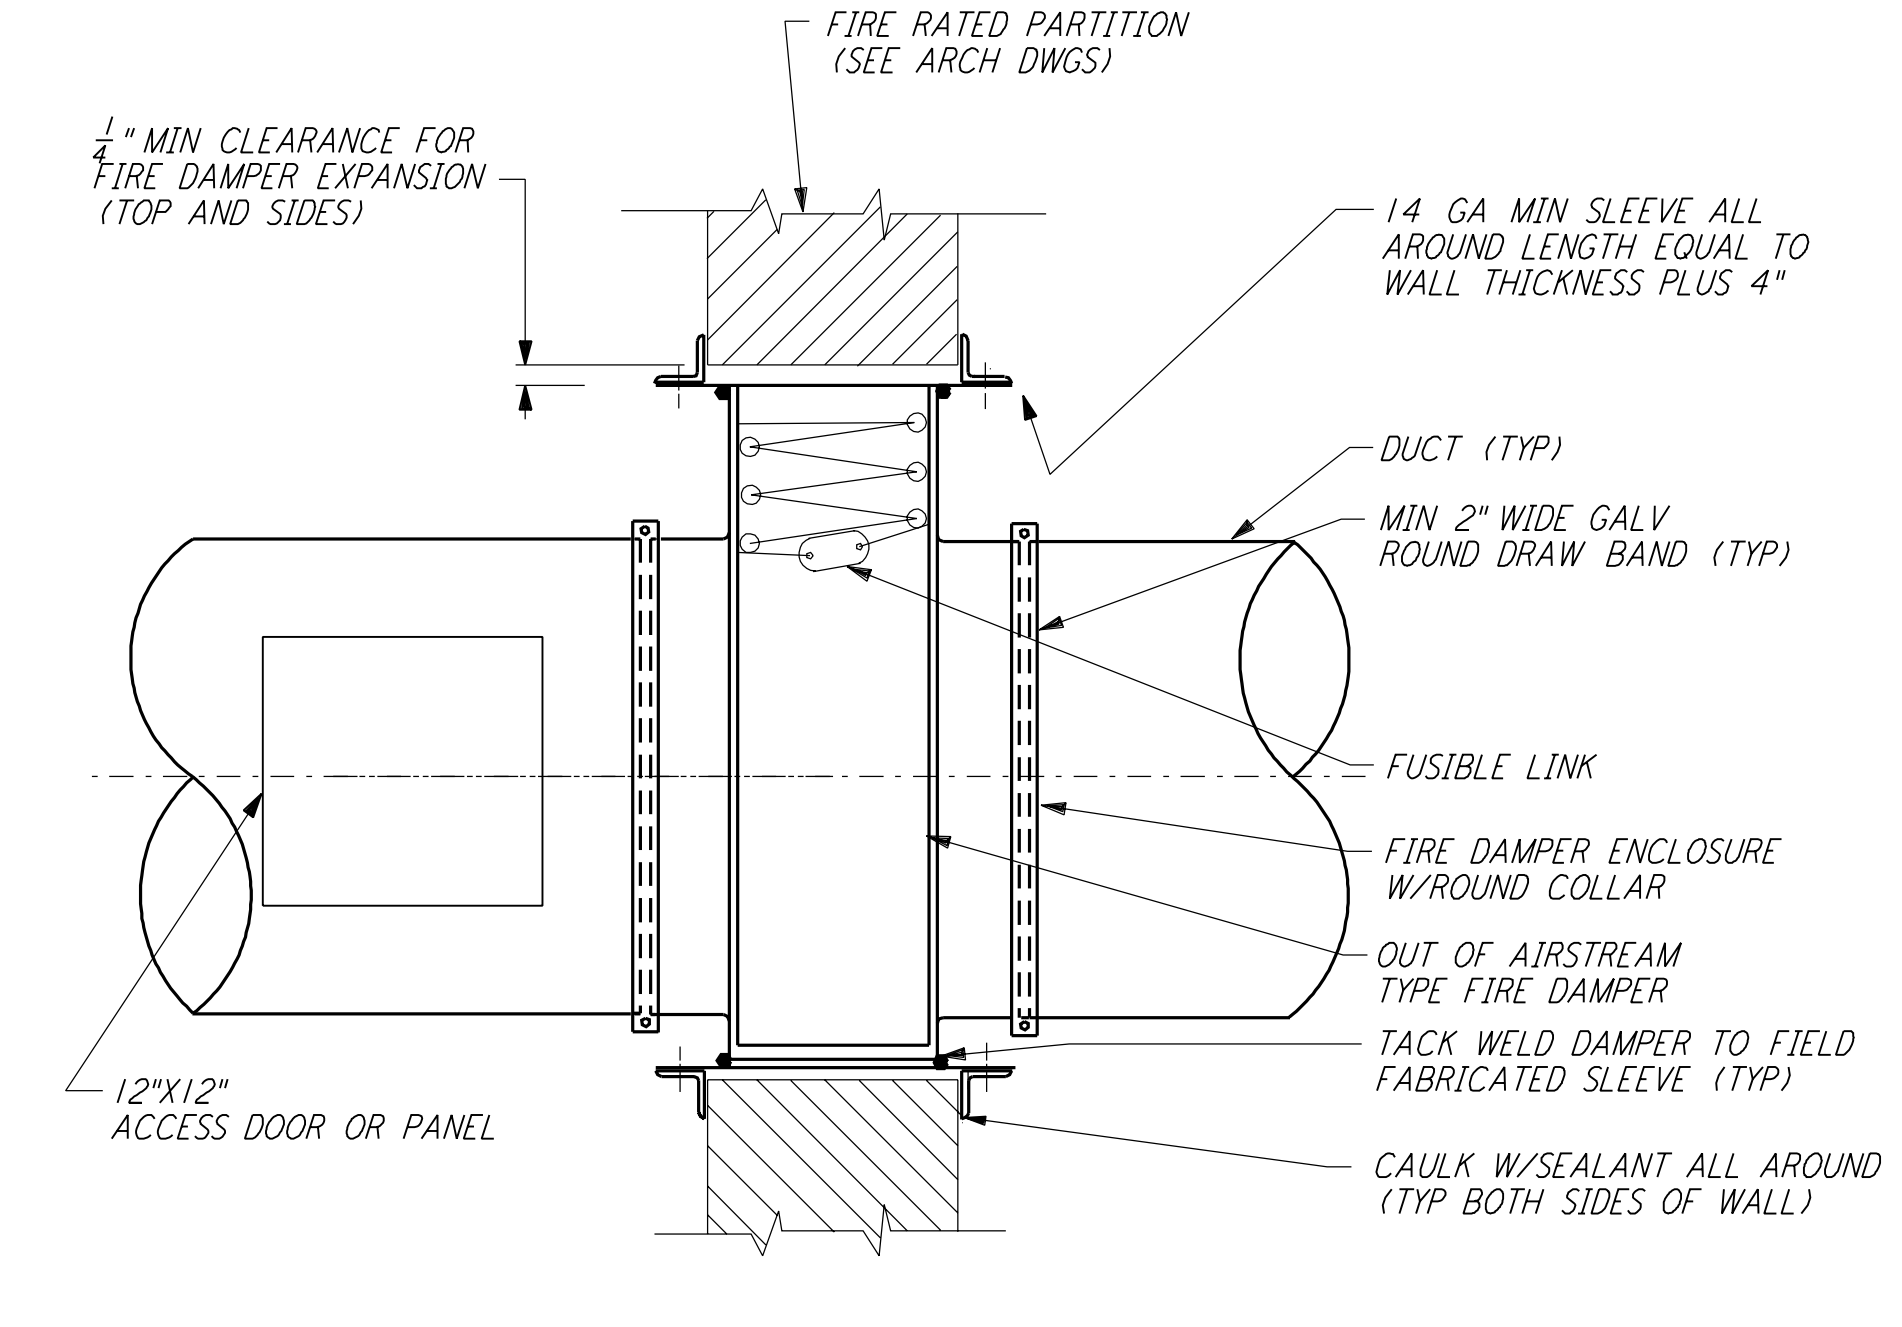


ROUND DUCT FIRE DAMPER MOUNTING DETAIL (3) REF
 NTS LA-H-411

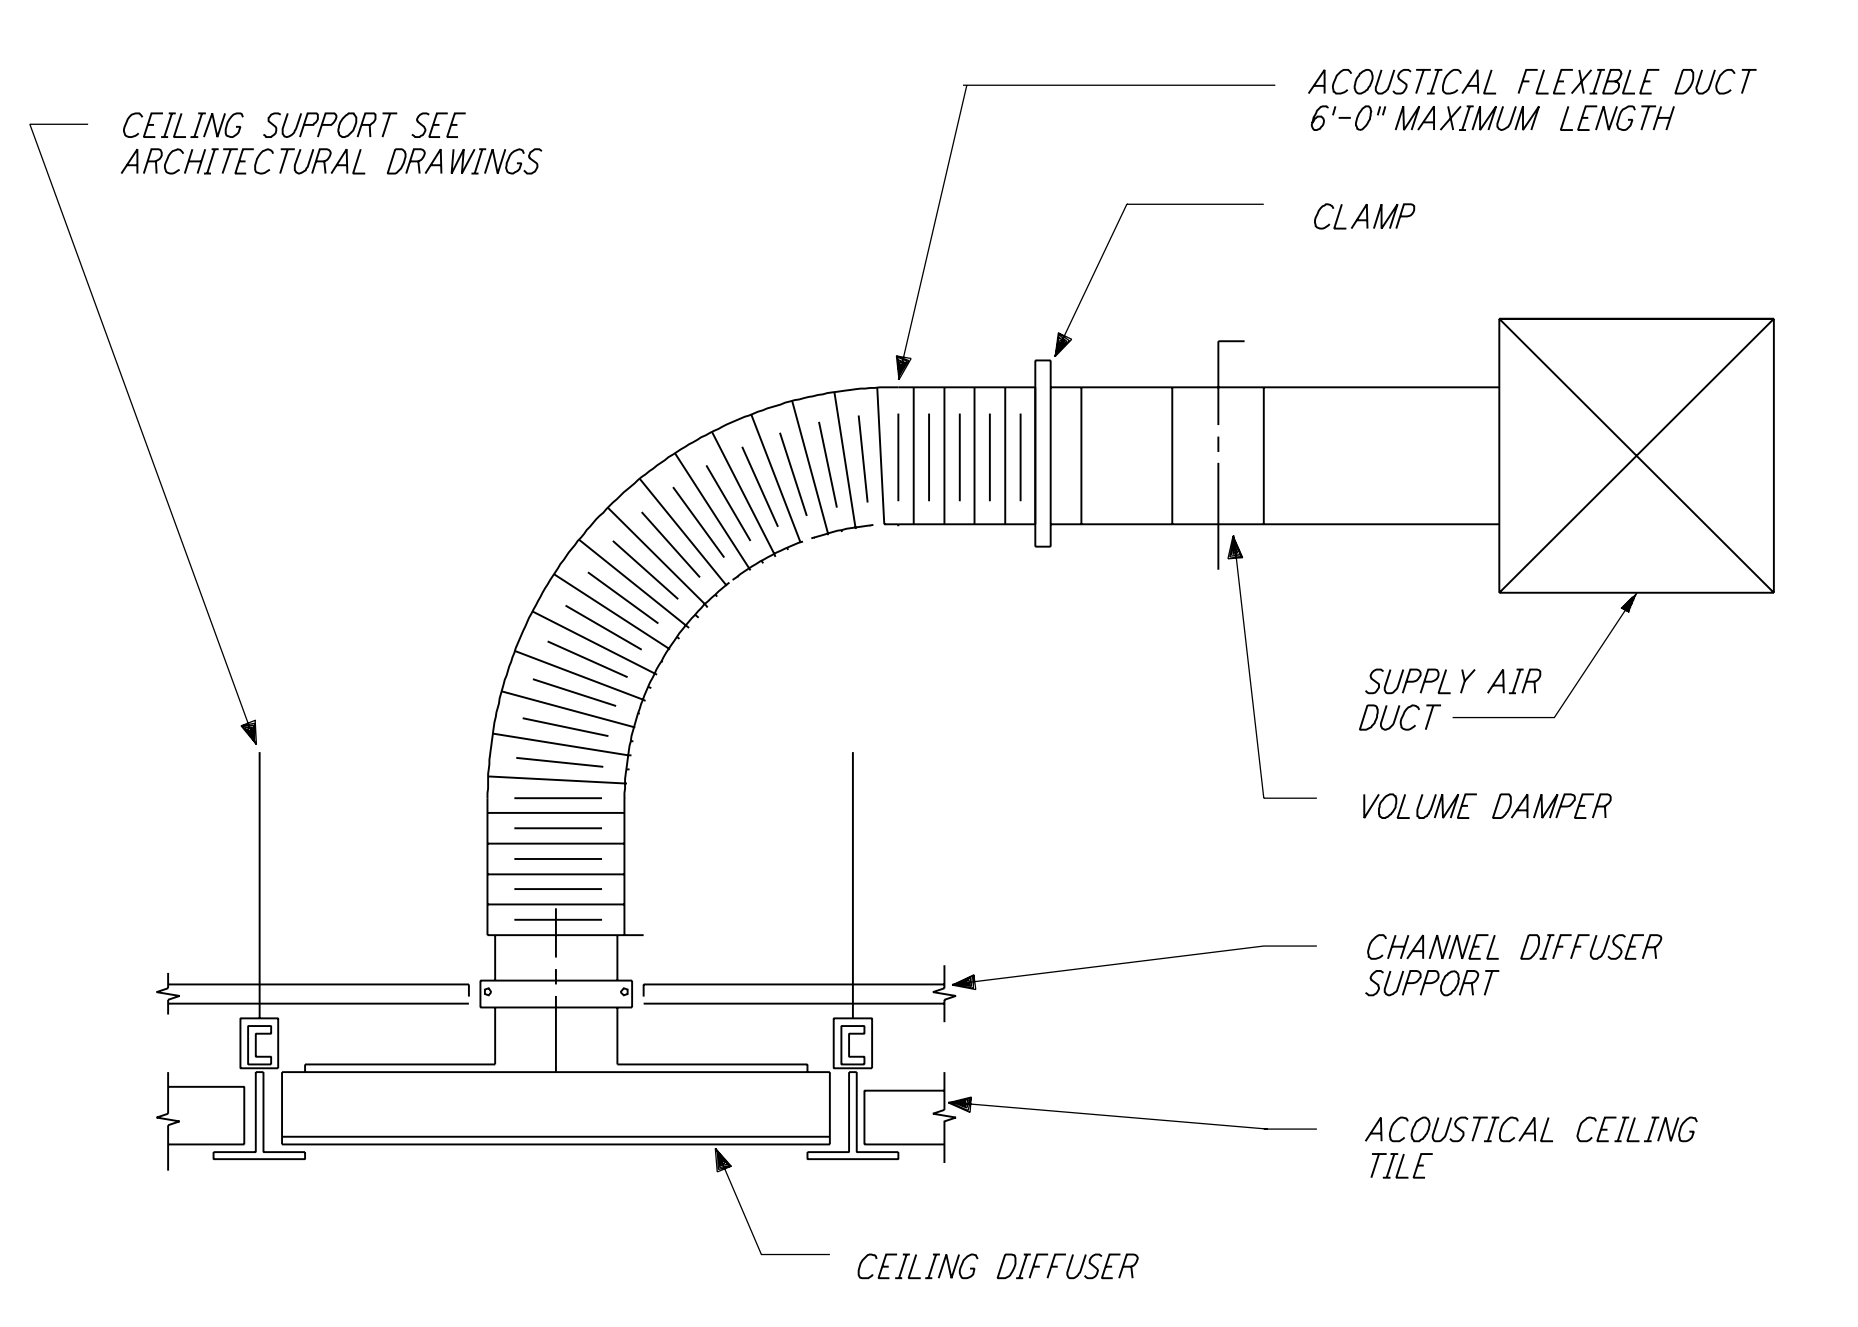


FLEXIBLE DUCT CONNECTION (4) REF
 NTS LA-H-411

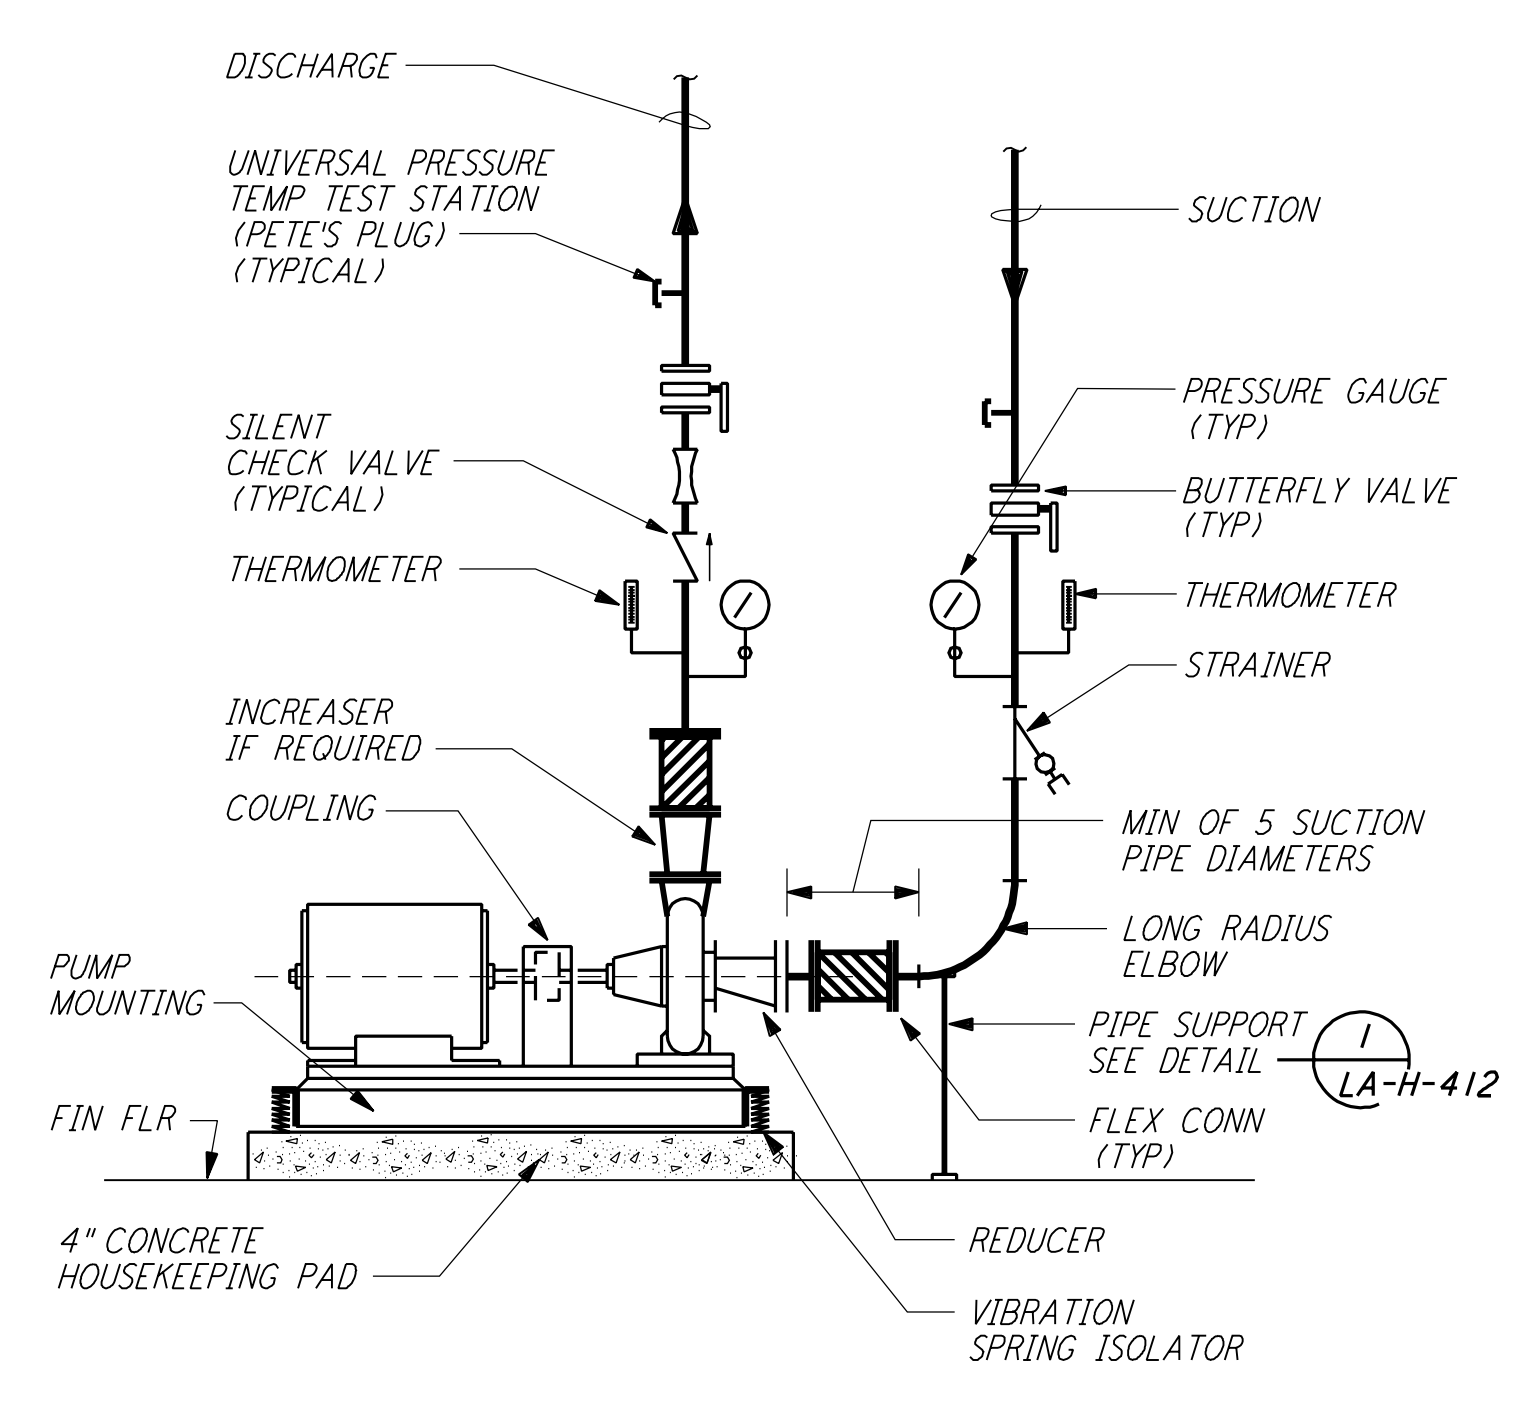


PUMP CONNECTION DETAIL (5) REF
 NTS LA-H-411

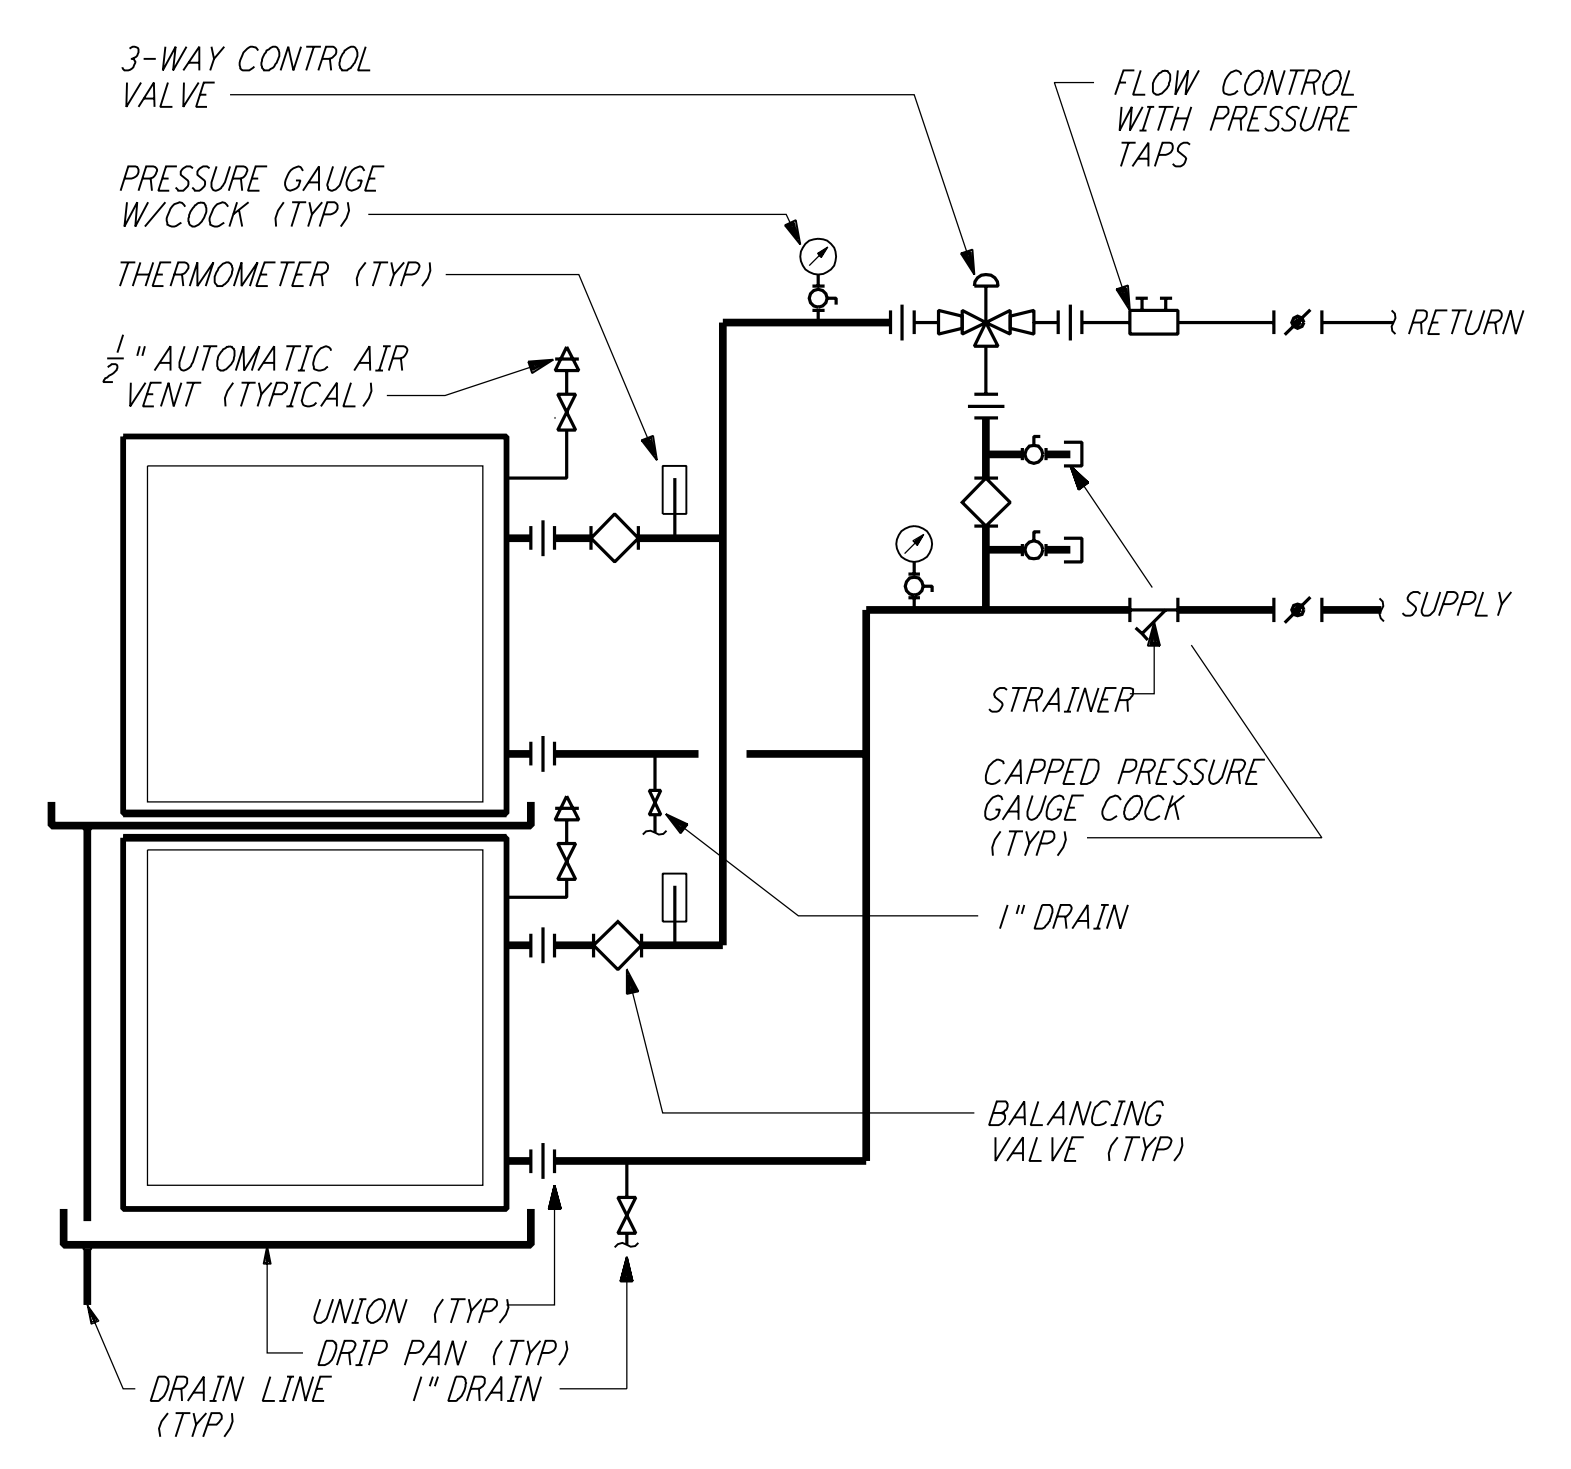


MULTIPLE COIL PIPING DETAIL (6) REF
 NTS LA-H-411

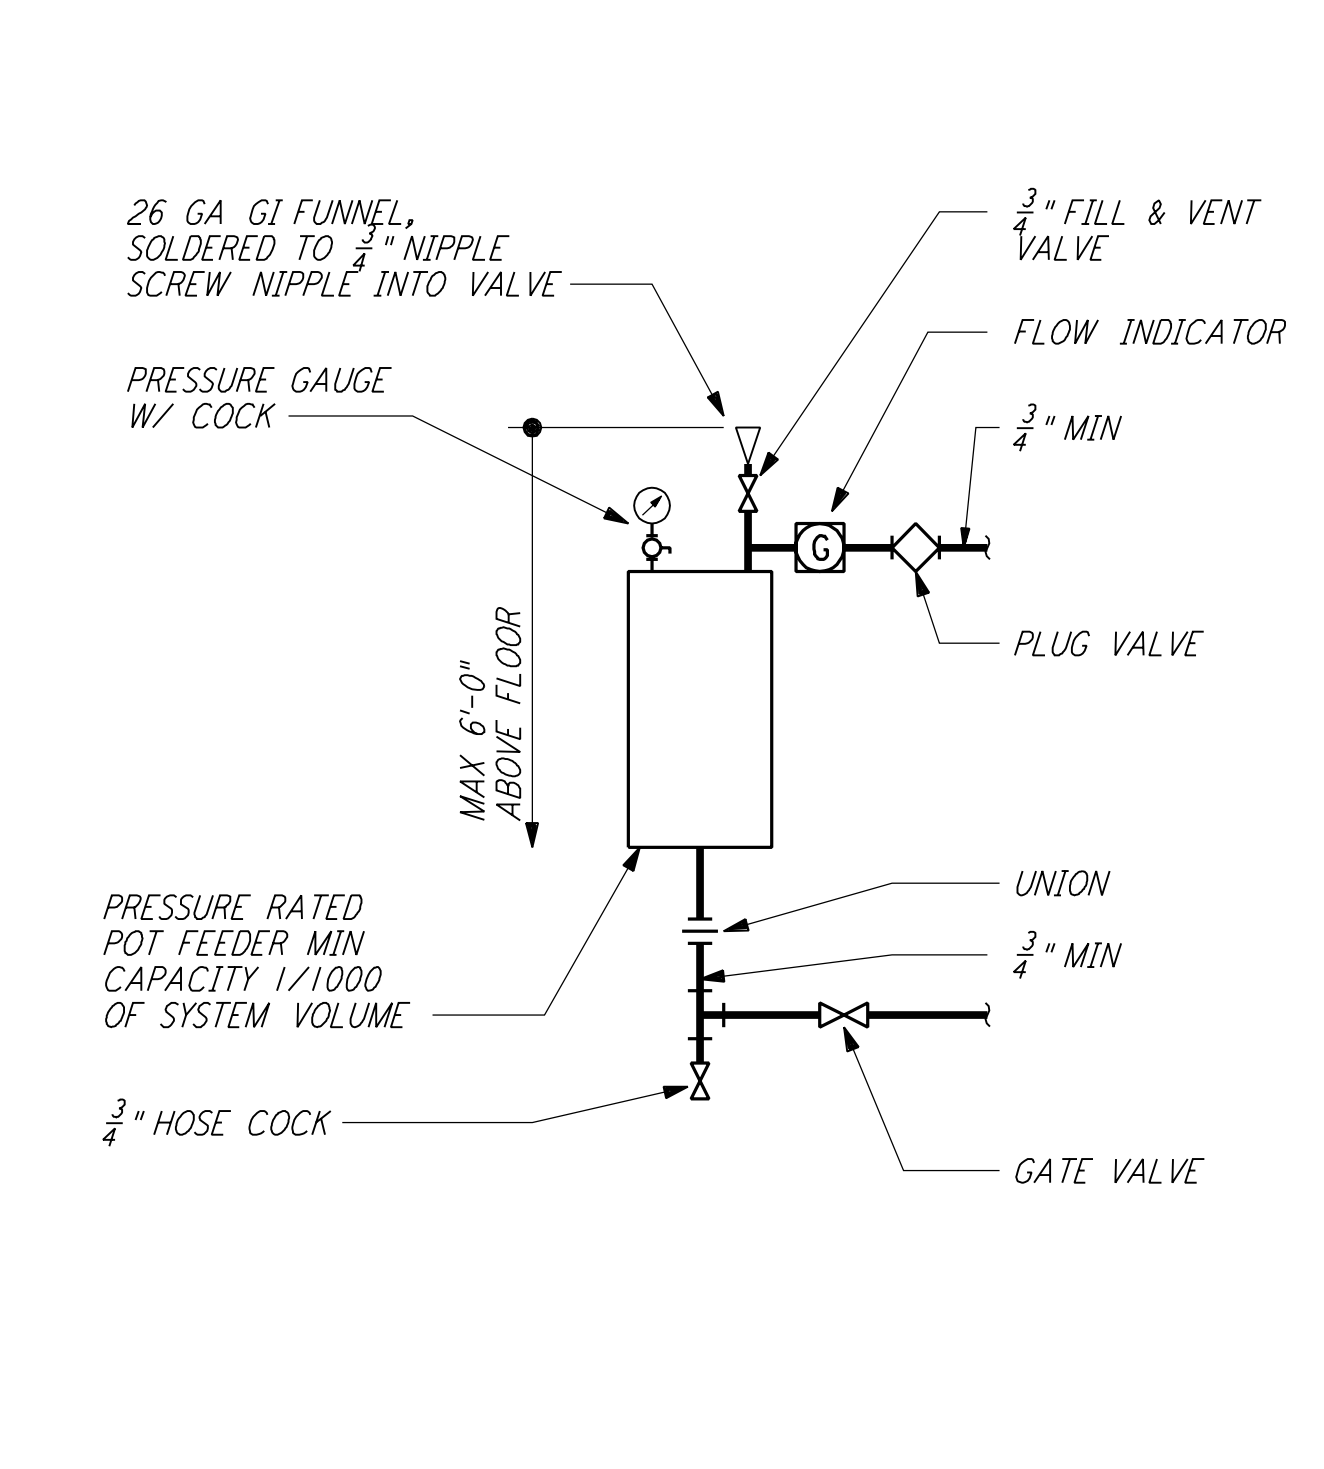


CHEMICAL FEEDER DETAIL (7) REF
 NTS LA-H-411

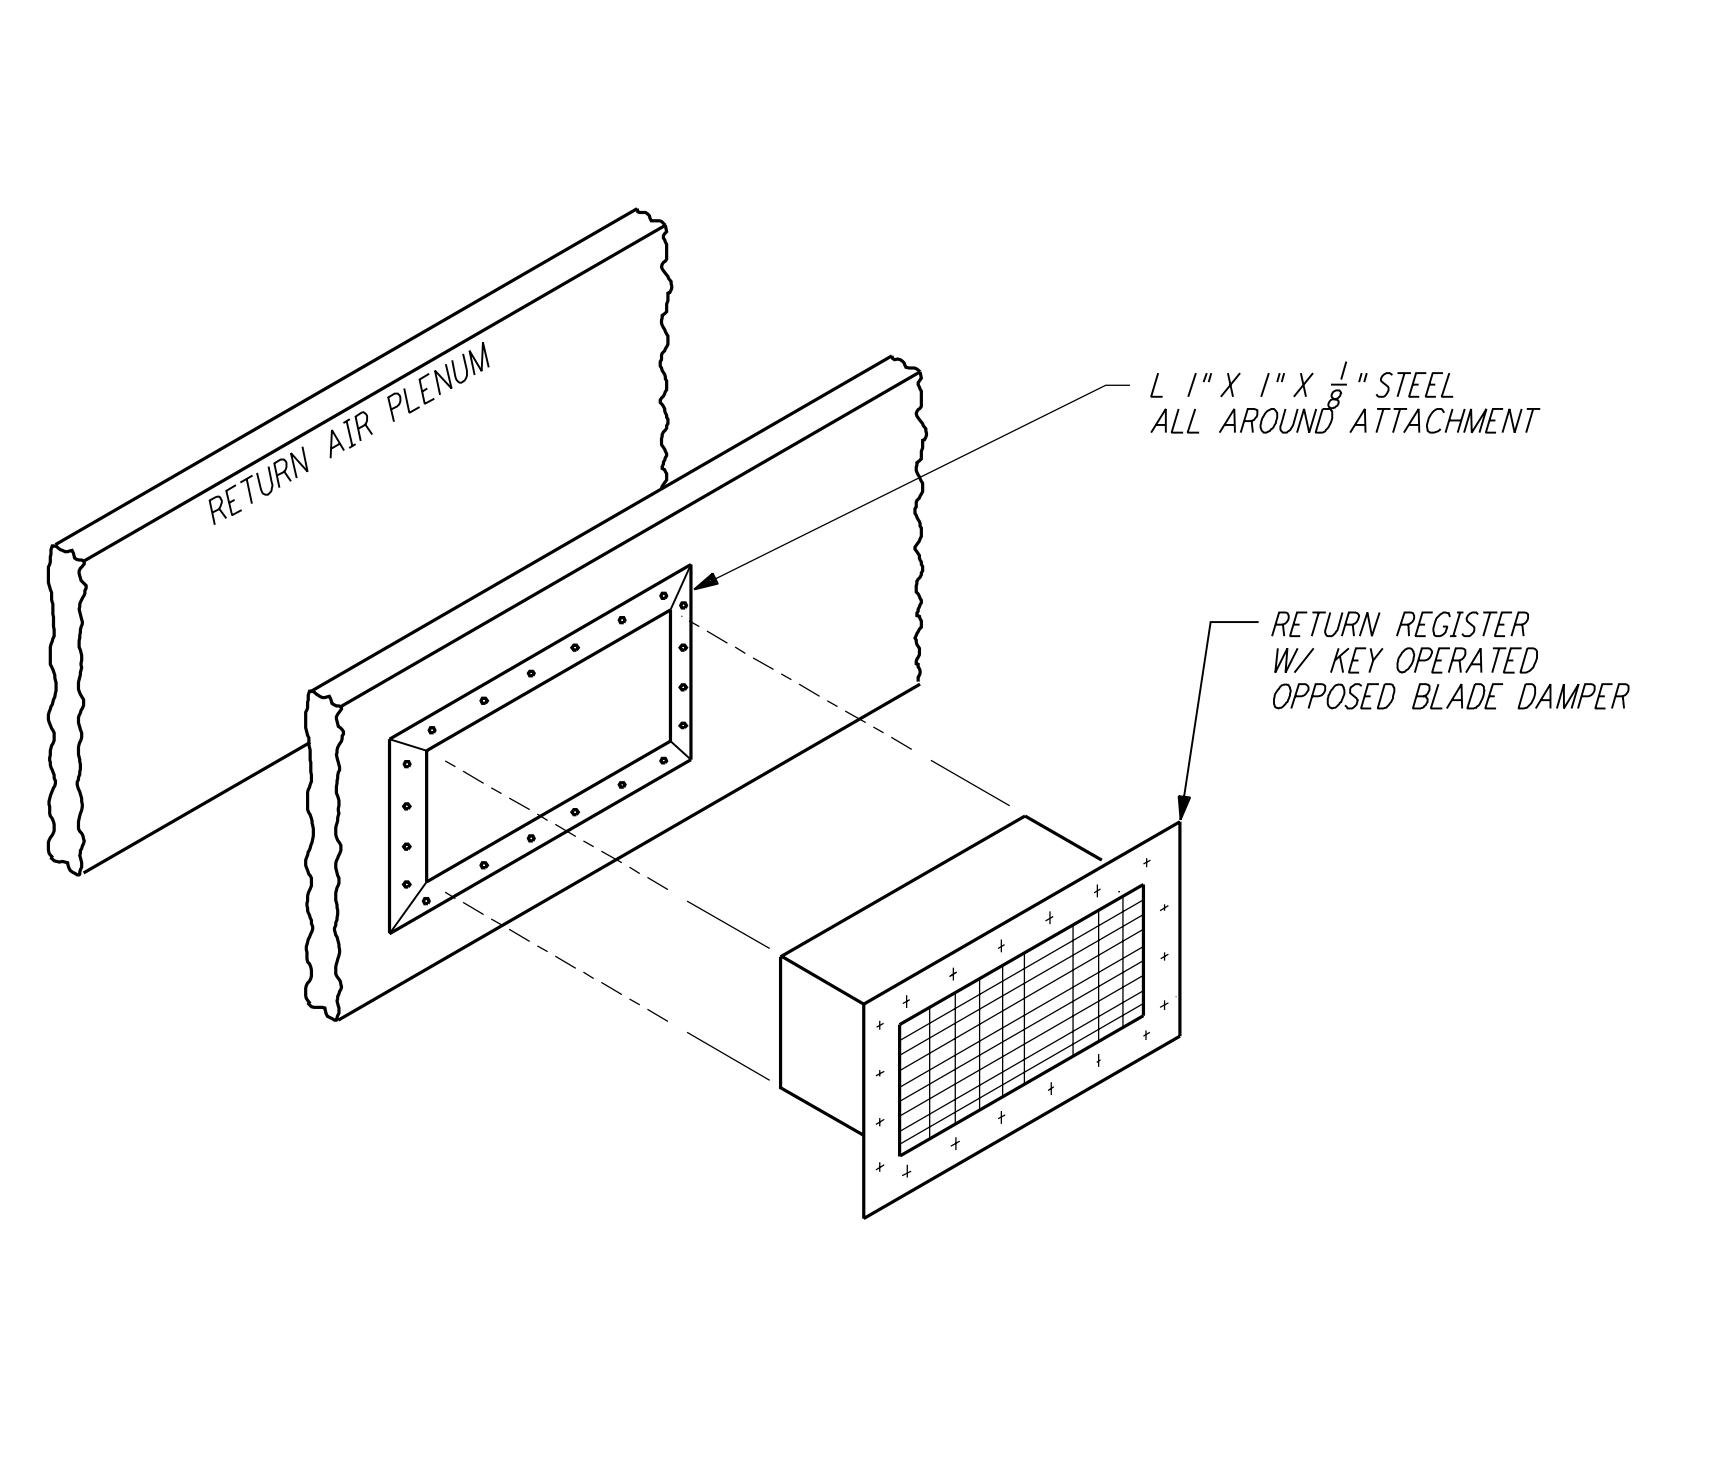


REGISTER MOUNTING DETAIL (8) REF
 NTS LA-H-411

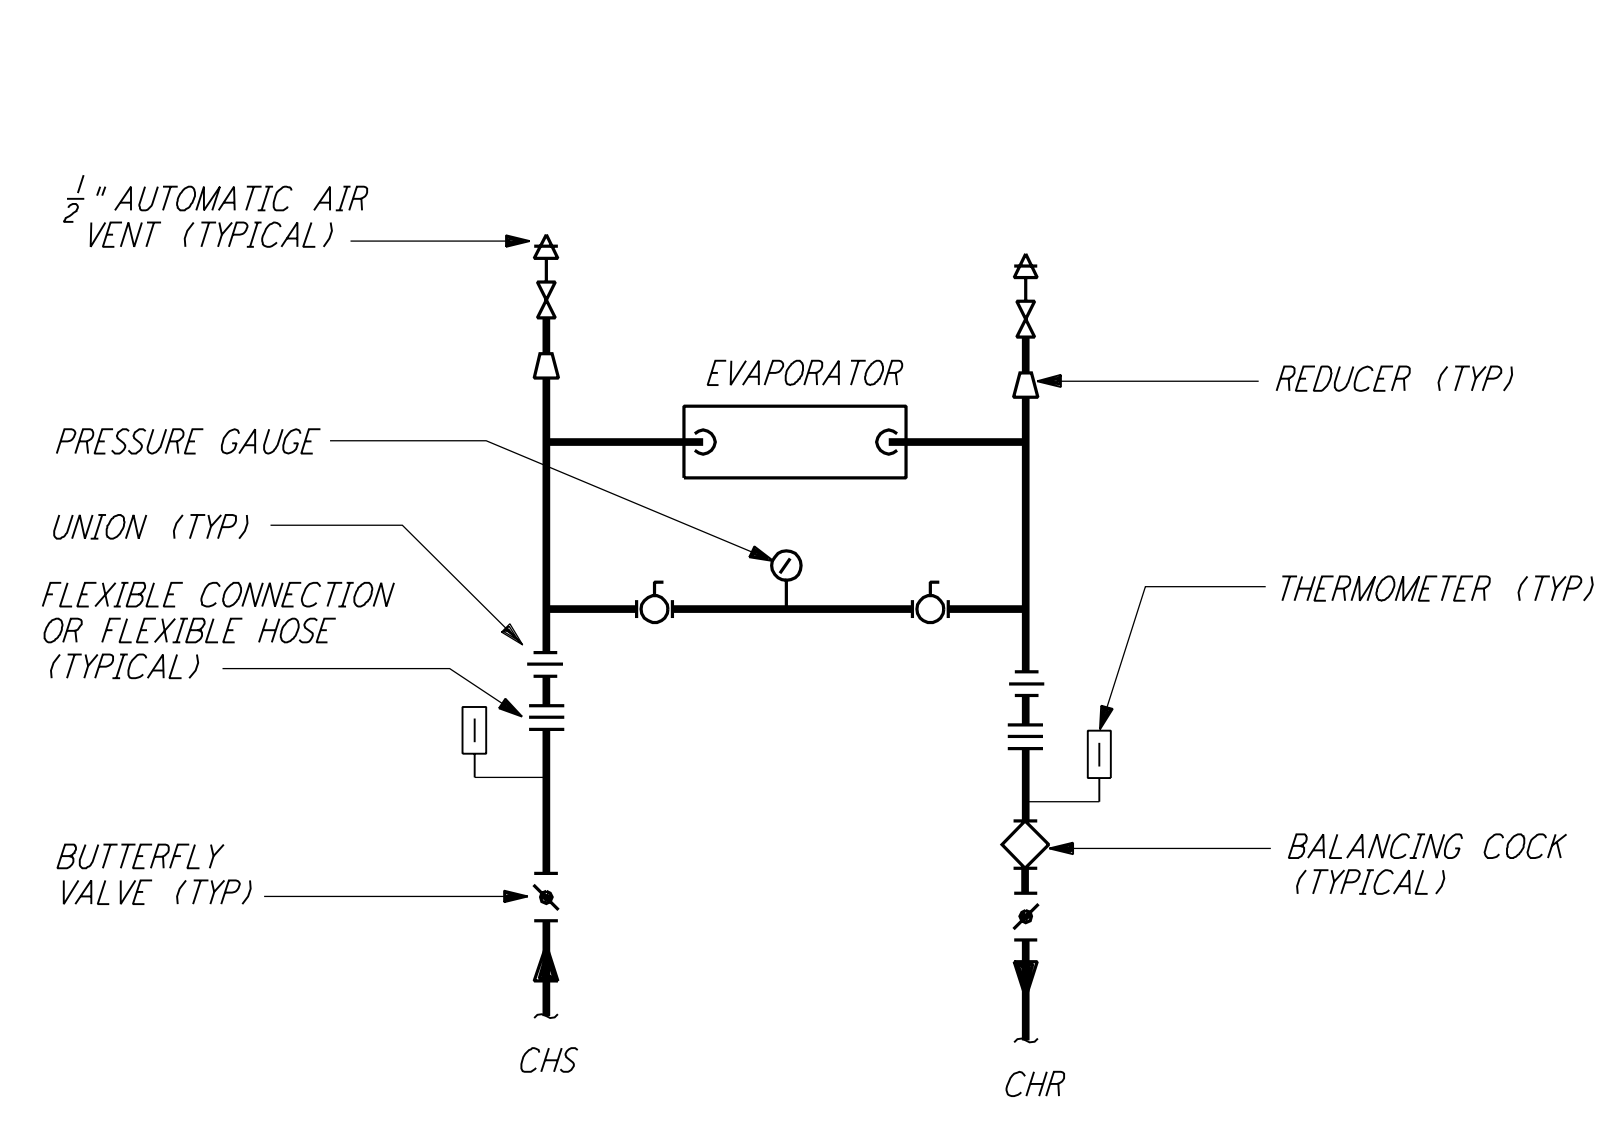

WATER CHILLER CONNECTION (9) REF
 NTS LA-H-411

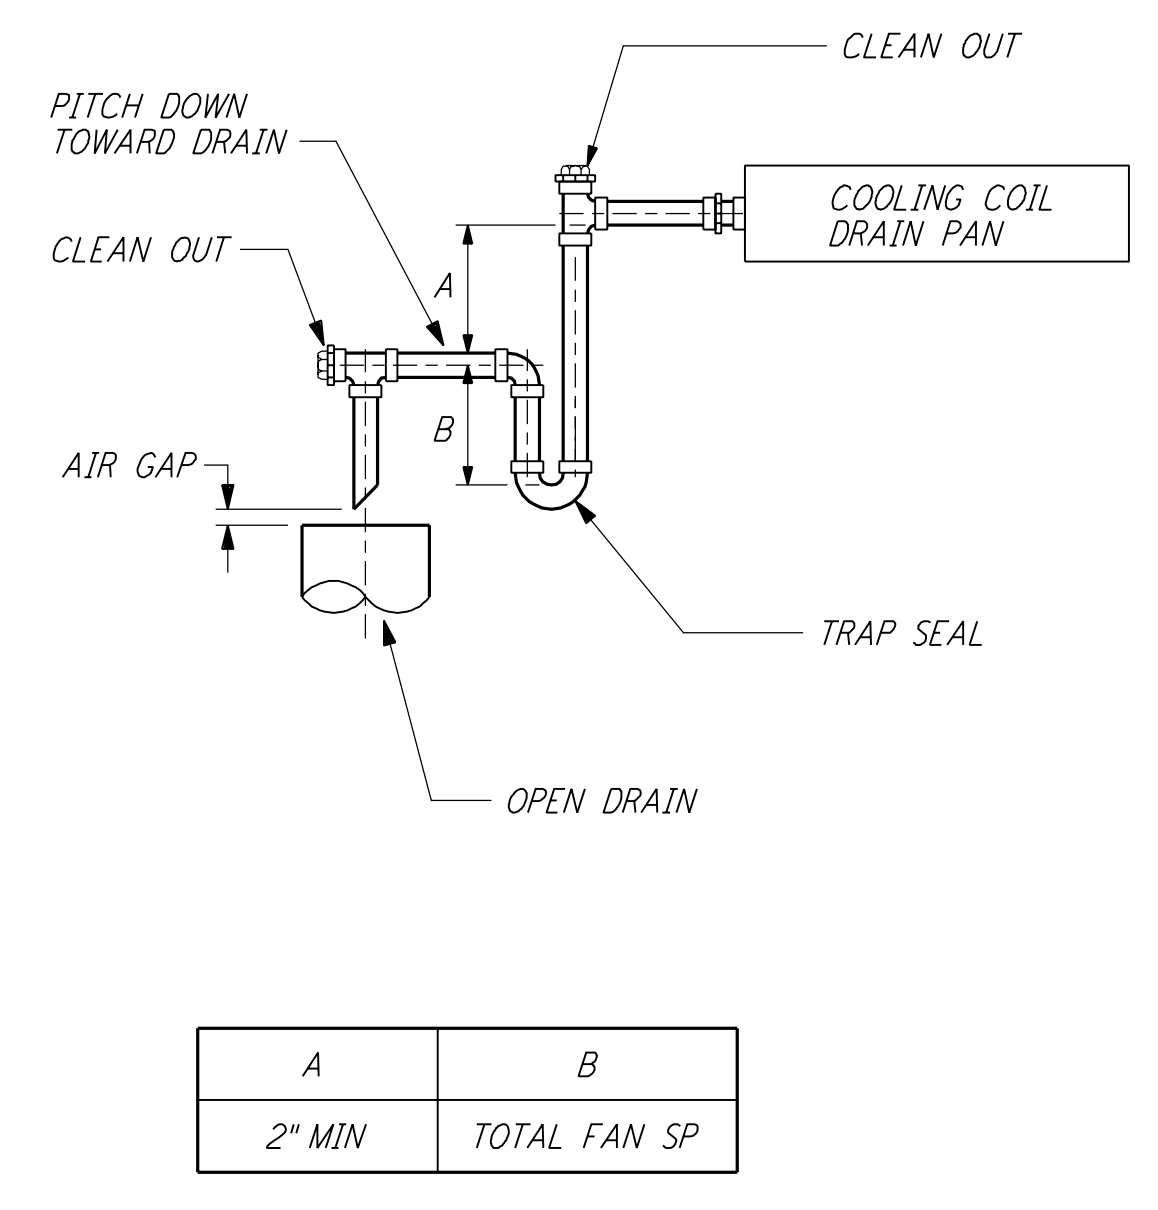

CONDENSATE DRAIN DETAIL (10) REF
 NTS LA-H-411

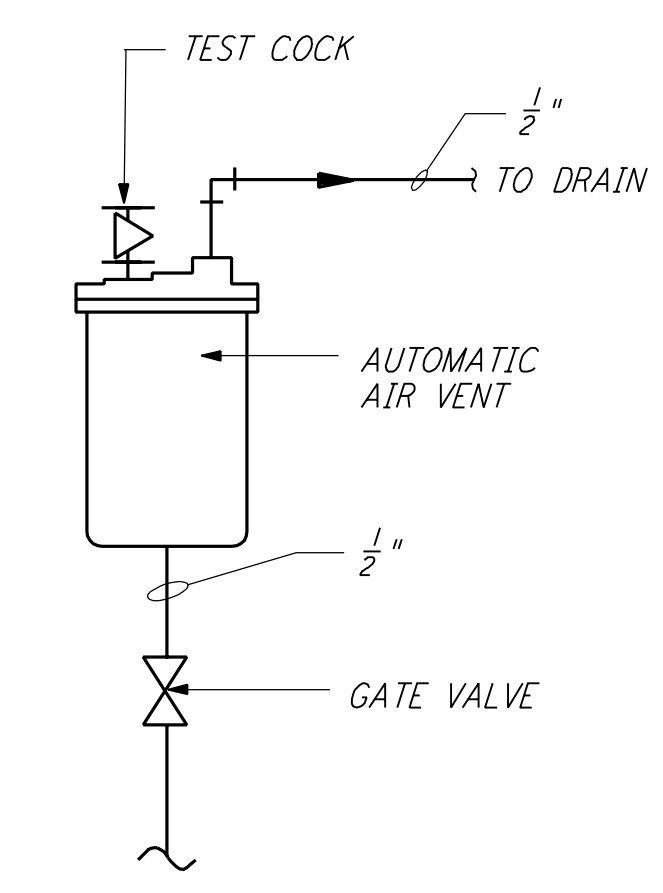

AUTOMATIC AIR VENT (11) REF
 NTS LA-H-411

NOTES:
 1. FOR LEGEND, ABBREVIATIONS AND GENERAL NOTES SEE SHEETS LA-H-001 AND LA-H-002.

LIGO-D960992-01-0

NO.	DATE	BY	CHKD	ENGR	PROJ	DESCRIPTION
1	8-7-98	DJB				ISSUED FOR AS-BUILT

ISSUED FOR CONSTRUCTION
 DRAWN: CLP 11-15-96
 CHECKED: MN 10-25-96
 ENGINEER: AA 1-23-96
 PROJ: TDM 11-15-96

AS-BUILT DRAWINGS

PARSONS
 100 WEST WALNUT STREET
 PASADENA, CALIFORNIA

LIGO
 CALIFORNIA INSTITUTE OF TECHNOLOGY
 MASSACHUSETTS INSTITUTE OF TECHNOLOGY

LASER INTERFEROMETER GRAVITATIONAL-WAVE OBSERVATORY SITE NO. 2 - LIVINGSTON, LOUISIANA		
TITLE	SCALE	CONTRACT NUMBER
HVAC DETAILS SHEET 1	NONE	PP150969
		PROJECT NUMBER 8094
		SHEET NUMBER LA-H-411
		REVISIONS

This document and the design it covers are the property of PARSONS. They are loaned only with the borrower's expressed written agreement that they will not be reproduced, copied, loaned, exhibited, or used in any other way, except by written consent from PARSONS to the borrower.

Wed Oct 7 14:19:34 1998 c:\p1\lha411.dtz

Note 1, LIGO, 04/07/99 08:02:20 PM
LIGO-D960992-01-O