
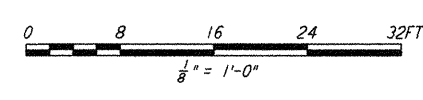


- NOTES:**
1. FOR PLAN SYMBOLS SEE DWG LA-E-002.
 2. WIRING FOR FIRE DETECTION SHALL BE CLASS "A", FOR FIRE ALARM DEVICES SHALL BE CLASS "B". WIRING INSTALLED IN CONCEALED CONDUIT FOR FIRE DETECTION AND SECURITY SYSTEMS SHALL BE DONE BY OTHERS.
 3. DUCT MOUNTED SMOKE DETECTORS SHALL BE PROVIDED WITH AN AUXILIARY RELAY CONTACT (N.C.) FOR EQUIPMENT SHUT-DOWN.
 4. COORDINATE AHU LOCATIONS WITH DUCT MOUNTED SMOKE DETECTORS.
 5. TELEPHONE AND DATA RECEPTACLES SHOWN IN MIDDLE OF ROOMS SHALL BE PROVIDED WITH IMBEDDED 3/4" CONDUIT TO NEAREST PERMANENT WALL, WITH RISER TO ABOVE CEILING CAVITY.
 6. DATA AND PHONE LINES SHALL BE HOMERUN FROM WALL AND FLOOR RECEPTACLES TO BACKBOARD IN ROOM 163.
 7. WIRE RUNS IN CEILING CAVITY SHALL BE ORDERLY.

SYMBOL REPRESENTS DUAL TELEPHONE AND DATA (CAT 5) RECEPTACLE (TYP)

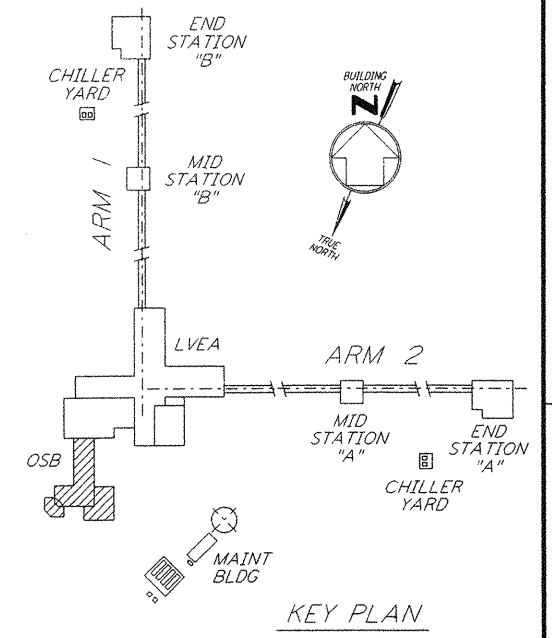

not be reproduced, copied, loaned, exhibited, or used in any other way, except by written consent from PARSONS to the borrower.

This document and the design it covers are the property of PARSONS. They are loaned only with the borrower's expressed written agreement that they will

NO.	DATE	BY	CHKD	ENGR	PROJ	DESCRIPTION
2	8-7-98	JE	RJK	MM	MM	ISSUED FOR AS-BUILT
1	2-28-97	J.G.	RDC	KCR	T. D. M.	GENERAL REVISIONS

ISSUED FOR CONSTRUCTION	DRAWN	M. M.	11-15-96
CHECKED	J. C. L.	7-24-96	
ENGINEER	K. C. R.	10-25-96	
PROJ	T. D. M.	11-15-96	

AS-BUILT DRAWINGS

PARSONS
 100 WEST WALNUT STREET
 PASADENA, CALIFORNIA

LIGO
 CALIFORNIA INSTITUTE OF TECHNOLOGY
 MASSACHUSETTS INSTITUTE OF TECHNOLOGY

LASER INTERFEROMETER GRAVITATIONAL-WAVE OBSERVATORY SITE NO. 2 - LIVINGSTON, LOUISIANA		
TITLE	SCALE	CONTRACT NUMBER
ELECTRICAL CORNER STATION OSB OFFICE AREA FIRE DET & SECURITY PLAN	NONE	PP150969
	SHEET NUMBER	PROJECT NUMBER
	LA-E-110	8094
	REVISIONS	