

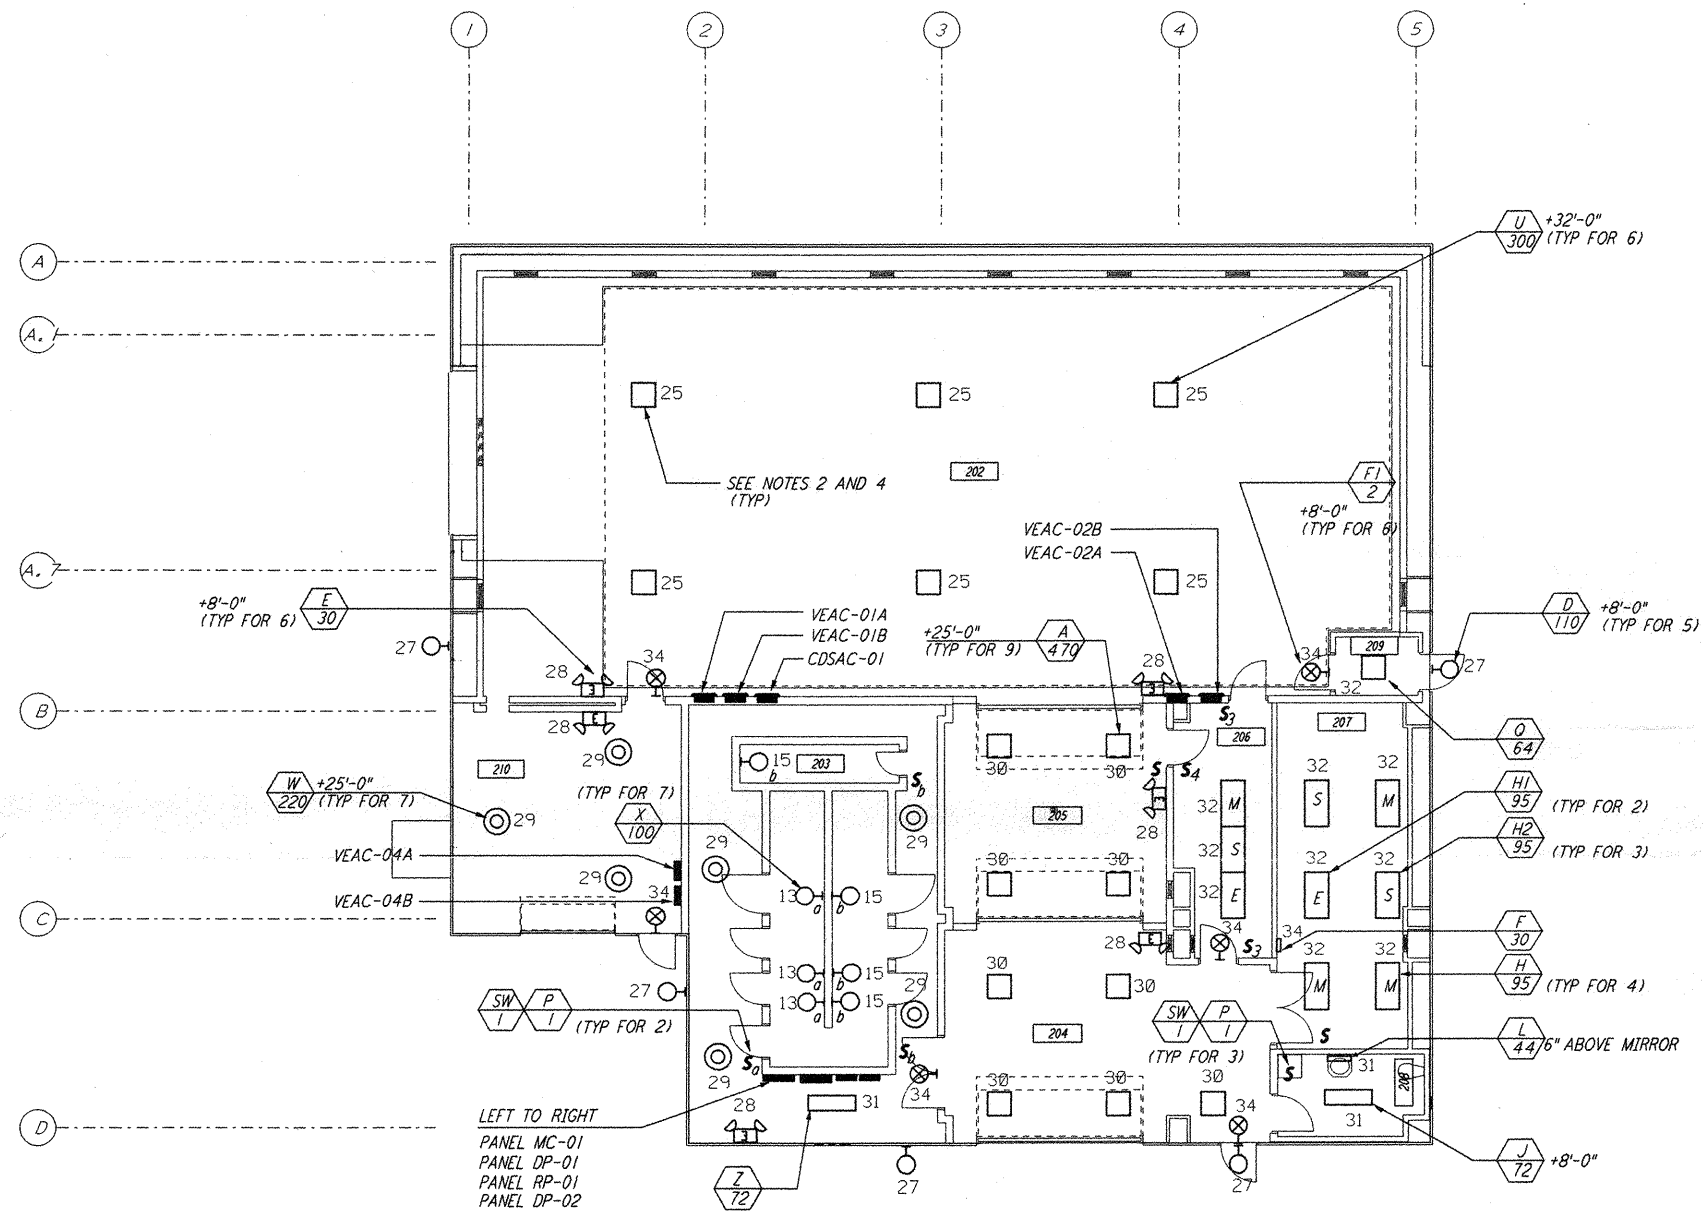


**NOTES:**


1. FOR GENERAL NOTES SEE DRAWINGS LA-E-102.
2. ALL CIRCUITS SHOWN ON THIS DRAWING ARE FROM PANEL DP-02 UNLESS OTHERWISE NOTED.
3. FOR PANEL SCHEDULES SEE DRAWING LA-E-205 AND LA-E-206.
4. FOR FIXTURE LOCATION SEE ARCHITECTURAL REFLECTED CEILING PLAN ON DRAWING LA-A-221.
5. FOR FIRE DETECTION NOTES SEE DRAWING LA-E-110.
6. ALL LIGHTING CIRCUITS SHALL HAVE HOME RUN TO PANEL DP-02 EXCEPT CIRCUITS #13 & #15 SHALL HOME RUN TO PANEL RP-01.

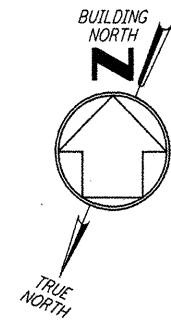


**LIGHTING PLAN**  
SEE NOTE 6

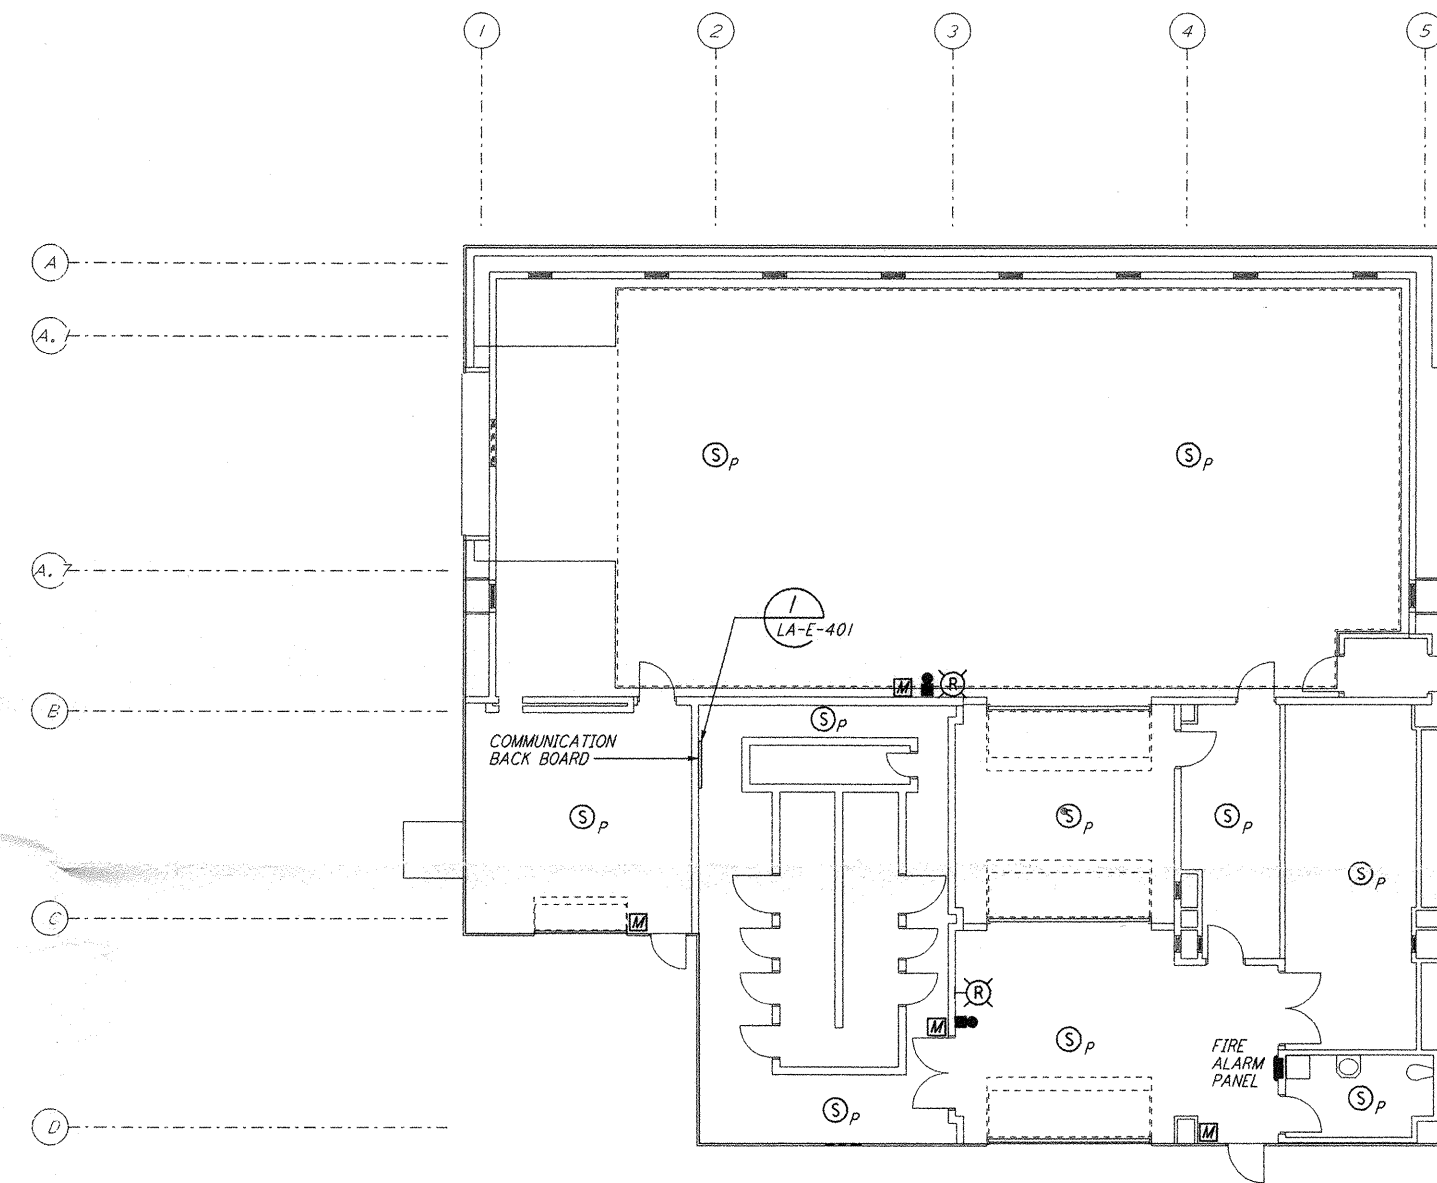

**COMMUNICATIONS AND FIRE DETECTION PLAN**

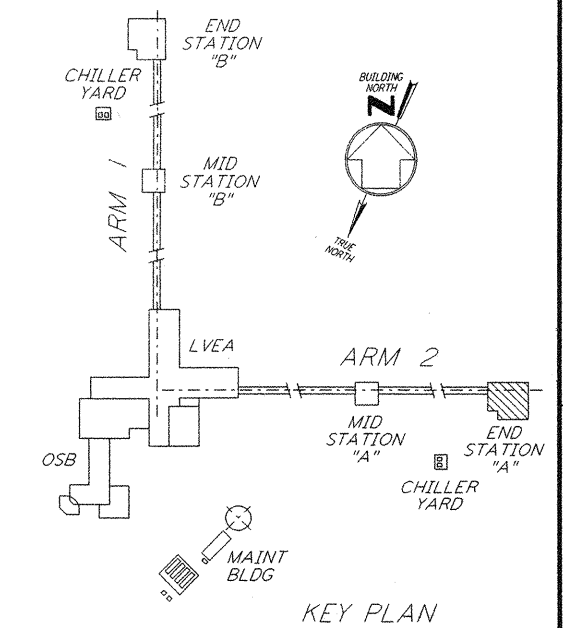

**KEY PLAN**  
**LIGO-D961025-02-0**

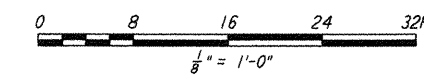

This document and the design it covers are the property of PARSONS. They are loaned only with the borrower's expressed written agreement that they will not be reproduced, copied, loaned, exhibited, or used in any other way, except by written consent from PARSONS to the borrower.

NO.	DATE	BY	CHKD	ENGR	PROJ	DESCRIPTION
2	8-7-98	JF	D.K.	MS		ISSUED FOR AS-BUILT
1	2-28-97	J. G.	RDC	KCR	T. D. M.	GENERAL REVISIONS

ISSUED FOR CONSTRUCTION  
 DRAWN M. M. 11-15-96  
 CHECKED J. C. L. 7-24-96  
 ENGINEER K. C. R. 10-25-96  
 PROJ T. D. M. 11-15-96

**AS-BUILT DRAWINGS**

**PARSONS**  
 100 WEST WALNUT STREET  
 PASADENA, CALIFORNIA

**LIGO**  
 CALIFORNIA INSTITUTE OF TECHNOLOGY  
 MASSACHUSETTS INSTITUTE OF TECHNOLOGY

LASER INTERFEROMETER  
 GRAVITATIONAL-WAVE OBSERVATORY  
 SITE NO. 2 - LIVINGSTON, LOUISIANA

TITLE: **ELECTRICAL END STATION A LIGHTING, COMMUNICATIONS & FIRE DETECTION PLAN**

SCALE: NONE  
 CONTRACT NUMBER: PP150969  
 PROJECT NUMBER: 8094

SHEET NUMBER: **LA-E-201**