
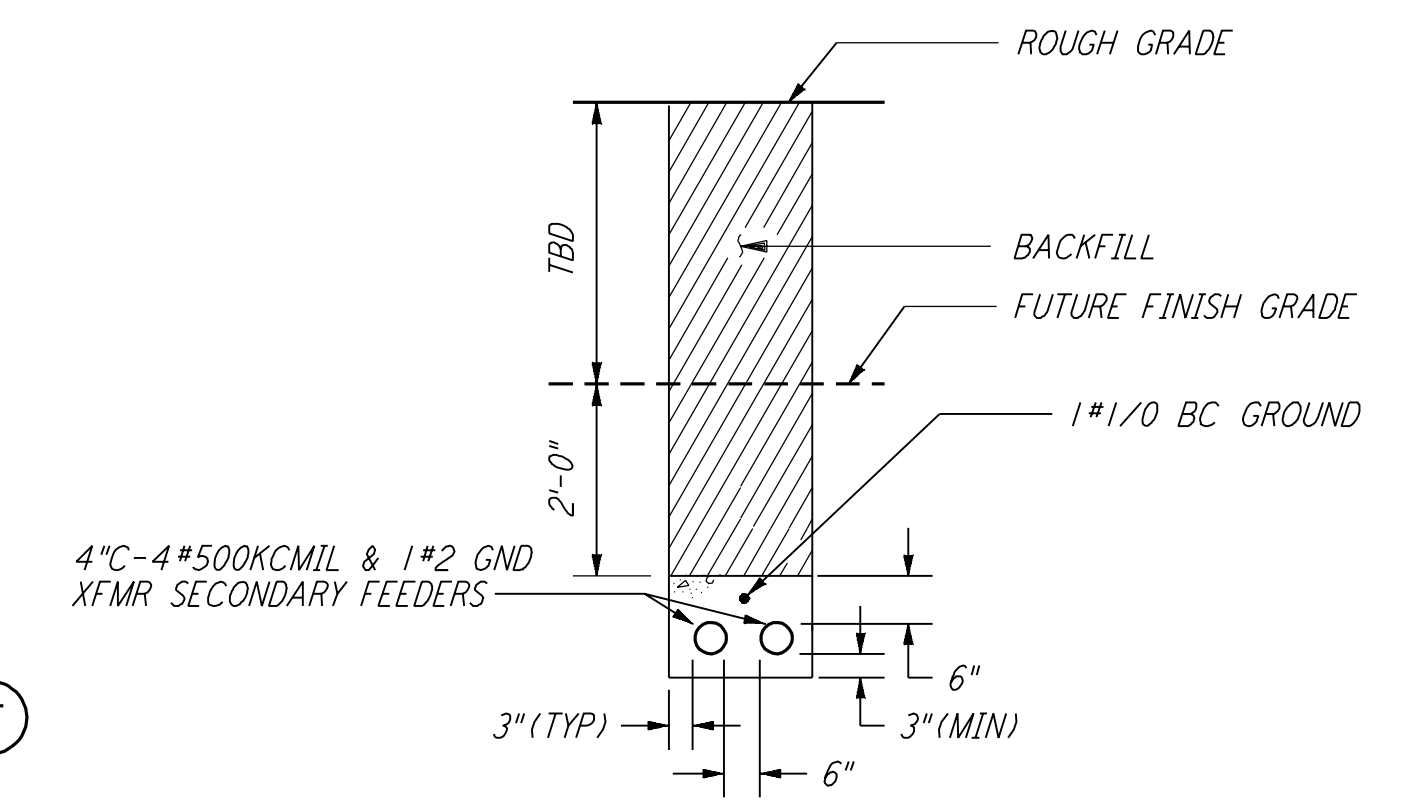
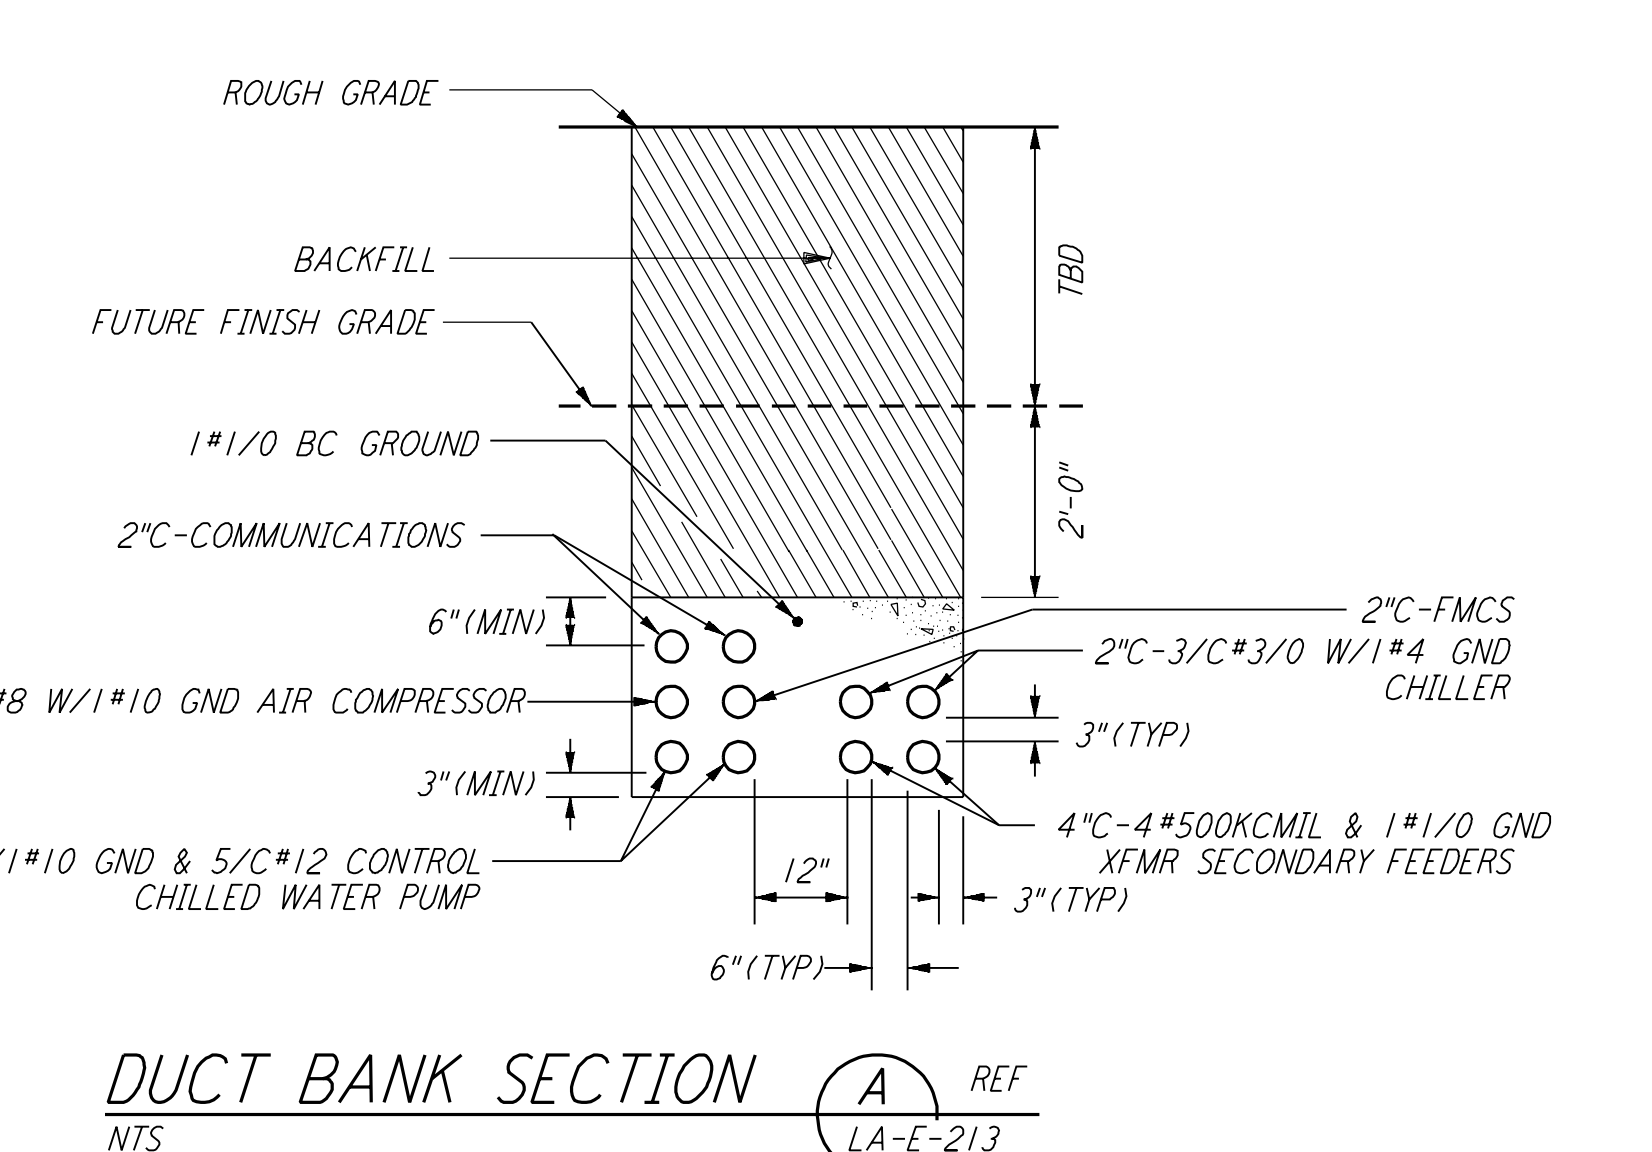
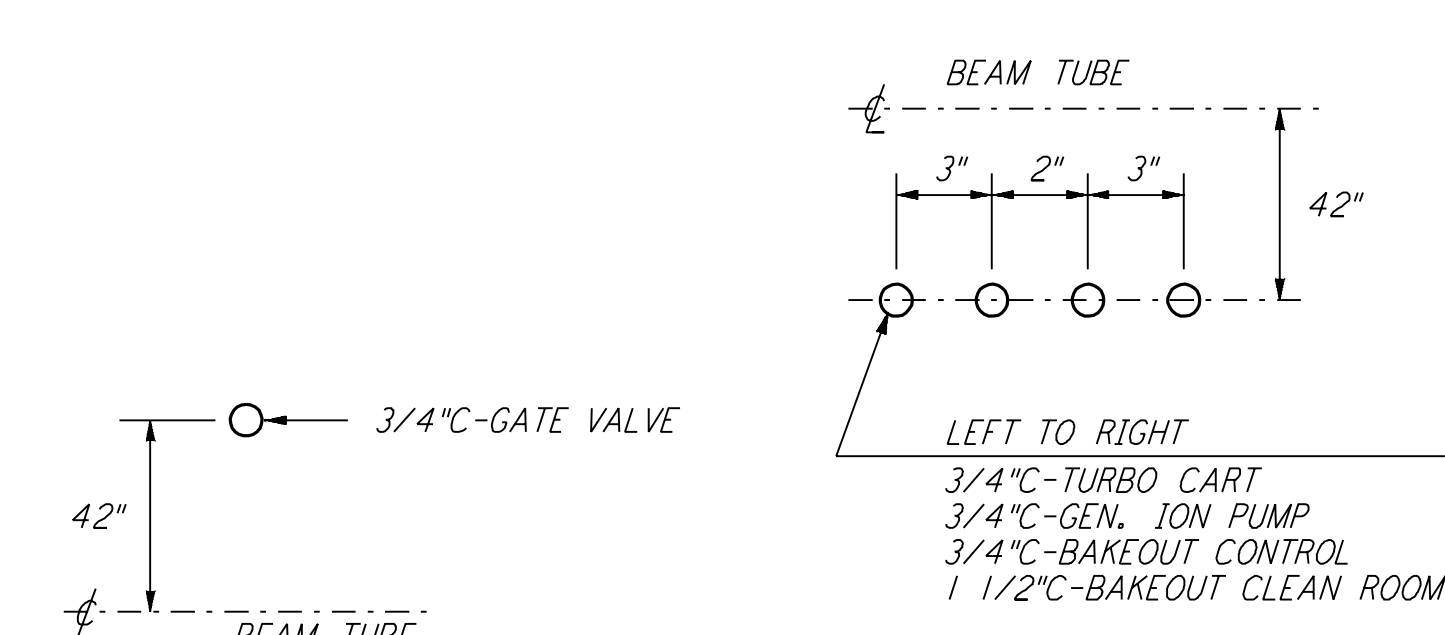












This document and the design it covers are the property of PARSONS. They are loaned only with the borrower's expressed written agreement that they will not be reproduced, copied, loaned, exhibited, or used in any other way, except by written consent from PARSONS to the borrower.

This document and the design it covers are the property of PARSONS. They are loaned only with the borrower's expressed written agreement that they will not be reproduced, copied, loaned, exhibited, or used in any other way, except by written consent from PARSONS to the borrower.

Wed Oct 7 13:51:53 1998 ee\lgo\site2\ee\lae213.d3z

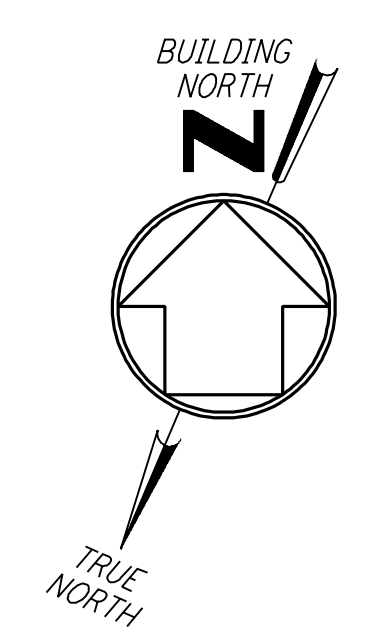

- NOTES:**
- FOR STANDARD SYMBOLS, ABBREVIATIONS AND ACRONYMS SEE DWG. LA-E-001.
  - FOR ELECTRICAL SYMBOLS SEE DWG. LA-E-002.
  - FOR STANDARD INSTALLATION DETAILS SEE DWG. LA-E-405 THRU LA-E-407.
  - FOR CABLE TYPE DESCRIPTION SEE DWG. LA-E-007.
  - ALL DUCTBANK RUNS ARE SHOWN DIAGRAMMATICALLY ONLY. CONTRACTOR SHALL COORDINATE INSTALLATION WITH OTHER DISCIPLINES. TO USE COMMON TRENCH, BACK FILL ETC.
  - ARRANGEMENT OF CDS POWER CONDUIT STUB-UPS SHALL BE COORDINATED WITH THE VACUUM EQUIPMENT VENDOR.

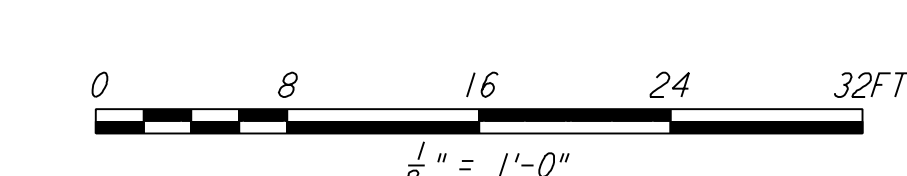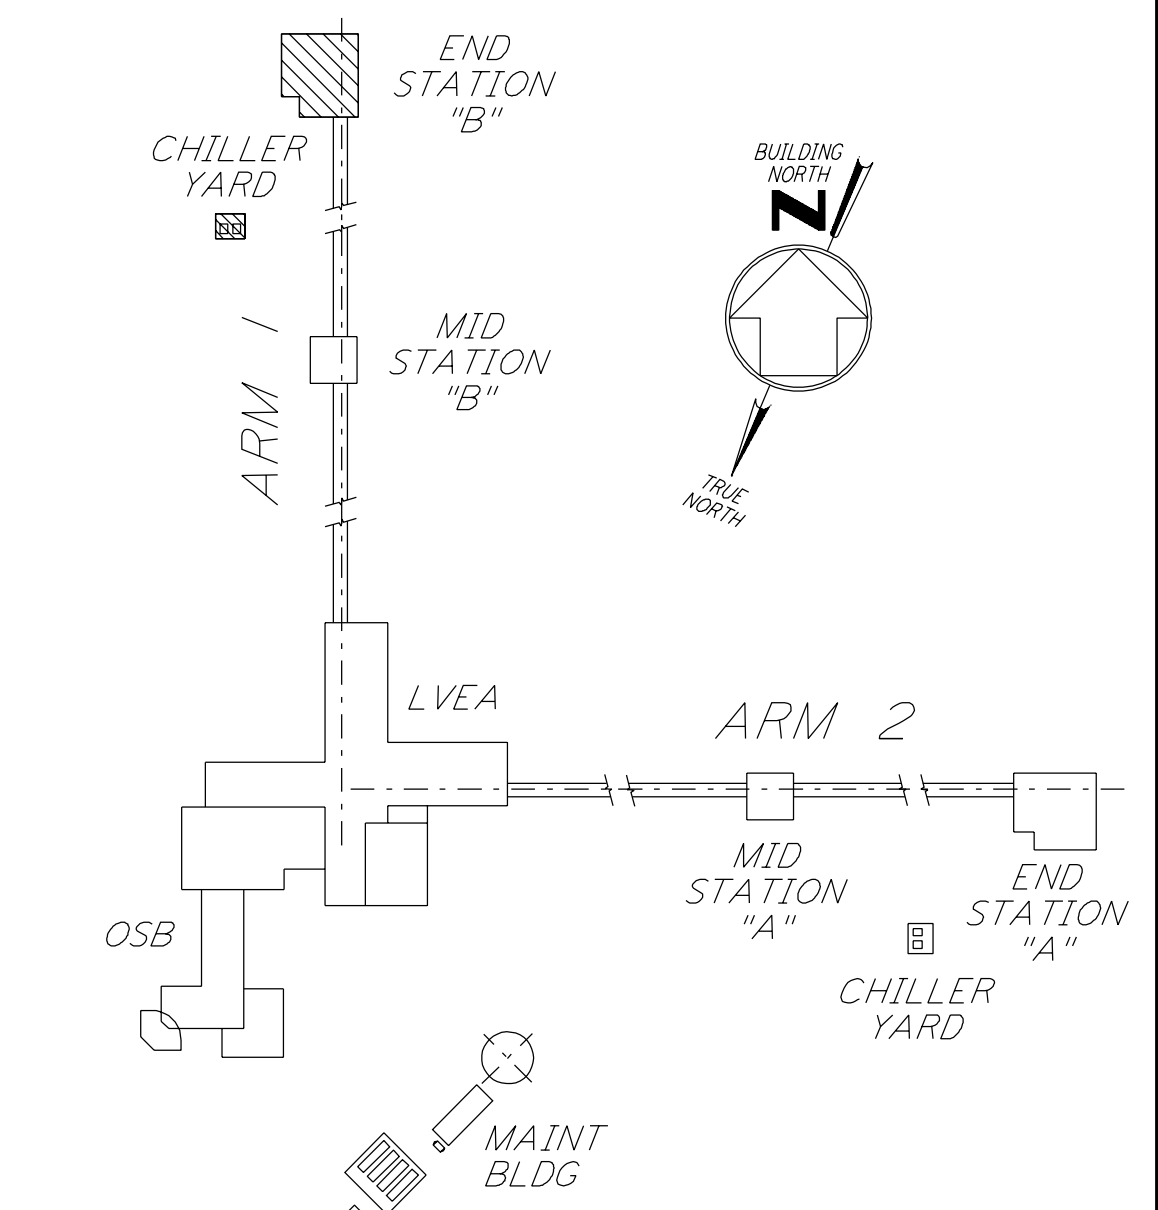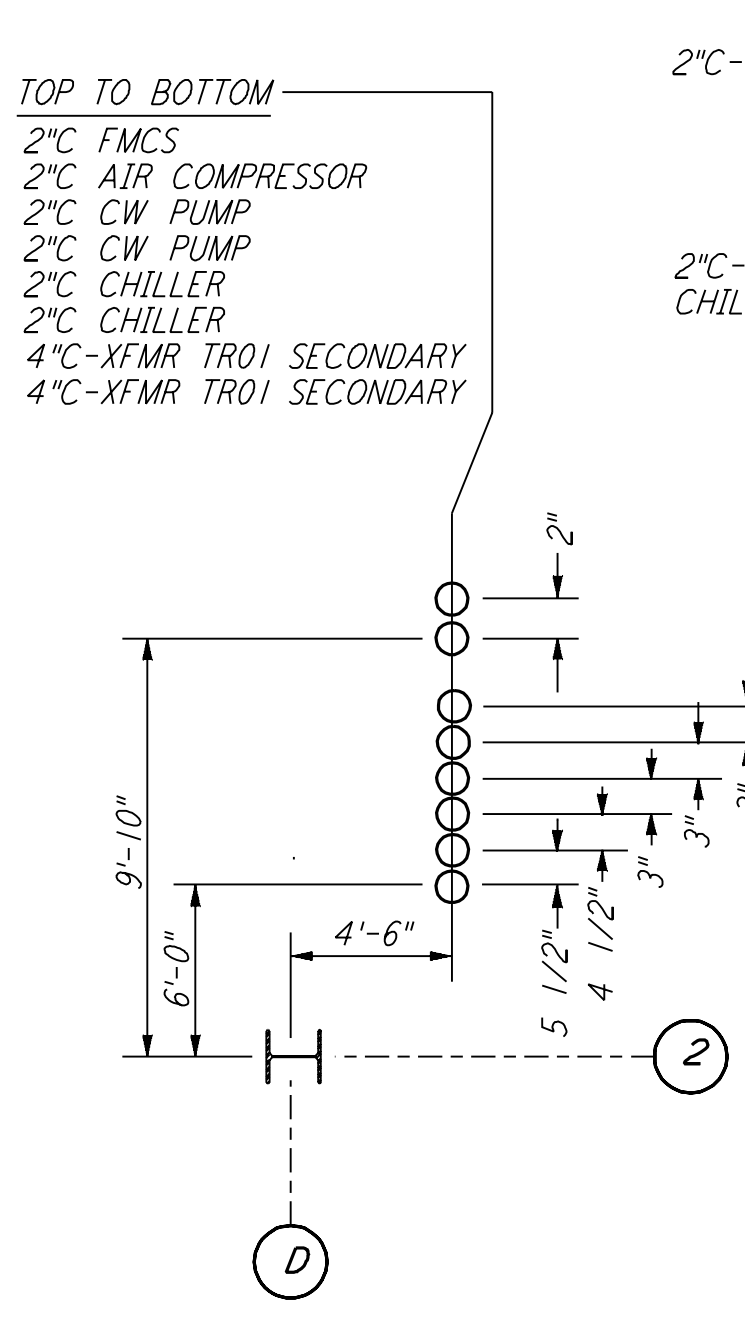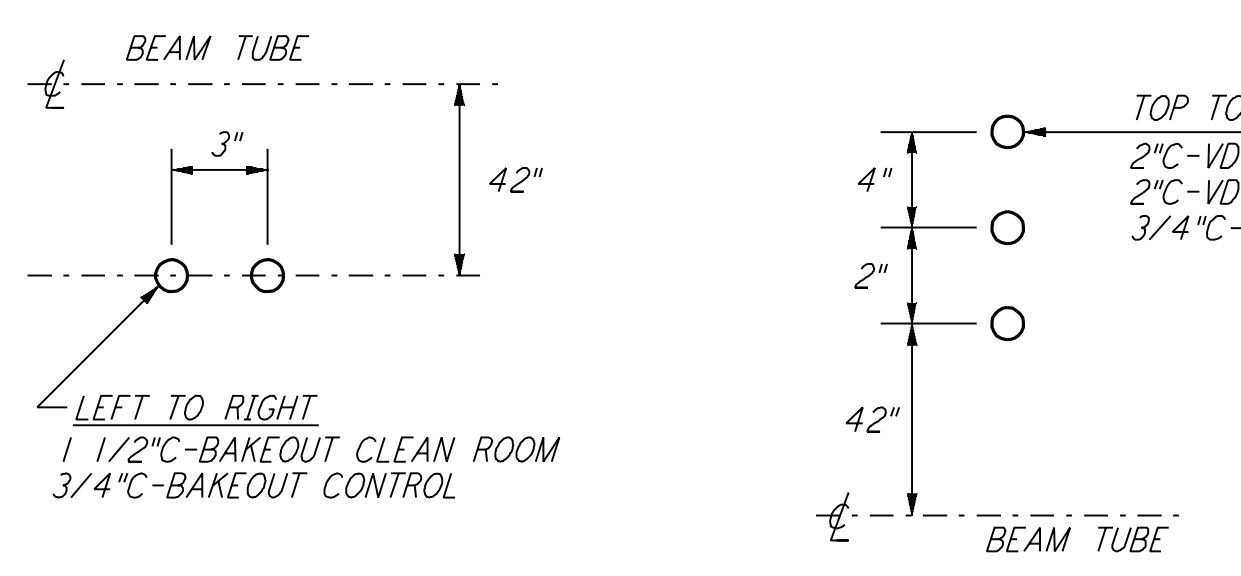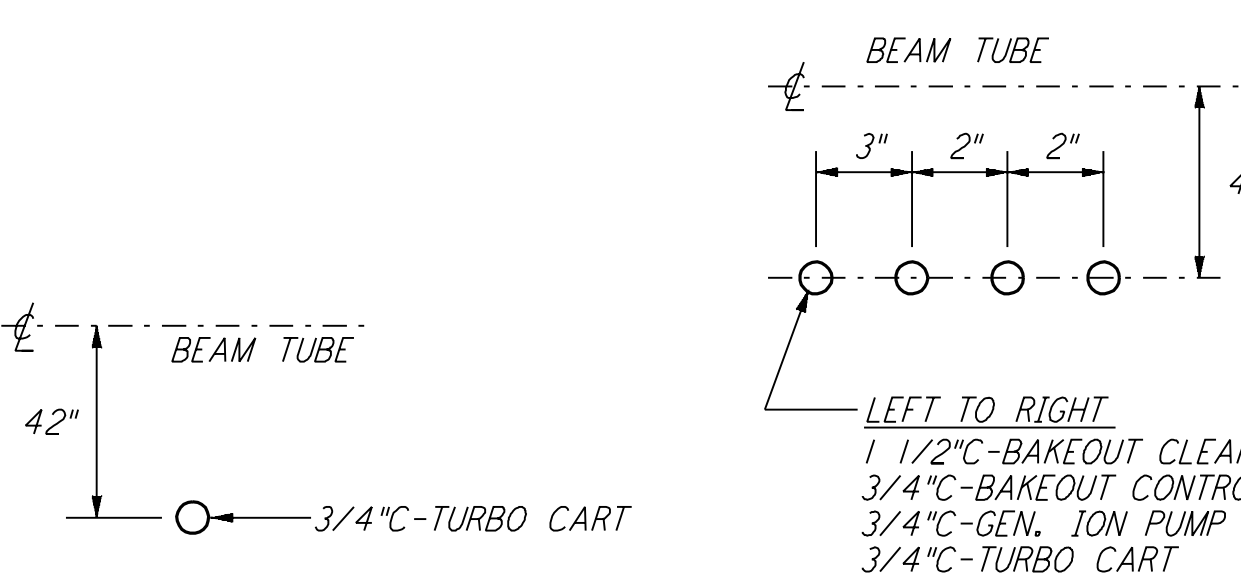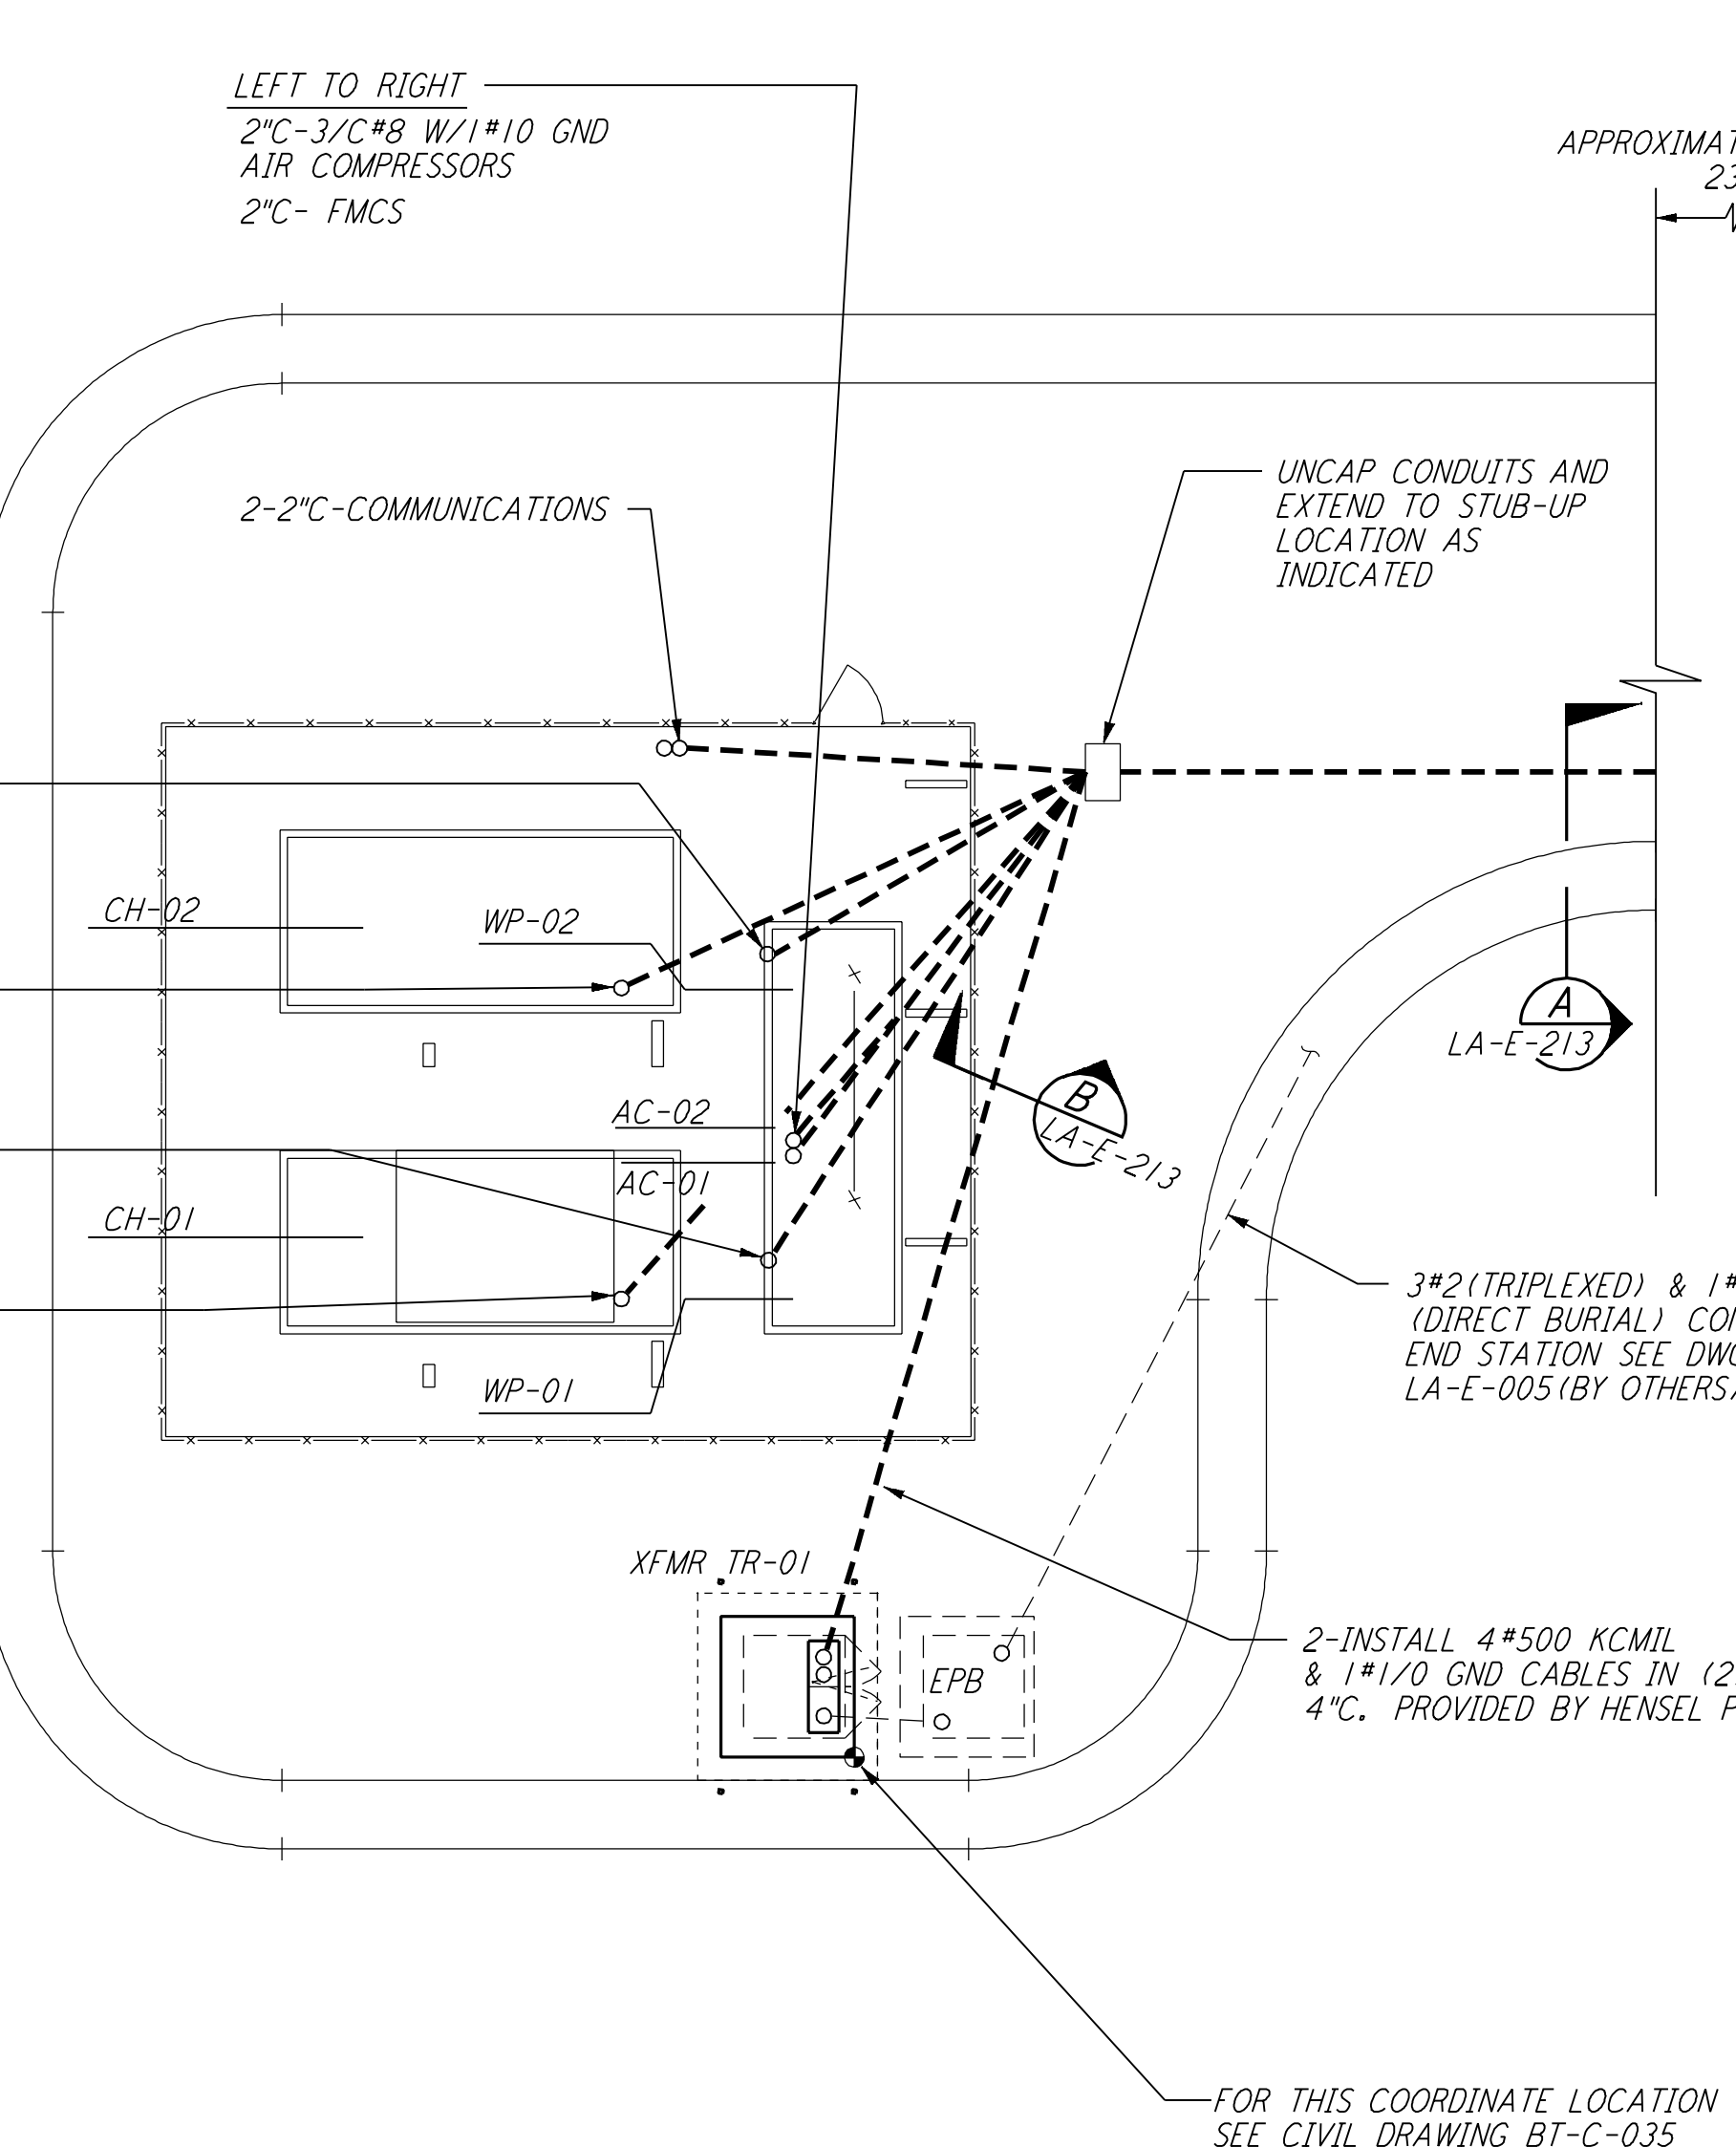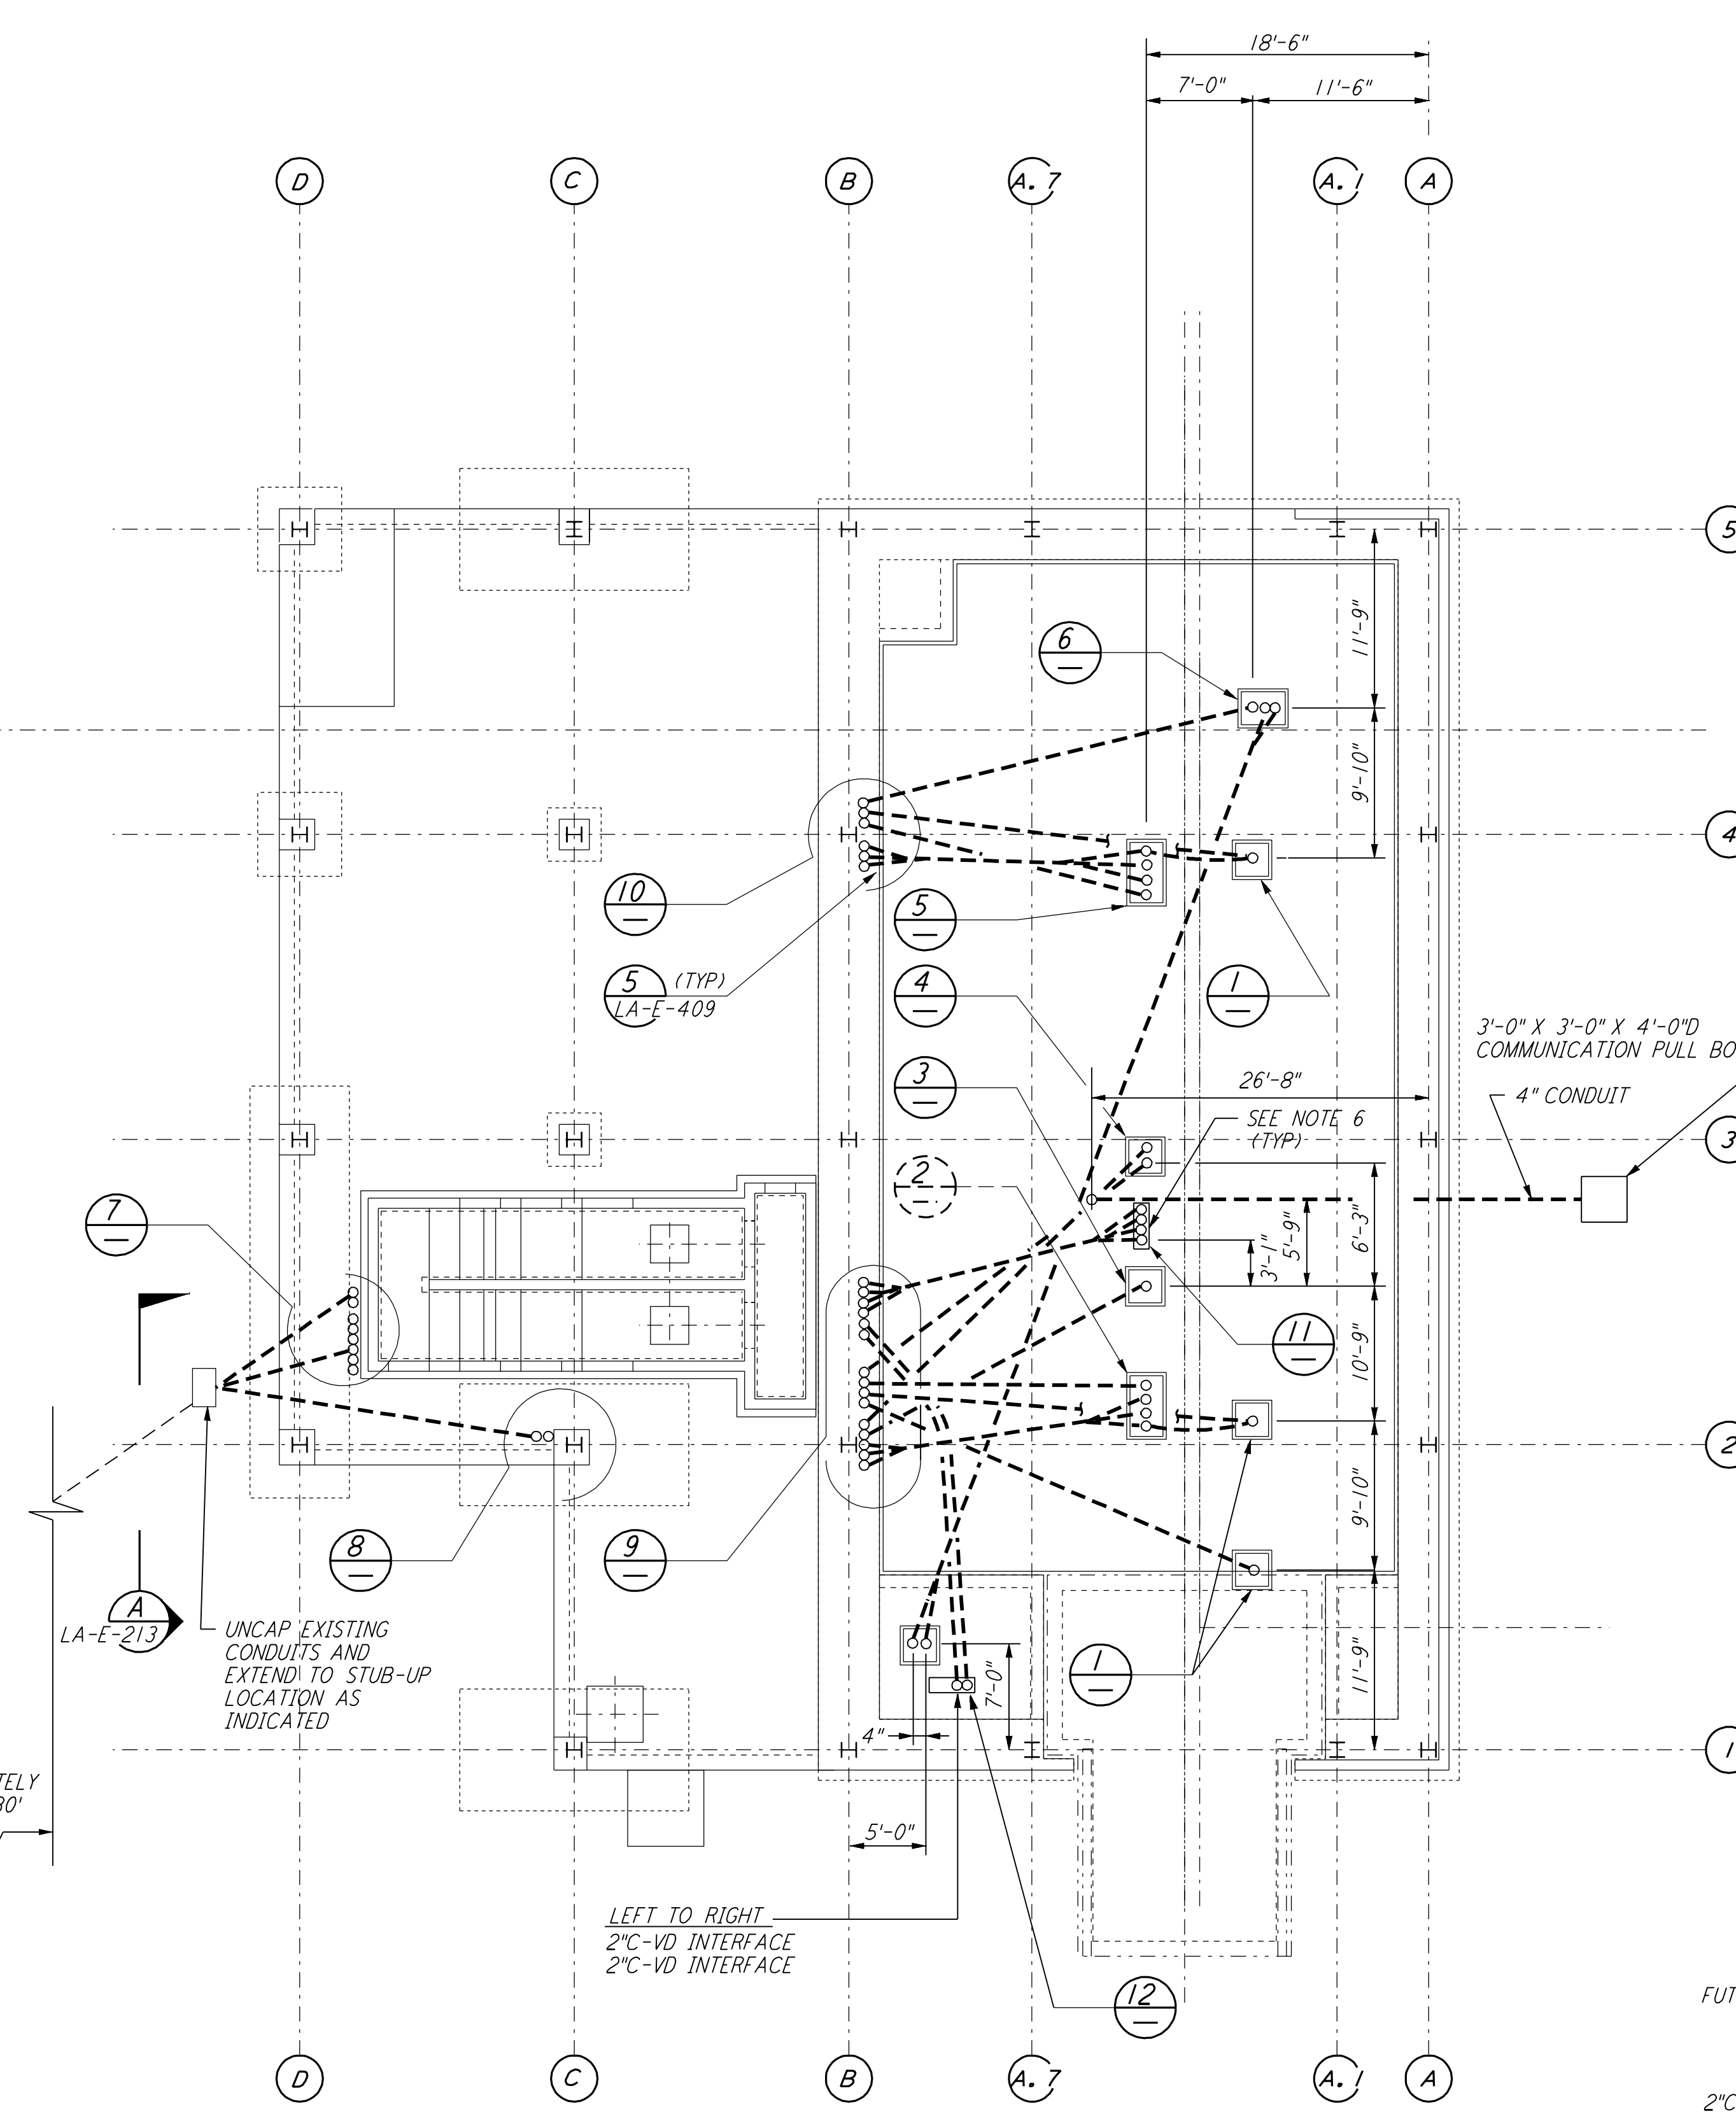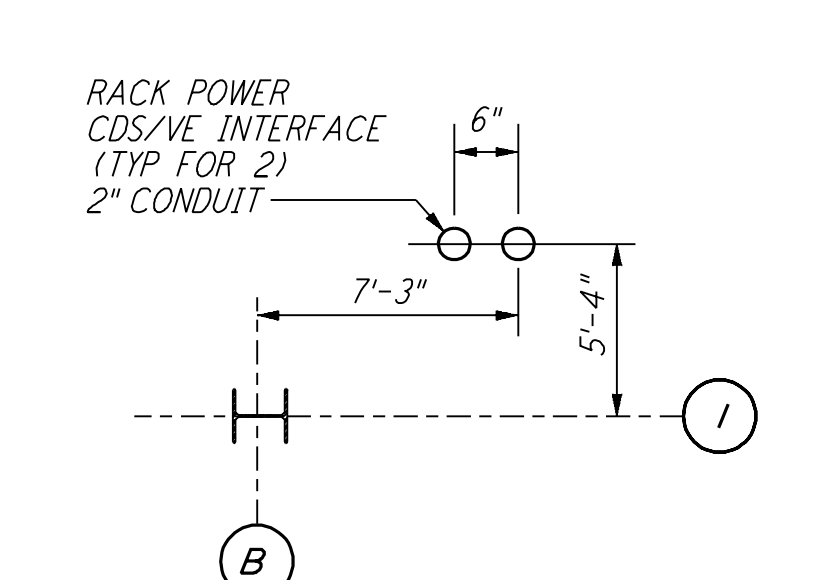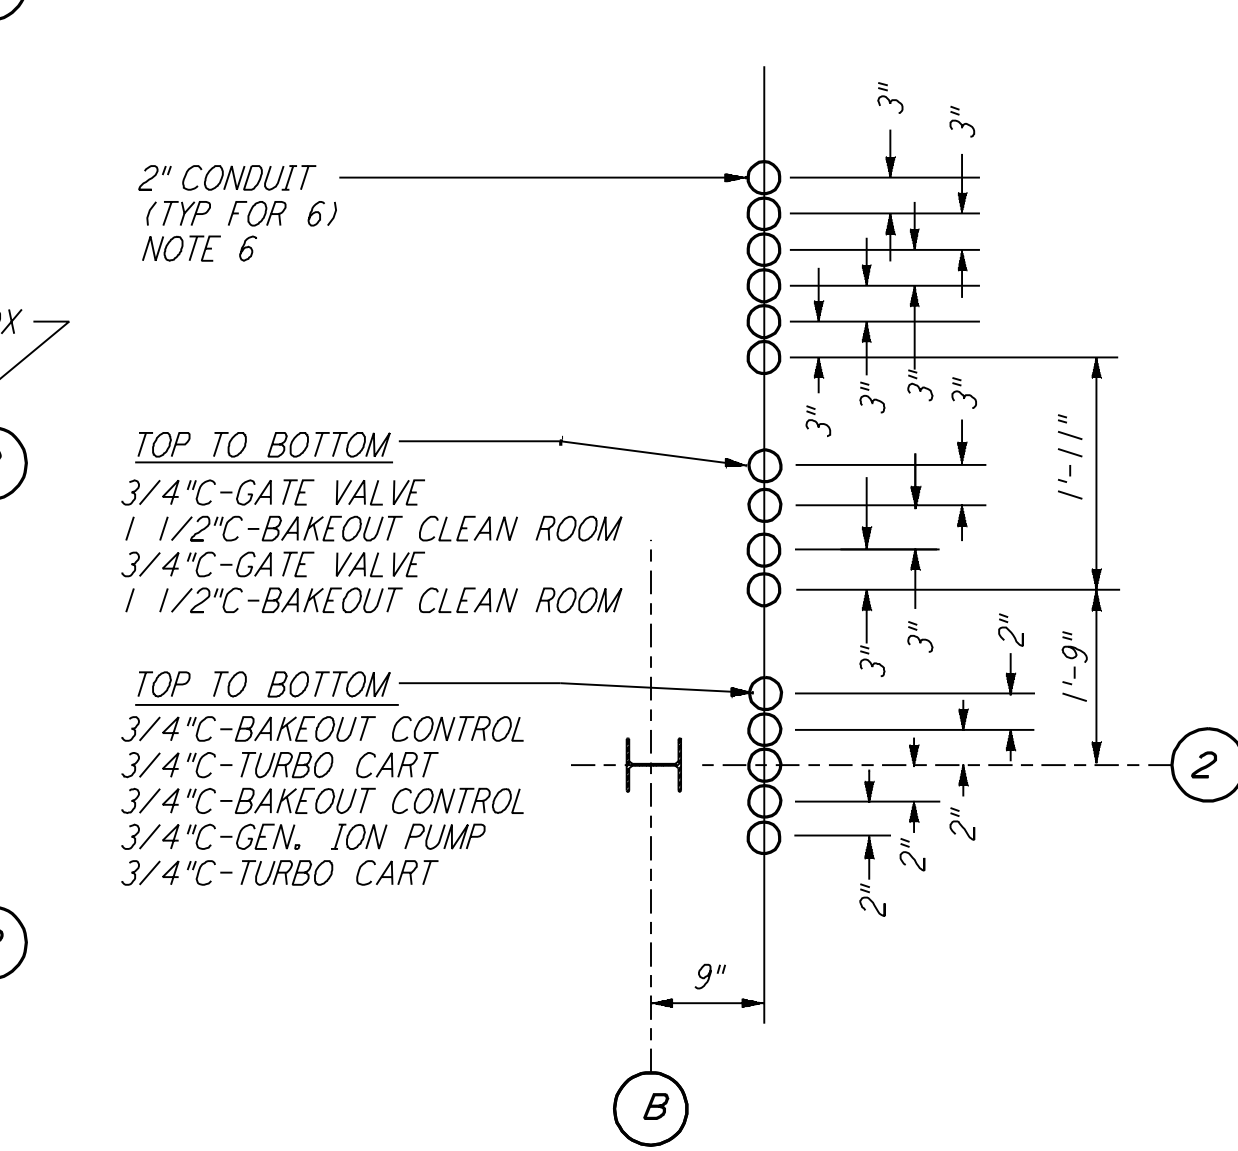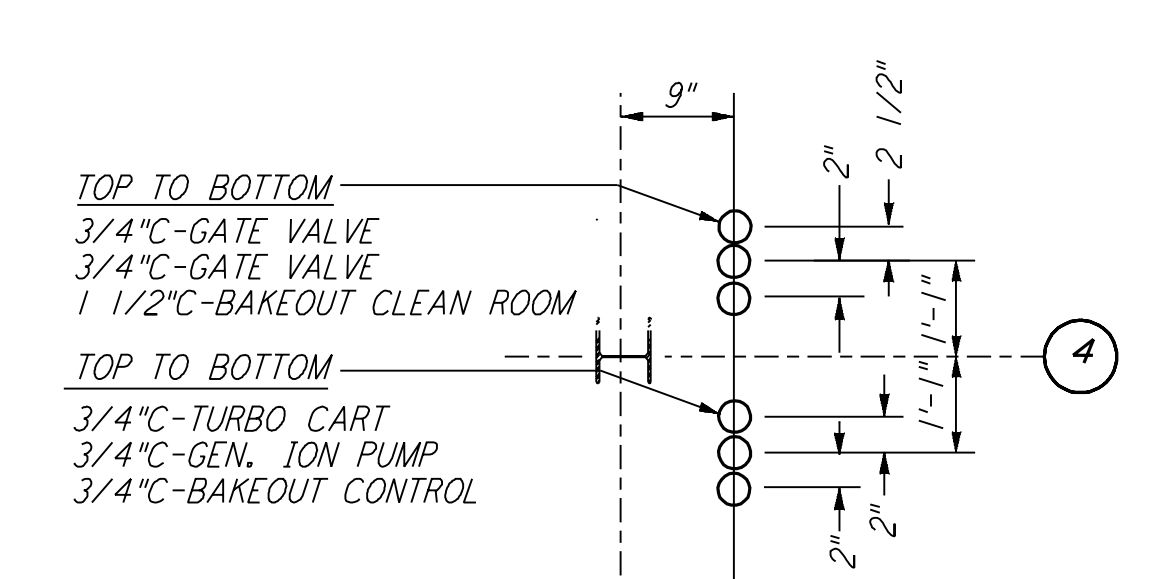

NO.	DATE	BY	CHKD	ENGR	PROJ	DESCRIPTION
3	8-7-98	J.E.				ISSUED FOR AS-BUILT
2	4-4-97	J.G.	K.R.	K.R.	T.D.M.	REVISED DIMENSION
1	3-17-97	J.G.	T.D.M.	K.R.	T.D.M.	REVISED VACUUM EQUIP. LOCATIONS

ISSUED FOR CONSTRUCTION		
DRAWN	M.M.	11-15-96
CHECKED	J.C.L.	7-24-96
ENGINEER	K.C.F.	10-25-96
PROJ	T.D.M.	11-15-96

**AS-BUILT DRAWINGS**

**PARSONS**

100 WEST WALNUT STREET  
PASADENA, CALIFORNIA

**LIGO**

CALIFORNIA INSTITUTE OF TECHNOLOGY  
MASSACHUSETTS INSTITUTE OF TECHNOLOGY

**LIGO-D961034-03-O**

LASER INTERFEROMETER  
GRAVITATIONAL-WAVE OBSERVATORY  
SITE NO. 2 - LIVINGSTON, LOUISIANA

TITLE	SCALE	CONTRACT NUMBER	PROJECT NUMBER
<b>ELECTRICAL END STATION B UNDERGROUND PLAN</b>	AS NOTED	PP150969	8094
SHEET NUMBER	REVISIONS		
<b>LA-E-213</b>			<b>3</b>