


LIST OF MATERIAL

ITEM NO.	QTY	DESCRIPTION
1	1	AIR TERMINAL, SOLID COPPER, 1/2" X 24" HARGER # 71B
2	1	BRONZE ADHESIVE BASE, HARGER # 152
3	1	ADHESIVE, HARGER # 263


AIR TERMINAL HORIZONTAL MTG. (1) REF
 N. T. S. E-103
 E-112
 E-202
 E-208

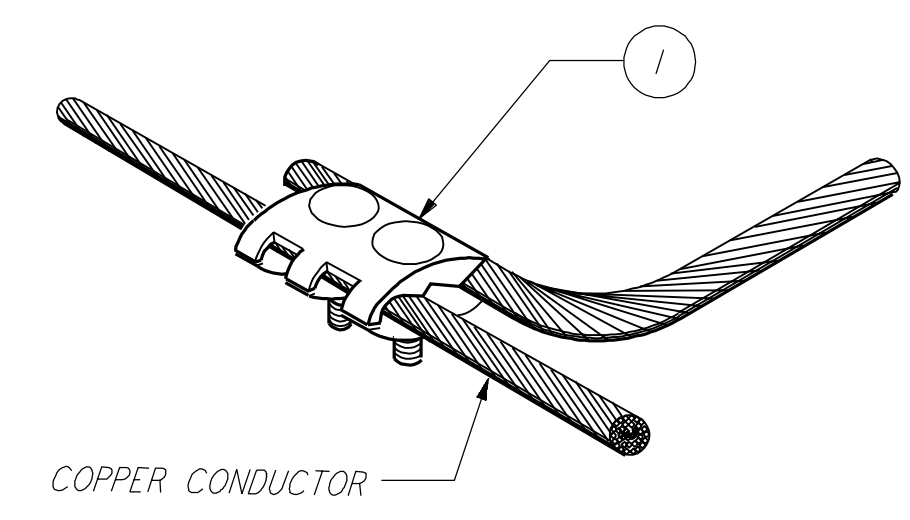

LIST OF MATERIAL

ITEM NO.	QTY	DESCRIPTION
1	1	2 BOLT PARALLEL SPLICER, HARGER # 204


CABLE TAP (2) REF
 N. T. S. E-202
 E-208

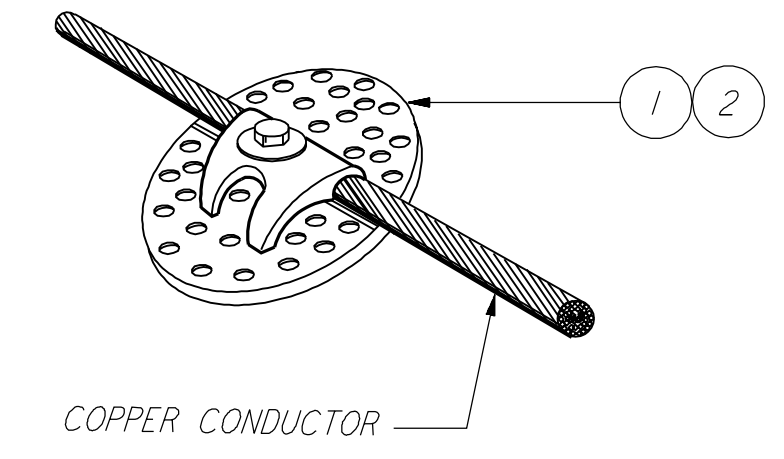

LIST OF MATERIAL

ITEM NO.	QTY	DESCRIPTION
1	1	ADHESIVE CABLE HOLDER, HARGER # 260
2	1	ADHESIVE, HARGER # 263

CABLE BONDING TO SURFACE (3) REF
 N. T. S. E-103
 E-202
 E-208

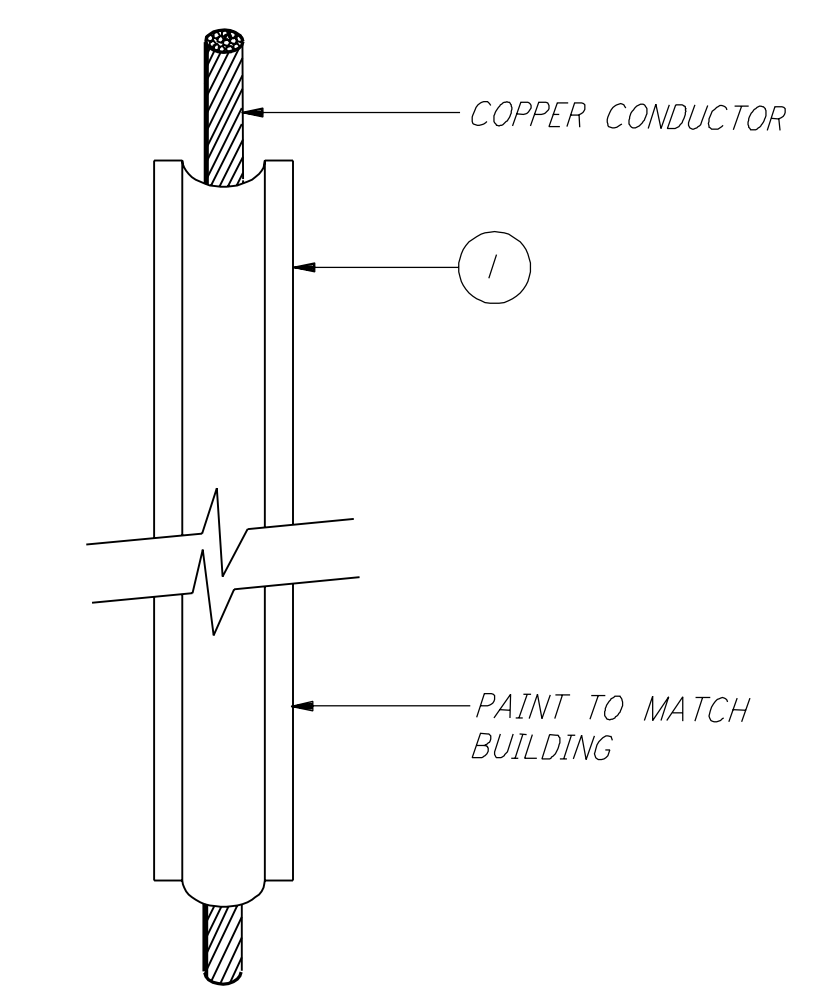

LIST OF MATERIAL

ITEM NO.	QTY	DESCRIPTION
1	AR	PVC CABLE GUARD HARGER # 321

EXTERIOR DOWN CONDUCTOR SUPPORT (4) REF
 N. T. S. E-103
 E-202
 E-208

not be reproduced, copied, loaned, exhibited, or used in any other way, except by written consent from PARSONS to the borrower.

This document and the design it covers are the property of PARSONS. They are loaned only with the borrower's expressed written agreement that they will

NO.	DATE	BY	CHKD	ENGR	PROJ	DESCRIPTION
1	8-7-98	JE				ISSUED FOR AS-BUILT

ISSUED FOR CONSTRUCTION		
DRAWN	M. M.	11-15-96
CHECKED	JCL	7-24-96
ENGINEER	KCR	10-25-96
PROJ	T. D. M.	11-15-96

AS-BUILT DRAWINGS

100 WEST WALNUT STREET
 PASADENA, CALIFORNIA

CALIFORNIA INSTITUTE OF TECHNOLOGY
 MASSACHUSETTS INSTITUTE OF TECHNOLOGY

LIGO-D961044-01-O

LASER INTERFEROMETER
 GRAVITATIONAL-WAVE OBSERVATORY
 SITE NO. 2 - LIVINGSTON, LOUISIANA

TITLE	SCALE	CONTRACT NUMBER	PROJECT NUMBER
ELECTRICAL LIGHTNING PROTECTION DETAILS	NONE	PP150969	8094
SHEET NUMBER		REVISIONS	
LA-E-408		1	