




NOTES:
 1. SEE SHEET LA-C-002 FOR GENERAL NOTES, LEGEND AND ABBREVIATIONS.

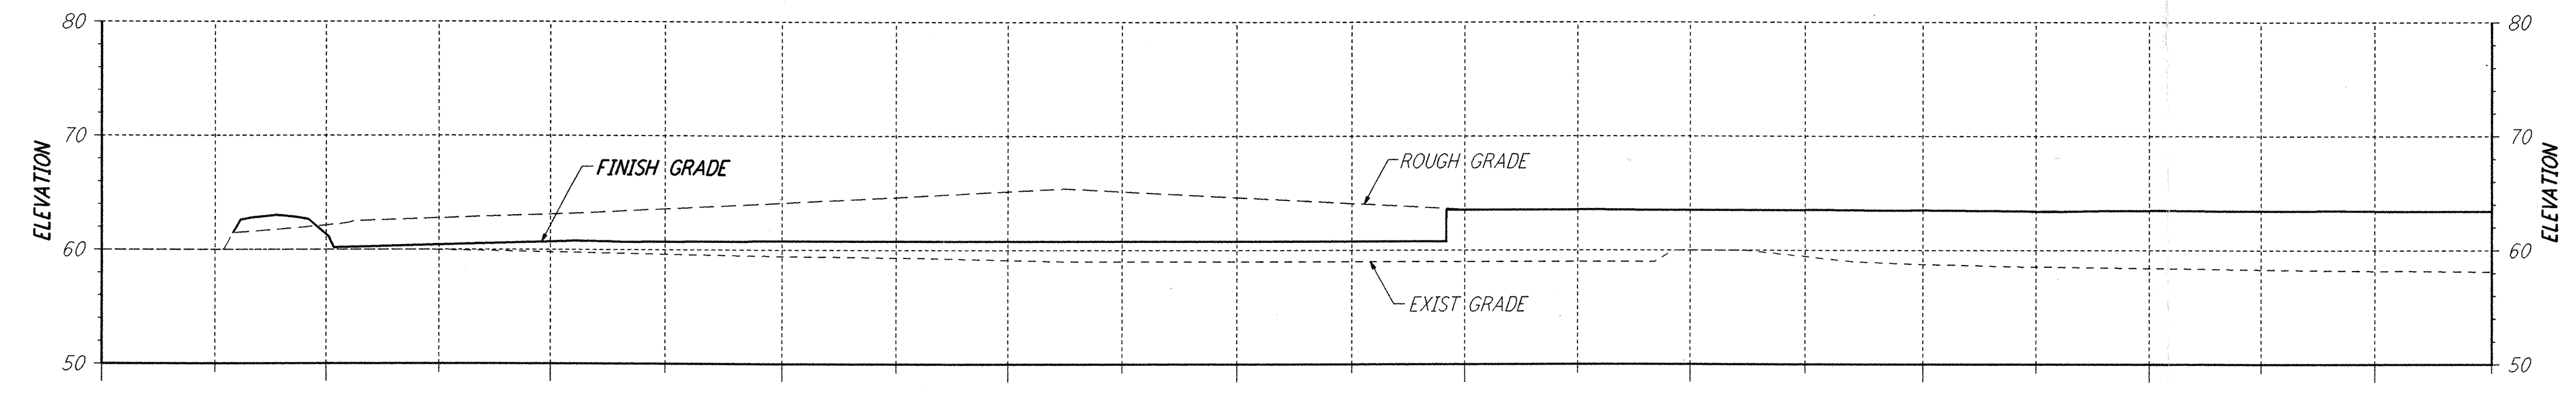


SECTION A
 SCALES: HORIZ: 1" = 50'
 VERT: 1" = 10'
 (CORNER STATION - ALONG SOUTHWEST ARM BEAM TUBE)

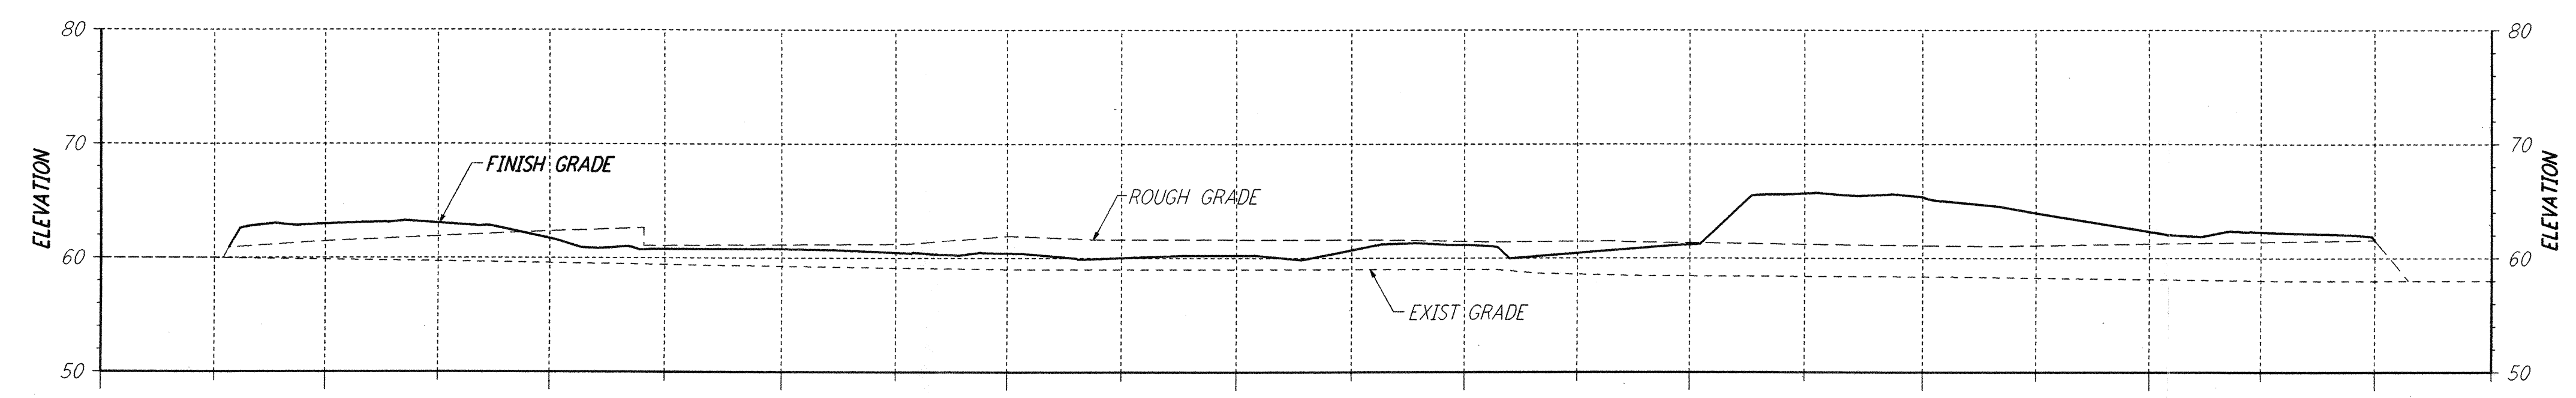


SECTION B
 SCALES: HORIZ: 1" = 50'
 VERT: 1" = 10'
 (CORNER STATION - ALONG SOUTHWEST AXIS)

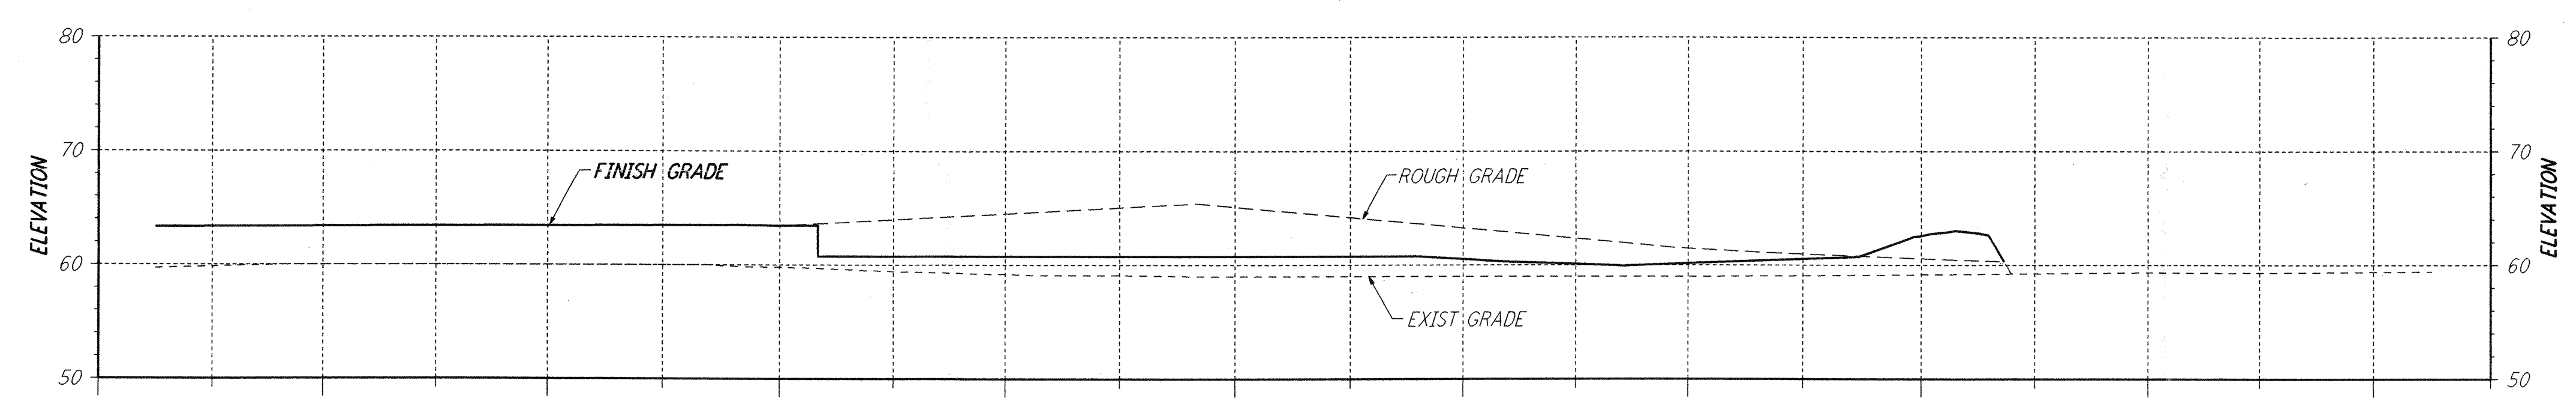


SECTION C
 SCALES: HORIZ: 1" = 50'
 VERT: 1" = 10'
 (CORNER STATION - ALONG SOUTHEAST ARM BEAM TUBE)

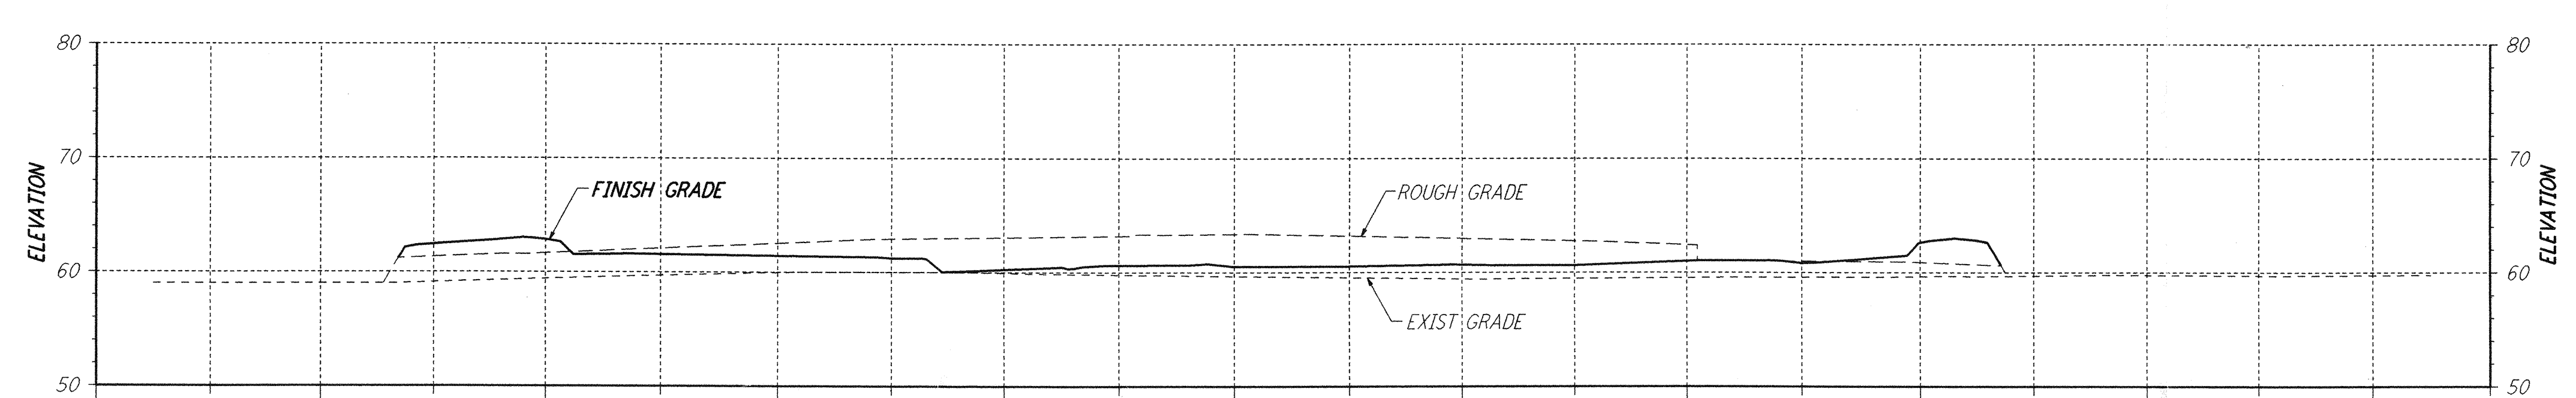


SECTION D
 SCALES: HORIZ: 1" = 50'
 VERT: 1" = 10'
 (CORNER STATION - ALONG SOUTHEAST AXIS)

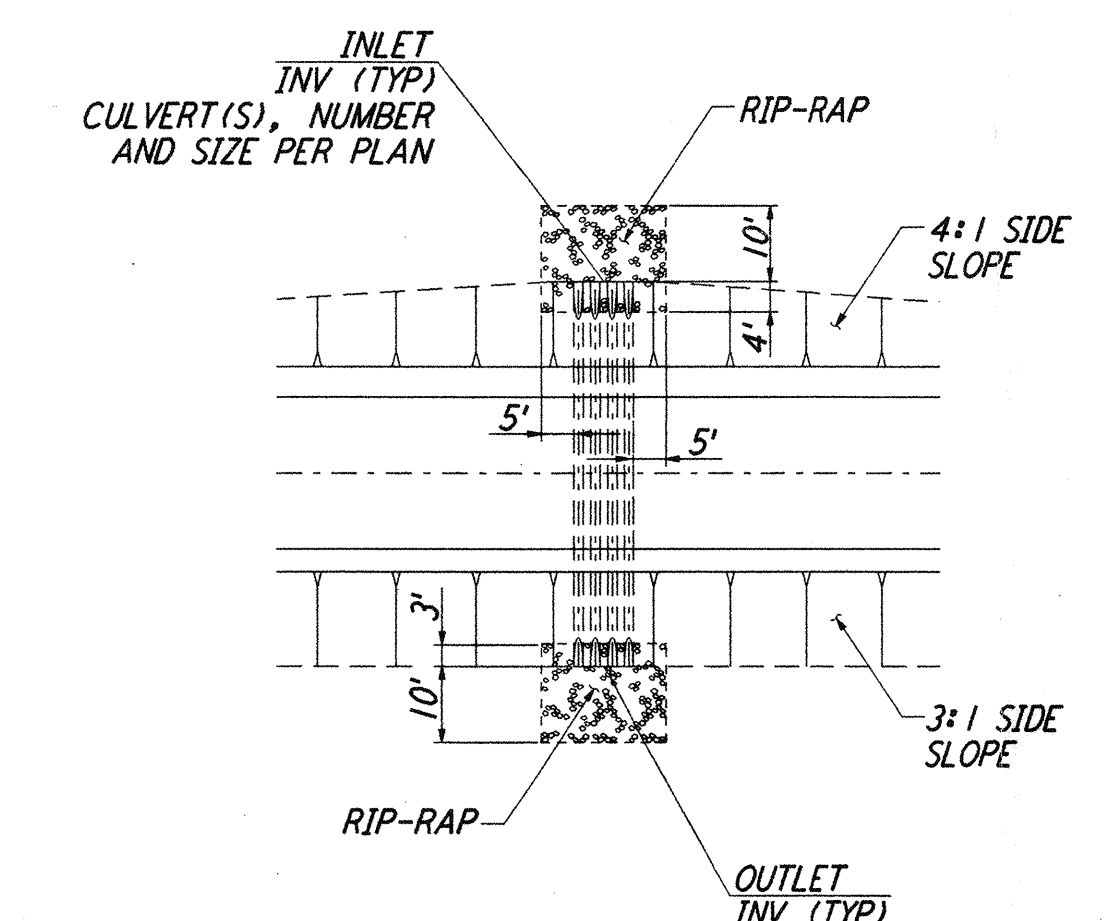


RIP-RAP
 NOT TO SCALE
 SCALES: HORIZ: 1" = 50'
 VERT: 1" = 10'

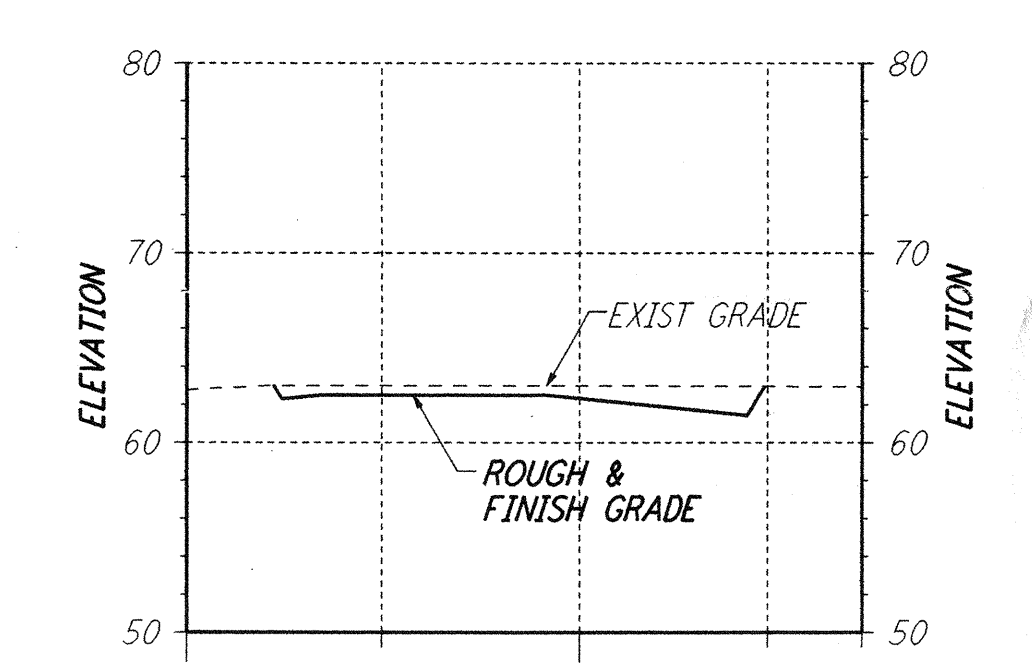


SECTION E
 SCALES: HORIZ: 1" = 50'
 VERT: 1" = 10'
 (MID-POINT PUMP STATION - SOUTHWEST ARM)

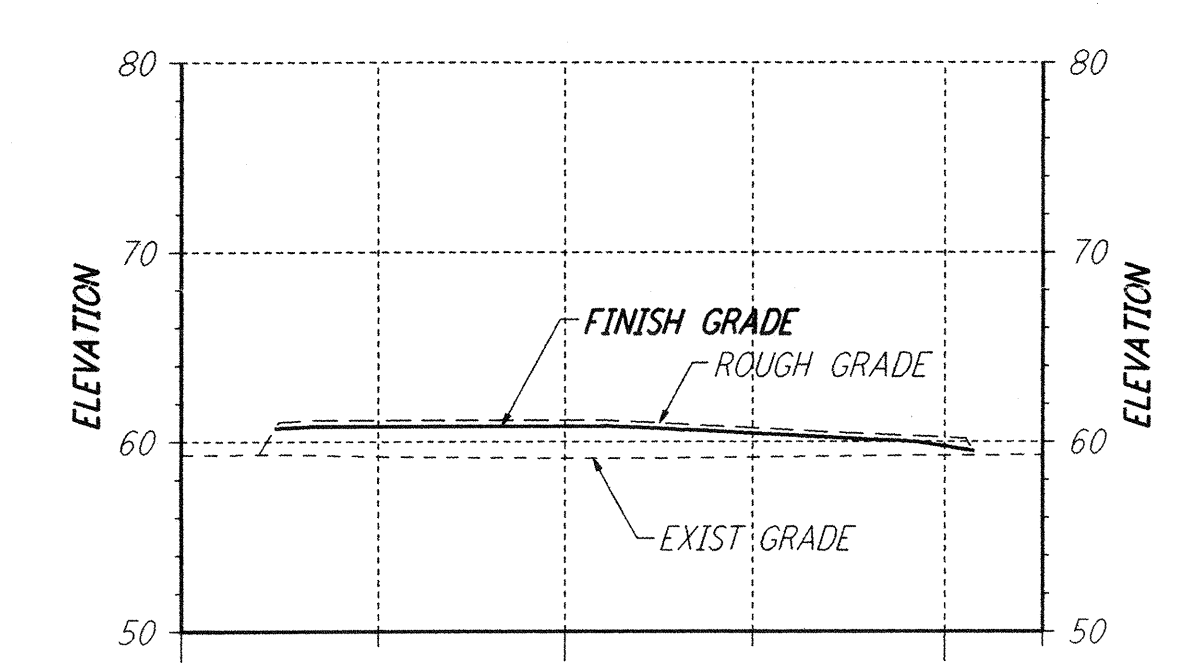


SECTION F
 SCALES: HORIZ: 1" = 50'
 VERT: 1" = 10'
 (END STATION - SOUTHWEST ARM)

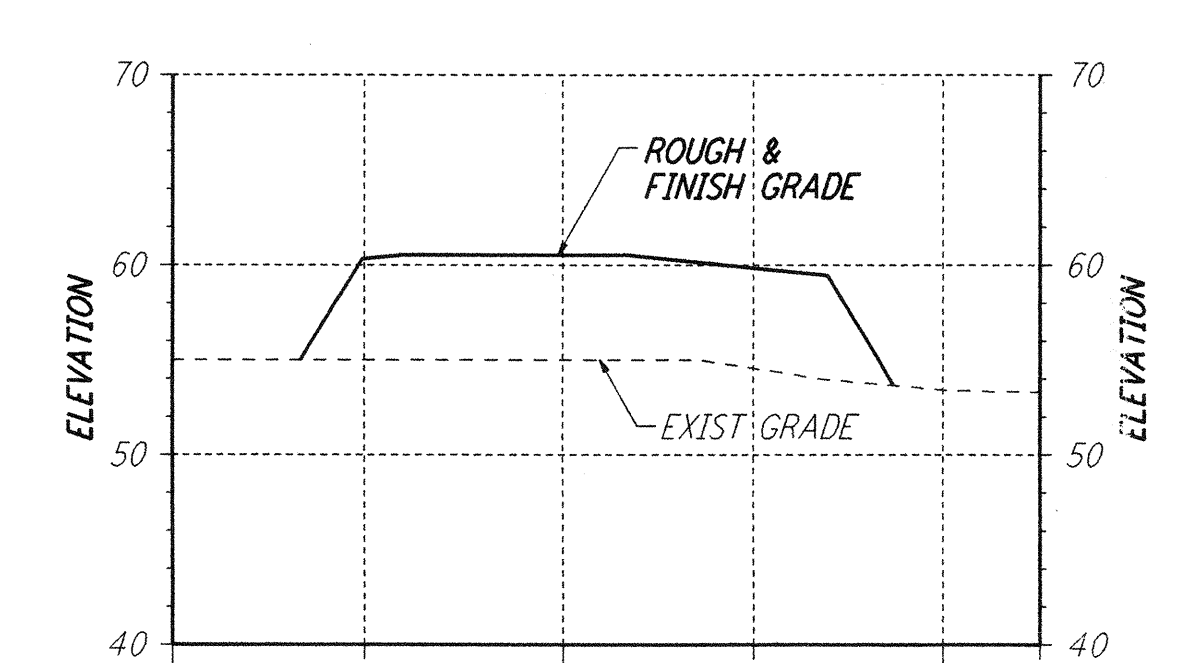

SECTION G
 SCALES: HORIZ: 1" = 50'
 VERT: 1" = 10'
 (MID-POINT PUMP STATION - SOUTHEAST ARM)

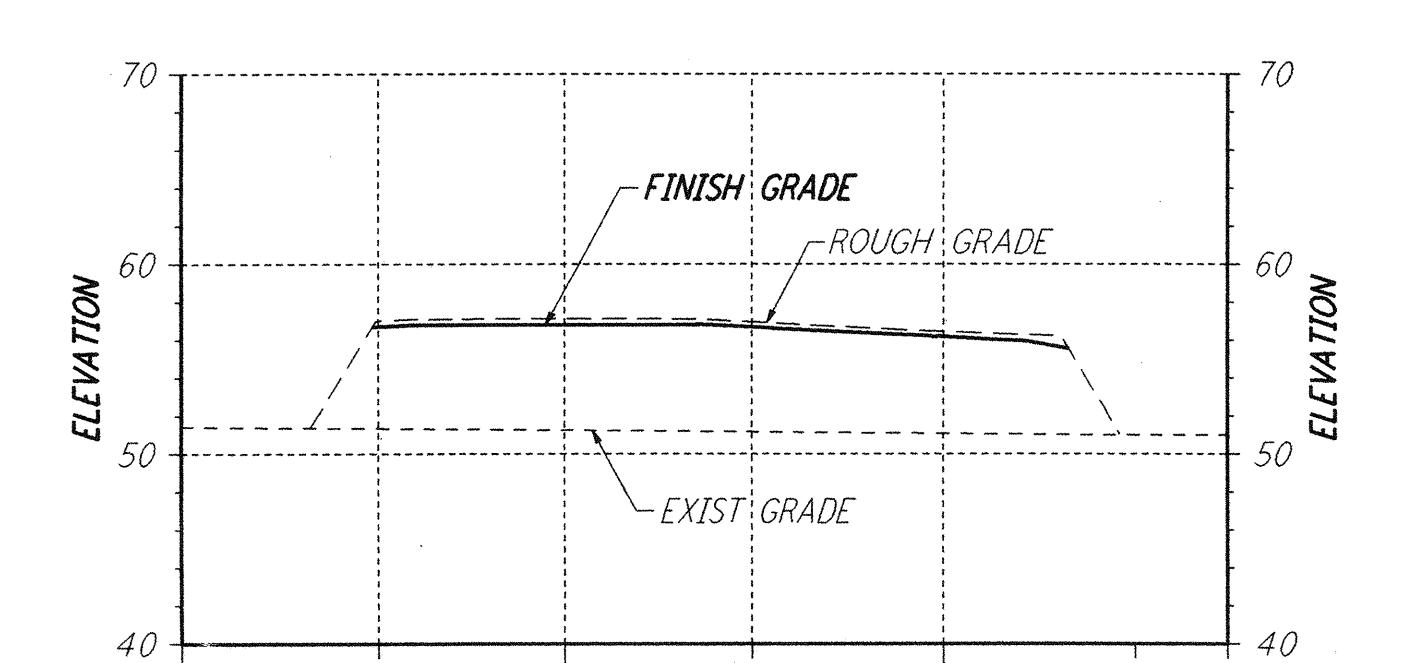

SECTION H
 SCALES: HORIZ: 1" = 50'
 VERT: 1" = 10'
 (END STATION - SOUTHEAST ARM)

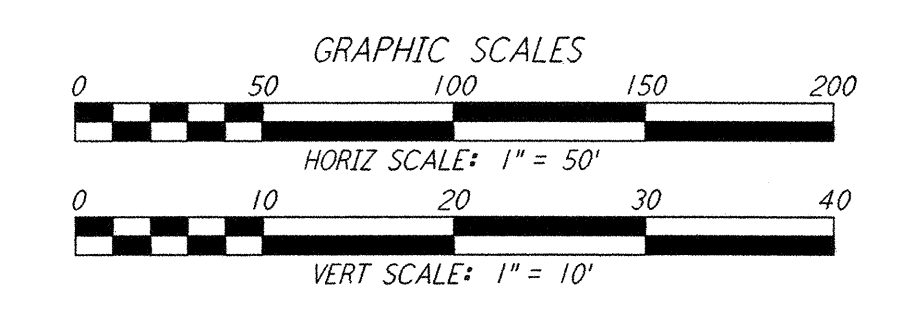

not be reproduced, copied, loaned, exhibited, or used in any other way, except by written consent from PARSONS to the borrower.

This document and the design it covers are the property of PARSONS. They are loaned only with the borrower's expressed written agreement that they will

NO.	DATE	BY	CHKD	ENGR	PROJ	DESCRIPTION
1	08-07-98	WRB	TD	TD	TD	ISSUED FOR AS-BUILT

ISSUED FOR CONSTRUCTION		
DRAWN	WRB	11-15-96
CHECKED	ML	11-15-96
ENGINEER	JB	11-15-96
PROJ	TDM	11-15-96

AS-BUILT DRAWINGS

PARSONS
 100 WEST WALNUT STREET
 PASADENA, CALIFORNIA

LIGO
 CALIFORNIA INSTITUTE OF TECHNOLOGY
 MASSACHUSETTS INSTITUTE OF TECHNOLOGY

LASER INTERFEROMETER
 GRAVITATIONAL-WAVE OBSERVATORY
 SITE NO. 2 - LIVINGSTON, LOUISIANA

TITLE	SCALE	CONTRACT NUMBER	PROJECT NUMBER
CIVIL GRADING SECTIONS & DETAILS SHEET 2	AS NOTED	PPI 50969	8094
SHEET NUMBER		REVISIONS	
LA-C-054			