


This document and the design it covers are the property of PARSONS. They are loaned only with the borrower's expressed written agreement that they will not be reproduced, copied, loaned, exhibited, or used in any other way, except by written consent from PARSONS to the borrower.


This document and the design it covers are the property of PARSONS. They are loaned only with the borrower's expressed written agreement that they will not be reproduced, copied, loaned, exhibited, or used in any other way, except by written consent from PARSONS to the borrower.

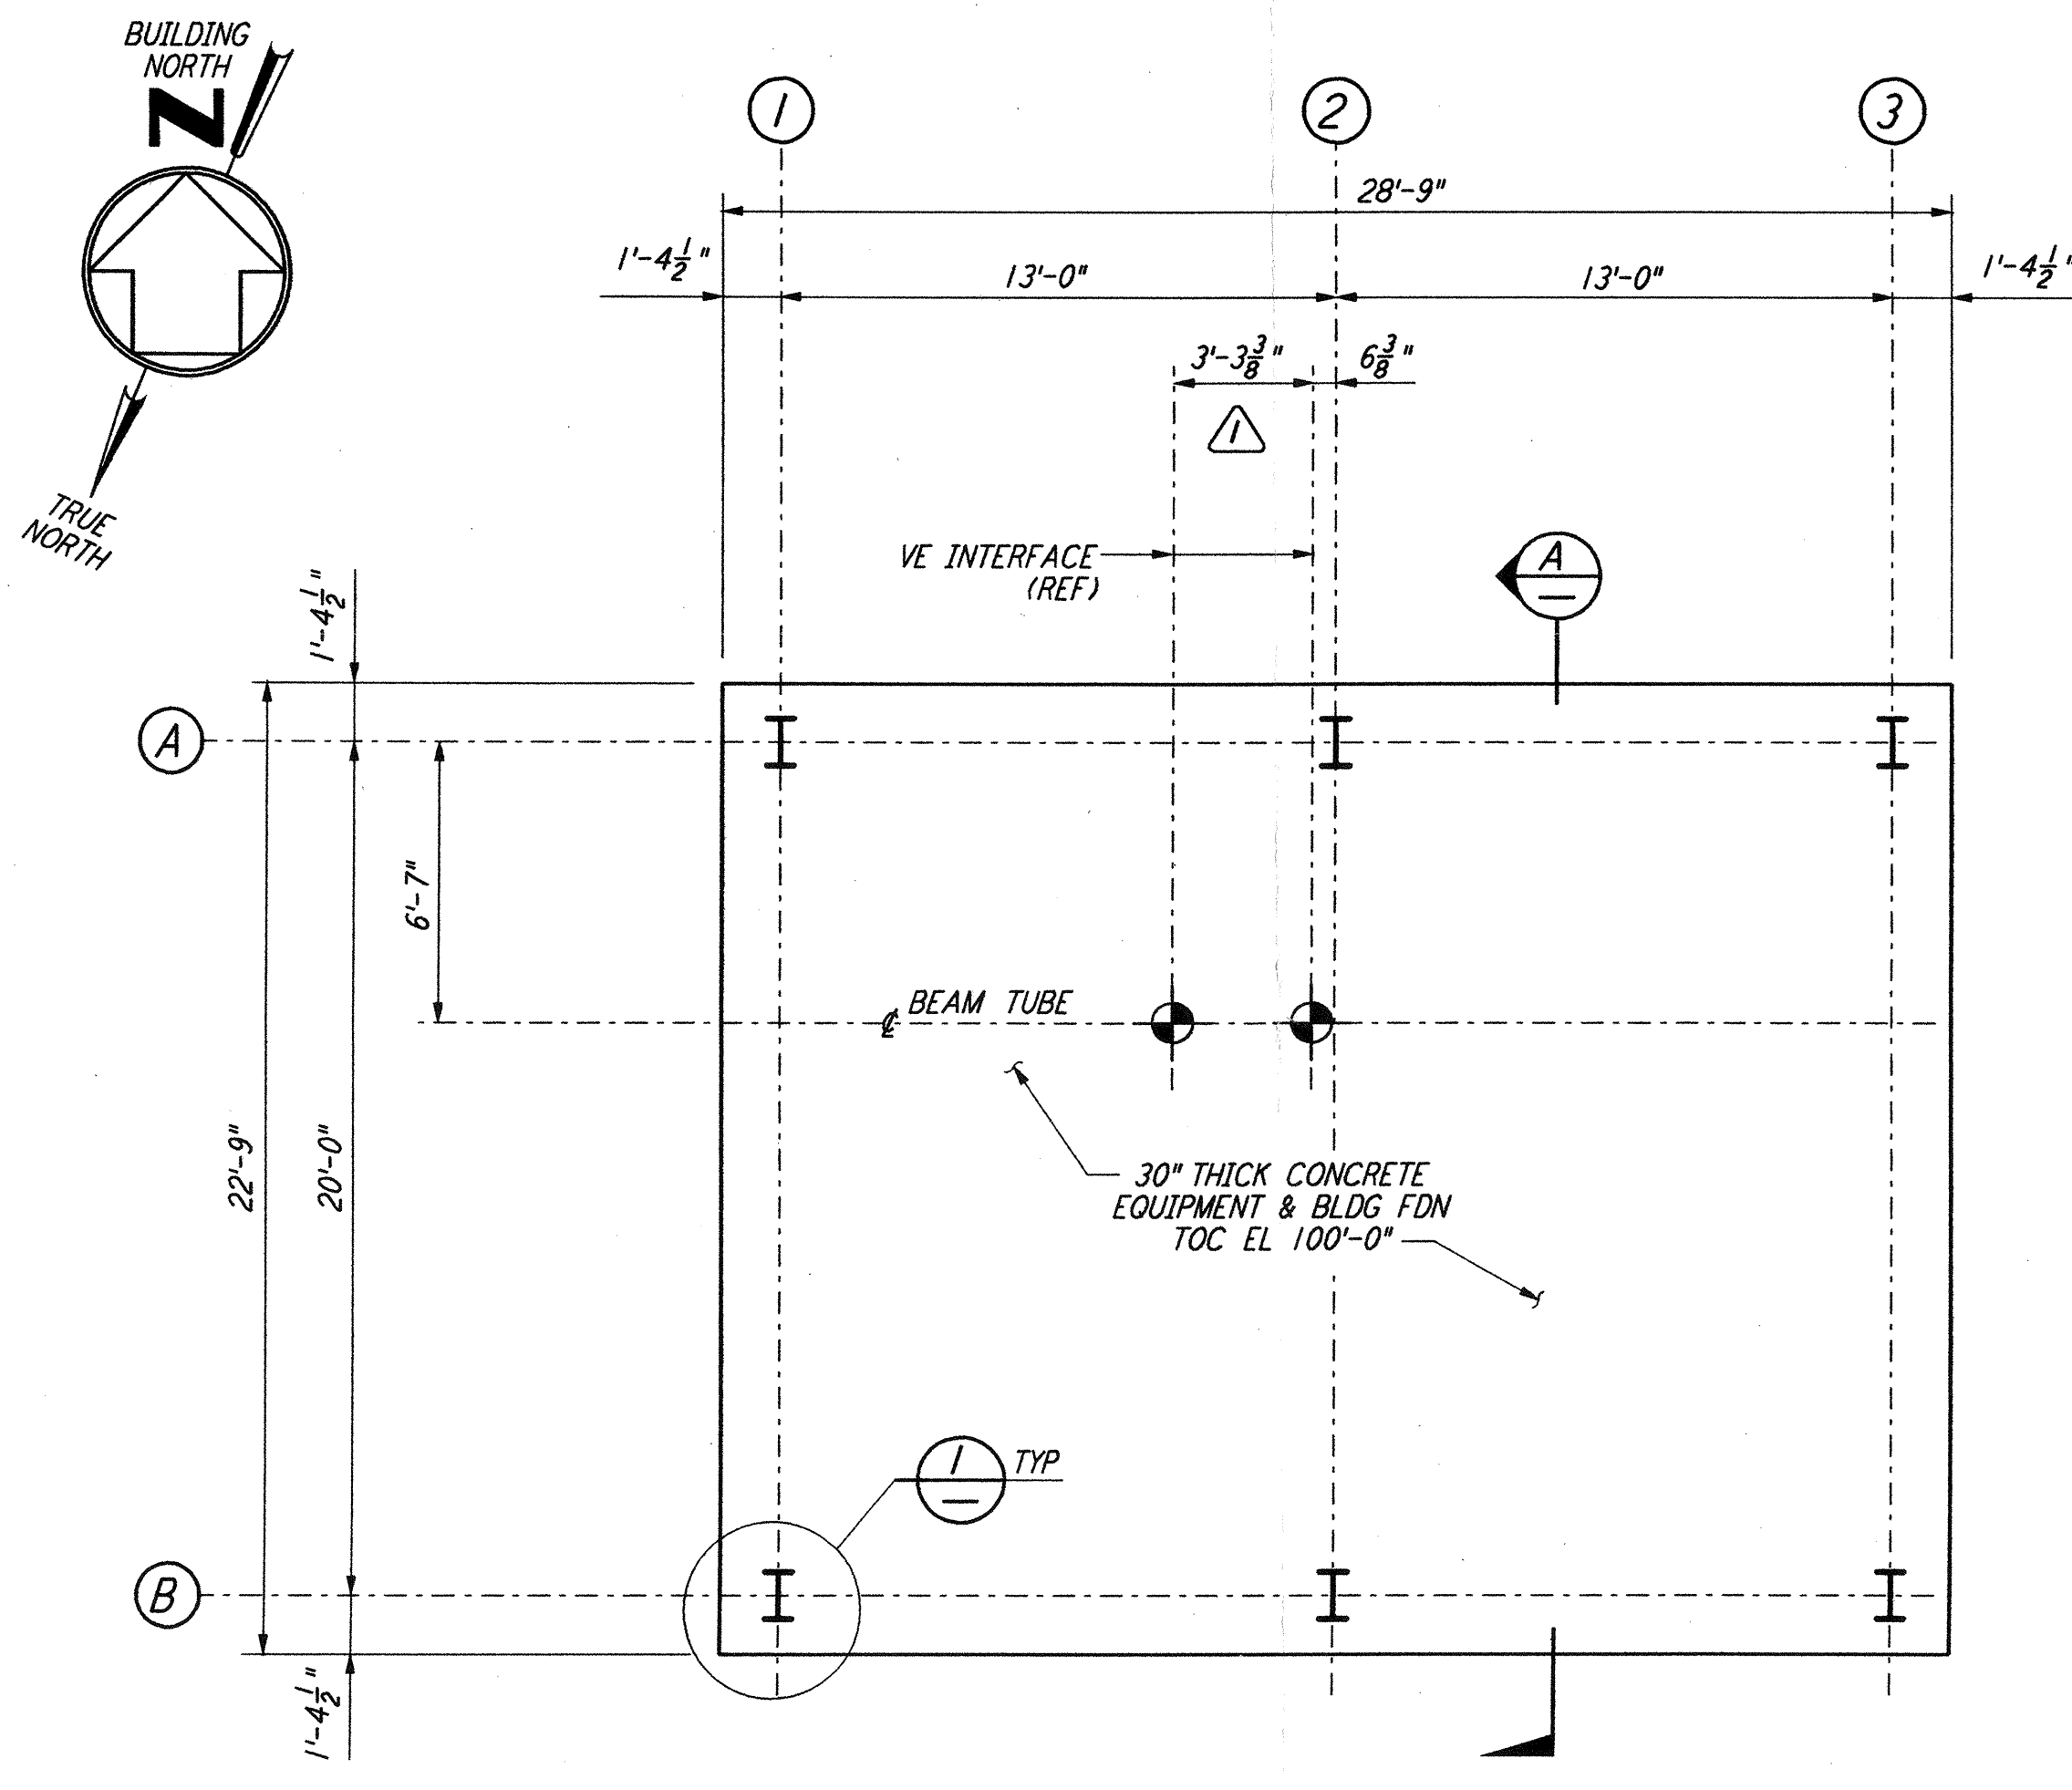

**SOUTHWEST ARM (ARM 2)
 MID STATION "A" - FOUNDATION PLAN**

1/4" = 1'-0"

DATUM POINT EL 100'-0" = EL 63.00'

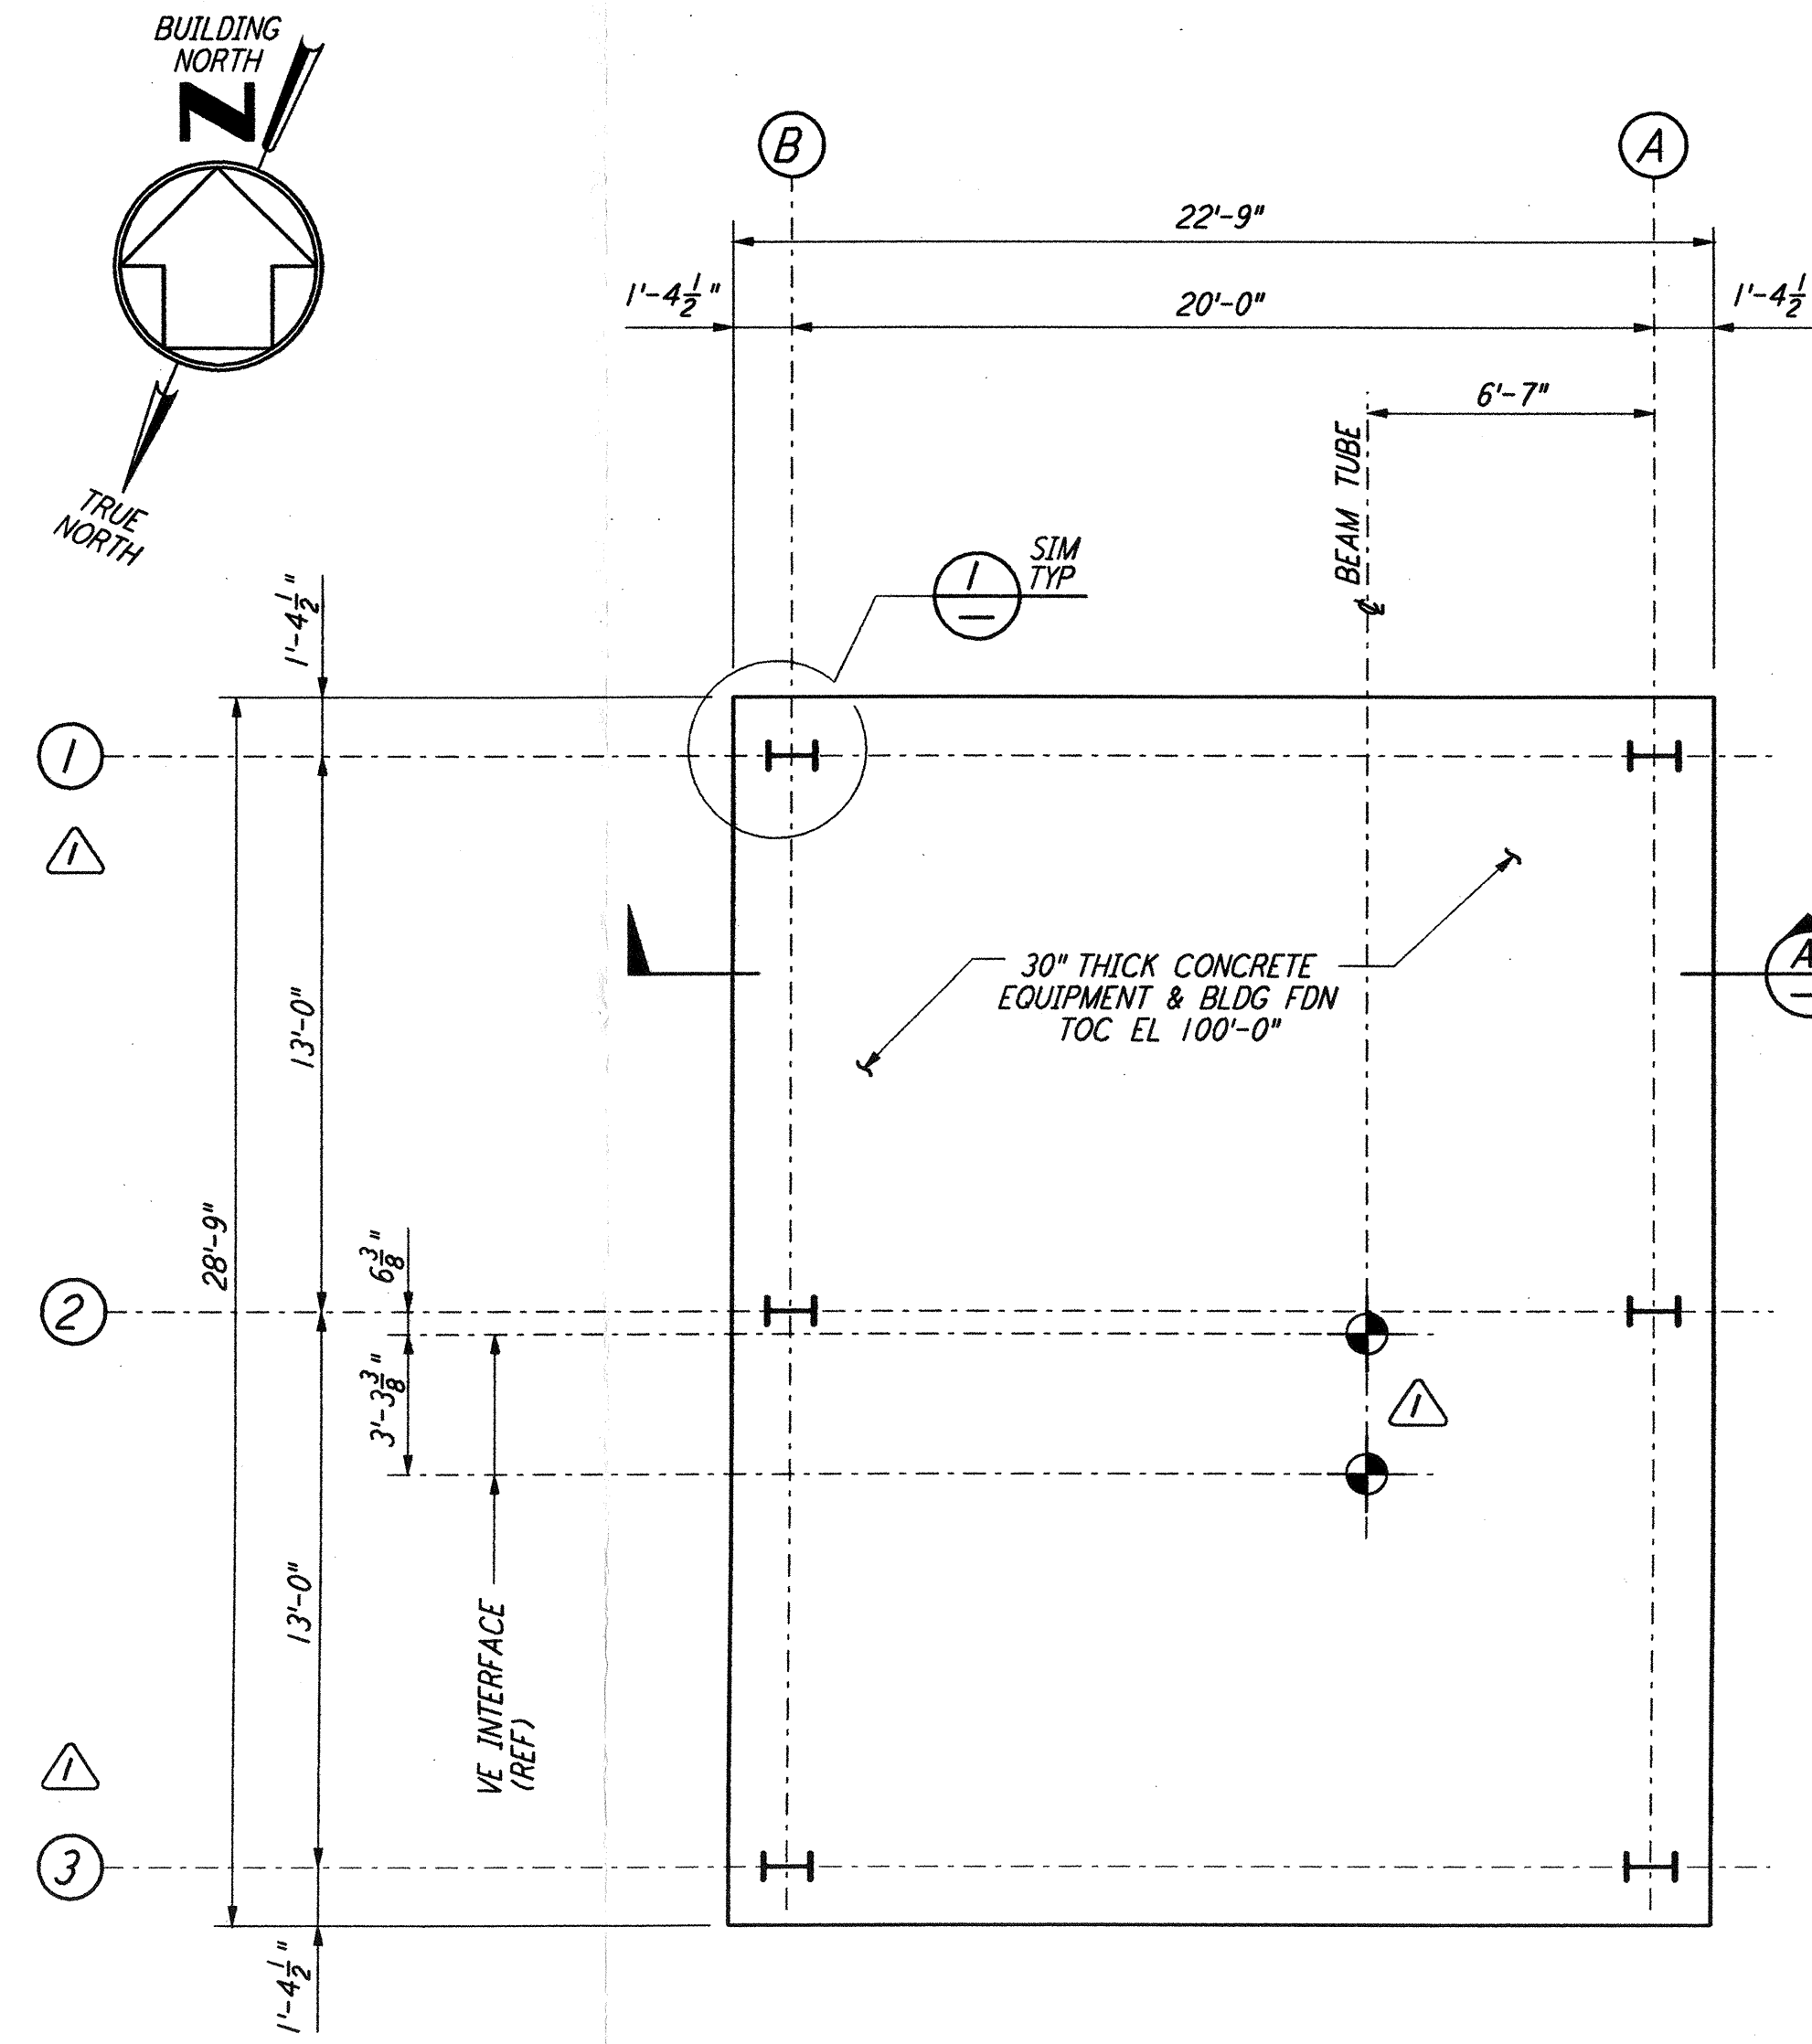


**SOUTHEAST ARM (ARM 1)
 MID STATION "B" - FOUNDATION PLAN**

1/4" = 1'-0"

DATUM POINT EL 100'-0" = EL 61.00'

NOTES:

1. FOR GENERAL NOTES, ABBREVIATIONS AND SYMBOLS SEE DRAWING LA-S-501.

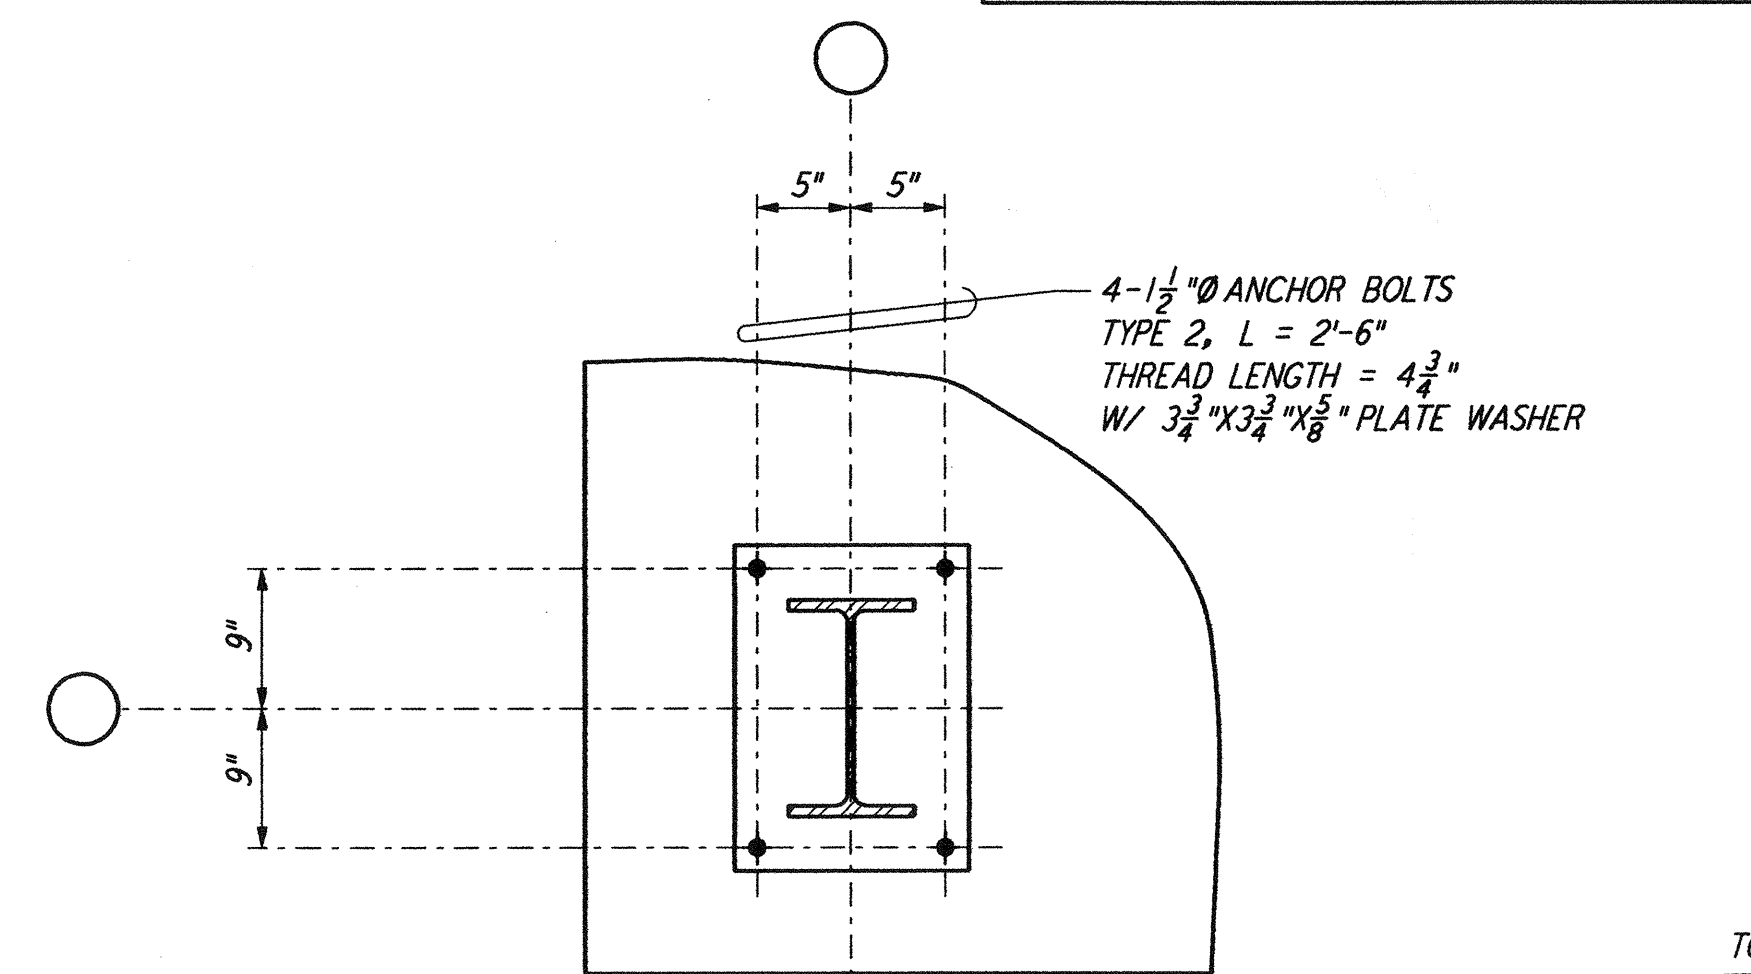


PLAN

ELEVATION


DETAIL 1

1" = 1'-0"

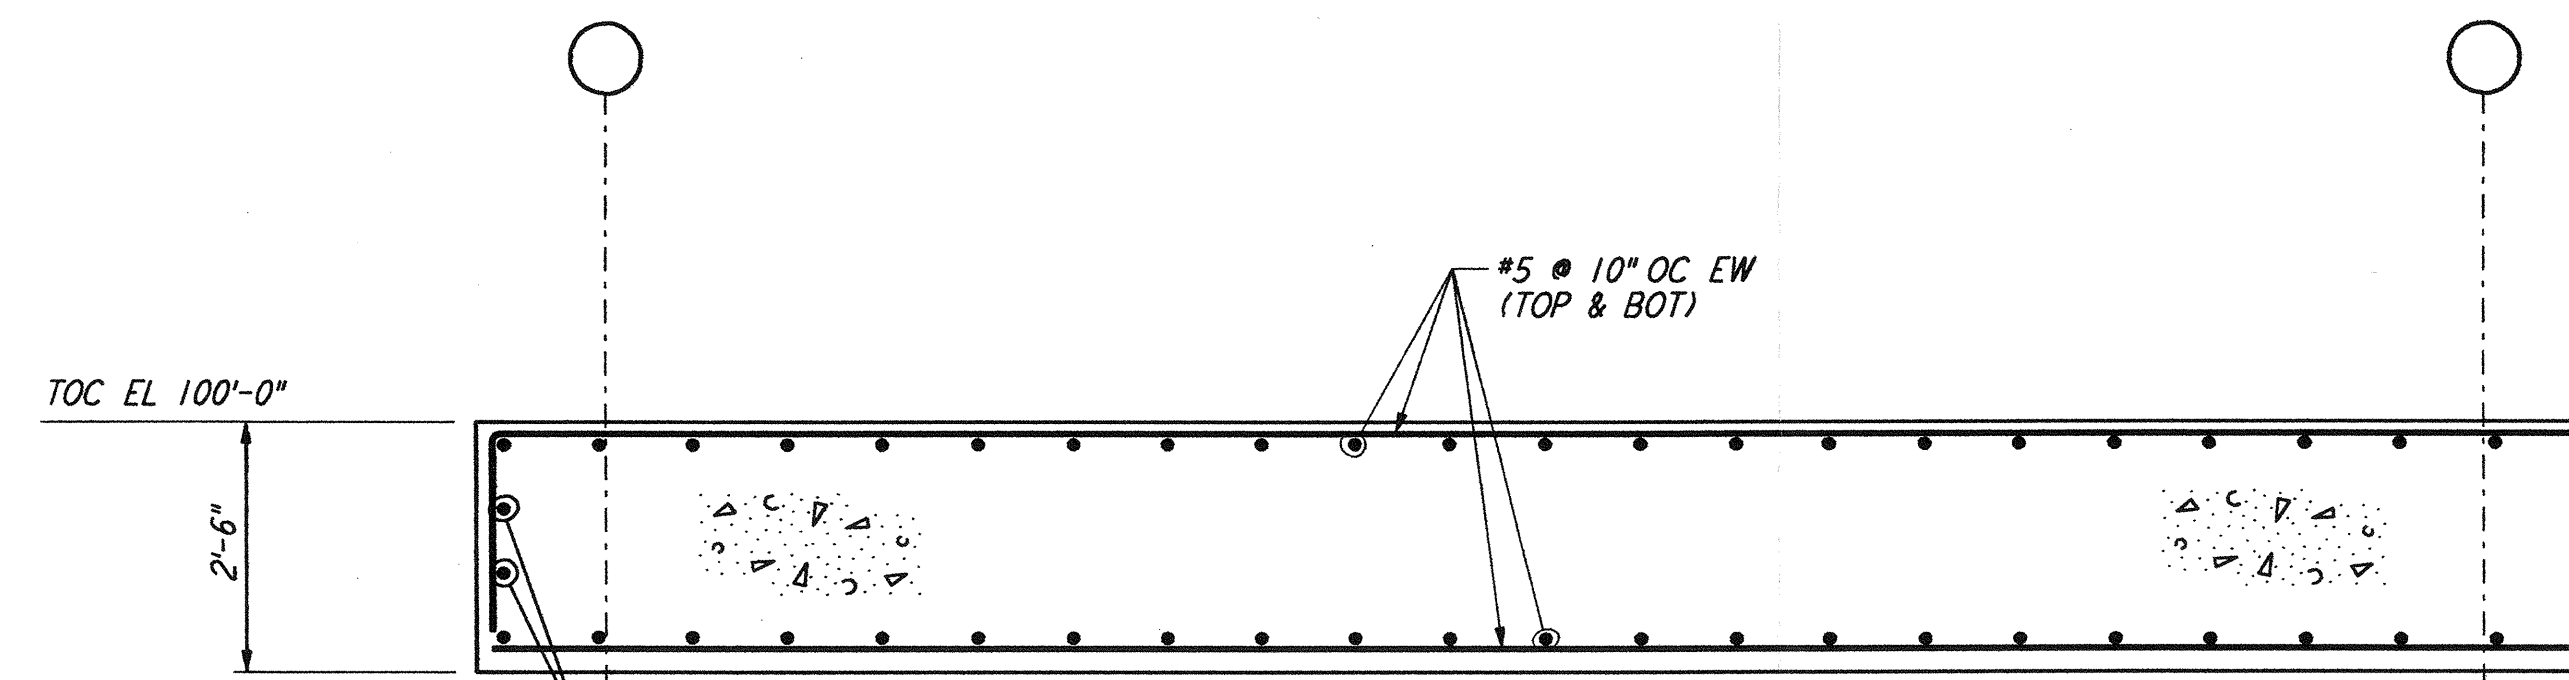


SECTION A

1/2" = 1'-0"

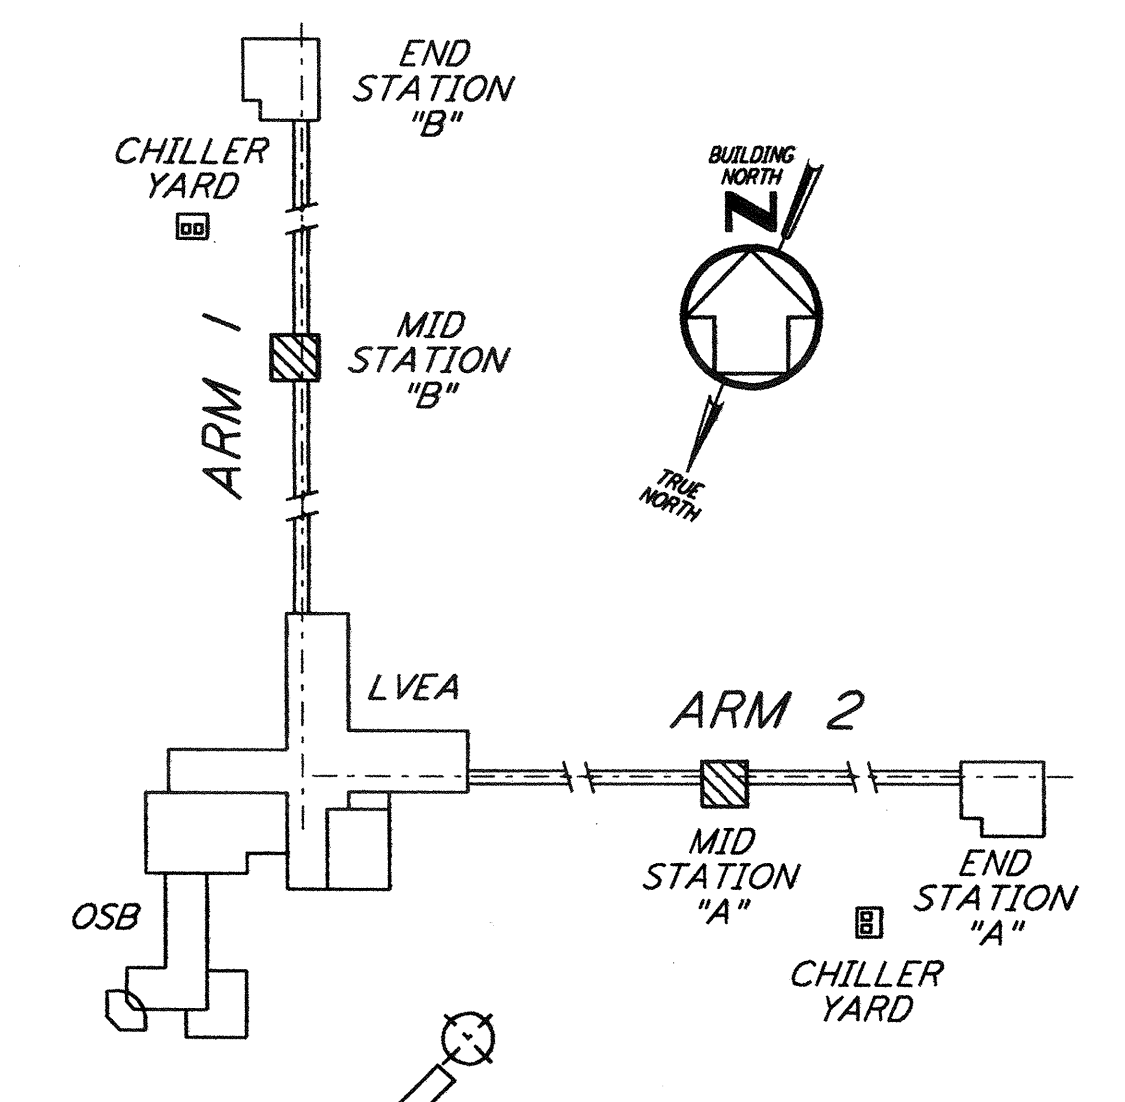

KEY PLAN

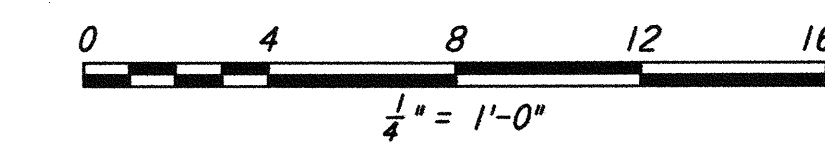

LIGO-D961242-02-O

NO.	DATE	BY	CHKD	ENGR	PROJ	DESCRIPTION
2	1-15-99	MEI	--	--	MDW	ISSUED FOR AS BUILT
1	2-28-97	RM				REV VE INTERFACE DIMS AT MID STA A&B

ISSUED FOR CONSTRUCTION		
DRAWN	MCS	11-15-96
CHECKED	DDM	11-15-96
ENGINEER	BP	11-15-96
PROJ	TDM	11-15-96

**AS-BUILT
 DRAWINGS**



100 WEST WALNUT STREET
 PASADENA, CALIFORNIA



CALIFORNIA INSTITUTE OF TECHNOLOGY
 MASSACHUSETTS INSTITUTE OF TECHNOLOGY

LASER INTERFEROMETER GRAVITATIONAL-WAVE OBSERVATORY BEAM TUBE ENCLOSURE - LIVINGSTON, LA			
TITLE	SCALE	PROJECT NUMBER	REVISIONS
STRUCTURAL BEAM TUBE ENCLOSURE MID STATIONS "A" & "B" FOUNDATION PLANS	AS NOTED	PP150969	8094
SHEET NUMBER		LA-S-507	