



This document and the design it covers are the property of PARSONS. They are loaned only with the borrower's expressed written agreement that they will not be reproduced, copied, loaned, exhibited, or used in any other way, except by written consent from PARSONS to the borrower.


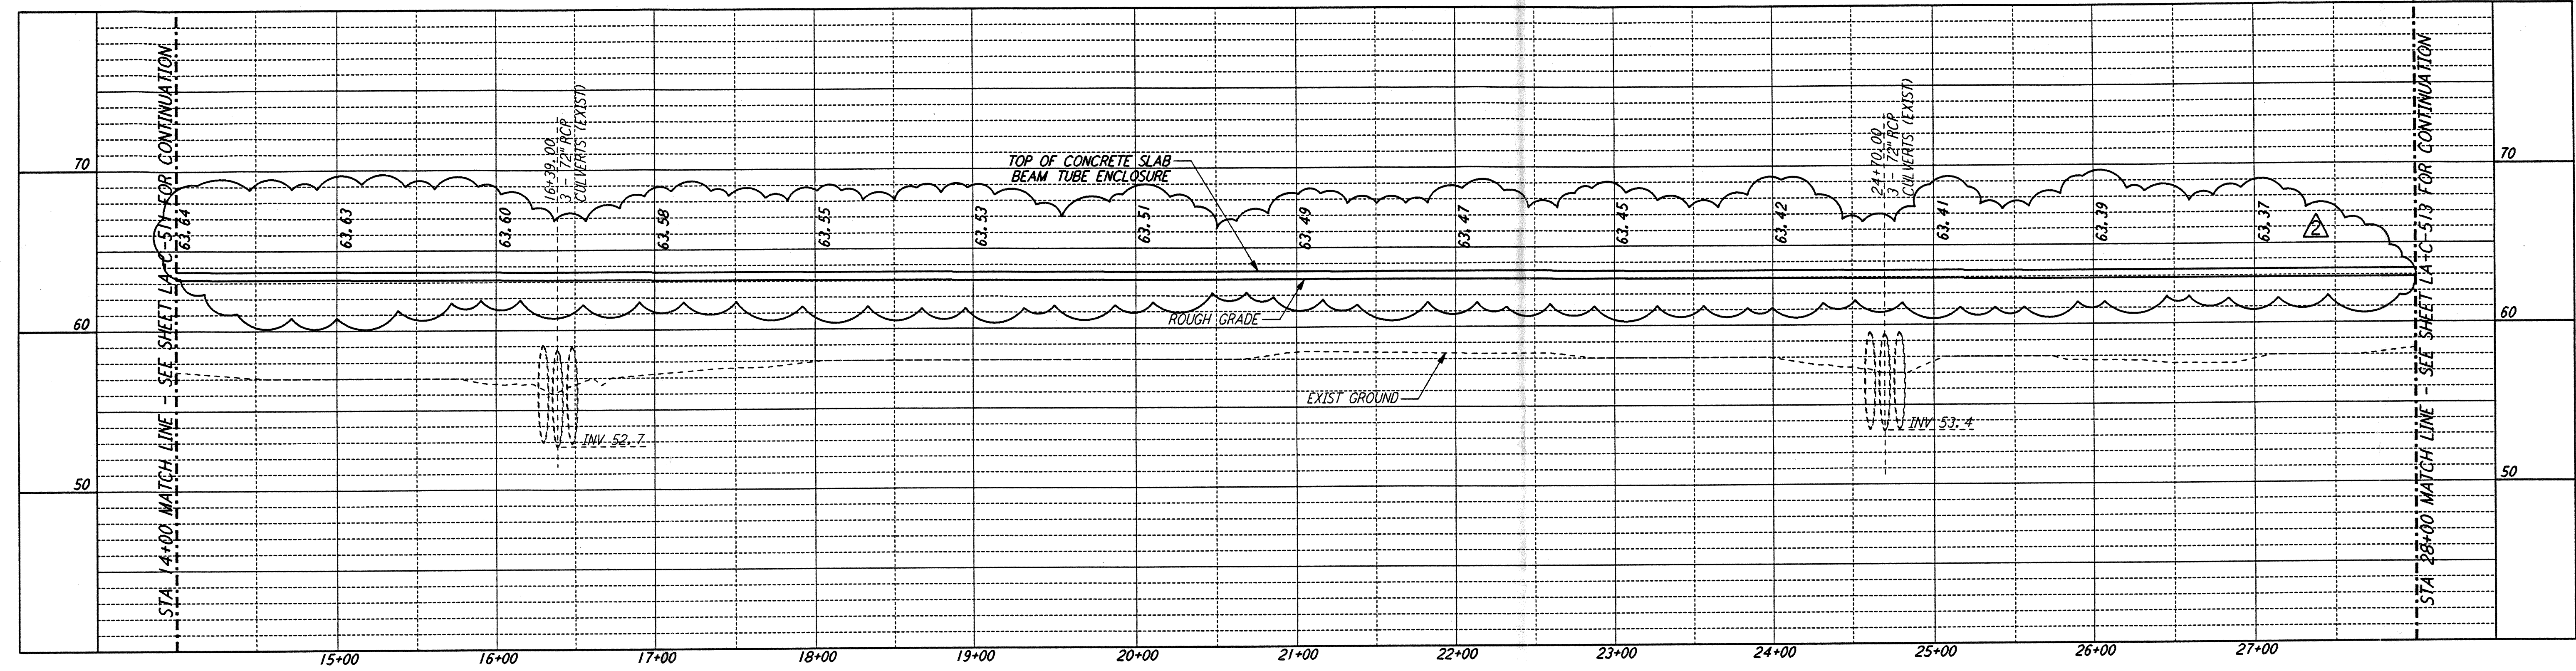


PROFILE  
SCALE: HORIZ: 1" = 50'  
VERT: 1" = 5'

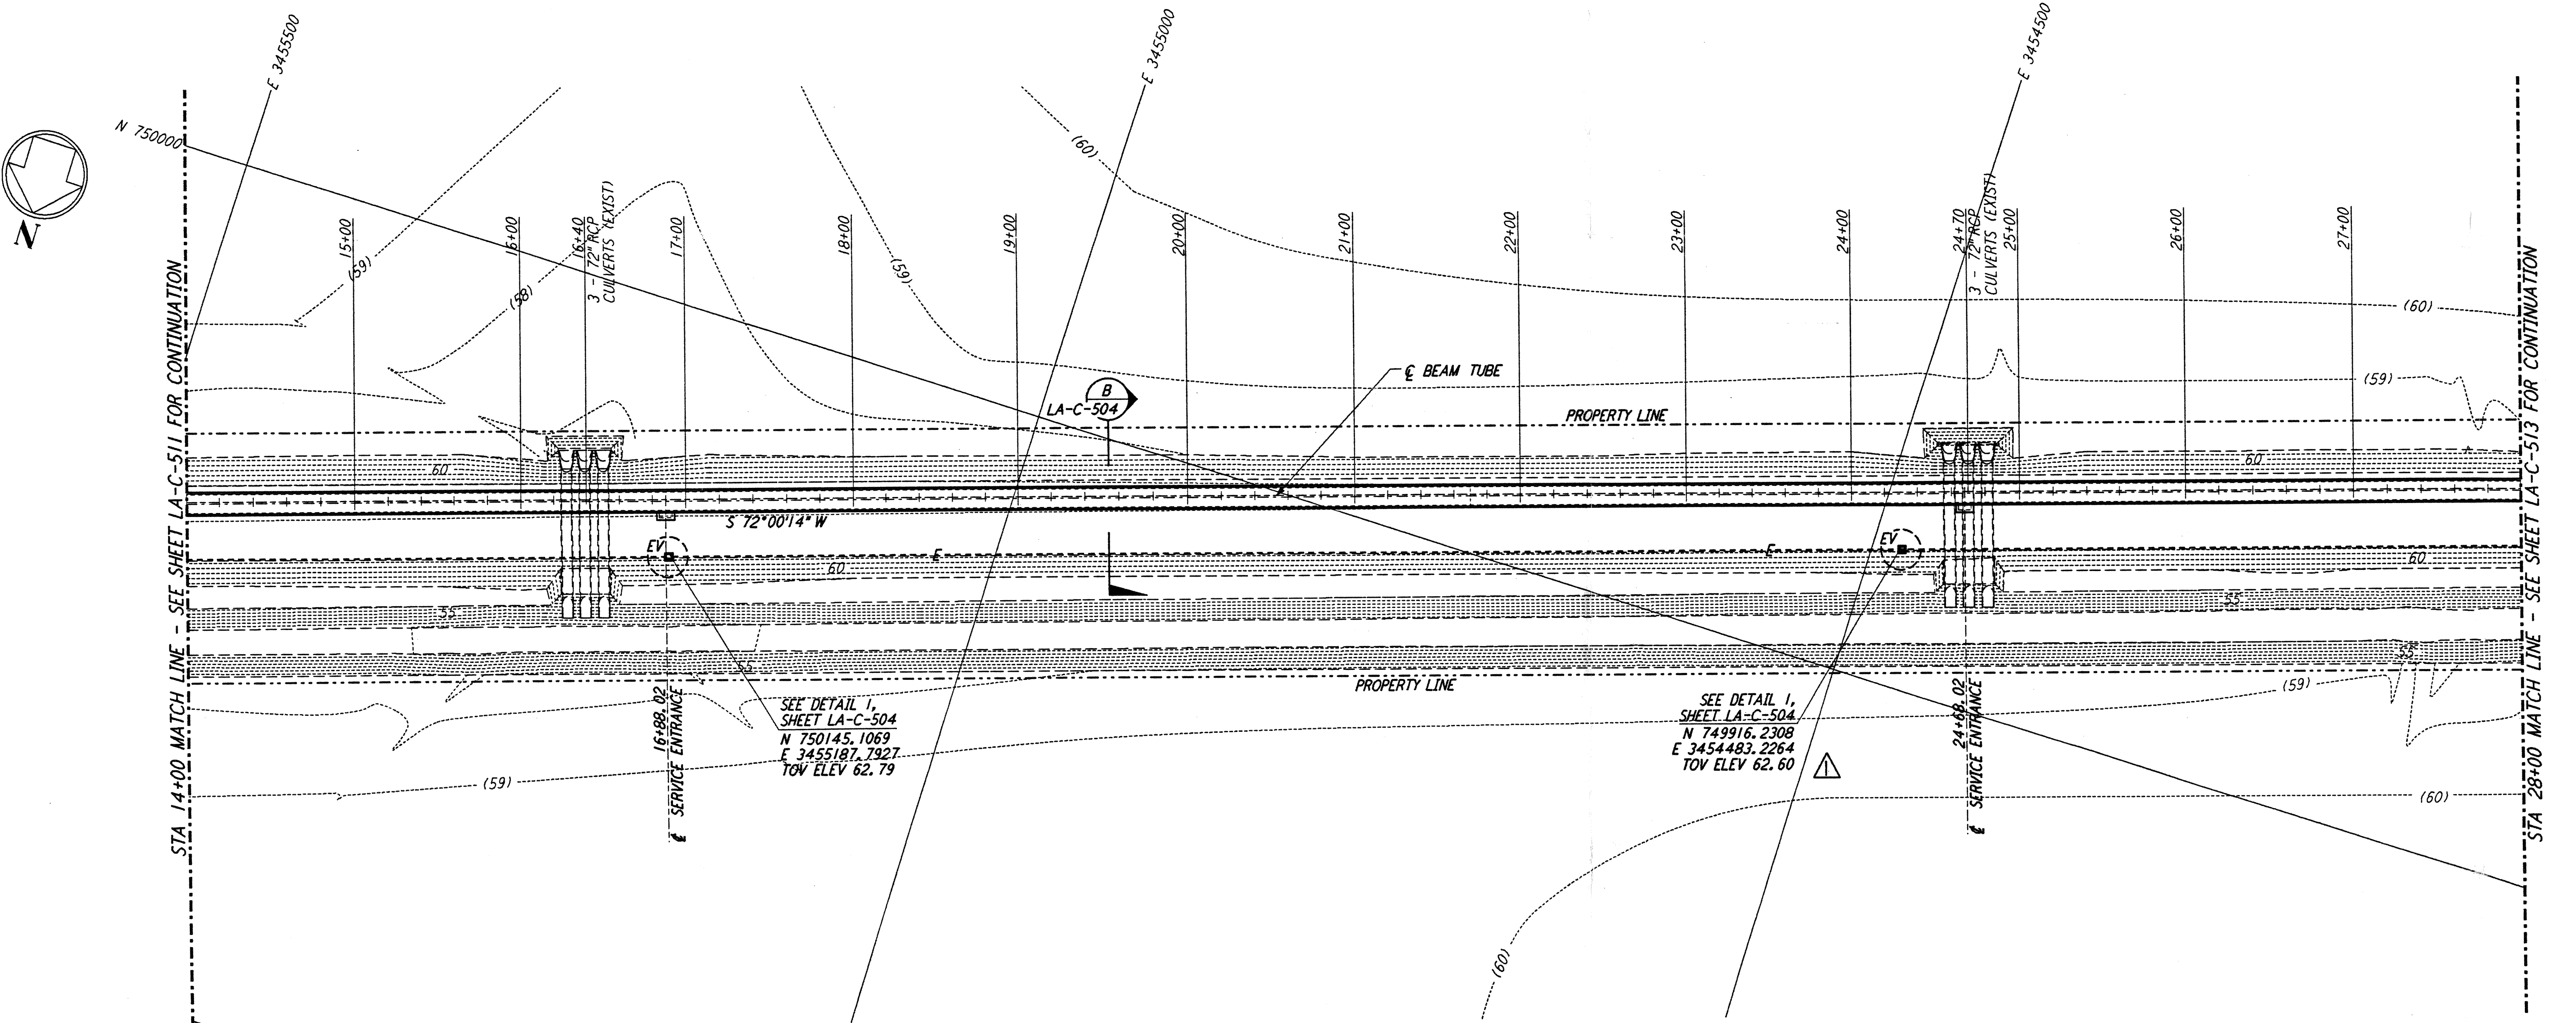


PLAN  
SCALE: 1" = 50'

- NOTES:
- SEE SHEET LA-C-502 FOR GENERAL NOTES, LEGEND AND ABBREVIATIONS.
  - SEE SHEET LA-C-504 FOR TYPICAL SECTIONS AND DETAILS.

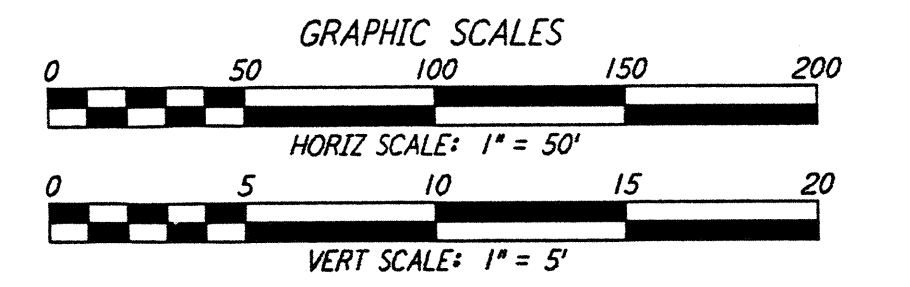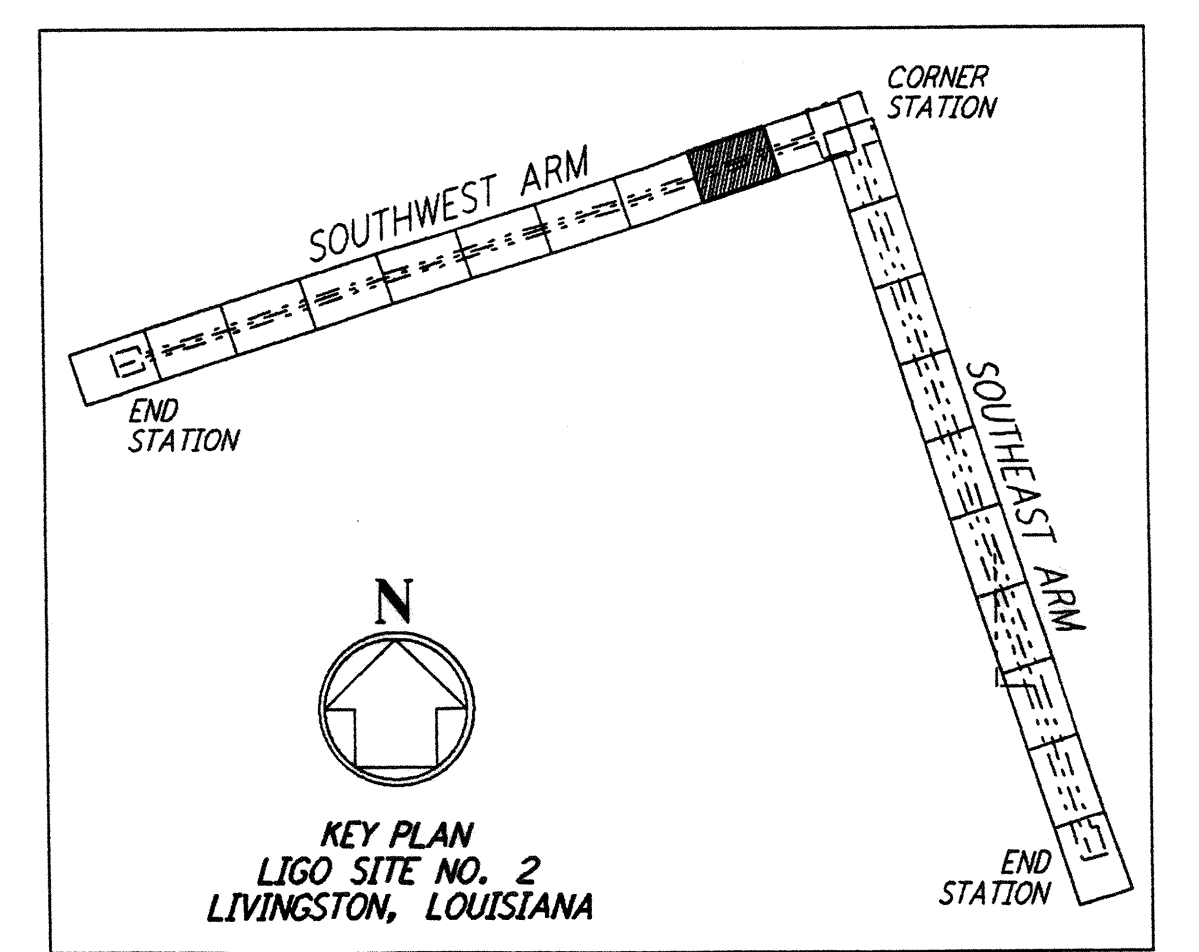

NO.	DATE	BY	CHKD	ENGR	PROJ	DESCRIPTION
2	2-3-97	WRB	CL	JB	TDM	REVISED PROFILE ELEVATIONS
1	1-13-97	WRB	JB	JB	TDM	AS-BUILT CULVERTS, REVISED ELEC VAULT

ISSUED FOR CONSTRUCTION			
DRAWN	WRB	11-15-96	
CHECKED	ML	11-15-96	
ENGINEER	JB	11-15-96	
PROJ	TDM	11-15-96	

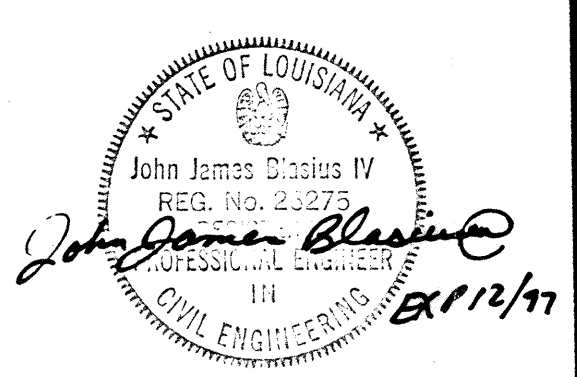

**PARSONS**  
100 WEST WALNUT STREET  
PASADENA, CALIFORNIA

**LIGO**  
CALIFORNIA INSTITUTE OF TECHNOLOGY  
MASSACHUSETTS INSTITUTE OF TECHNOLOGY

LASER INTERFEROMETER  
GRAVITATIONAL-WAVE OBSERVATORY  
BEAM TUBE ENCLOSURE - LIVINGSTON, LA

CIVIL  
SOUTHWEST ARM  
PLAN AND PROFILE  
STA 14+00 TO STA 28+00

SCALE: AS NOTED  
CONTRACT NUMBER: PPI50969  
PROJECT NUMBER: 8094

SHEET NUMBER: **LA-C-512**