




NOTES:

- 1. SEE SHEET LA-C-502 FOR GENERAL NOTES, LEGEND AND ABBREVIATIONS.
- 2. SEE SHEET LA-C-504 FOR TYPICAL SECTIONS AND DETAILS.

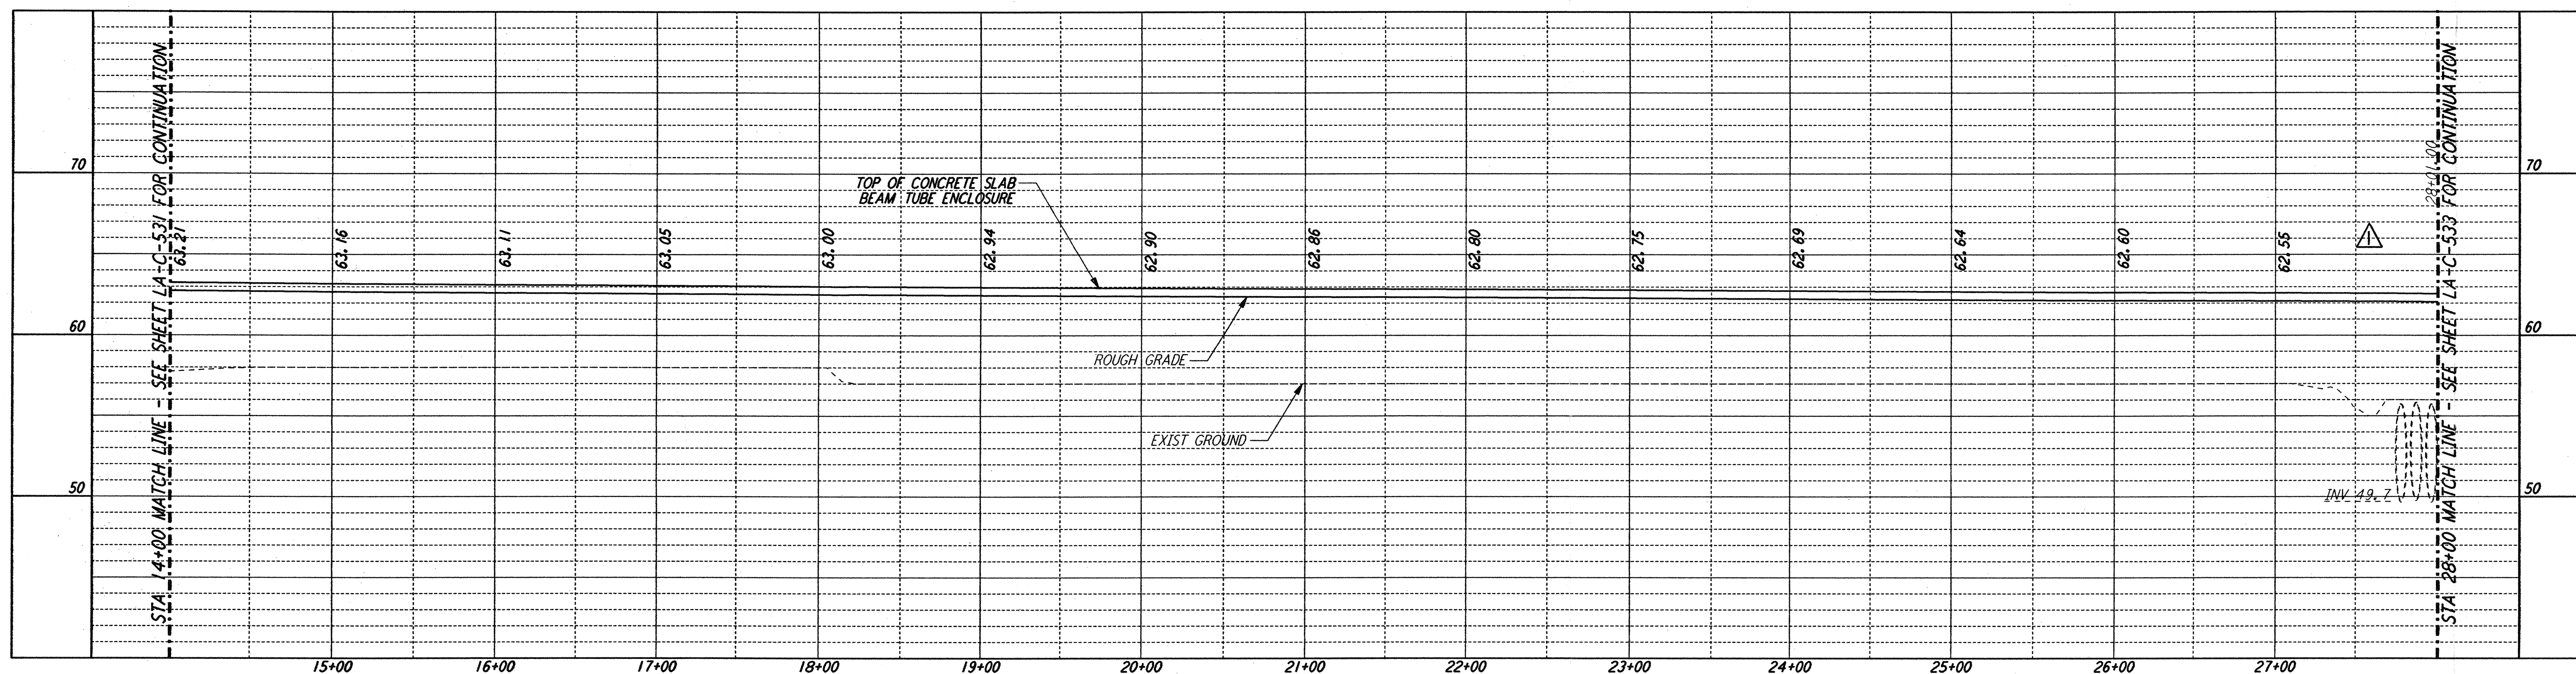


PROFILE

SCALE: HORIZ: 1" = 50'
VERT: 1" = 5'

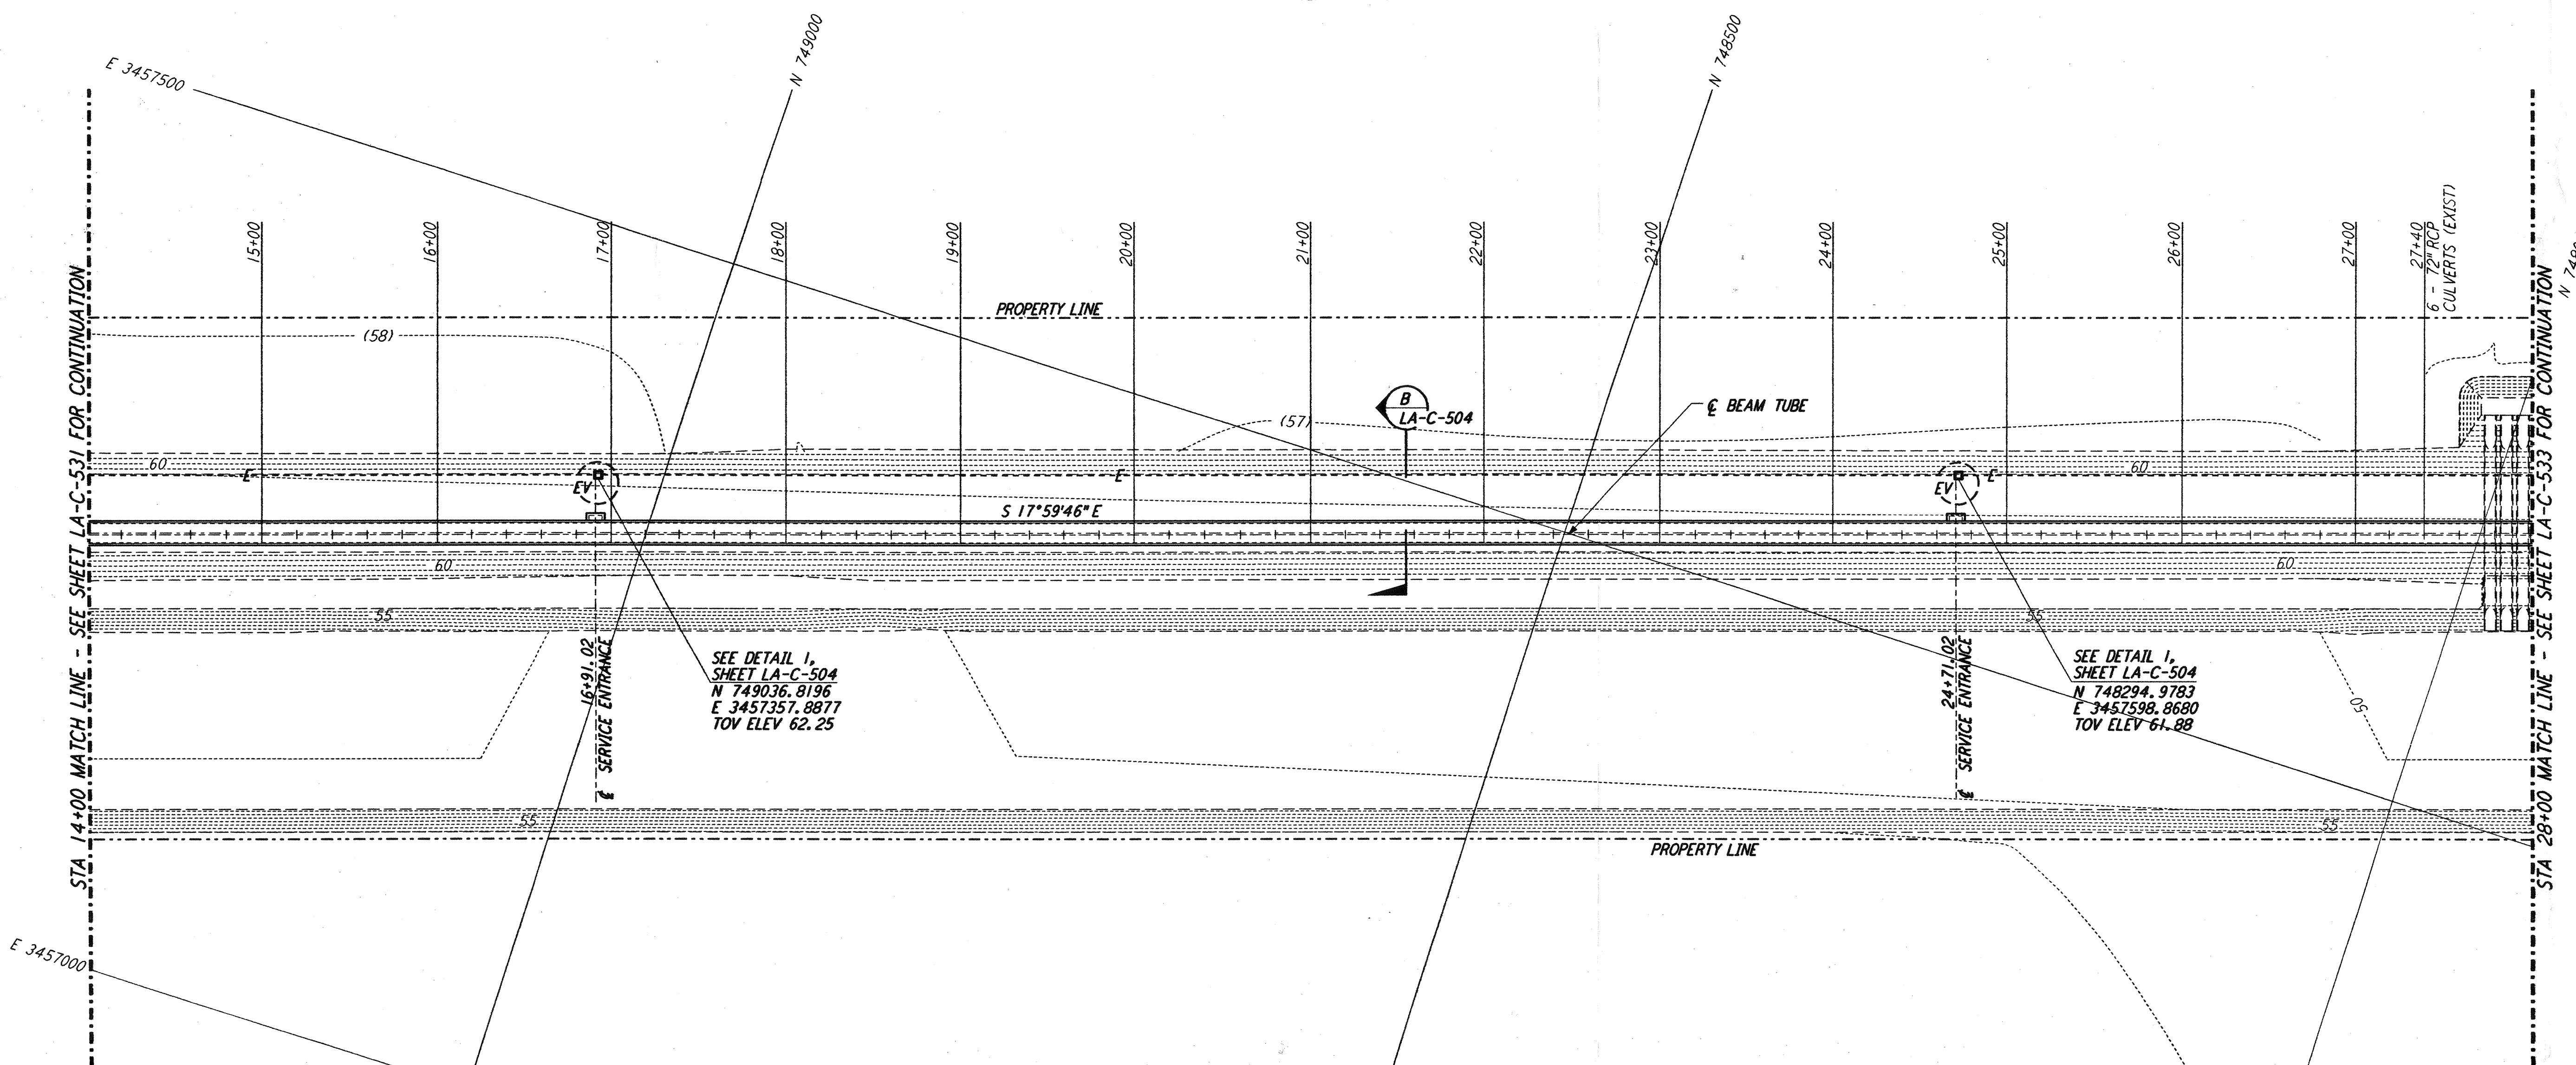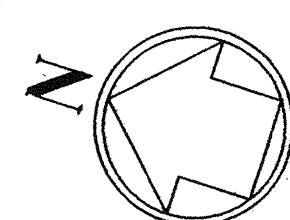


PLAN

SCALE: 1" = 50'

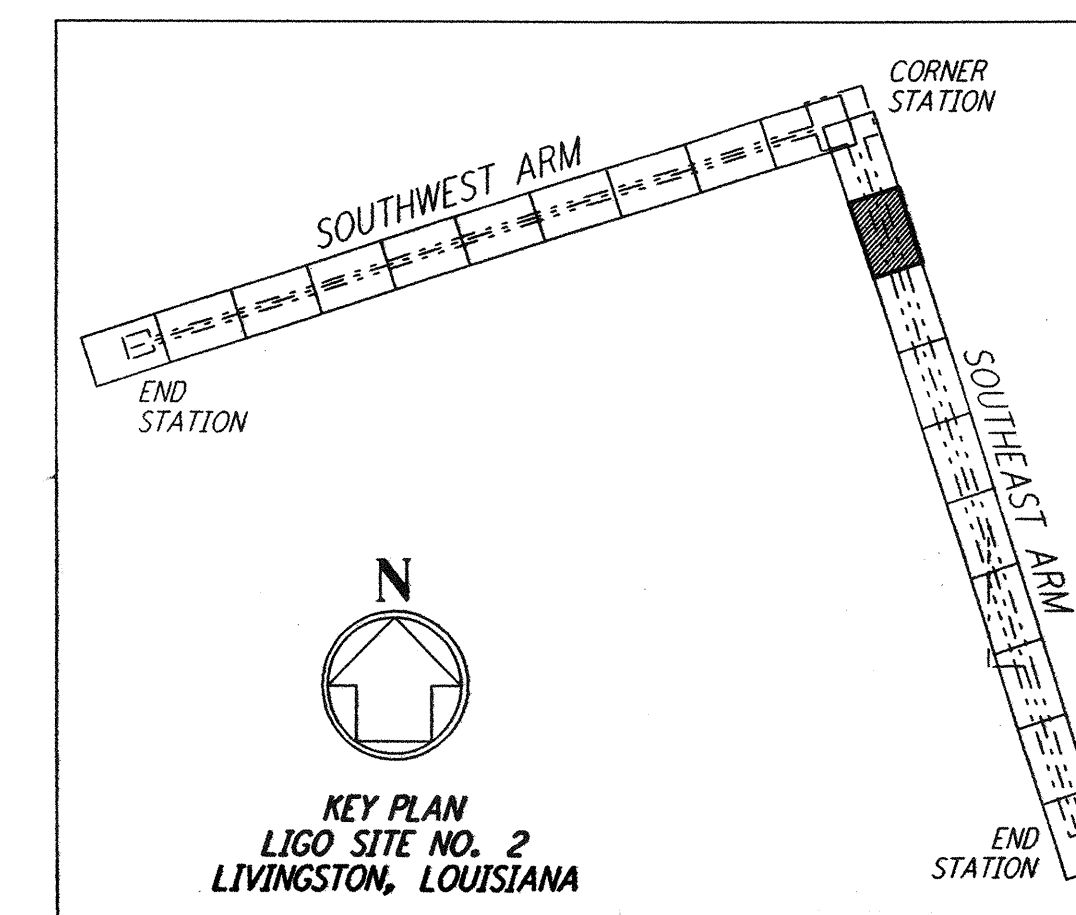

LIGO-D961277-02-O

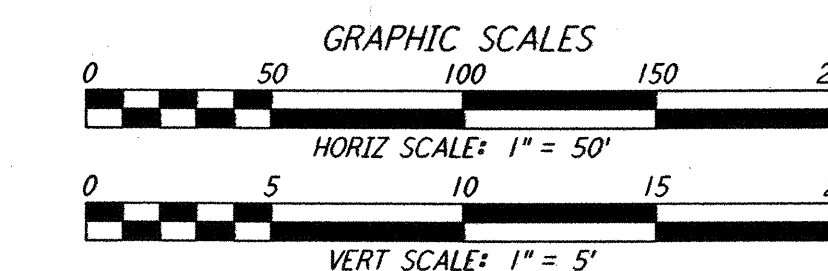

This document and the design it covers are the property of PARSONS. They are loaned only with the borrower's expressed written agreement that they will not be reproduced, copied, loaned, exhibited, or used in any other way, except by written consent from PARSONS to the borrower.

This document and the design it covers are the property of PARSONS. They are loaned only with the borrower's expressed written agreement that they will not be reproduced, copied, loaned, exhibited, or used in any other way, except by written consent from PARSONS to the borrower.

NO.	DATE	BY	CHKD	ENGR	PROJ	DESCRIPTION
2	1-15-99	MEI	--	--	MDW	ISSUED FOR AS BUILT
1	2-3-97	WRB	--	--		REVISED PROFILE ELEVATIONS

ISSUED FOR CONSTRUCTION		
DRAWN	WRB	11-15-96
CHECKED	ML	11-15-96
ENGINEER	JB	11-15-96
PROJ	TDM	11-15-96

AS-BUILT DRAWINGS

100 WEST WALNUT STREET
PASADENA, CALIFORNIA

CALIFORNIA INSTITUTE OF TECHNOLOGY
MASSACHUSETTS INSTITUTE OF TECHNOLOGY

LASER INTERFEROMETER
GRAVITATIONAL-WAVE OBSERVATORY
BEAM TUBE ENCLOSURE - LIVINGSTON, LA

CIVIL
SOUTHWEST ARM
PLAN AND PROFILE
STA 14+00 TO STA 28+00

SCALE: CONTRACT NUMBER: PROJECT NUMBER:
AS NOTED PPI50969 8094

SHEET NUMBER: REVISION:
LA-C-532 2