




- NOTES:**
- SEE SHEET LA-C-502 FOR GENERAL NOTES, LEGEND AND ABBREVIATIONS.
 - SEE SHEET LA-C-504 FOR TYPICAL SECTIONS AND DETAILS.
 - ALL GRADES, DIMENSIONS AND ELEVATIONS SHOWN FOR THE TEMPORARY ACCESS ROAD ARE APPROXIMATE, PENDING FINAL LOCATION IN THE FIELD.

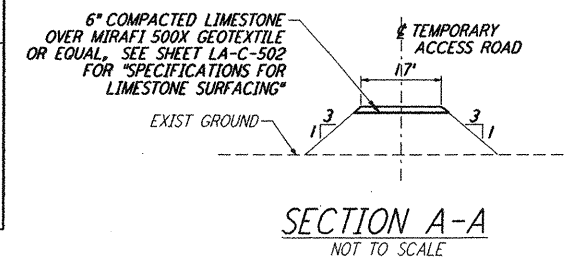


PROFILE
 SCALES: HORIZ: 1" = 50'
 VERT: 1" = 5'

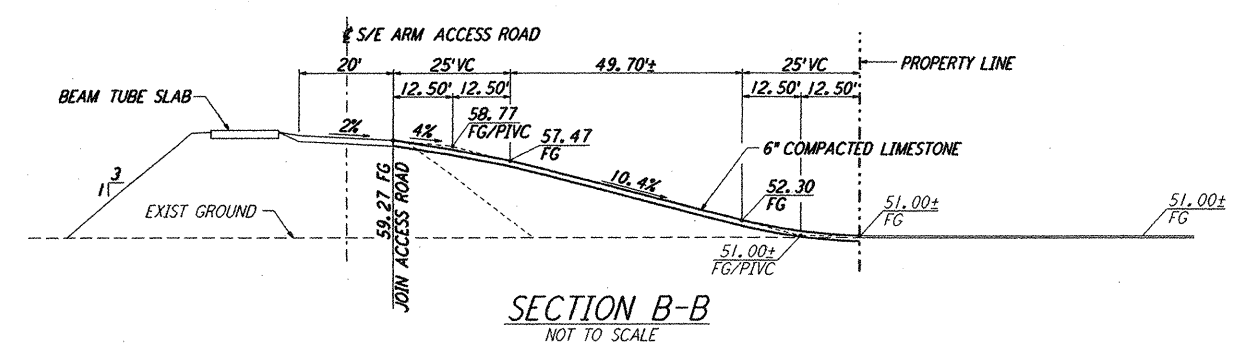


SECTION B-B
 NOT TO SCALE

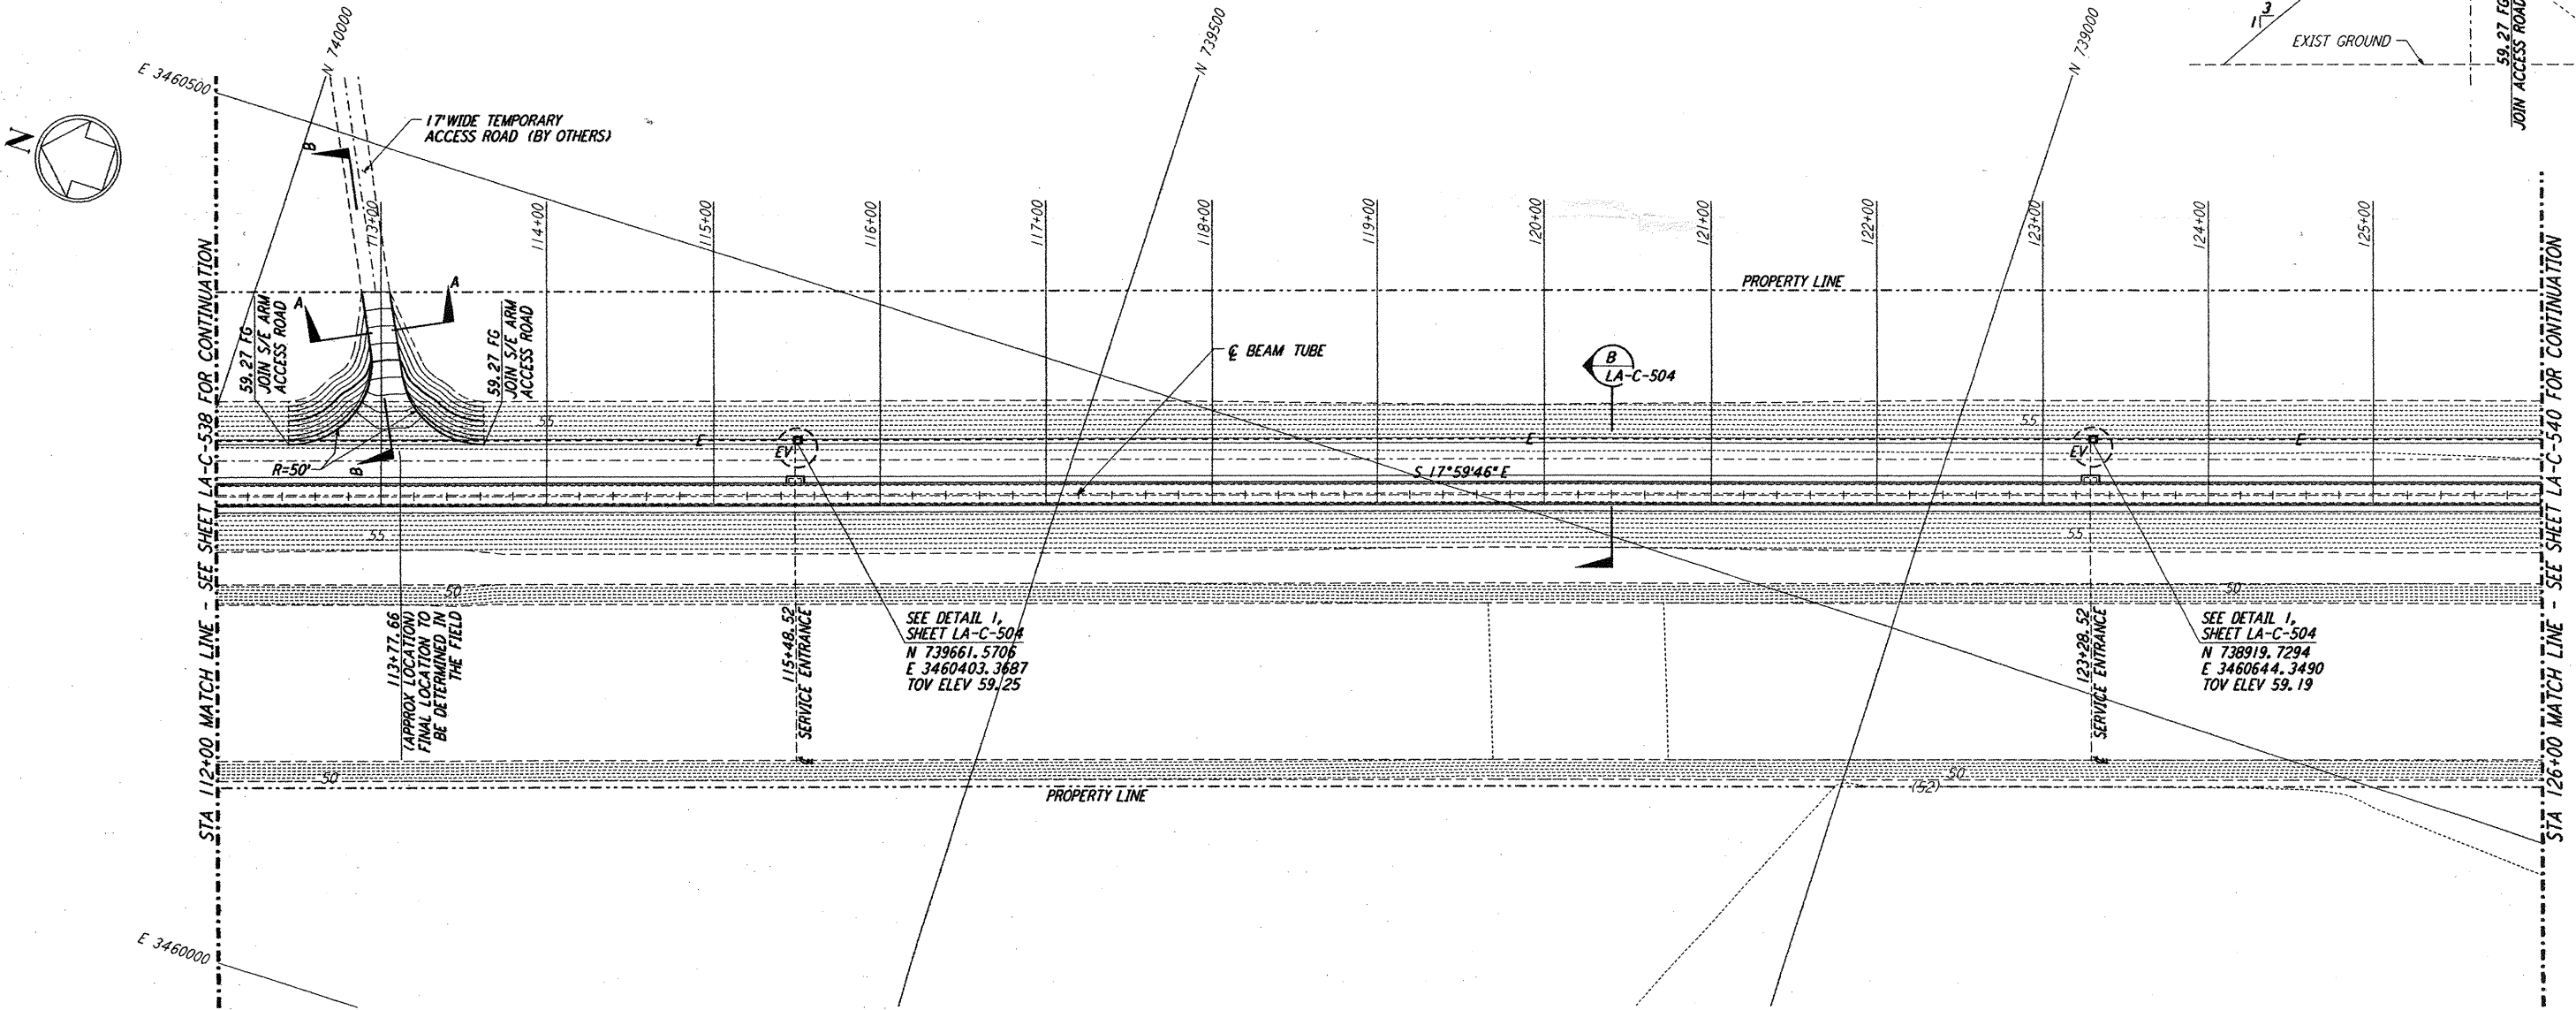

PLAN
 SCALE: 1" = 50'

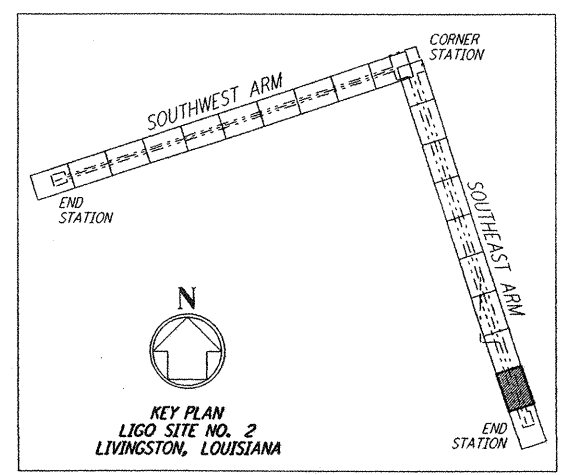

LIGO-D961284-02-O

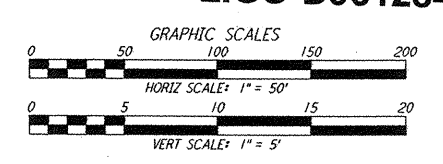

NO.	DATE	BY	CHKD	ENGR	PRJ	DESCRIPTION
2	1-15-99	MET	--	--	MDW	ISSUED FOR AS-BUILT
1	2-3-97	WRB				REVISED PROFILE ELEVATIONS

ISSUED FOR CONSTRUCTION		
DRAWN	WRB	11-15-96
CHECKED	ML	11-15-96
ENGINEER	JB	11-15-96
PROJ	TDM	11-15-96

AS-BUILT DRAWINGS

PARSONS
 100 WEST WALNUT STREET
 PASADENA, CALIFORNIA

LIGO
 CALIFORNIA INSTITUTE OF TECHNOLOGY
 MASSACHUSETTS INSTITUTE OF TECHNOLOGY

LASER INTERFEROMETER
 GRAVITATIONAL-WAVE OBSERVATORY
 BEAM TUBE ENCLOSURE - LIVINGSTON, LA

TITLE: CIVIL
 SHEET NUMBER: AS NOTED
 CONTRACT NUMBER: PP150969
 PROJECT NUMBER: 8094

LA-C-539

not be reproduced, copied, loaned, exhibited, or used in any other way, except by written consent from PARSONS to the borrower.

This document and the design it covers are the property of PARSONS. They are loaned only with the borrower's expressed written agreement that they will

7:1 Jan 15 12:41:14 1999 C:\PLOT\JOBES\3-9862\ACF\B2085E.K\Y1862\c45391.dwg LIGOLF3.BOR