


This document and the design it covers are the property of PARSONS. They are loaned only with the borrower's expressed written agreement that they will not be reproduced, copied, loaned, exhibited, or used in any other way, except by written consent from PARSONS to the borrower.

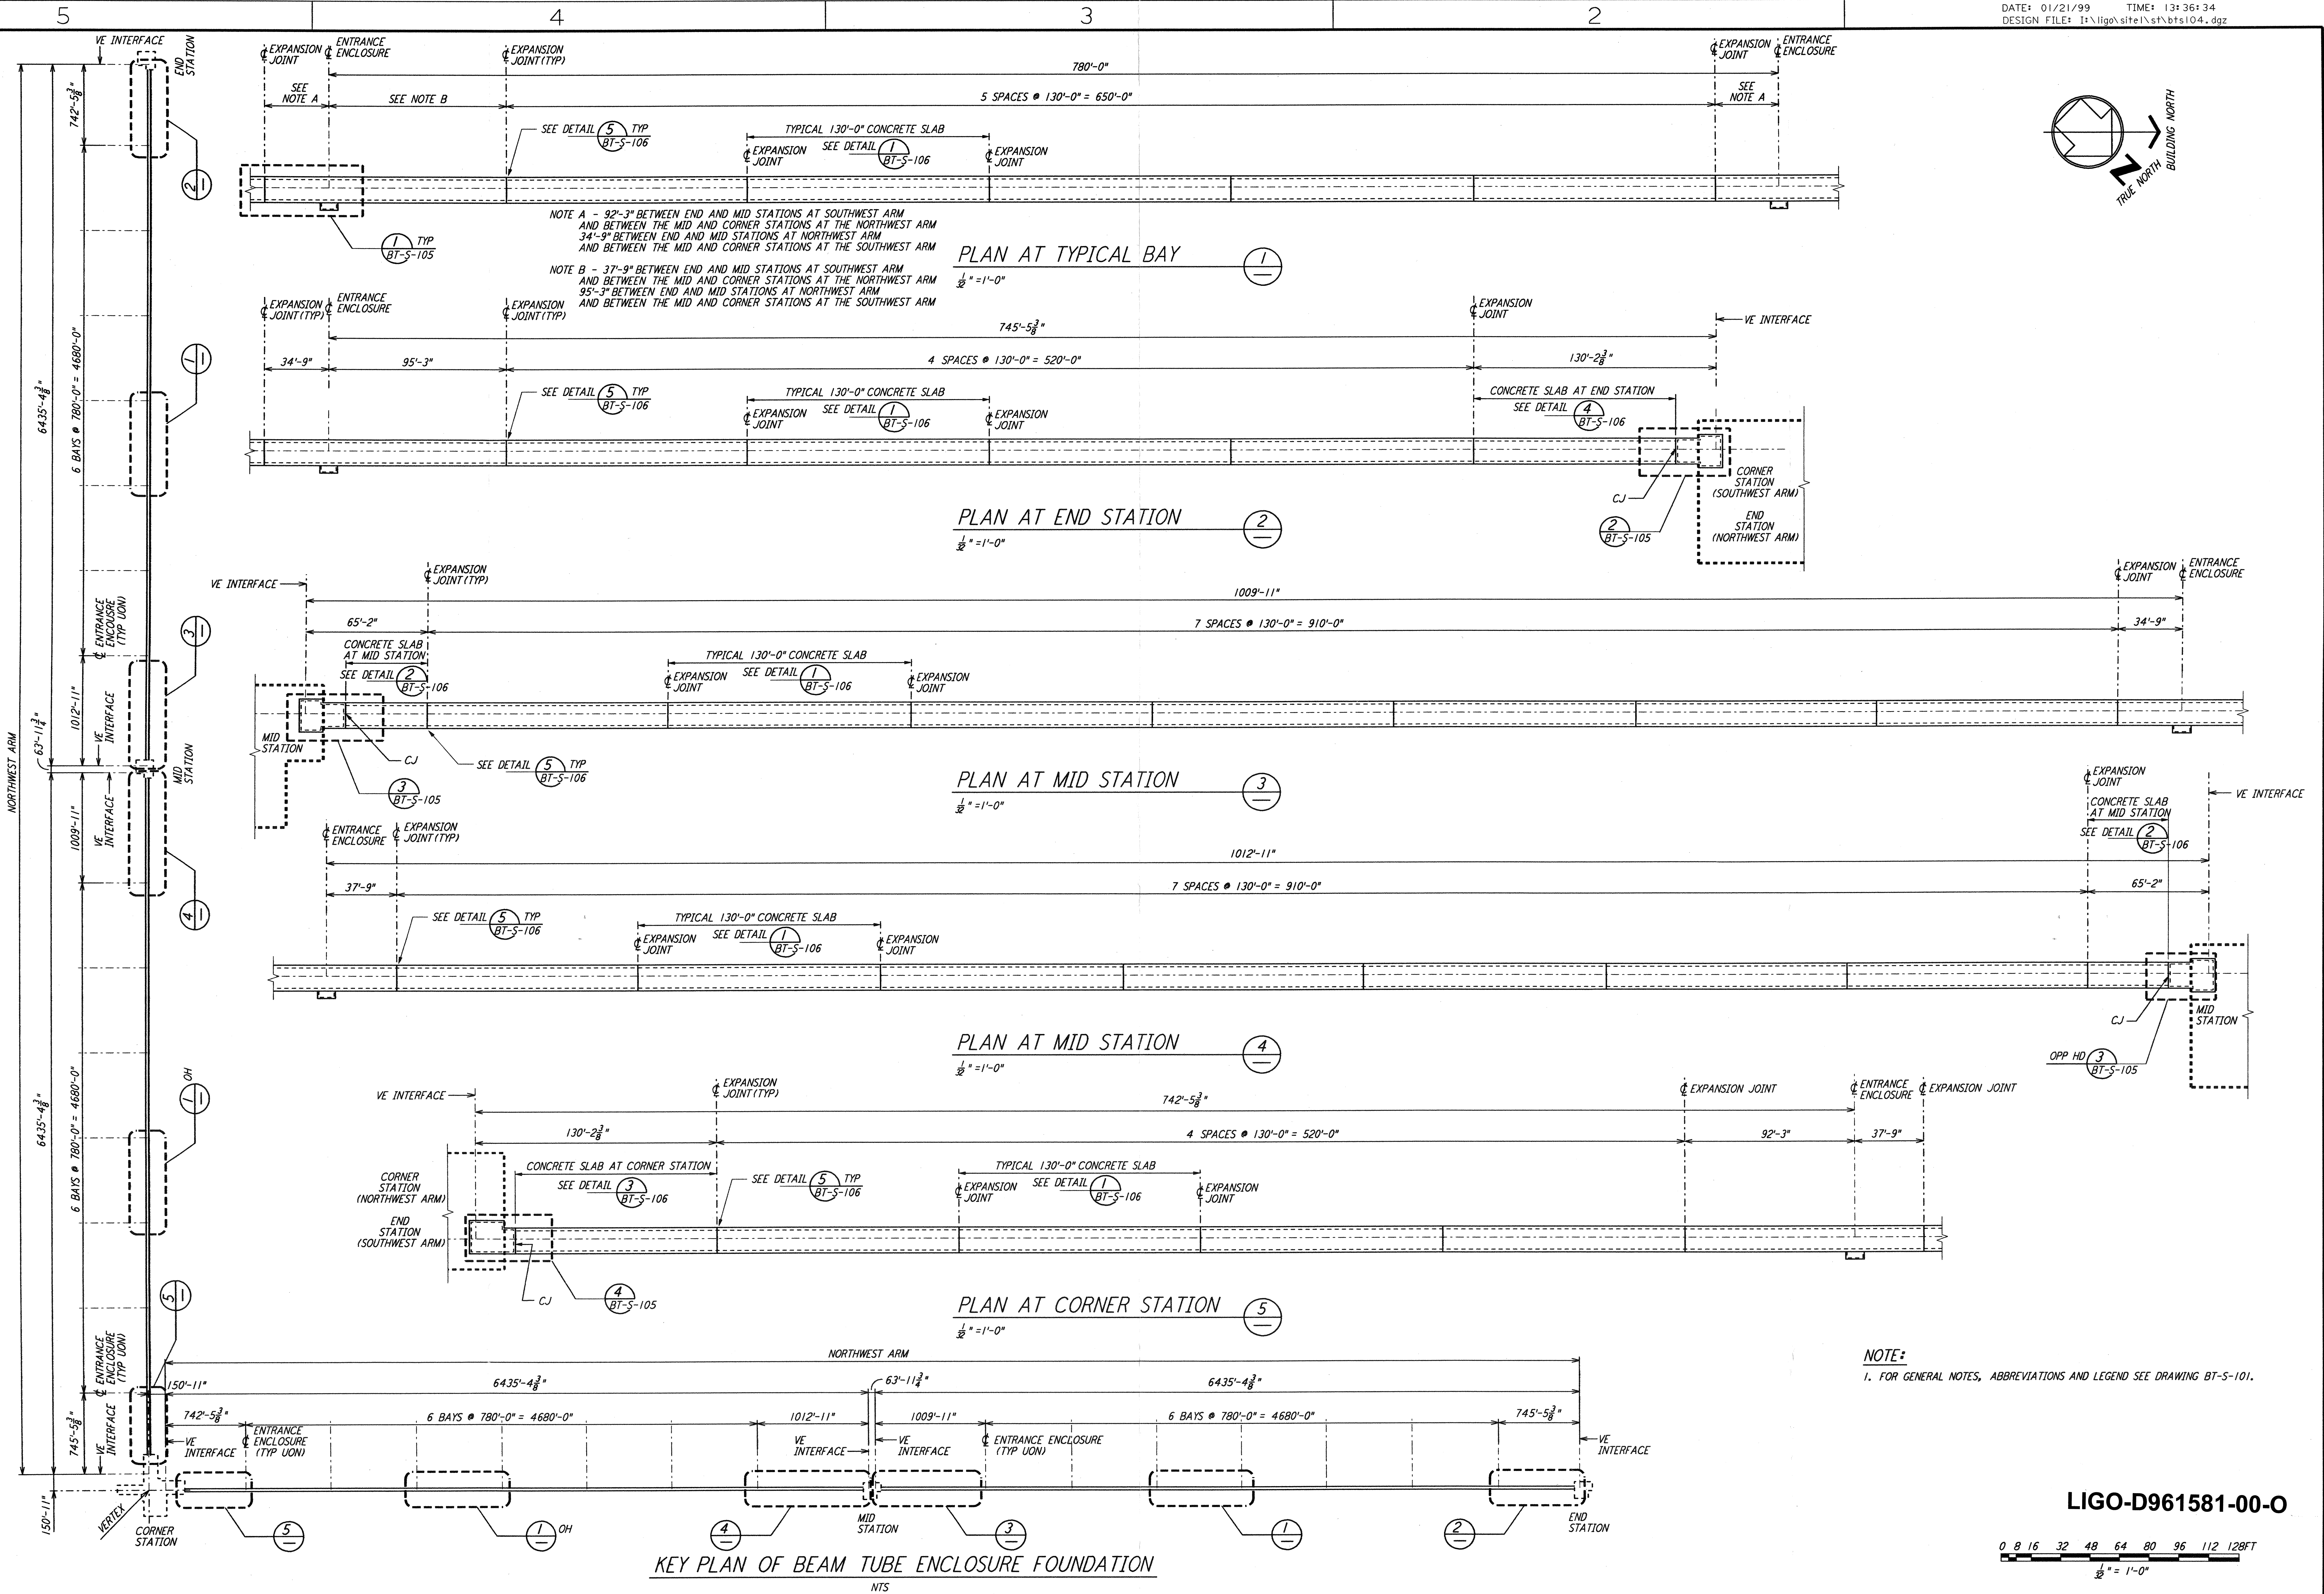

NOTE:
 1. FOR GENERAL NOTES, ABBREVIATIONS AND LEGEND SEE DRAWING BT-S-101.

LIGO-D961581-00-0
 0 8 16 32 48 64 80 96 112 128 FT
 1/2" = 1'-0"

NO.	DATE	BY	CHKD	ENGR	PROJ	DESCRIPTION
0	1-22-99	MEI	--	--	MDW	ISSUED FOR AS BUILT
A	5-10-96	MCS	--	--	MDW	ISSUED FOR BID

AS-BUILT DRAWINGS

DRAWN: SH
 CHECKED: []
 ENGINEER: []
 PROJ: []

PARSONS
 100 WEST WALNUT STREET
 PASADENA, CALIFORNIA

LIGO
 CALIFORNIA INSTITUTE OF TECHNOLOGY
 MASSACHUSETTS INSTITUTE OF TECHNOLOGY

LASER INTERFEROMETER
 GRAVITATIONAL-WAVE OBSERVATORY
 BTE INSTALLATION - HANFORD, WA

SCALE: AS NOTED
 CONTRACT NUMBER: PPI50969
 PROJECT NUMBER: 8094

SHEET NUMBER: **BT-S-104**

Thu Jan 21 13:26:12 1999 G:\PLOT\JOB\53-V\3682.DWG 52085 KA\3682-4104b.prf LIGOBTF.BDR