


REV	DESCRIPTION	APPROVED	DATE
A	RELEASED		
B	CHANGED TITLE TO TUBE, BEARING HOUSING; DELETED GROOVE; 6.00/5.99 DIA WAS 6.00/5.94 DIA; DELETED ITEM #2. ADDED .63 DIA HOLE	A.J.L	9/7/96
C	ADDED C'BORES FOR EASE OF BEARING INSTALLATION	A.J.L	9/30/96

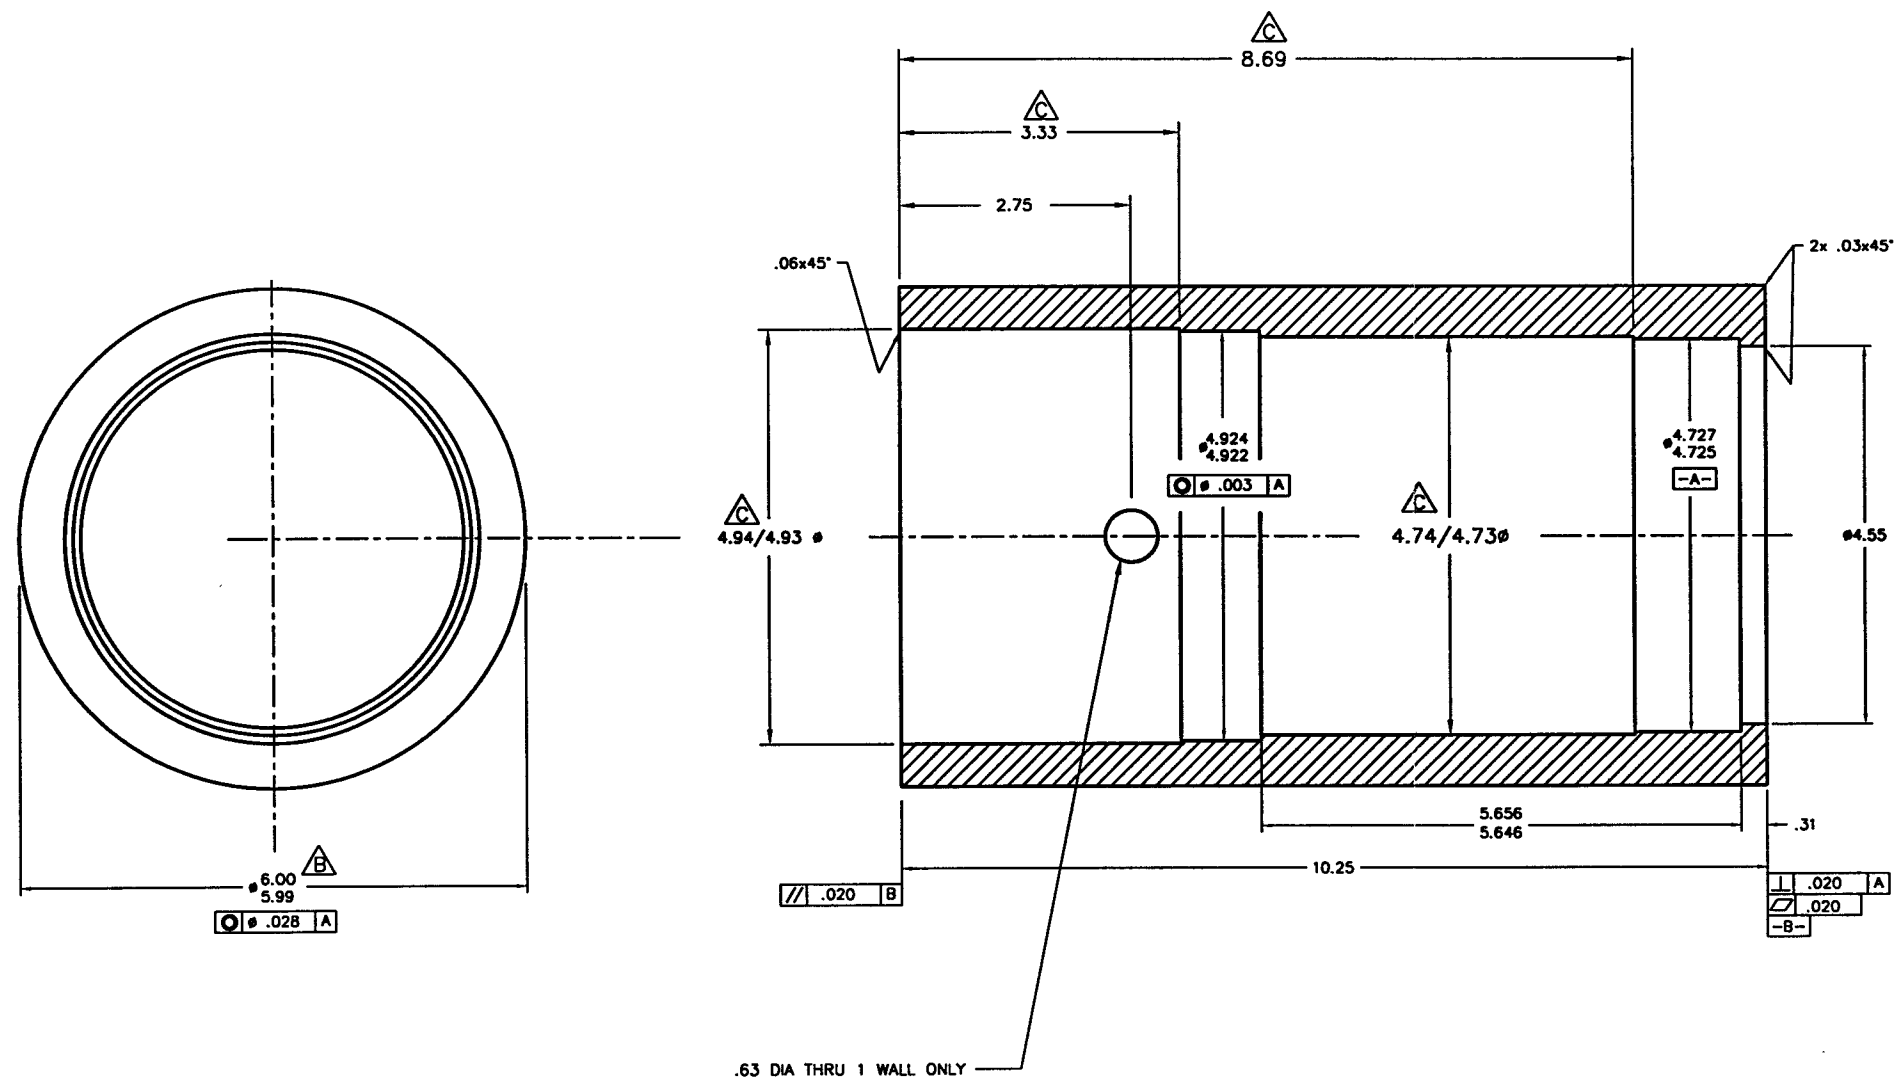

DWG # V049-8-548
MGO-D961664-C-V

DEC 19 1996

ITEM	QTY.	PART NO.	DESCRIPTION
PART LIST			MATERIAL SPECIFICATION 304 SST
UNLESS OTHERWISE SPECIFIED DIMENSIONS ARE IN INCHES TOLERANCES ARE:		CONTRACT OR SALES ORDER NO.	GNB Corporation SCIENTIFIC AND INDUSTRIAL EQUIPMENT 30971 San Benito Court HAYWARD, CALIFORNIA 94544 (510) 441-1900 FAX: (510) 441-0939
DECIMALS	ANGLES	FINISH	
.XX ± .01 ± 10'	12 1/2	12 1/2	
.XXX ± .005			
//, □, ⊥ WITHIN .05		APPROX. WT. 30#	
UNSPECIFIED FILLETS: R.015 BREAK EDGES .010 ± 45° REMOVE ALL BURRS		APPROVALS DATE	
THIRD ANGLE PROJECTION		DRAFTER	
		CHECKER	
C103303	DO NOT SCALE DRAWING	ENGINEER ZH	2-13-96
USED ON	CADD FILE NAME C103737C	TITLE TUBE, BEARING HOUSING G44E, G48E	
		SCALE: NONE	DWG. NO. 103737
		SHEET 1	OF 1
			REV. C