


NOTE:
 1. FOR GENERAL NOTES, ABBREVIATIONS AND LEGEND SEE DRAWING LA-S-501.

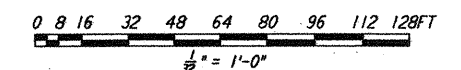

LIGO-D970101-01-0

NO.	DATE	BY	CHKD	ENGR	PROJ	DESCRIPTION
1	1-15-99	MEI	--	--	MDW	ISSUED FOR AS BUILT

ISSUED FOR CONSTRUCTION
 DRAWN: GGP 02-28-97
 CHECKED:
 ENGINEER:
 PROJ:

AS-BUILT DRAWINGS

PARSONS
 100 WEST WALNUT STREET
 PASADENA, CALIFORNIA

LIGO
 CALIFORNIA INSTITUTE OF TECHNOLOGY
 MASSACHUSETTS INSTITUTE OF TECHNOLOGY

LASER INTERFEROMETER
 GRAVITATIONAL-WAVE OBSERVATORY
 BEAM TUBE ENCLOSURE - LIVINGSTON, LA

TITLE: STRUCTURAL
 SHEET NUMBER: AS NOTED
 CONTRACT NUMBER: PP150969
 PROJECT NUMBER: 8094

LA-S-504A

This document and the design it covers are the property of PARSONS. They are loaned only with the borrower's expressed written agreement that they will not be reproduced, copied, loaned, exhibited, or used in any other way except by written consent from PARSONS to the borrower.

The Jan 14 1999 15:24:09 C:\PLOT\JOBES\33\B8E2\0F 82085 K:\V\882\1848.dwg LIC0LTF.BOR