



CALIFORNIA INSTITUTE OF TECHNOLOGY
 MASSACHUSETTS INSTITUTE OF TECHNOLOGY

DCN No. E990439-00-D

SHEET 1 OF 1

DOCUMENT CHANGE NOTICE (DCN)

DOCUMENT No. (DOC-REV-GP. ID)	TITLE	NEW REV.
D970618-A-D	Sensor/Actuator Spacer	B

CHANGE DESCRIPTION (FROM/TO): Change thickness from .12 to .06. Remove pin clearance holes and add one large clearance hole. Remove .06 from the bottom.

REASON FOR CHANGE: easier to machine

ACTION: Incorporate change Attach DCN to drawing(s) Other action (specify):


DISPOSITION OF HARDWARE (IDENTIFY SERIAL NUMBERS)	DCN DISTRIBUTION (X=incl. docs)
<input type="checkbox"/> No hardware affected (record change only)	Althouse Barish Coles
<input checked="" type="checkbox"/> List S/Ns which comply already: documenting as-built config. <i>All hardware to date built to Rev. B</i>	X Coyne Lazzarini Lindquist
<input type="checkbox"/> List S/Ns to be reworked or scrapped:	Raab Sanders Shoemaker
<input type="checkbox"/> List S/Ns to be built with this change:	Stapfer Tyler Weiss
<input type="checkbox"/> List S/Ns to be retested per this change:	Whitcomb Scislawitz
<input type="checkbox"/>	Bork Zucker
<input type="checkbox"/>	Barton Mason
<input type="checkbox"/>	Camp Jones
<input type="checkbox"/>	Fine
<input type="checkbox"/>	X Romie

SAFETY, COST, SCHEDULE, REQUIREMENTS IMPACT? No Yes (If yes, enter Change Request number)

APPROVALS:	DATE	OTHER APPROVALS (specify)	DATE
ORIGINATOR: J. Romie	12-6-99		
TASK LEADER: J. Romie	12-6-99		
GROUP LEADER: <i>J. Coyne</i>	<i>12/10/99</i>		
DCC RELEASE: <i>J. Romie</i>	<i>12-10-99</i>		

NOTES: (UNLESS OTHERWISE SPECIFIED)
 1. REMOVE ALL BURRS AND SHARP EDGES.
 2. MATERIAL: PRESHRUNK PFA 440HP.

REV	DATE	DRAWN BY	CHECKED	QCC	QCN/DESCRIPTION
A	6-4-99	J. Roubie			E990243/INITIAL RELEASE
B	7-6-99	J. Roubie			E990438/THICKNESS CHANGE

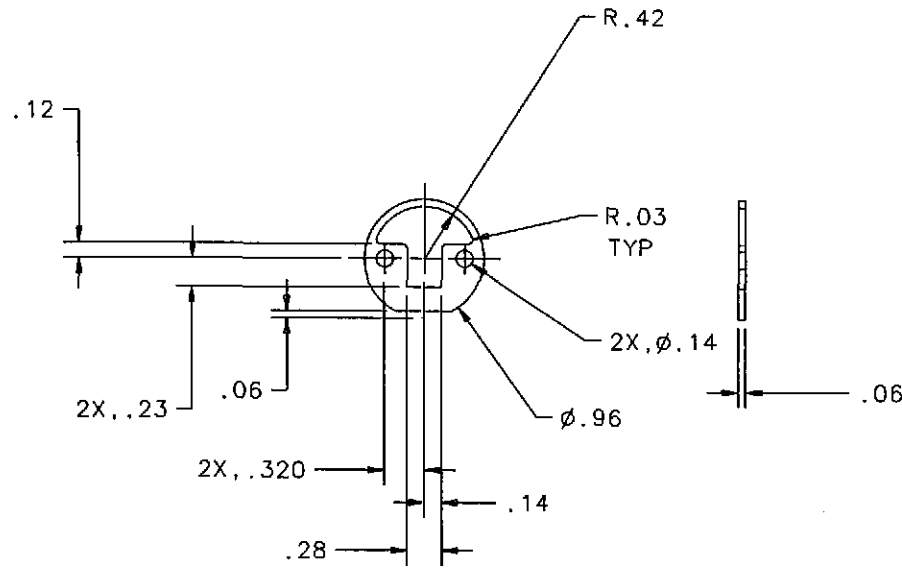

QTY REQD	PSCM NO	PART OR IDENTIFYING NO	NOMENCLATURE OR DESCRIPTION	MATERIAL SPECIFICATION	ITEM NO
PARTS LIST					
UNLESS OTHERWISE SPECIFIED DIMENSIONS ARE IN IN TOLERANCES ARE: FRACTIONS DECIMALS .XX = ±.02 .XXX = ±.003 DO NOT SCALE DRAWING		APPROVALS DRAWN J. HAZEL CHECKED		DATE 12/97	
MATERIAL SEE NOTES			LIGO CALIFORNIA INSTITUTE OF TECHNOLOGY MASSACHUSETTS INSTITUTE OF TECHNOLOGY		
FINISH NONE			TITLE SENSOR/ACTUATOR SPACER		
SCALE 1/1			SIZE B Dwg NO. D970618		REV B
FILENAME /home/scc/docs/D970618.pdf					SHEET 1 OF 1