

# H2 TMS Y QPD Sled

## - As Built -

Bram Slagmolen, Keita Kawabe,  
Matt Evans

**LIGO-T1100476**

# QPD Sled Telescopes

- The TMS/ISC Breadboard has two QPD sleds, one for IR and one for Green.
- Each sled, has a small Gouy phase beam reducing telescope to steer the beam onto the QPDs.
- The Gouy phase between the two QPDs needs to be close to 90 degrees (for a diagonal sensing matrix in the near- and far field).

# Mode-Matching Approach


- The sleds are assembled, and the telescope optics (2" lens and a 1" lens) are placed as illustrated in figures 8 and 10 in document [T1000247](#).
- The nominal location for L1 and L2 as listed in the tables 8 and 9 are used.
- For mode-matching measurements, the IR and GRN Laser Diode sources as per [T1100474](#) are used.
- The Coherence ModeMaster is used to measure the waist location and size behind the telescope.
- The location of L2 is adjusted to match the measured waist location and size as close as possible according to T1000247.

# Mode-Matching Validation

- Once the telescopes are aligned, a matlab model (alm) is used to validate the location of the QPDs with respect to the measured waist locations.
- This is done by adjusting the model (changing the distance between L1 and L2) such that the waist location is similar to the measured results (using the LD sources as input to the telescope).
- With these telescope settings and 'injected' the IFO arm cavity beam parameters (e.g. out of the TMS Telescope), adjust the location of the QPDs so the difference in Gouy Phase is nominal 90 degrees.

# IR QPD Sled /w LD Source


Adjusted the L2 location in the model until the output waist coincided with the measured waist location (Y-waist).

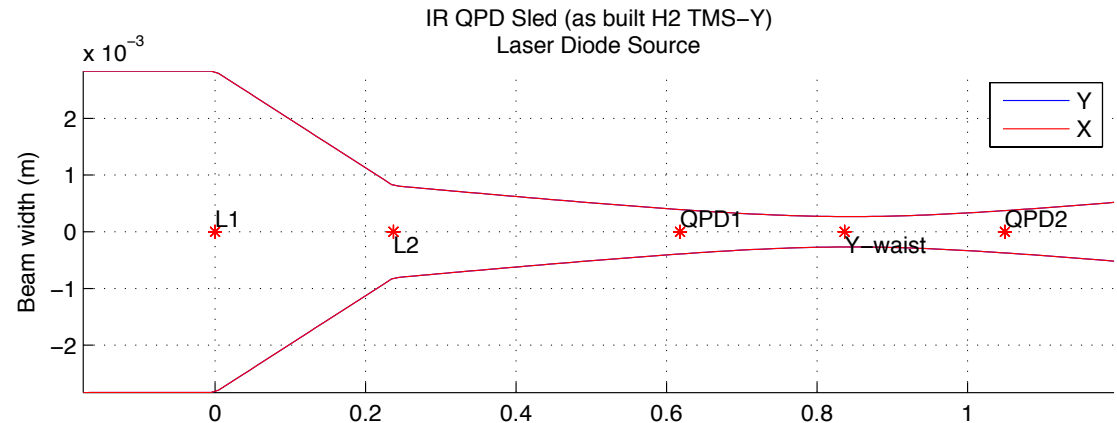

Waist location target: 0.80m  
(as per T1000247, table 8, fig 7)

Laser Diode Source  
modematching = 0.99412  
IRxpath.components list

Measured Parameters:  
(\* = adjusted z(m) parameter)

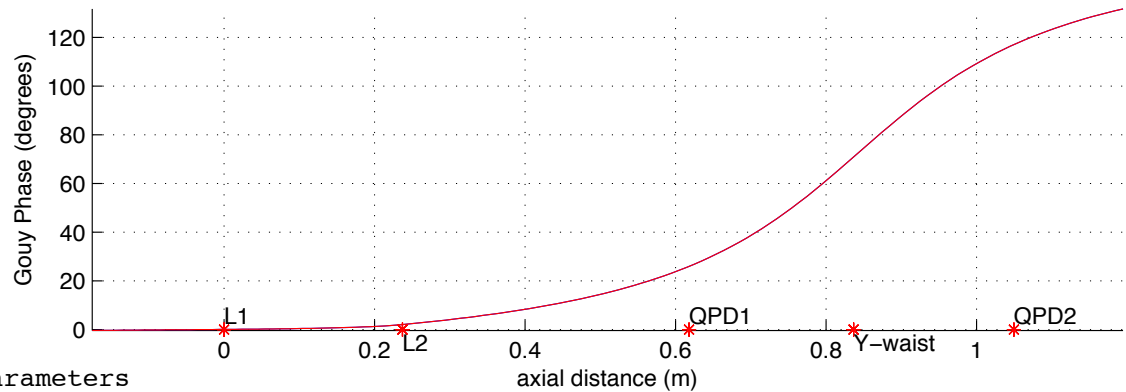

label	z (m)	type	parameters
-----	-----	-----	-----
L1	0	lens	focalLength: 0.3330
* L2	<b>0.2370</b>	lens	focalLength: -0.111
QPD1	0.6180	flat mirror	none:
Y-waist	0.8366	flat mirror	none:
QPD2	1.0498	flat mirror	none:

# IR QPD Sled /w IFO Beam (as-built)


Using the model to locate  
the QPDs.

IFO Arm Beam Parameters  
modematching = 0.96367  
IRxpath.components list

Modeled Parameters:  
(\* = adjusted z(m) parameter)

label	z (m)	type
L1	0	lens
L2	0.2370	lens
*QPD1	<b>0.6180</b>	flat mirror
Y-waist	0.8366	flat mirror
*QPD2	<b>1.0498</b>	flat mirror

Gouy Phase-x (QPD1): 20.0427  
Gouy Phase-y (QPD1): 20.0427  
Gouy Phase-x (QPD2): 109.0697  
Gouy Phase-y (QPD2): 109.0697

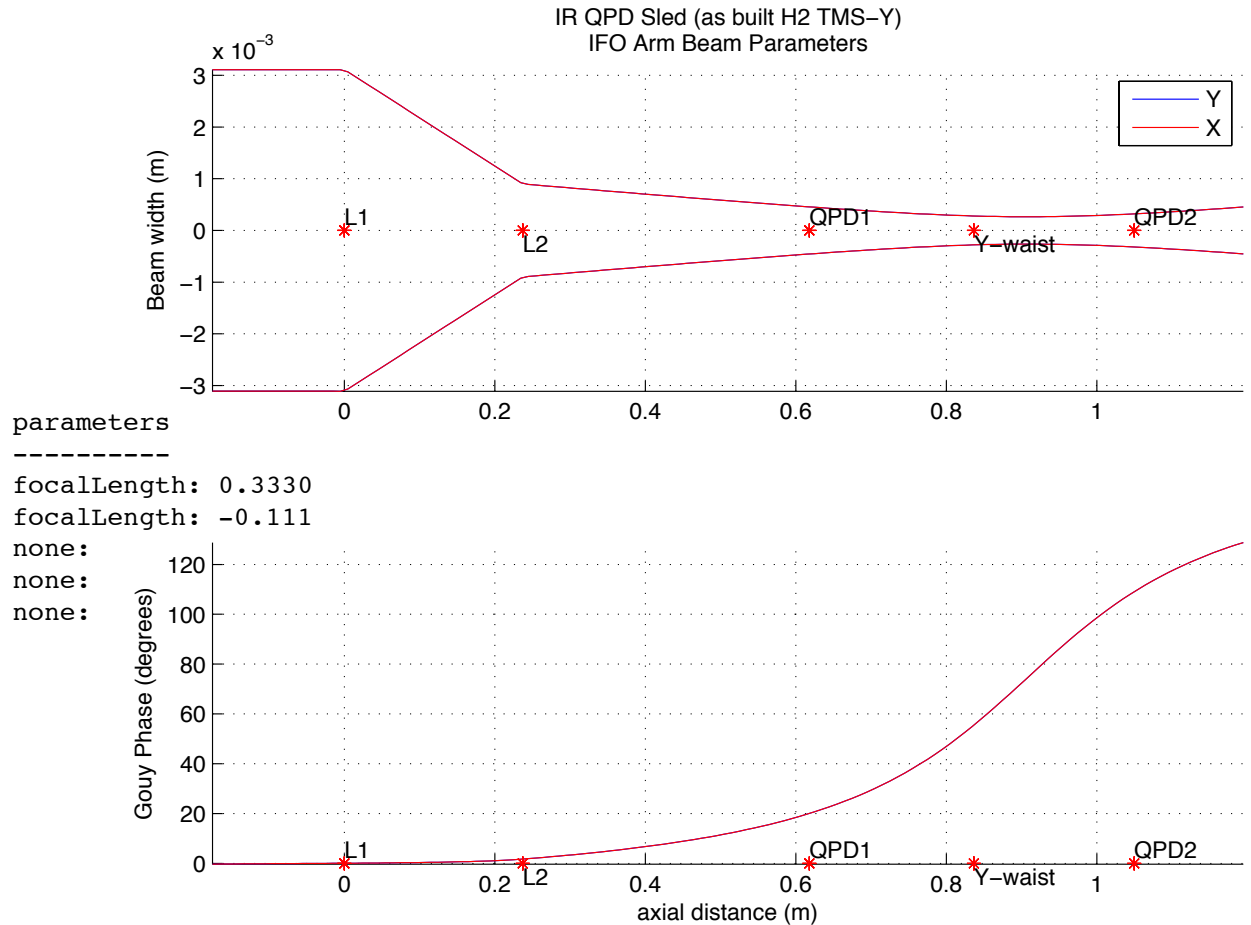

# GRN QPD Sled /w LD Source



Adjusted the L2 location in the model until the output waist coincided with the measured waist location (Y-waist).

Waist location target: 0.619m  
(as per T1000247, table 9, fig 9)

Laser Diode Source  
modematching = 0.94505  
GRNxpath.components list

Measured Parameters:  
(\* = adjusted z(m) parameter)

label	z (m)	type	parameters
L1	0	lens	focalLength: 0.3330
QPD1	0.2078	flat mirror	none:
* L2	<b>0.2840</b>	lens	focalLength: -0.056
Y-waist	0.5320	flat mirror	none:
L3	0.6650	lens	focalLength: -0.056
QPD2	0.7666	flat mirror	none:

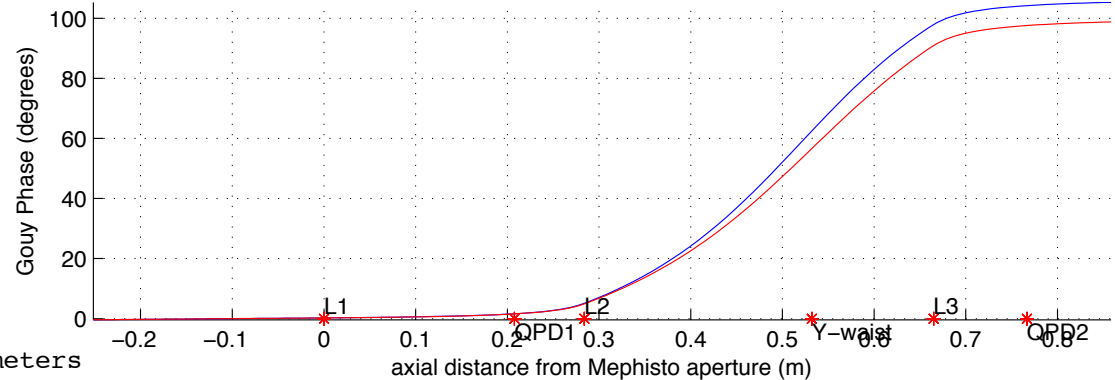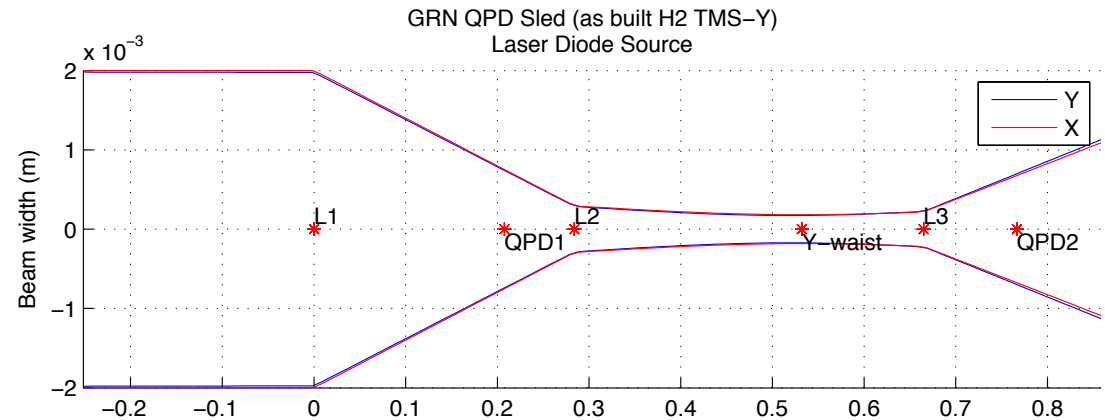

# GRN QPD Sled /w IFO Beam (as-built)

Using the model to locate  
the QPDs.

IFO Arm Beam Parameters  
modematching = 0.95444  
GRNxpath.components list

Modeled Parameters:  
(\* = adjusted z(m) parameter)

label	z (m)	type
L1	0	lens
*QPD1	<b>0.1824</b>	flat mirror
L2	0.2840	lens
Y-waist	0.5320	flat mirror
*L3	<b>0.6650</b>	lens
*QPD2	<b>0.9190</b>	flat mirror

Gouy Phase-x (QPD1): 1.0042  
Gouy Phase-y (QPD1): 1.0042  
Gouy Phase-x (QPD2): 92.9226  
Gouy Phase-y (QPD2): 92.9226

