



Last Edited: 20 October 2006

Title OMC Piezo Driver Overview		LIGO Laboratory California Institute of Technology Massachusetts Institute of Technology		LIGO	
Size: B	DCC Number: D060283	Revision: A1	Engineer: R. Abbott	Date: 10/20/2006	Time: 3:42:21 PM
File: C:\Rich's Files\Mycafiles\ISC\DC_readout\PiezoDriver\OMC_overview.SchDoc					Sheet 1 of 4

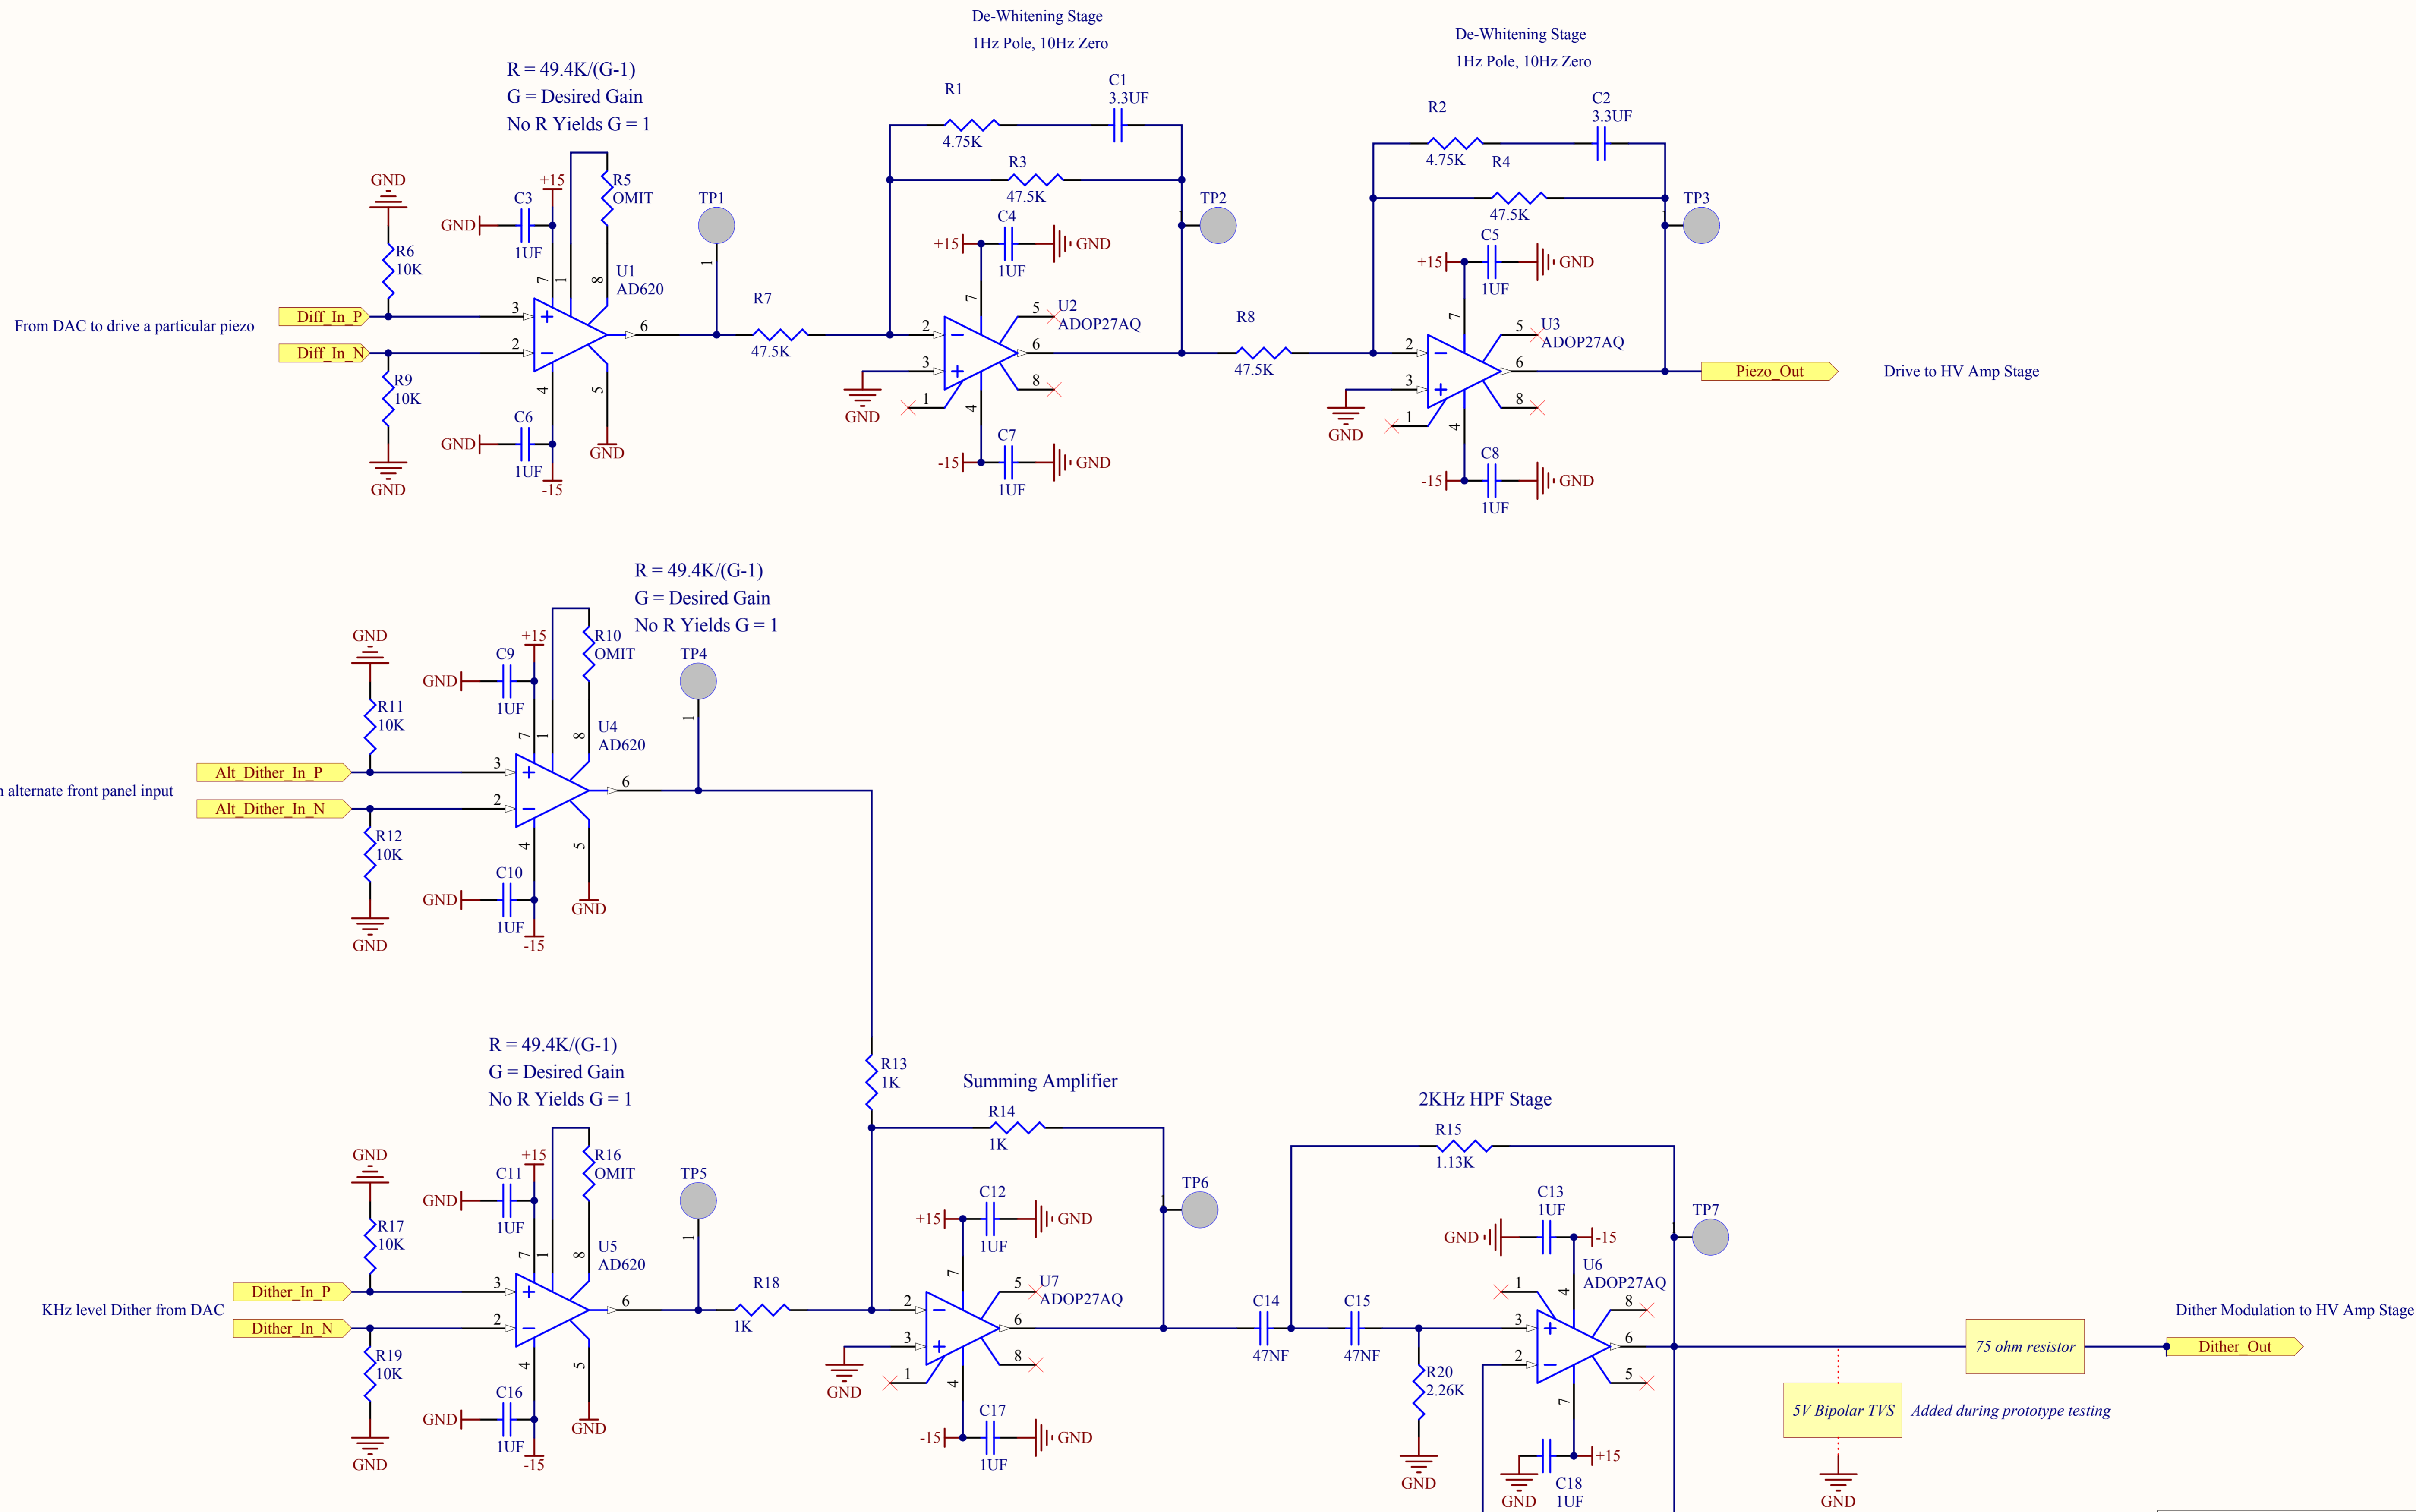

Last Edited: 20 October 2006


Title OMC Differential Receiver		LIGO Laboratory California Institute of Technology Massachusetts Institute of Technology		LIGO	
Size: B	DCC Number: D060283	Revision: A1	Engineer: R. Abbott	Date: 10/20/2006	Time: 3:42:22 PM
File: C:\Rich's Files\Mycadfiles\ISC\DC_readout\PiezoDriver\diff_rec_OMC.SchDoc				Sheet 2 of 4	

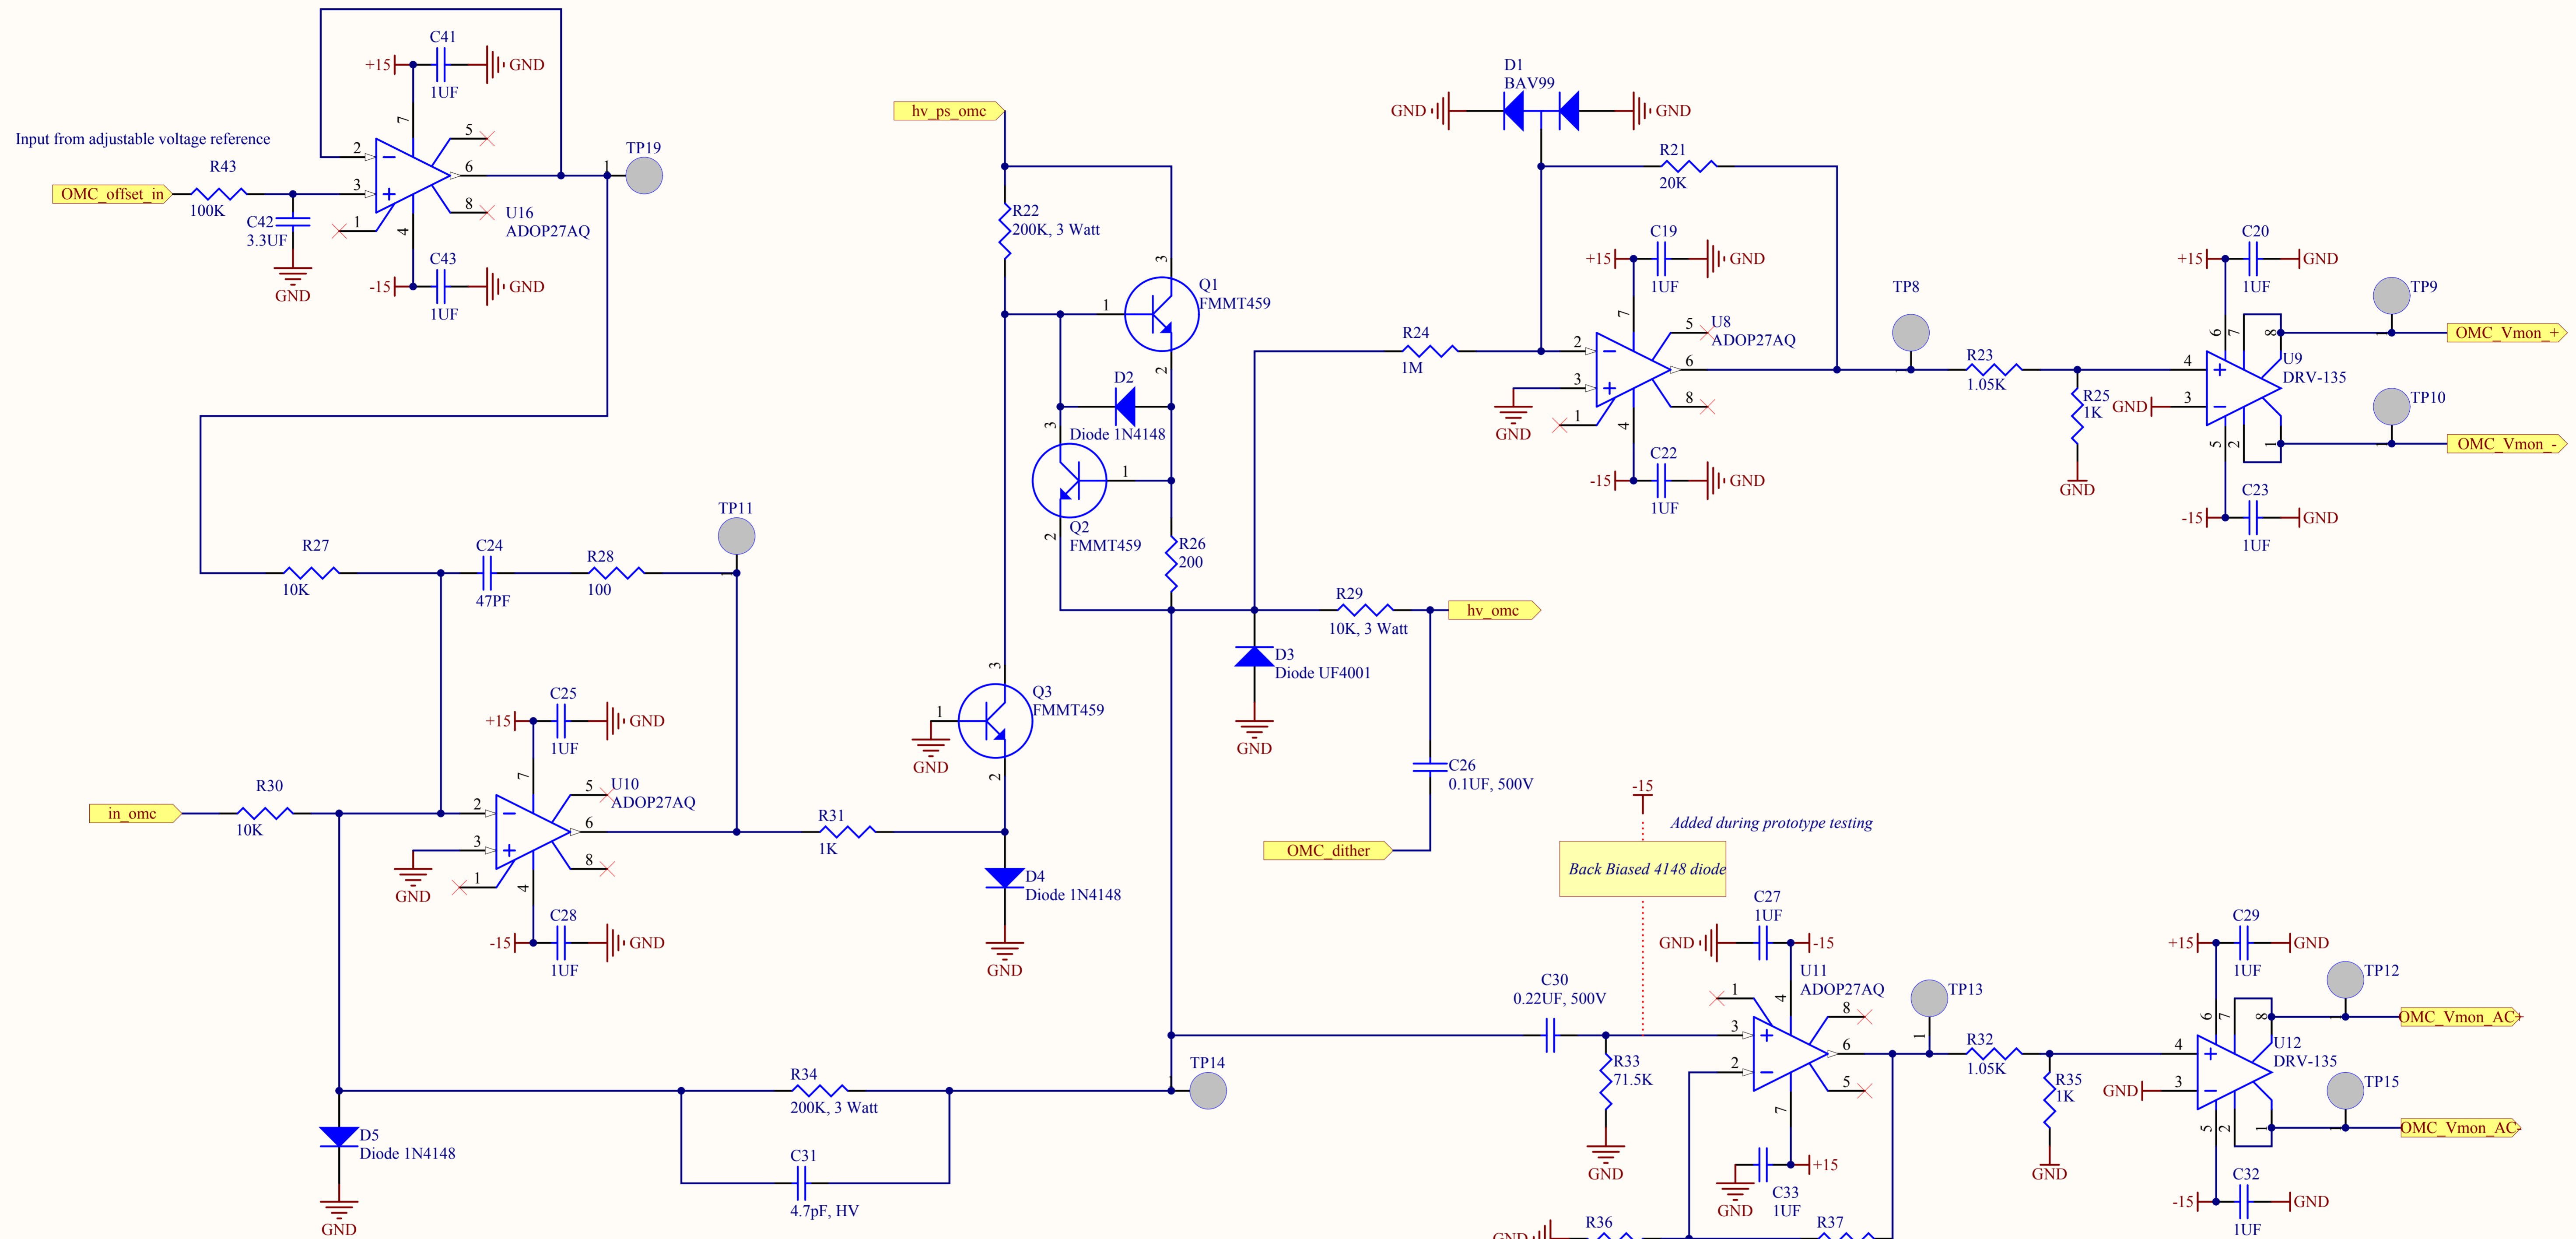

Added during prototype testing
Back Biased 4148 diode

Last Edited: 20 October 2006

Title High Voltage Driver		LIGO Laboratory California Institute of Technology Massachusetts Institute of Technology		LIGO	
Size: B	DCC Number: D060283	Revision: A1	Engineer: R. Abbott	Date: 10/20/2006	Time: 3:42:22 PM
File: C:\Rich's Files\Mycafiles\ISC\DC_readout\PiezoDriver\HV_driver.SchDoc					Sheet 3 of 4

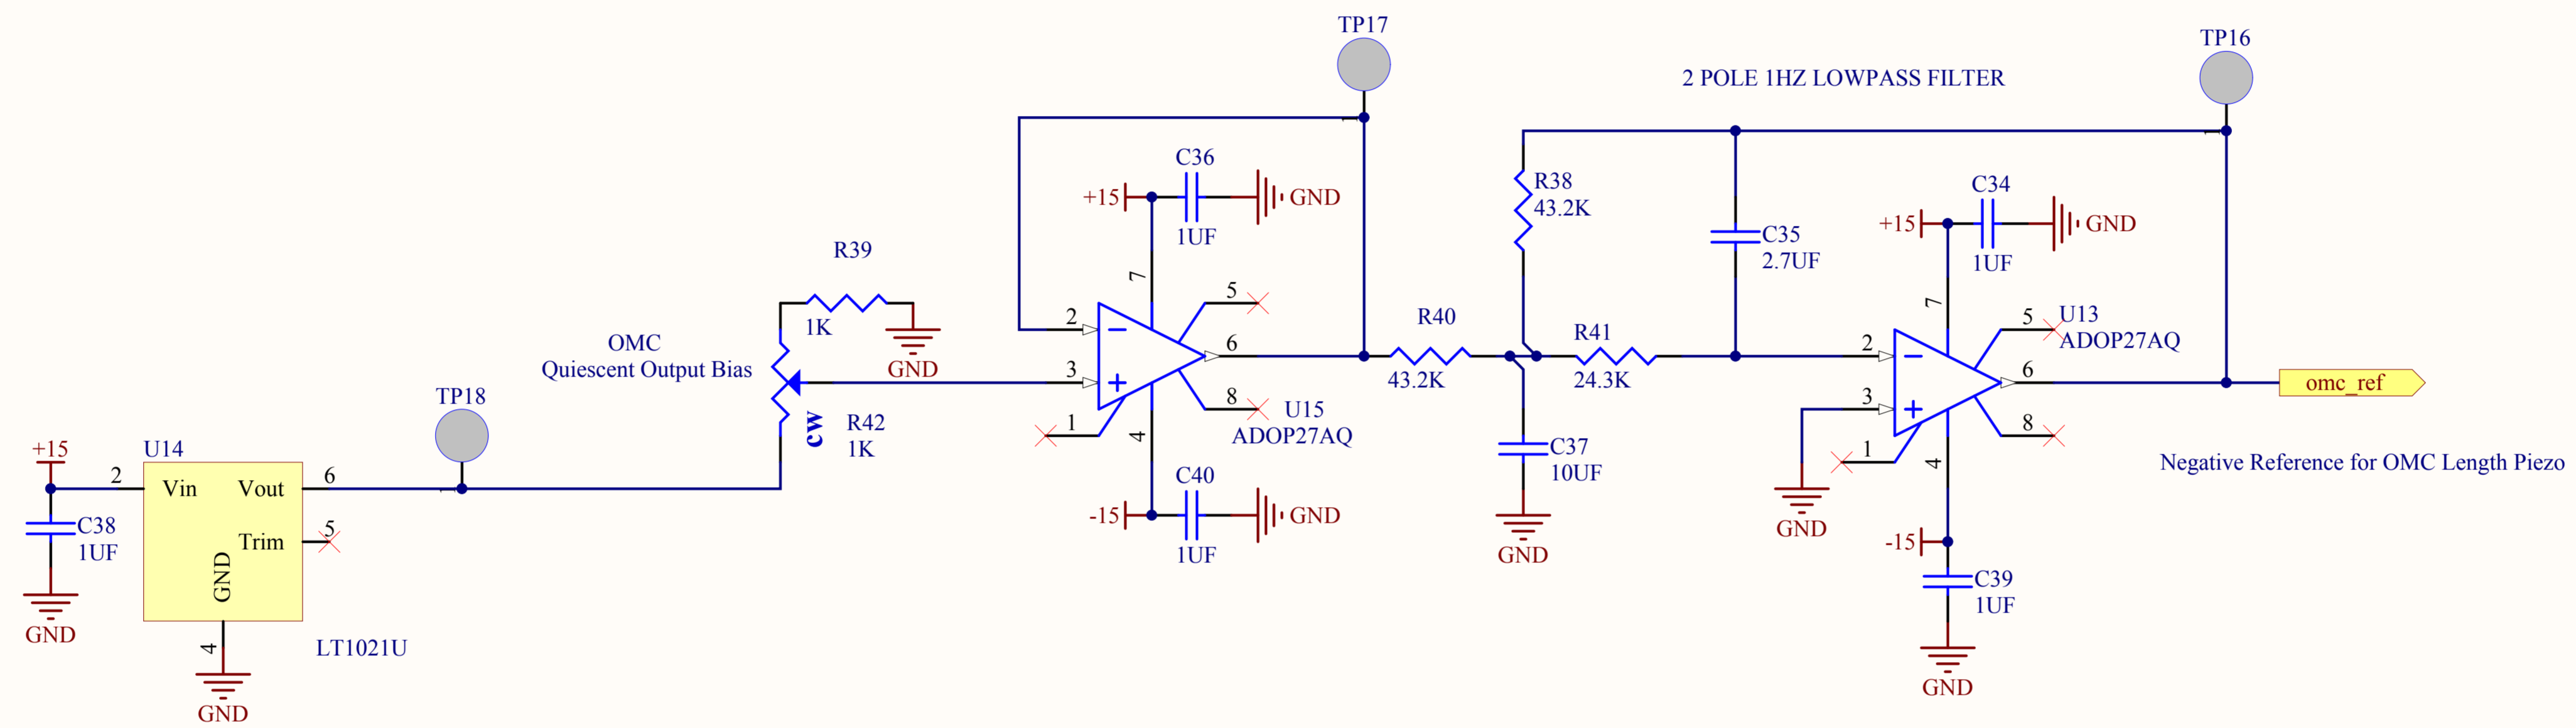

Last Edited: 20 October 2006

Title		LIGO Laboratory California Institute of Technology Massachusetts Institute of Technology		LIGO	
Size: B	DCC Number: D060283	Revision: A1	Engineer: R. Abbott	Date: 10/20/2006	Time: 3:42:22 PM
File: C:\Rich's Files\Mycadfiles\ISC\DC_readout\PiezoDriver\ref_filter_OMC.SchDoc				Sheet 4 of 4	

