


t f

DRAWING INDEX SHEET TITLE SHEET NUMBER GENERAL GENERAL, COVER SHEET BT-G-001 CIVIL CIVIL, DRAWING INDEX, LOCATION & VICINITY MAPS BT-C-001 CIVIL, GENERAL NOTES, LEGEND & ABBREVIATIONS BT-C-002 CIVIL, DRAWING MATRIX BT-C-003 CIVIL, TYPICAL SECTIONS AND DETAILS BT-C-004 CIVIL, CORNER STATION PLAN BT-C-005 CIVIL, NORTHWEST ARM, PLAN AND PROFILE, STA 0+00 TO 14+00 BT-C-011 CIVIL, NORTHWEST ARM, PLAN AND PROFILE, STA 14+00 TO 28+00 BT-C-012 CIVIL, NORTHWEST ARM, PLAN AND PROFILE, STA 28+00 TO 42+00 BT-C-013 CIVIL. NORTHWEST ARM, PLAN AND PROFILE, STA 42+00 TO 56+00 BT-C-014 CIVIL, NORTHWEST ARM, PLAN AND PROFILE, STA 56+00 TO 70+00 BT-C-015 CIVIL, NORTHWEST ARM, PLAN AND PROFILE, STA 70+00 TO 84+00 BT-C-016 CIVIL, NORTHWEST ARM, PLAN AND PROFILE, STA 84+00 TO 98+00 BT-C-017 CIVIL, NORTHWEST ARM, PLAN AND PROFILE, STA 98+00 TO 112+00 BT-C-018 CIVIL, NORTHWEST ARM, PLAN AND PROFILE, STA 112+00 TO 126+00 BT-C-019 CIVIL, NORTHWEST ARM, PLAN AND PROFILE, STA 126+00 TO 133+00 BT-C-020 BT-C-031 CIVIL, SOUTHWEST ARM, PLAN AND PROFILE, STA 0+00 TO 14+00 CIVIL, SOUTHWEST ARM, PLAN AND PROFILE, STA 14+00 TO 28+00 BT-C-032 CIVIL, SOUTHWEST ARM, PLAN AND PROFILE, STA 28+00 TO 42+00 BT-C-033 CIVIL, SOUTHWEST ARM, PLAN AND PROFILE, STA 42+00 TO 56+00 BT-C-034 CIVIL, SOUTHWEST ARM, PLAN AND PROFILE, STA 56+00 TO 70+00 BT-C-035 CIVIL, SOUTHWEST ARM, PLAN AND PROFILE, STA 70+00 TO 84+00 BT-C-036 CIVIL, SOUTHWEST ARM, PLAN AND PROFILE, STA 84+00 TO 98+00 BT-C-037 CIVIL, SOUTHWEST ARM, PLAN AND PROFILE, STA 98+00 TO 112+00 BT-C-038 BT-C-039 CIVIL, SOUTHWEST ARM, PLAN AND PROFILE, STA 112+00 TO 126+00 CIVIL, SOUTHWEST ARM, PLAN AND PROFILE, STA 126+00 TO 133+00 BT-C-040 STRUCTURAL STRUCTURAL, GENERAL NOTES, ABBREVIATIONS & LEGEND BT-S-001 STRUCTURAL, KEY PLAN OF BEAM TUBE ENCLOSURE & PARTIAL ENLARGED PLANS BT-5-002 STRUCTURAL, BEAM TUBE ENCLOSURE PLANS, SECTIONS & DETAILS BT-S-003 STRUCTURAL, KEY PLAN OF BEAM TUBE ENCLOSURE FOUNDATION & PARTIAL ENLARGED PLANS BT-S-004 STRUCTURAL, BEAM TUBE ENCLOSURE, SECTIONS & DETAILS, SHEET I BT-S-005 BT-S-006 STRUCTURAL, BEAM TUBE ENCLOSURE, SECTIONS & DETAILS, SHEET 2

COOR	DINATE TAB FOR LIGO		TIONS
GPS POINT	COORDINATES		ELEVATION
	NORTH	EAST	ELEVATION
LIGO I	421113.464	1907424.820	563.237
LIGO 2	416164.285	1912526.068	550. 905
LIGO 3	410647.803	1916004.584	542.532
LIGO 4	407401.131	1909213, 733	561.242
LIGO 5	403900.640	1905770.659	554.431
LIGO 6	413750.547	1904062.124	

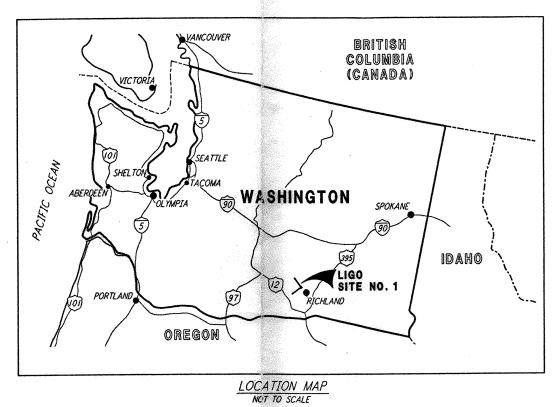

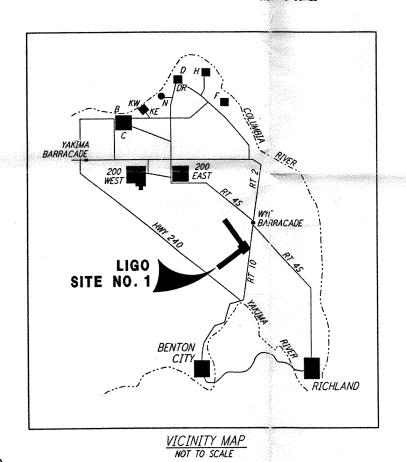

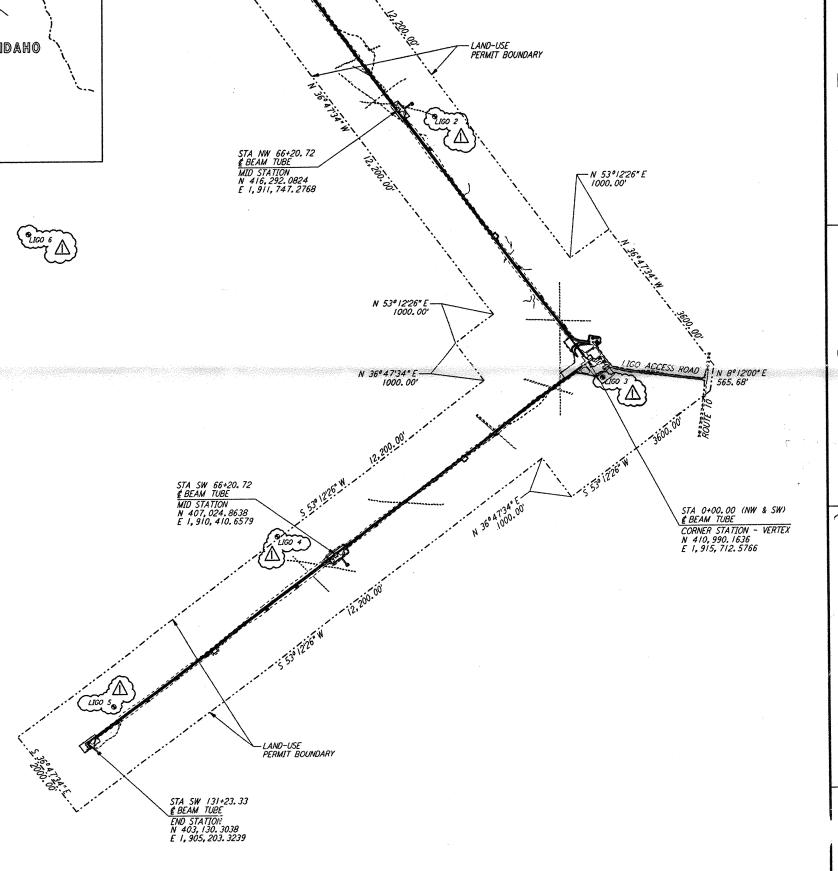

STA NW 131+23.33 & BEAM TUBE END STATION N 421,499.4164 E 1,907,852.7168

 DRAWN
 WRB
 1-19-96

 CHECKED
 MP
 1-19-96

 ENGINEER
 JB
 1-19-96

 PROJ
 MDW
 1-19-96
 I 2-29-96 WRB D D WDW CHANGE ORDER NO. 2

NO. DATE BY CHKD ENGR PROJ DESC





LIGO CALIFORNIA INSTITUTE OF TECHNOLOGY MASSACHUSETTS INSTITUTE OF TECHNOLOGY LASER INTERFEROMETER
GRAVITATIONAL-WAVE OBSERVATORY
BTE SITEWORK & FABRICATION - HANFORD, WA AS NOTED PP150969 8094 CIVIL
DRAWING INDEX
LOCATION & VICINITY
MAPS BT-C-001

GRAPHIC SC

2

L160 D960161-01-0

LIGOBTF 3.BOR