


This document and the design it covers are the property of PARSONS. They are loaned only with the borrower's expressed written agreement that they will not be reproduced, copied, loaned, exhibited, or used in any other way, except by written consent from PARSONS to the borrower.



DRAWING INDEX	
SHEET NUMBER	SHEET TITLE
<b>GENERAL</b>	
BT-G-001	GENERAL, COVER SHEET
<b>CIVIL</b>	
BT-C-001	CIVIL, DRAWING INDEX, LOCATION & VICINITY MAPS
BT-C-002	CIVIL, GENERAL NOTES, LEGEND & ABBREVIATIONS
BT-C-003	CIVIL, DRAWING MATRIX
BT-C-004	CIVIL, TYPICAL SECTIONS AND DETAILS
BT-C-005	CIVIL, CORNER STATION PLAN
BT-C-011	CIVIL, NORTHWEST ARM, PLAN AND PROFILE, STA 0+00 TO 14+00
BT-C-012	CIVIL, NORTHWEST ARM, PLAN AND PROFILE, STA 14+00 TO 28+00
BT-C-013	CIVIL, NORTHWEST ARM, PLAN AND PROFILE, STA 28+00 TO 42+00
BT-C-014	CIVIL, NORTHWEST ARM, PLAN AND PROFILE, STA 42+00 TO 56+00
BT-C-015	CIVIL, NORTHWEST ARM, PLAN AND PROFILE, STA 56+00 TO 70+00
BT-C-016	CIVIL, NORTHWEST ARM, PLAN AND PROFILE, STA 70+00 TO 84+00
BT-C-017	CIVIL, NORTHWEST ARM, PLAN AND PROFILE, STA 84+00 TO 98+00
BT-C-018	CIVIL, NORTHWEST ARM, PLAN AND PROFILE, STA 98+00 TO 112+00
BT-C-019	CIVIL, NORTHWEST ARM, PLAN AND PROFILE, STA 112+00 TO 126+00
BT-C-020	CIVIL, NORTHWEST ARM, PLAN AND PROFILE, STA 126+00 TO 133+00
BT-C-021	CIVIL, NORTHWEST ARM, MID-STATION, PLOT PLAN
BT-C-022	CIVIL, NORTHWEST ARM, MID-STATION, GRADING PLAN
BT-C-023	CIVIL, NORTHWEST ARM, MID-STATION, UTILITY PLAN
BT-C-025	CIVIL, NORTHWEST ARM, END-STATION, PLOT PLAN
BT-C-026	CIVIL, NORTHWEST ARM, END-STATION, GRADING PLAN
BT-C-027	CIVIL, NORTHWEST ARM, END-STATION, UTILITY PLAN
BT-C-031	CIVIL, SOUTHWEST ARM, PLAN AND PROFILE, STA 0+00 TO 14+00
BT-C-032	CIVIL, SOUTHWEST ARM, PLAN AND PROFILE, STA 14+00 TO 28+00
BT-C-033	CIVIL, SOUTHWEST ARM, PLAN AND PROFILE, STA 28+00 TO 42+00
BT-C-034	CIVIL, SOUTHWEST ARM, PLAN AND PROFILE, STA 42+00 TO 56+00
BT-C-035	CIVIL, SOUTHWEST ARM, PLAN AND PROFILE, STA 56+00 TO 70+00
BT-C-036	CIVIL, SOUTHWEST ARM, PLAN AND PROFILE, STA 70+00 TO 84+00
BT-C-037	CIVIL, SOUTHWEST ARM, PLAN AND PROFILE, STA 84+00 TO 98+00
BT-C-038	CIVIL, SOUTHWEST ARM, PLAN AND PROFILE, STA 98+00 TO 112+00
BT-C-039	CIVIL, SOUTHWEST ARM, PLAN AND PROFILE, STA 112+00 TO 126+00
BT-C-040	CIVIL, SOUTHWEST ARM, PLAN AND PROFILE, STA 126+00 TO 133+00
BT-C-041	CIVIL, SOUTHWEST ARM, MID-STATION, PLOT PLAN
BT-C-042	CIVIL, SOUTHWEST ARM, MID-STATION, GRADING PLAN
BT-C-043	CIVIL, SOUTHWEST ARM, MID-STATION, UTILITY PLAN
BT-C-045	CIVIL, SOUTHWEST ARM, END-STATION, PLOT PLAN
BT-C-046	CIVIL, SOUTHWEST ARM, END-STATION, GRADING PLAN
BT-C-047	CIVIL, SOUTHWEST ARM, END-STATION, UTILITY PLAN
BT-C-051	CIVIL, SITework DETAILS
BT-C-052	CIVIL, GRADING SECTIONS & DETAILS
<b>STRUCTURAL</b>	
BT-S-001	STRUCTURAL, GENERAL NOTES, ABBREVIATIONS & LEGEND
BT-S-002	STRUCTURAL, KEY PLAN OF BEAM TUBE ENCLOSURE & PARTIAL ENLARGED PLANS
BT-S-003	STRUCTURAL, BEAM TUBE ENCLOSURE PLANS, SECTIONS & DETAILS
BT-S-004	STRUCTURAL, KEY PLAN OF BEAM TUBE ENCLOSURE FOUNDATION & PARTIAL ENLARGED PLANS
BT-S-005	STRUCTURAL, BEAM TUBE ENCLOSURE, SECTIONS & DETAILS, SHEET 1
BT-S-006	STRUCTURAL, BEAM TUBE ENCLOSURE, SECTIONS & DETAILS, SHEET 2
BT-S-601	STRUCTURAL, GENERAL NOTES, ABBREVIATIONS & LEGEND
BT-S-602	STRUCTURAL, STANDARD, CONCRETE DETAILS SHEET 1
BT-S-603	STRUCTURAL, STANDARD, CONCRETE DETAILS SHEET 2
BT-S-604	STRUCTURAL, MID STATION "B" & END STATION "B", FOUNDATION PLANS
BT-S-605	STRUCTURAL, MID & END STATIONS "B", AIR HANDLING UNIT ENCLOSURE PLANS
BT-S-606	STRUCTURAL, MID & END STATIONS "B", AIR HANDLING UNIT ENCLOSURE ELEVS & SECTS
BT-S-607	STRUCTURAL, MID AND END STATIONS "B", FOUNDATION SCHEDULE AND DETAILS
BT-S-608	STRUCTURAL, FOUNDATION SECTIONS & DETAILS
<b>ELECTRICAL</b>	
BT-E-601	ELECTRICAL, MID & END STATION, GROUNDING PLAN
BT-E-602	ELECTRICAL, MID & END STATION, UNDERGROUND PLAN
BT-E-603	ELECTRICAL, GROUNDING DETAILS, SHEET 1
BT-E-604	ELECTRICAL, GROUNDING DETAILS, SHEET 2
<b>PLUMBING</b>	
BT-P-601	PLUMBING, MID & END STATIONS "B", UNDERGROUND PLAN
BT-P-602	PLUMBING, MID & END STATIONS "B", RISER DIAGRAM & SCHEMATICS

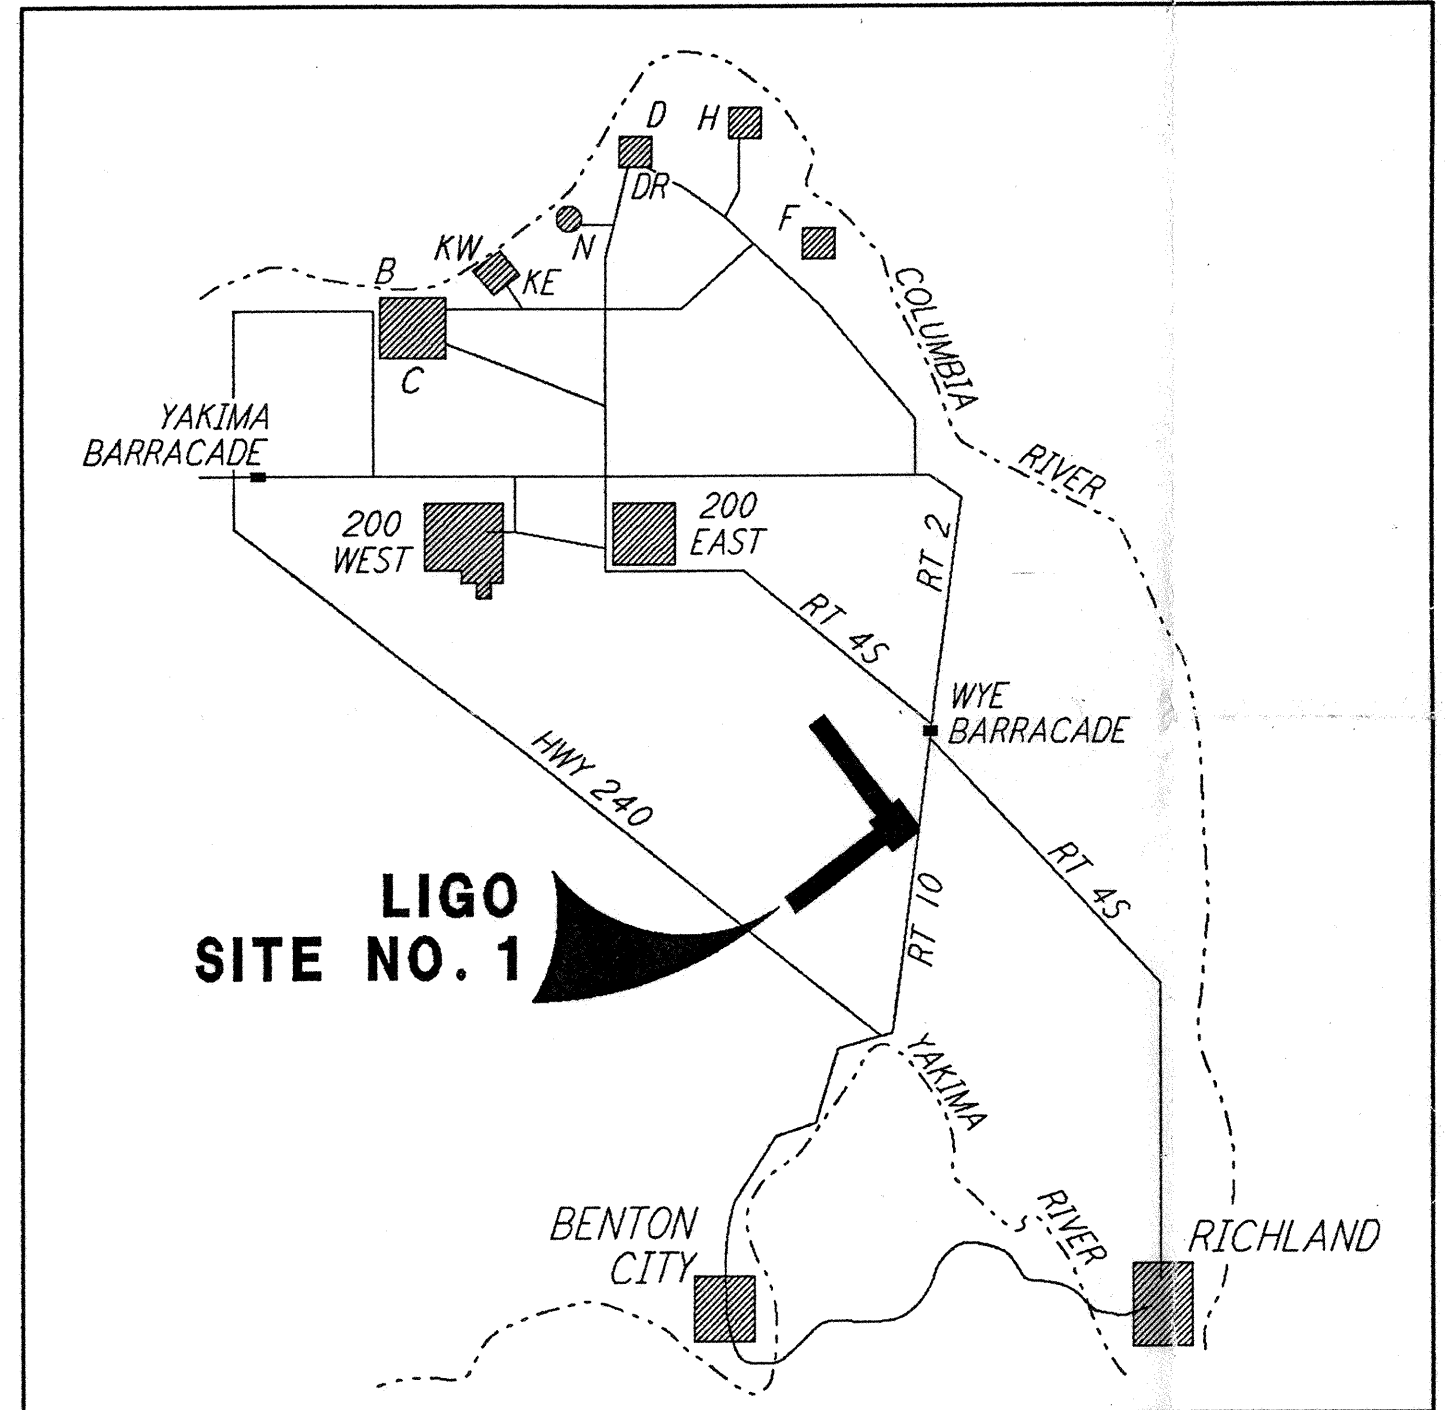

**COORDINATE TABLE & ELEVATIONS FOR LIGO GPS POINTS**


GPS POINT	COORDINATES		ELEVATION
	NORTH	EAST	
LIGO 1	421113.464	1907424.820	563.237
LIGO 2	416164.285	1912526.068	550.905
LIGO 3	410647.803	1916004.584	542.532
LIGO 4	407401.131	1909213.733	561.242
LIGO 5	403900.640	1905770.659	554.431
LIGO 6	413750.547	1904062.124	

NOTE: GPS COORDINATE POINTS ARE HIGH ACCURACY, PLACED BY THE WSDOT GEOGRAPHIC SERVICES.

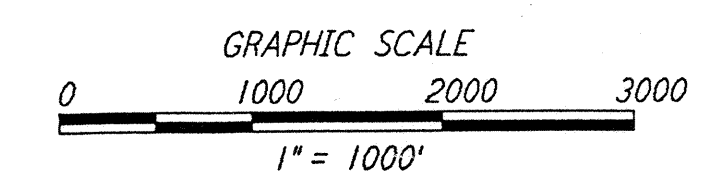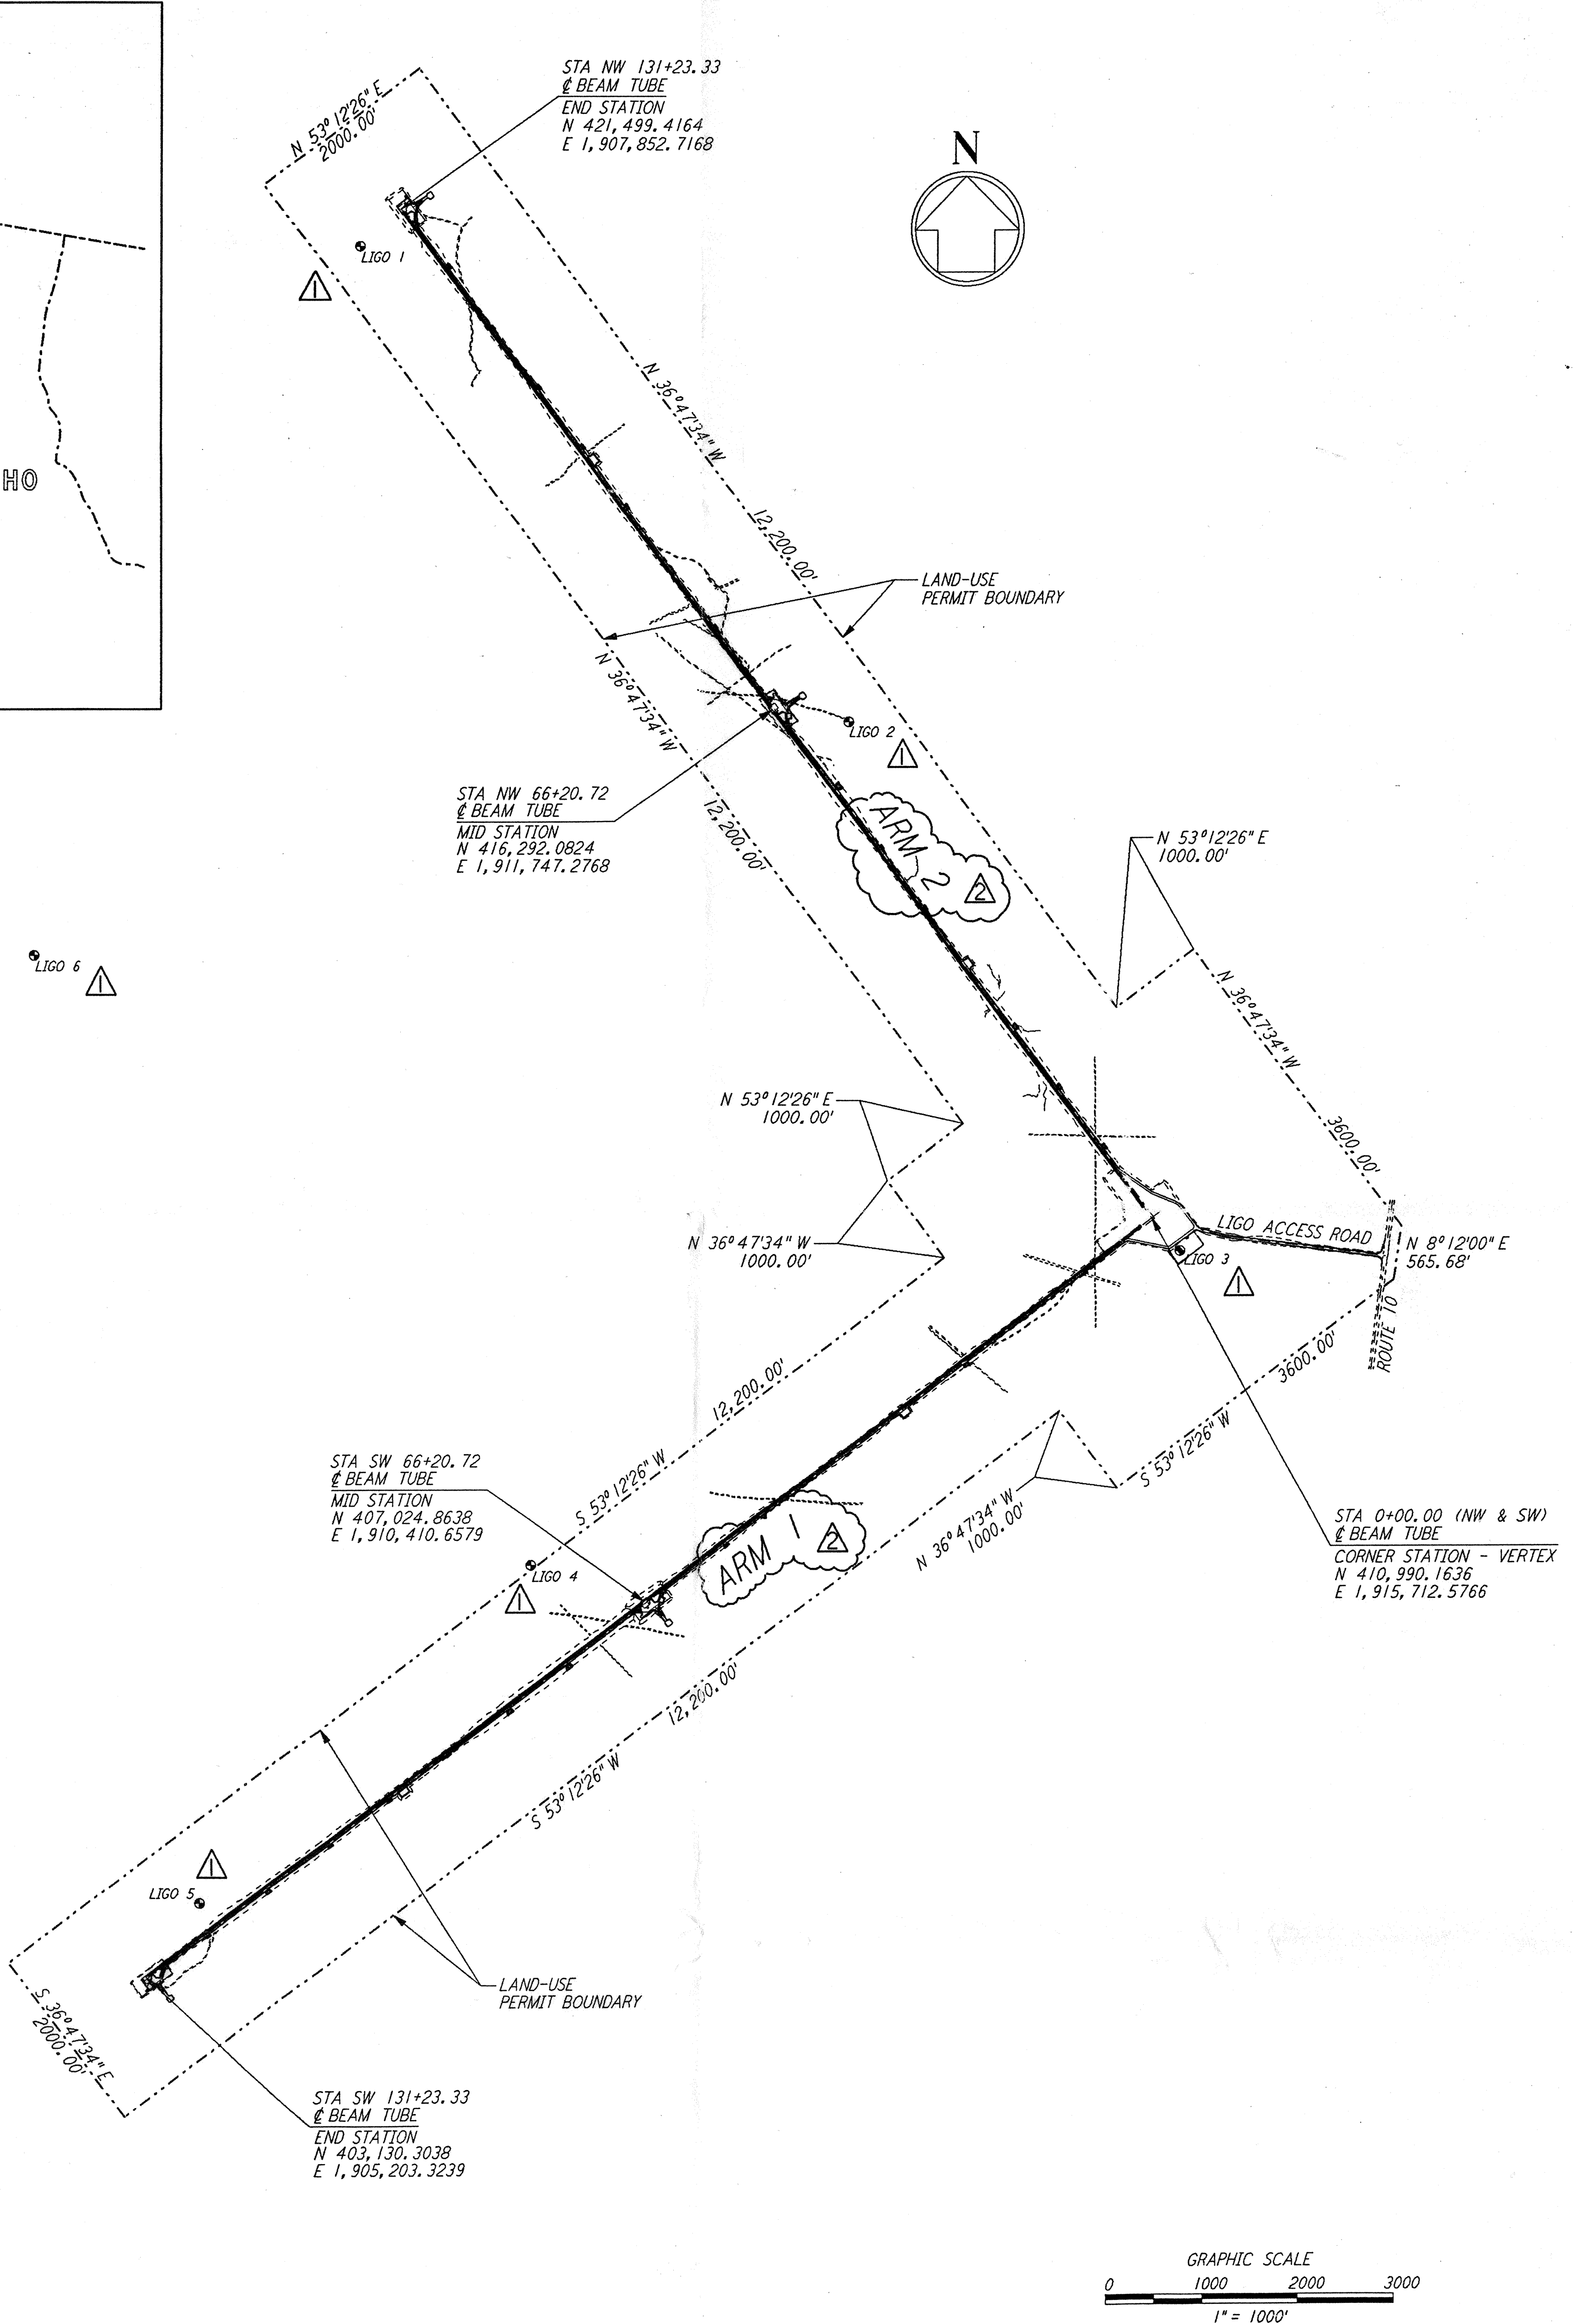

NO.	DATE	BY	CHKD	ENGR	PROJ	DESCRIPTION
2	4-19-96	WRB	TDM	MDW		CHANGE ORDER NO. 4
1	2-29-96	WRB	JB	MDW		CHANGE ORDER NO. 2

ISSUED FOR CONSTRUCTION		
DRAWN	WRB	1-19-96
CHECKED	MP	1-19-96
ENGINEER	JB	1-19-96
PROJ	MDW	1-19-96

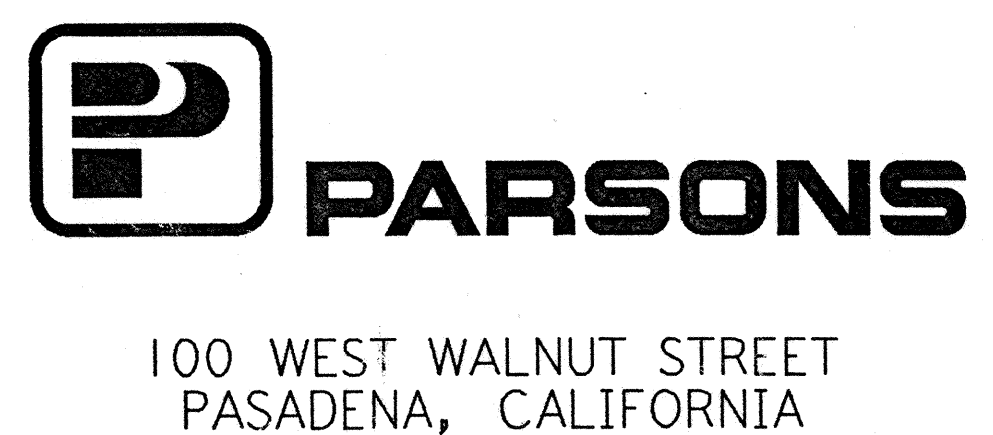

LASER INTERFEROMETER GRAVITATIONAL-WAVE OBSERVATORY BTE SITEWORK & FABRICATION - HANFORD, WA			
TITLE	SCALE	CONTRACT NUMBER	PROJECT NUMBER
CIVIL DRAWING INDEX LOCATION & VICINITY MAPS	AS NOTED	PP150969	8094
SHEET NUMBER		REVISIONS	
BT-C-001			

This drawing is the property of PARSONS. It is loaned to you for your use only. It is not to be reproduced, copied, loaned, exhibited, or used in any other way, except by written consent from PARSONS to the borrower.