not to be reproduced, copied, loaned, exhibited, or used in any other way, except by written consent from **PARSONS**. They are loaned only with the borrower's expressed written agreement that they will

This document and the design it covers are the property of **PARSONS**. They are loaned only with the borrower's expressed written agreement that they will

DESIGN FILE: J:\ligo\site\civil\btc005.dgz

NOTES:

1. SEE SHEET BT-C-002 FOR GENERAL NOTES, LEGEND AND ABBREVIATIONS.
2. SEE SHEET BT-C-004 FOR TYPICAL SECTIONS AND DETAILS.
3. CONTRACTOR SHALL GRADE AND LEVEL SITE FOR HIS USE, BUT IN A MANNER THAT IT CONTINUOUSLY AND EFFECTIVELY DRAINS AND CAUSES NO DAMAGE OR PONDING IN CONSTRUCTION WORK AREAS OR FINAL SITE. ⚠1

TEMPORARY ACCESS ROAD (1/—)
NOT TO SCALE

CURVE DATA (TEMPORARY ACCESS ROAD)

	R	Δ	L	T	REMARK
1	40.00'	90°00'00"	62.83'	40.00'	EDGE OF ROAD
2	55.00'	51°29'57"	49.44'	26.53'	EDGE OF ROAD
3	55.00'	38°30'03"	36.96'	19.21'	EDGE OF ROAD
4	110.00'	30°00'00"	57.60'	29.47'	℄ TEMPORARY ACCESS ROAD
5	110.00'	11°44'13"	22.53'	11.31'	
6	64.33'	18°15'47"	20.51'	10.34'	
7	62.00'	48°19'28"	52.29'	27.81'	
8	63.00'	48°19'28"	53.14'	28.26'	

DETAIL (2/—) ⚠
NOT TO SCALE

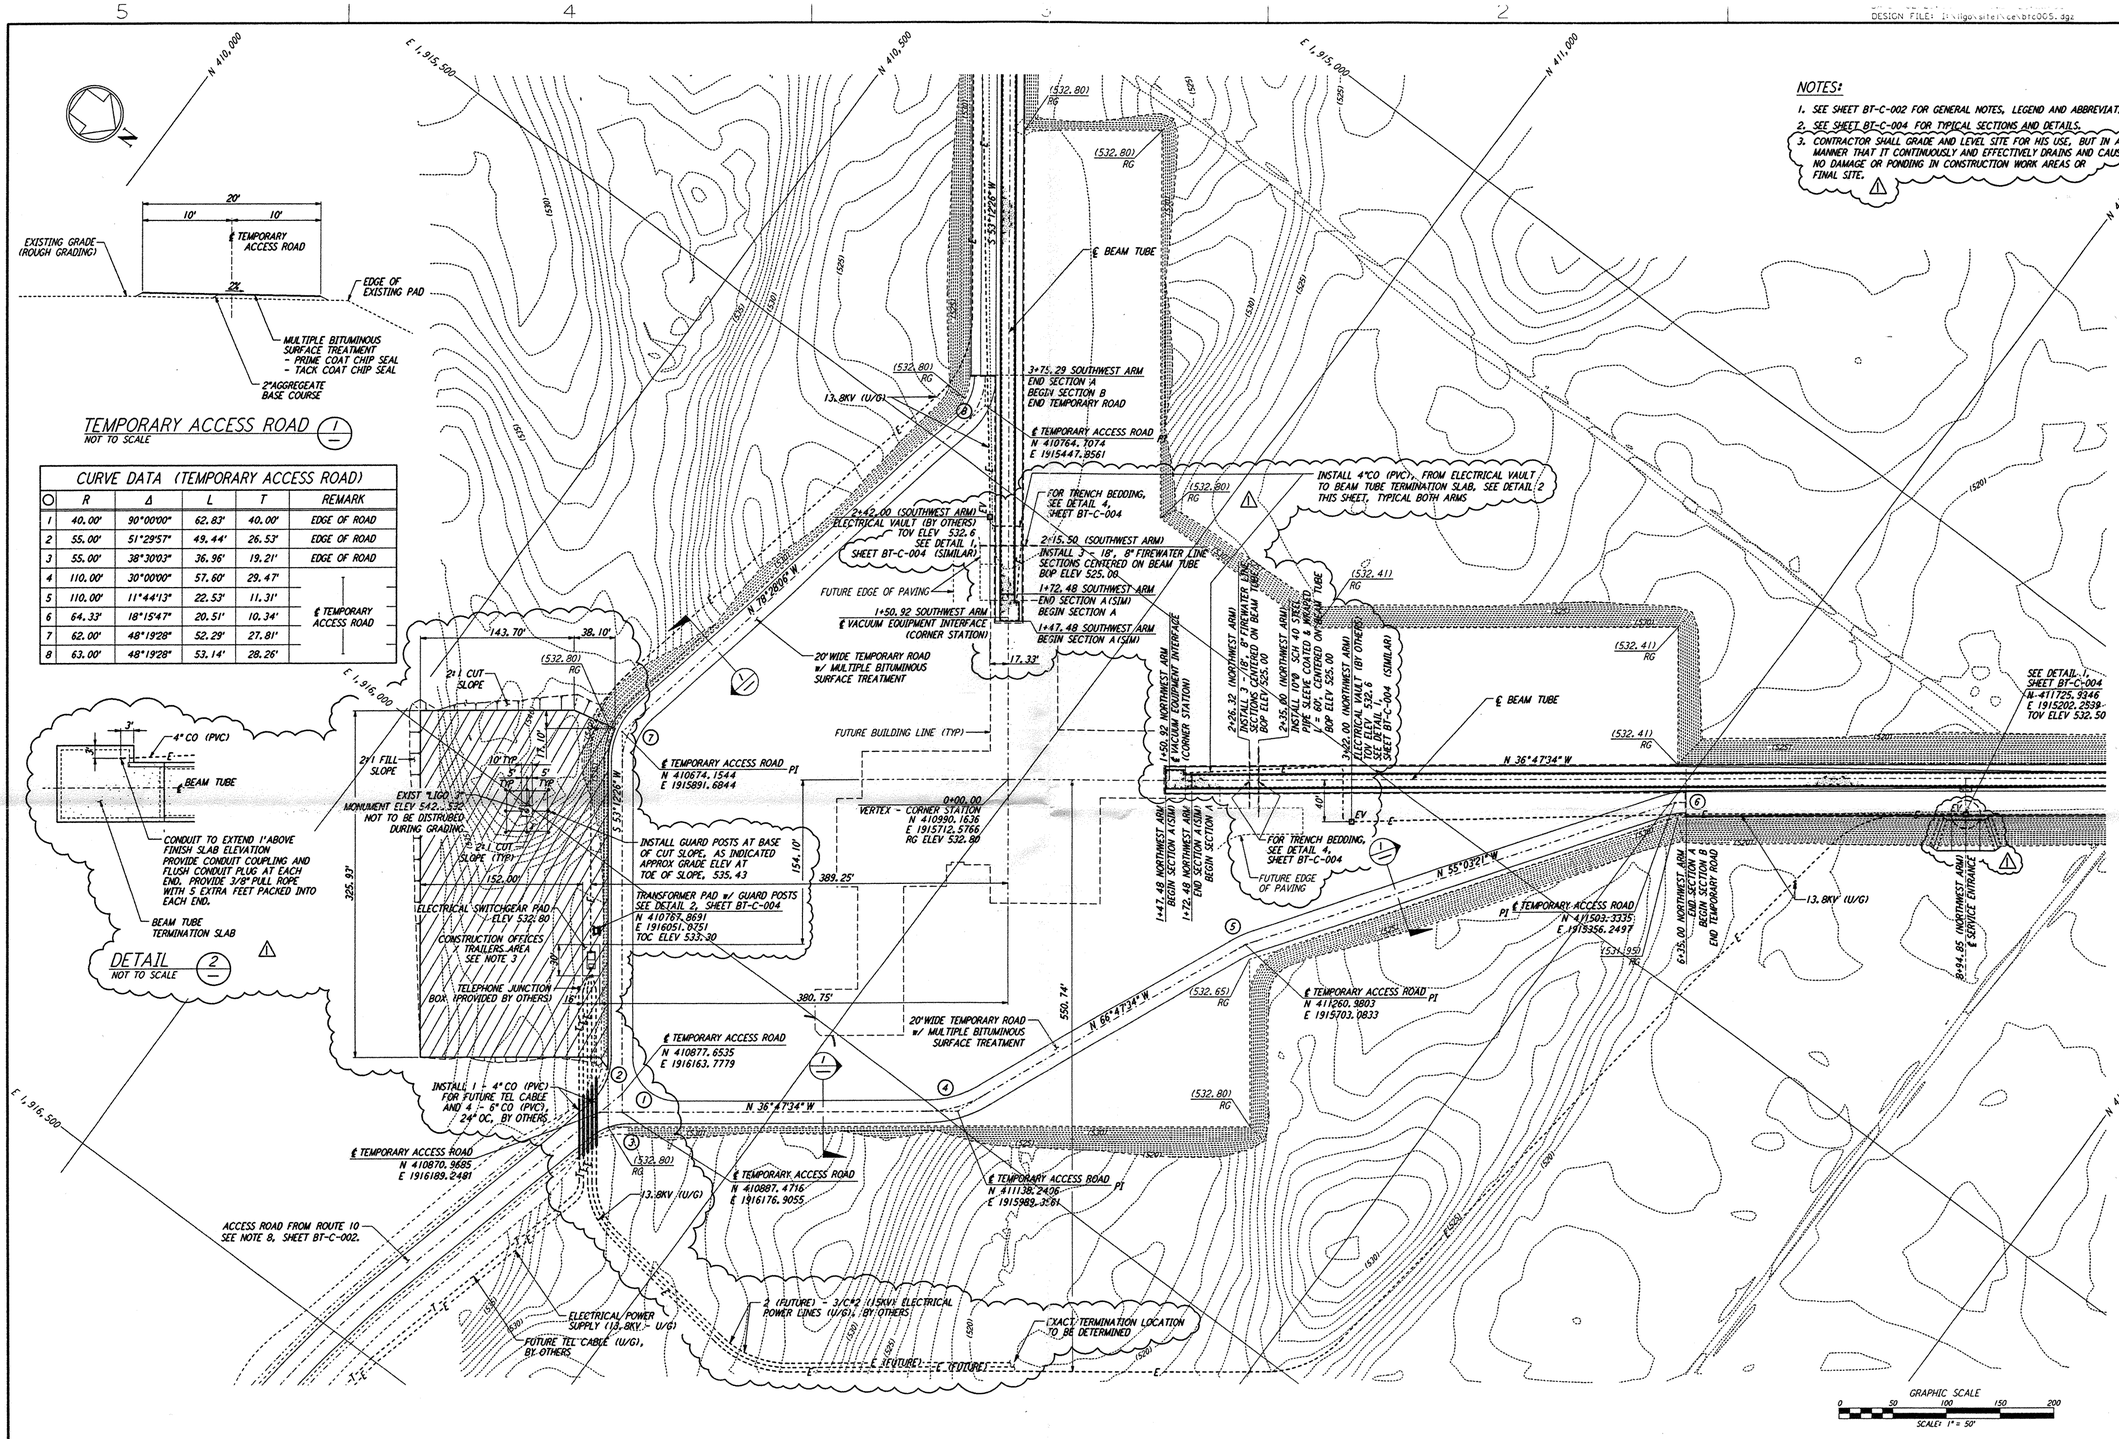

GRAPHIC SCALE
0 50 100 150 200
SCALE: 1" = 50'

REFERENCES			REVISIONS						
DRAWING NO.	DESCRIPTION		NO.	DATE	BY	CHKD	ENGR	PROJ	DESCRIPTION
			1	2-29-96	WRB				CHANGE ORDER NO. 2

⚠ ISSUED FOR CONSTRUCTION

DRAWN	WRB	1-19-96
CHECKED	MP	1-19-96
ENGINEER	JB	1-19-96
PROJ	MDW	1-19-96

JAMES BLANCH — STATE OF CALIFORNIA — PROFESSIONAL ENGINEER — EXPIRES 12-96

PARSONS
100 WEST WALNUT STREET
PASADENA, CALIFORNIA

LIGO
CALIFORNIA INSTITUTE OF TECHNOLOGY
MASSACHUSETTS INSTITUTE OF TECHNOLOGY

LASER INTERFEROMETER GRAVITATIONAL-WAVE OBSERVATORY
BTE SITEWORK & FABRICATION - HANFORD, WA

TITLE: CIVIL CORNER STATION PLAN

SCALE	CONTRACT NUMBER	PROJECT NUMBER
1" = 50'	PP150969	8094

SHEET NUMBER: BT-C-005 ⚠1 REVISIONS

LIGO D960165-01-D

LIGOBTF3.BOR

Thu Feb 29 23:27:05 1996 s:\fv\bdz\fv3bdz\civil\bmpl.pmp

Thu Feb 29 23:27:09 1996 s:\fv\bdz\fv3bdz\civil\bmpl.pmp