

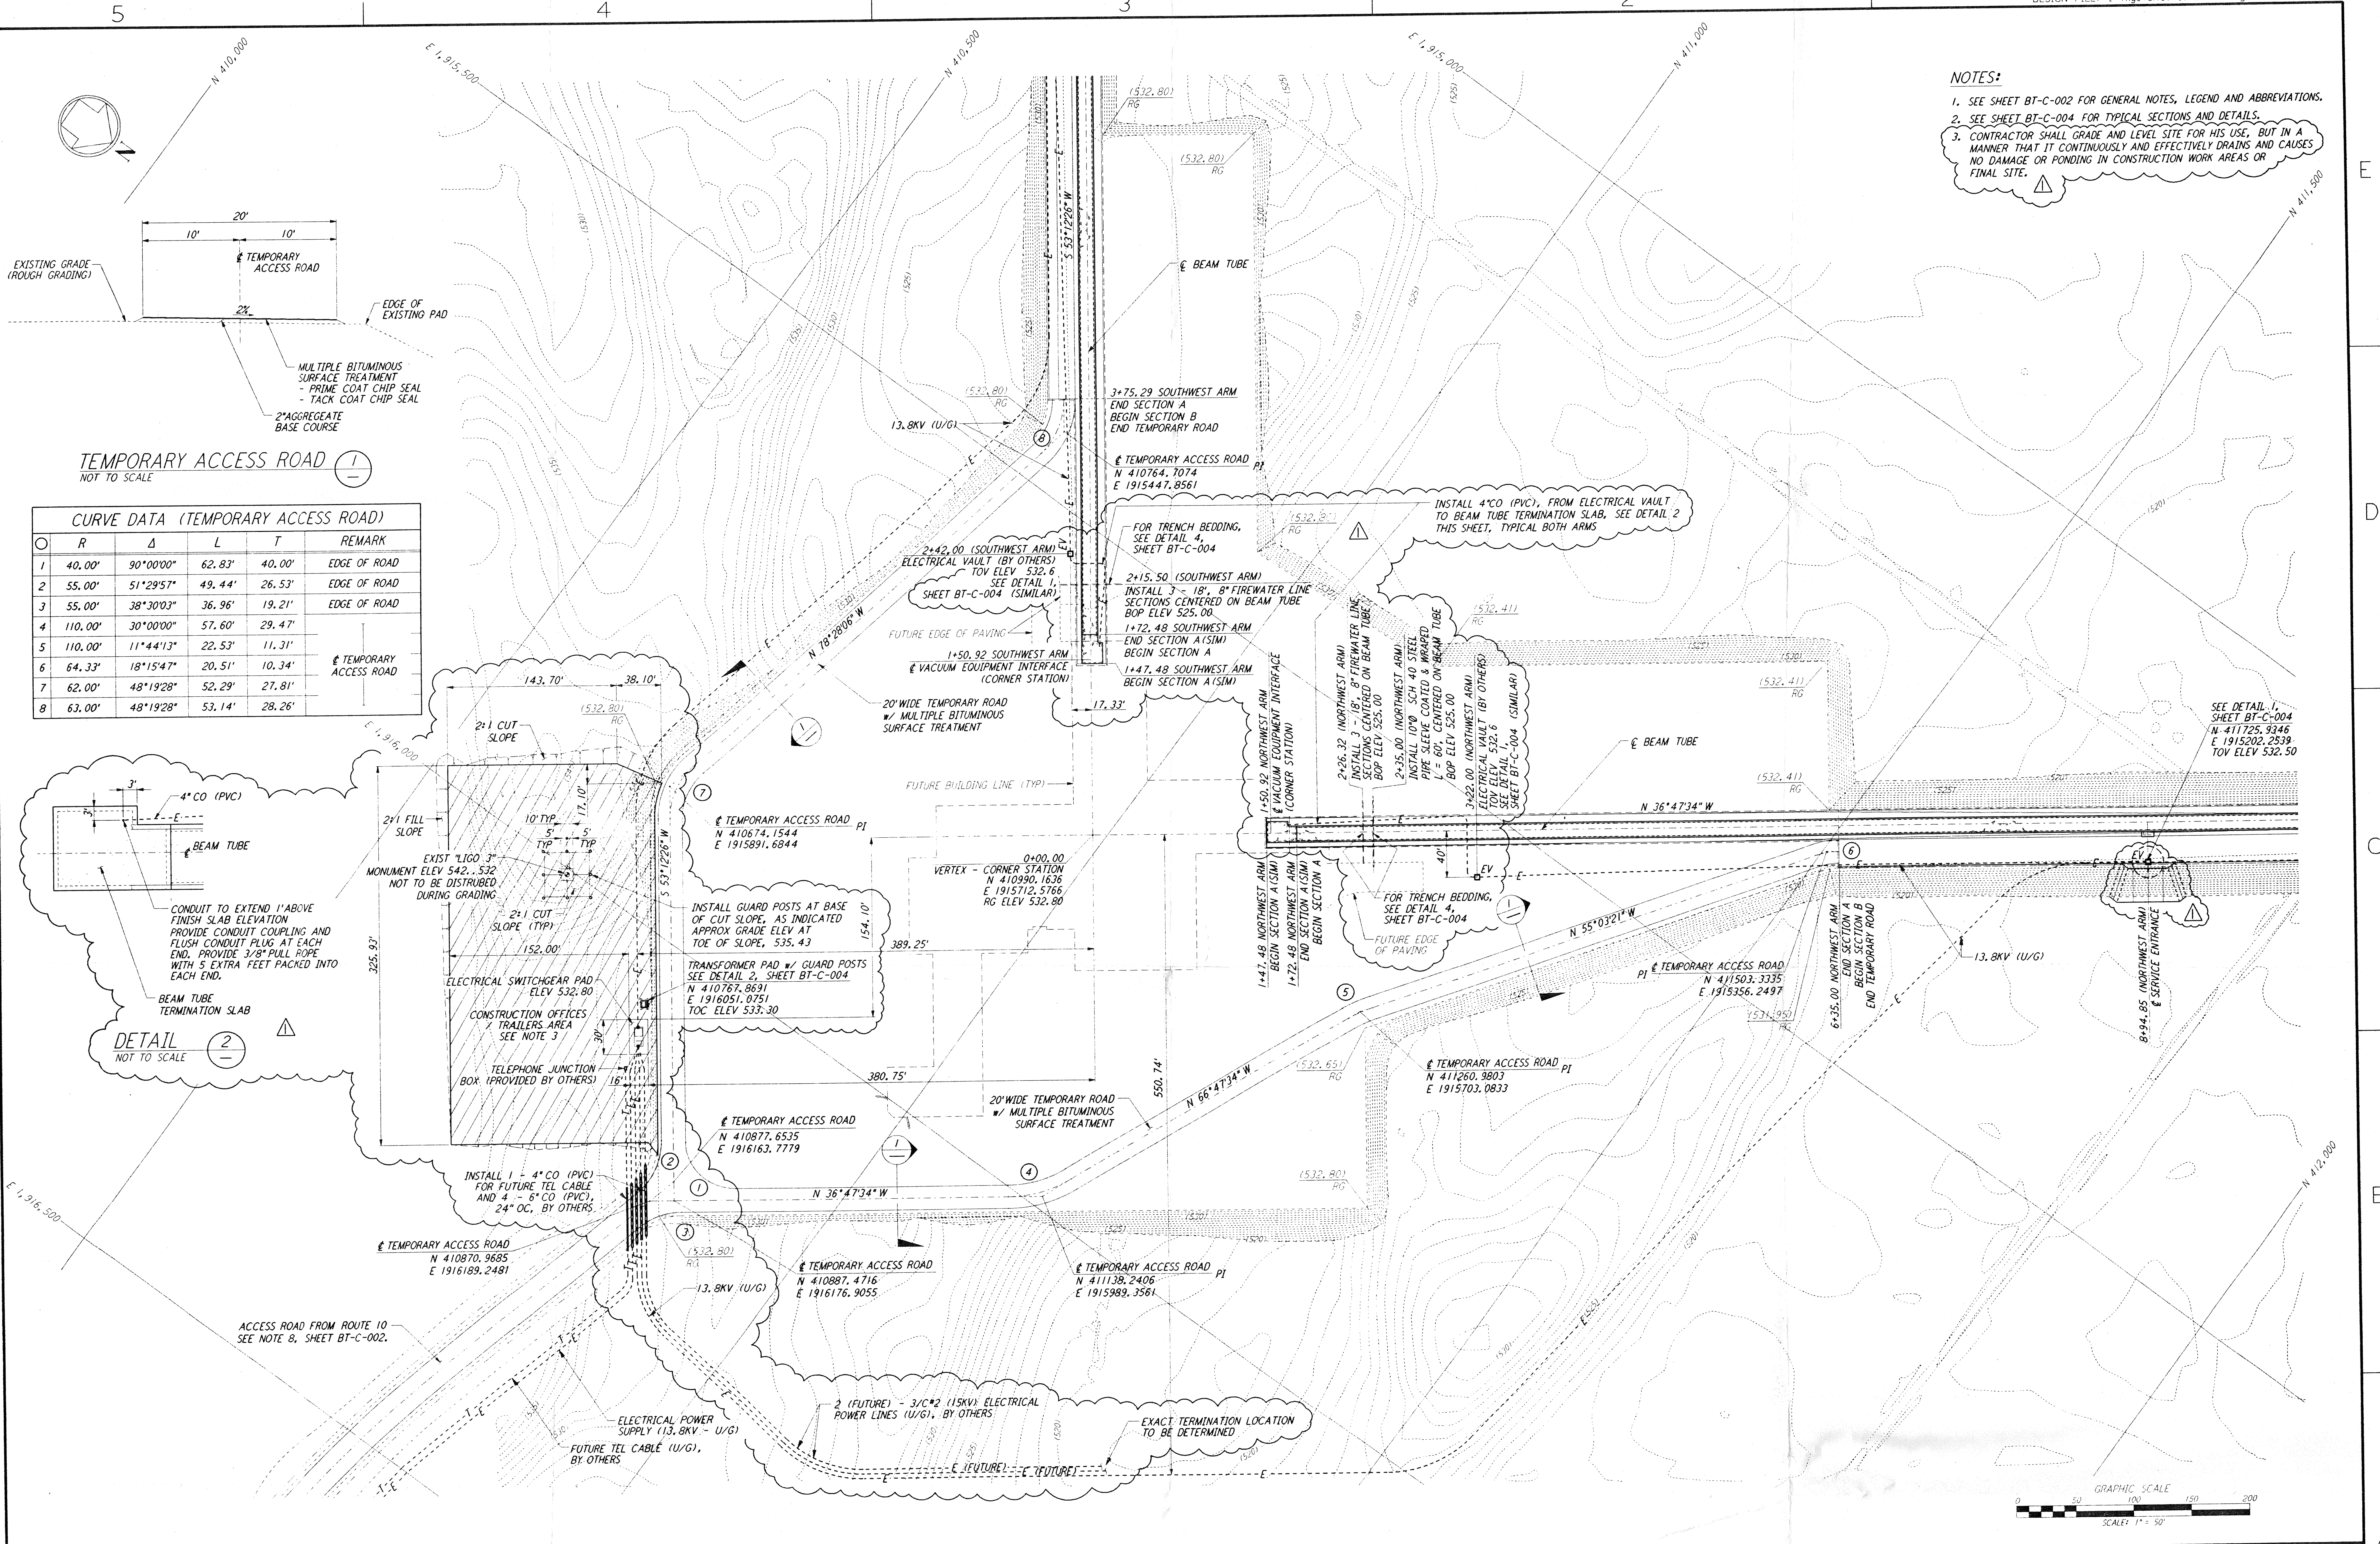


- NOTES:**
- SEE SHEET BT-C-002 FOR GENERAL NOTES, LEGEND AND ABBREVIATIONS.
  - SEE SHEET BT-C-004 FOR TYPICAL SECTIONS AND DETAILS.
  - CONTRACTOR SHALL GRADE AND LEVEL SITE FOR HIS USE, BUT IN A MANNER THAT IT CONTINUOUSLY AND EFFECTIVELY DRAINS AND CAUSES NO DAMAGE OR PONDING IN CONSTRUCTION WORK AREAS OR FINAL SITE.

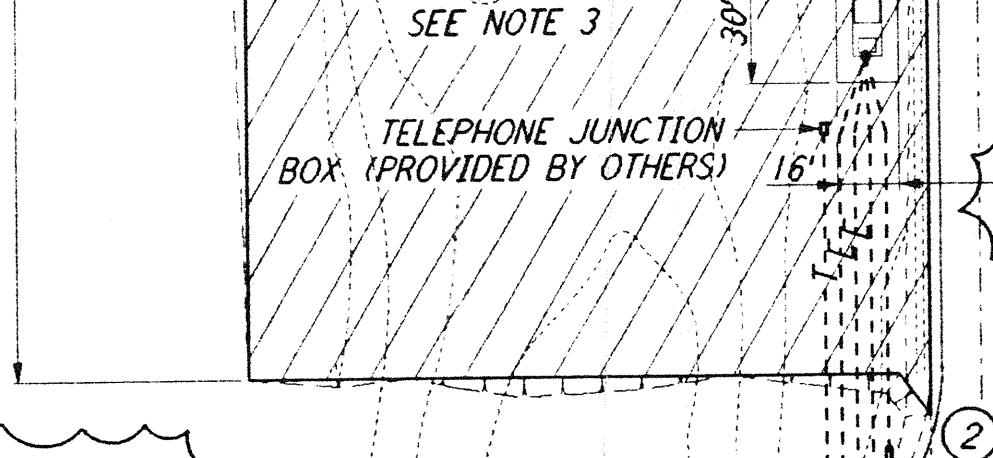

**TEMPORARY ACCESS ROAD**  
NOT TO SCALE

R	Δ	L	T	REMARK	
1	40.00'	90°00'00"	62.83'	40.00'	EDGE OF ROAD
2	55.00'	51°29'57"	49.44'	26.53'	EDGE OF ROAD
3	55.00'	38°30'03"	36.96'	19.21'	EDGE OF ROAD
4	110.00'	30°00'00"	57.60'	29.47'	
5	110.00'	11°44'13"	22.53'	11.31'	
6	64.33'	18°15'47"	20.51'	10.34'	TEMPORARY ACCESS ROAD
7	62.00'	48°19'28"	52.29'	27.81'	
8	63.00'	48°19'28"	53.14'	28.26'	

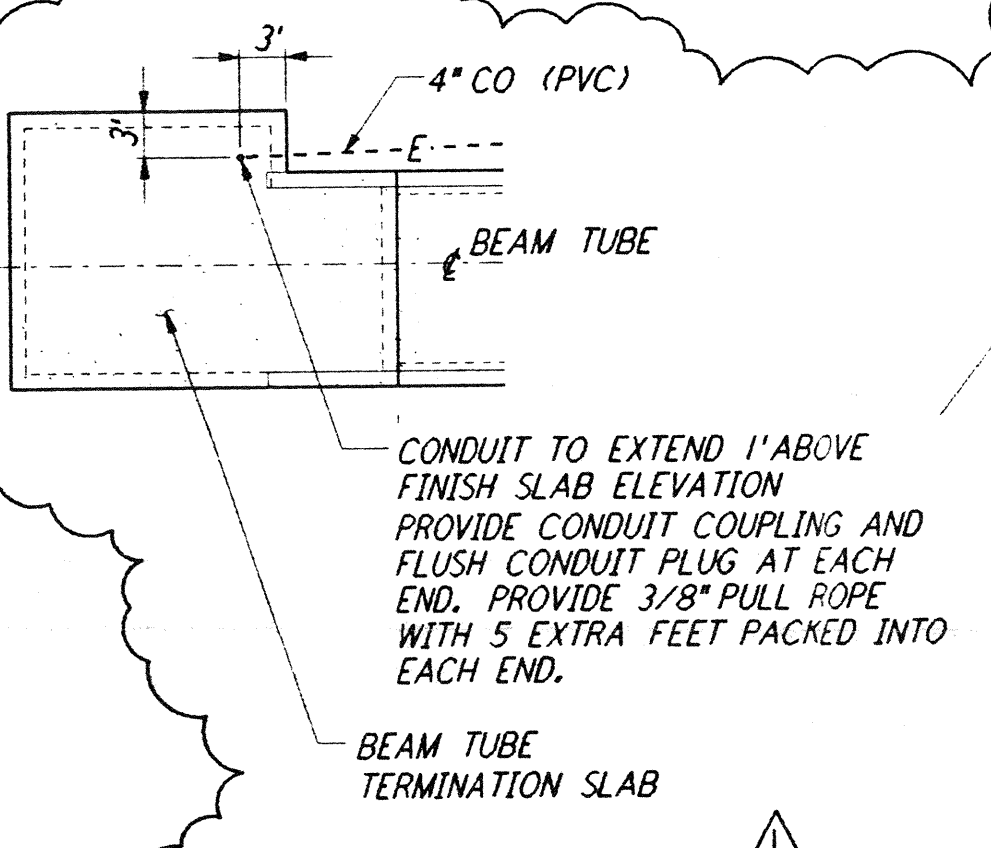

NO.	DATE	BY	CHKD	ENGR	PROJ	DESCRIPTION
1	2-29-96	WRB				CHANGE ORDER NO. 2

ISSUED FOR CONSTRUCTION	DRAWN	DATE
WRB	WRB	1-19-96
MP	MP	1-19-96
JB	JB	1-19-96
MDW	MDW	1-19-96

*John M. ...*  
12/96

**PARSONS**  
100 WEST WALNUT STREET  
PASADENA, CALIFORNIA

**LIGO**  
CALIFORNIA INSTITUTE OF TECHNOLOGY  
MASSACHUSETTS INSTITUTE OF TECHNOLOGY

LASER INTERFEROMETER  
GRAVITATIONAL-WAVE OBSERVATORY  
BTE SITESWORK & FABRICATION - HANFORD, WA

TITLE: CIVIL CORNER STATION PLAN  
SCALE: 1" = 50'  
PROJECT NUMBER: PP150969  
SHEET NUMBER: BT-C-005  
REVISIONS: 8094

LIGO-D960165-01-01  
LIC06TF3.BDR

NO.	DATE	BY	CHKD	ENGR	PROJ	DESCRIPTION
1	3/27/96	WRB				