


5

4

3

2


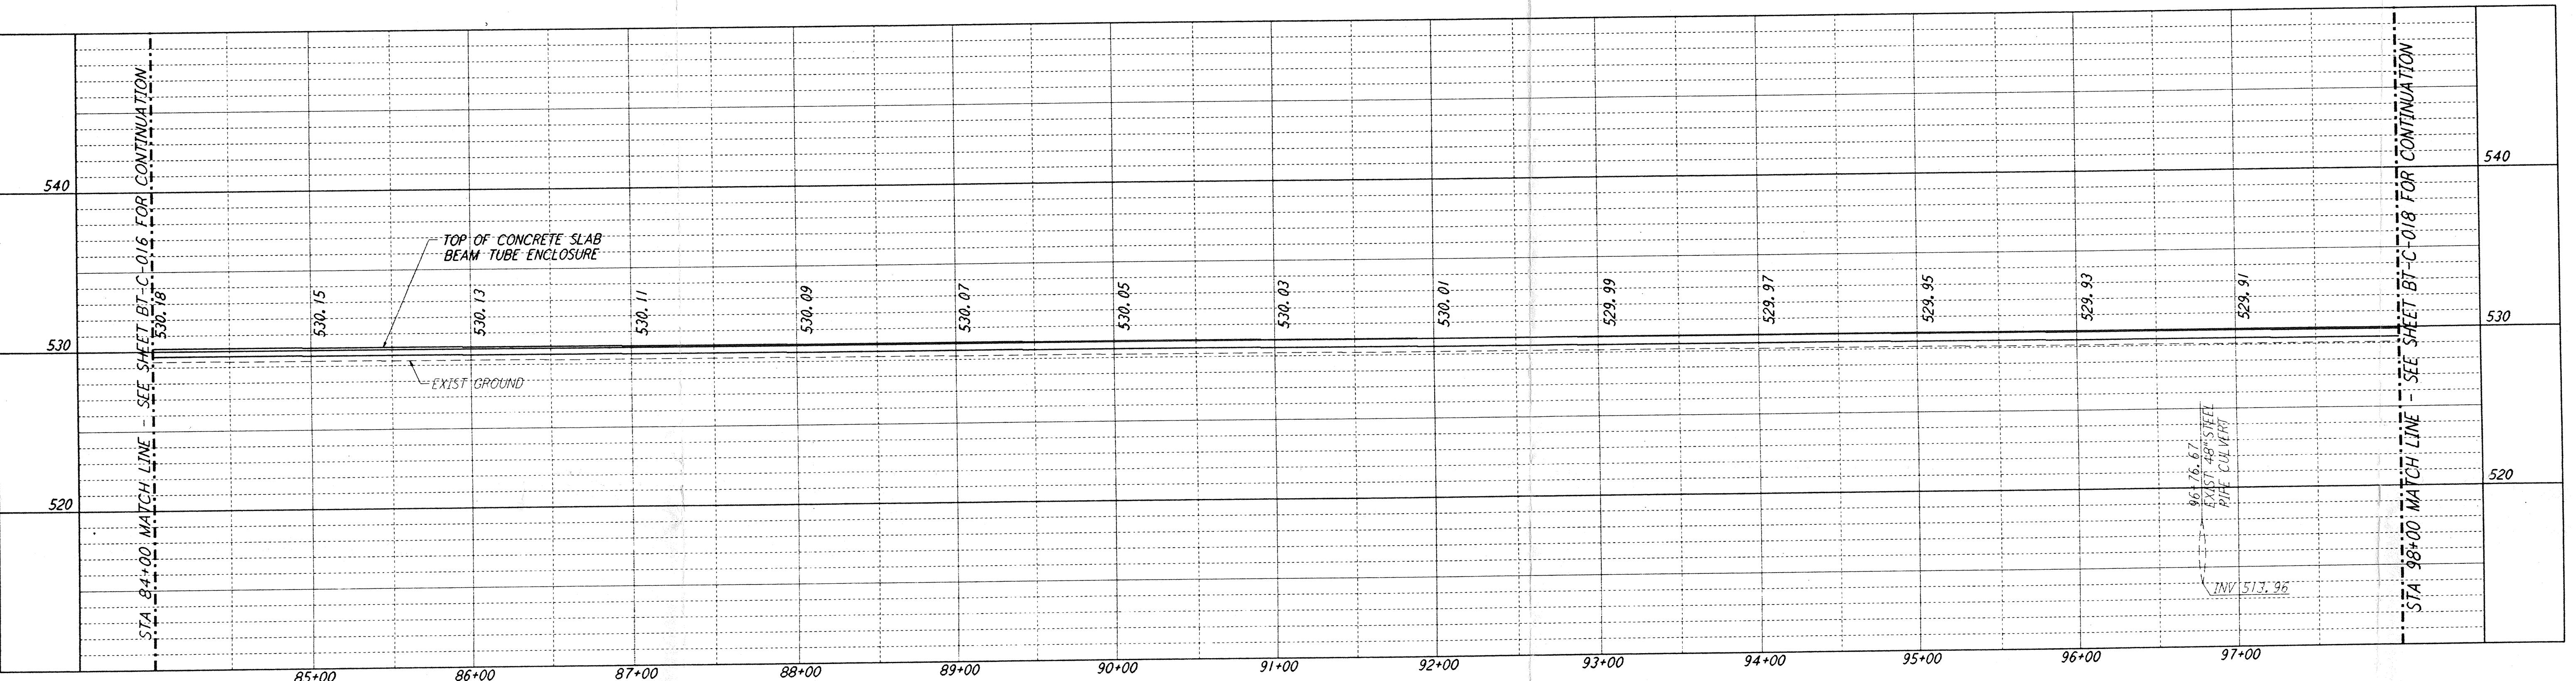


NOTES:

1. SEE SHEET BT-C-002 FOR GENERAL NOTES, LEGEND AND ABBREVIATIONS.
2. SEE SHEET BT-C-004 FOR TYPICAL SECTIONS AND DETAILS.

any other way, except by written consent from
PARSONS to the borrower.

This document contains LIGO property.
They are loaned only with the
borrower's expressed written agreement that they will
not be reproduced, except under conditions
of **PARSONS**.

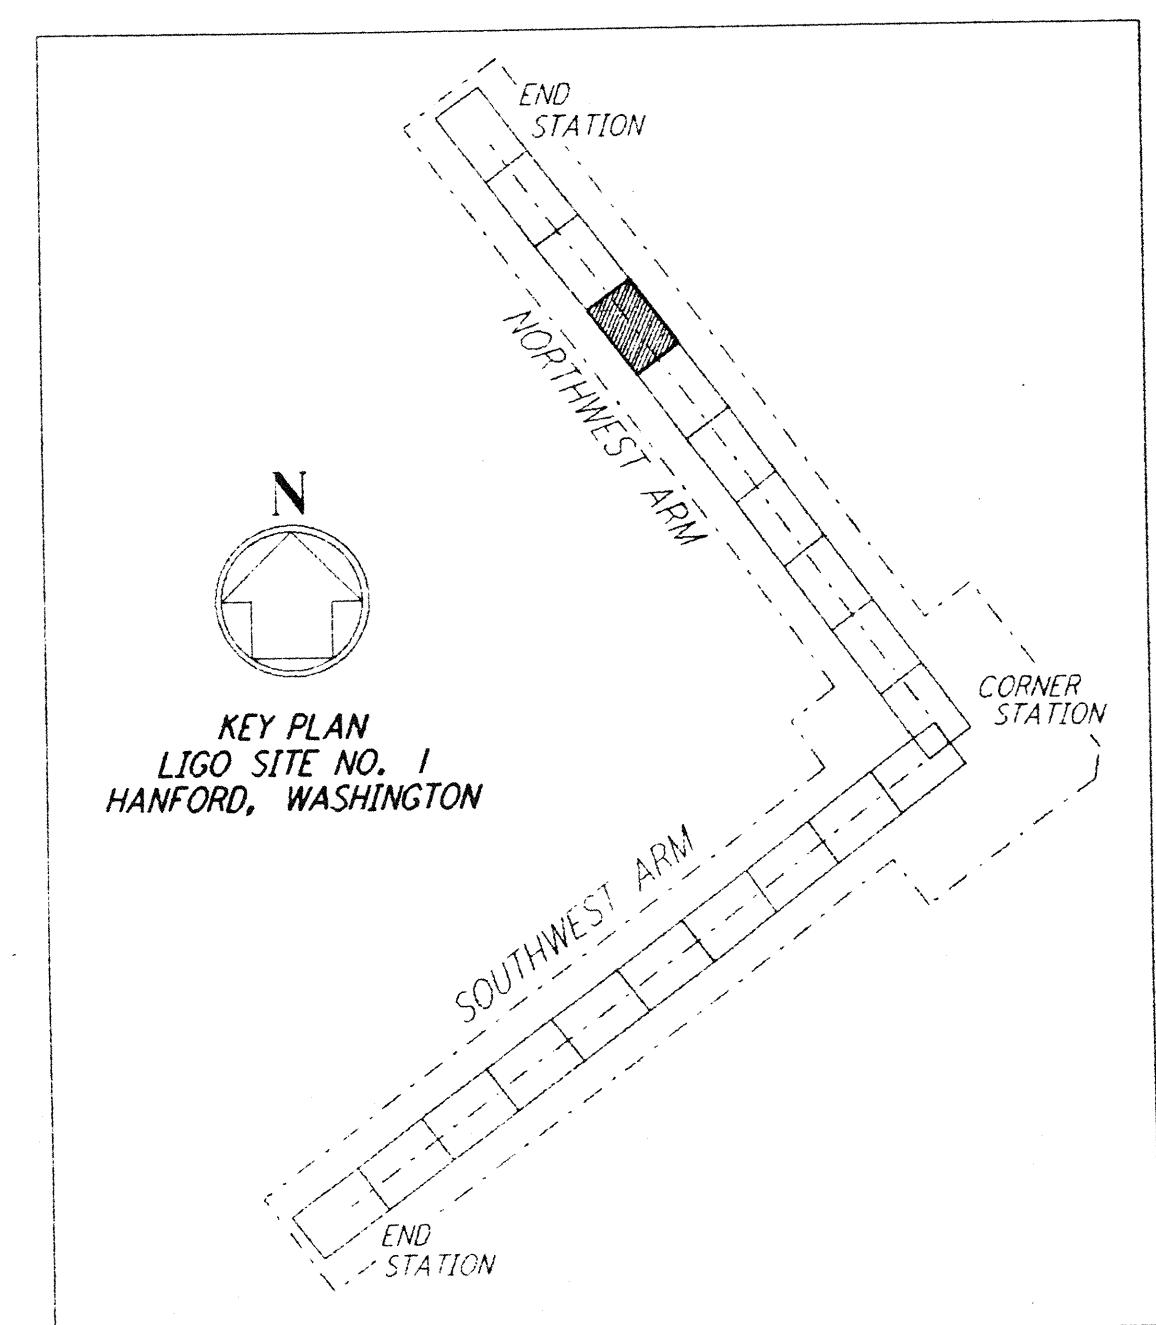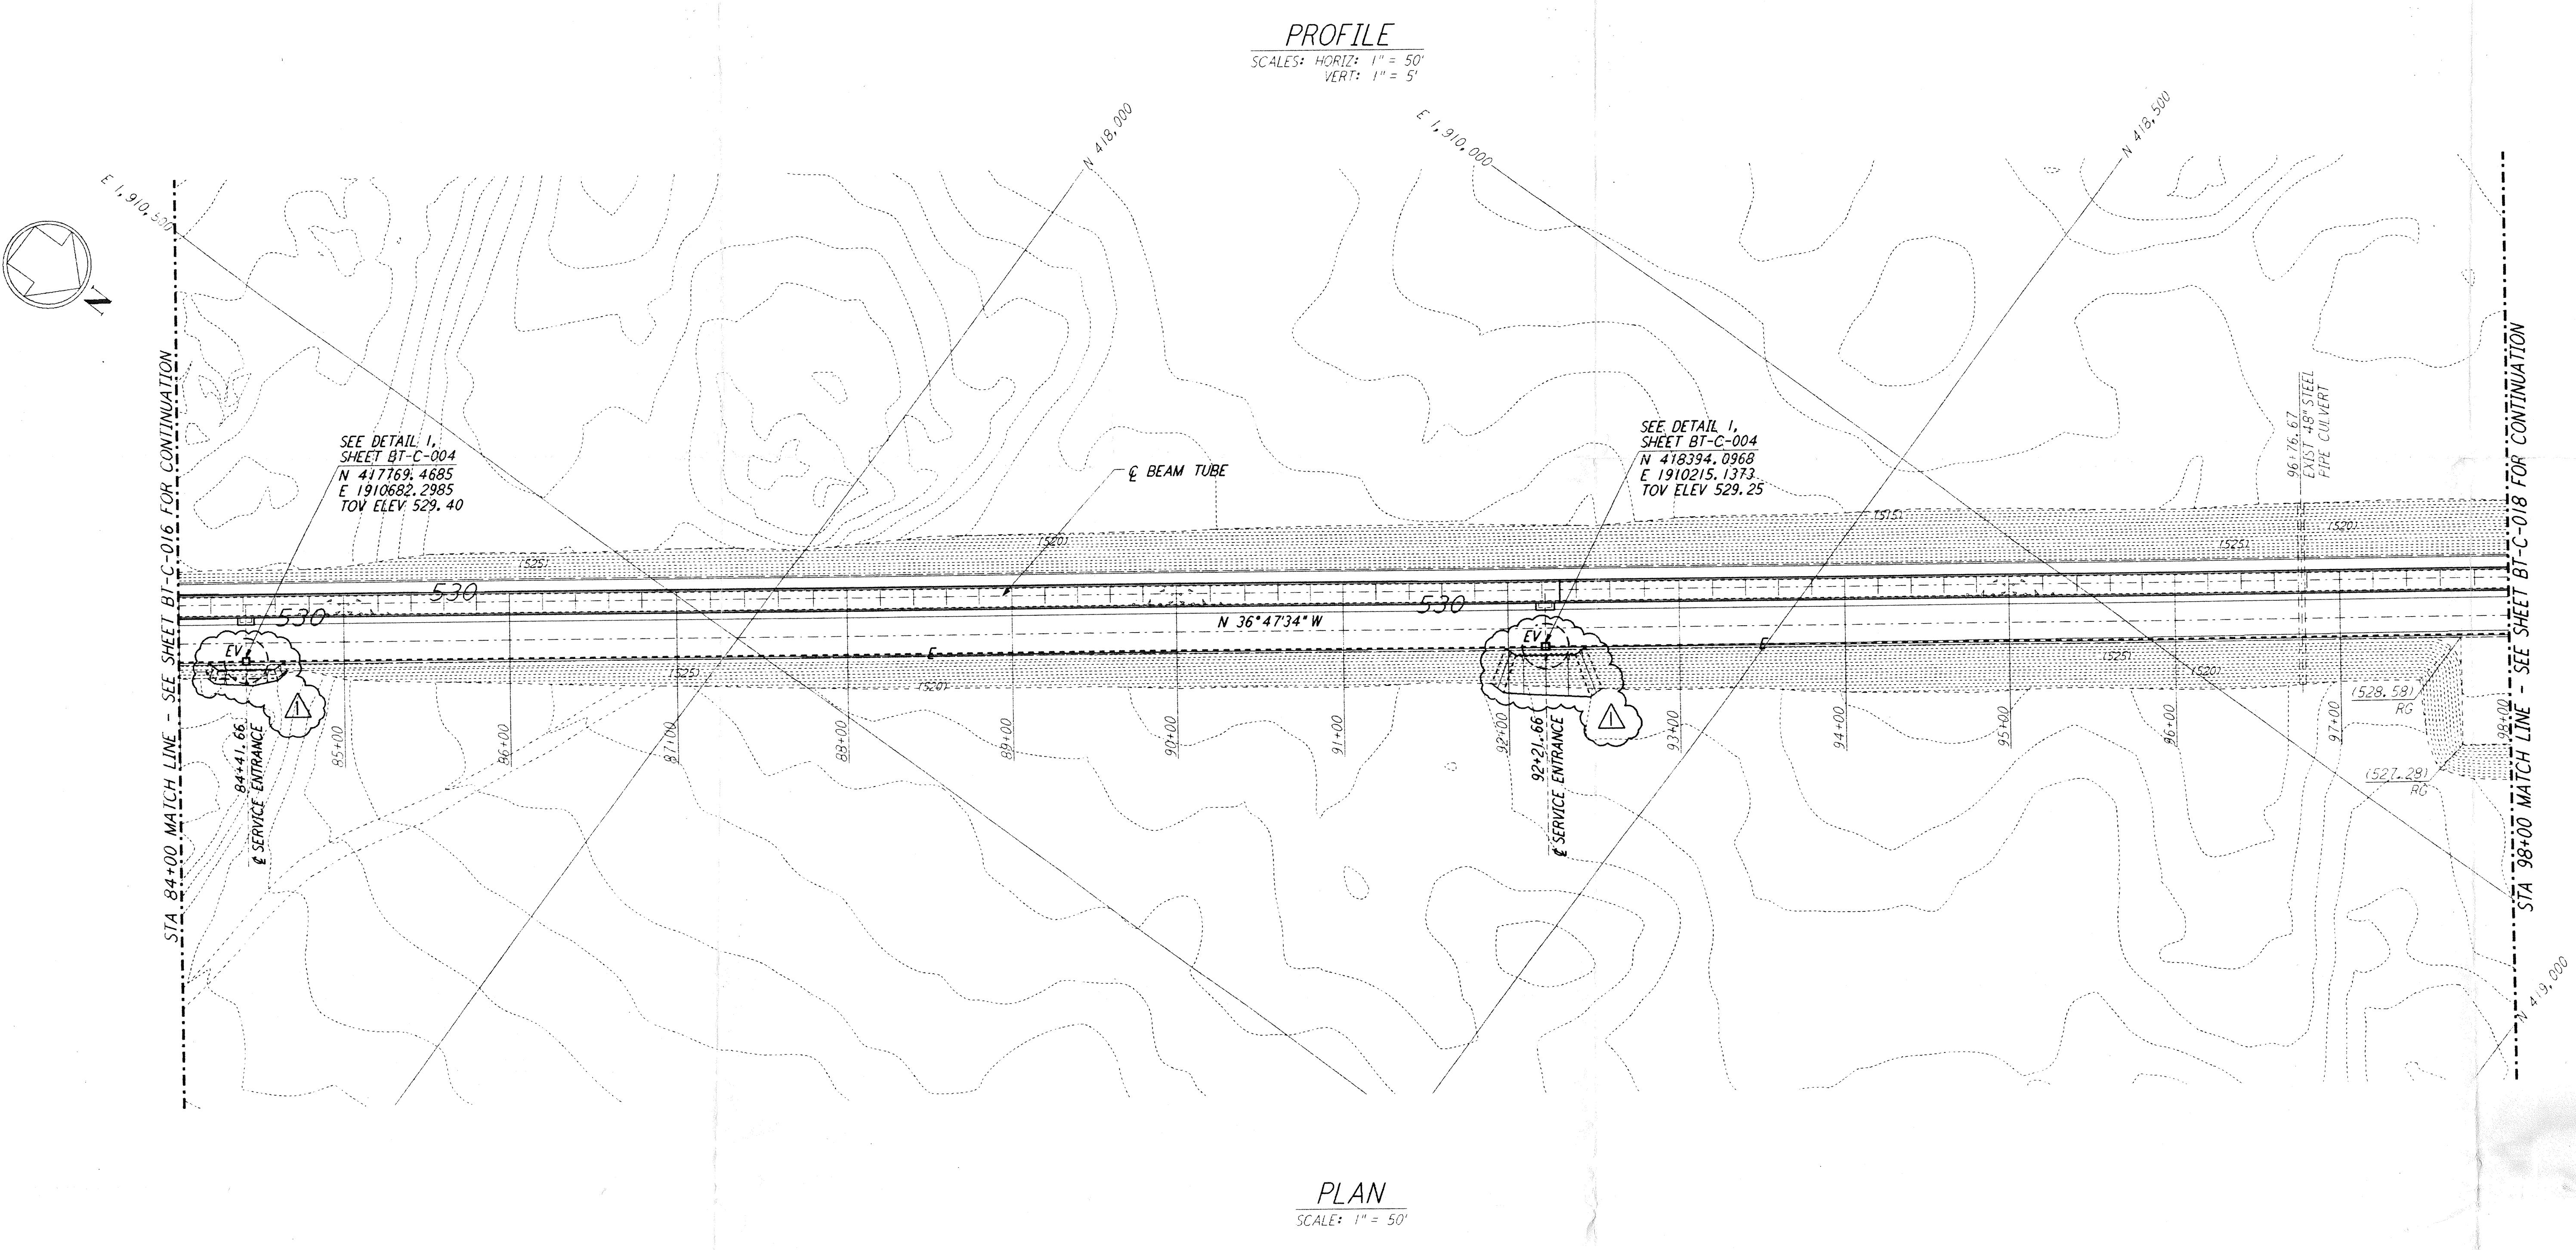

GRAPHIC SCALES
0 50 100 150 200
0 5 10 15 20
HORIZ SCALE: 1" = 50'
VERT SCALE: 1" = 5'

REFERENCE	REVISIONS	ISSUED FOR CONSTRUCTION					DRAWN BY	CHECKED BY	ENGINEERED BY	PROJ	NO.	DATE	WRB	CHKO	ENGR	PROJ	CHANGE ORDER NO.	DESCRIPTION
		DRAWN	WRB	1-19-96	CHECKED	MP												
		J. Parsons																

PLAN
SCALE: 1" = 50'

1/96

P PARSONS

100 WEST WALNUT STREET
PASADENA, CALIFORNIA

LIGO

CALIFORNIA INSTITUTE OF TECHNOLOGY
MASSACHUSETTS INSTITUTE OF TECHNOLOGY

LASER INTERFEROMETER
GRAVITATIONAL-WAVE OBSERVATORY
BTE SITESITE & FABRICATION - HANFORD, WA
TITLE: CIVIL NORTHWEST ARM PLAN AND PROFILE
STA 84+00 TO STA 98+00
SHEET NUMBER: AS NOTED PP150969 8094
REVISIONS: BT-C-017
Date Received: 3/25/96
Title #: LIGO
Date: / / Approved:
TDM #: LIGO-
Date: / / Approved:
Gen Transmittal: LIGO-
Date: / / Approved:

Date Received	Title #	Contractor #
3/25/96	LIGO	GT-C-017 Rev.1
	Date: / /	Approved:
	TDM #:	LIGO-
	Date: / /	Approved:
	Gen Transmittal:	LIGO-
	Date: / /	Approved:

5

4

3

2

A

C

B

D