
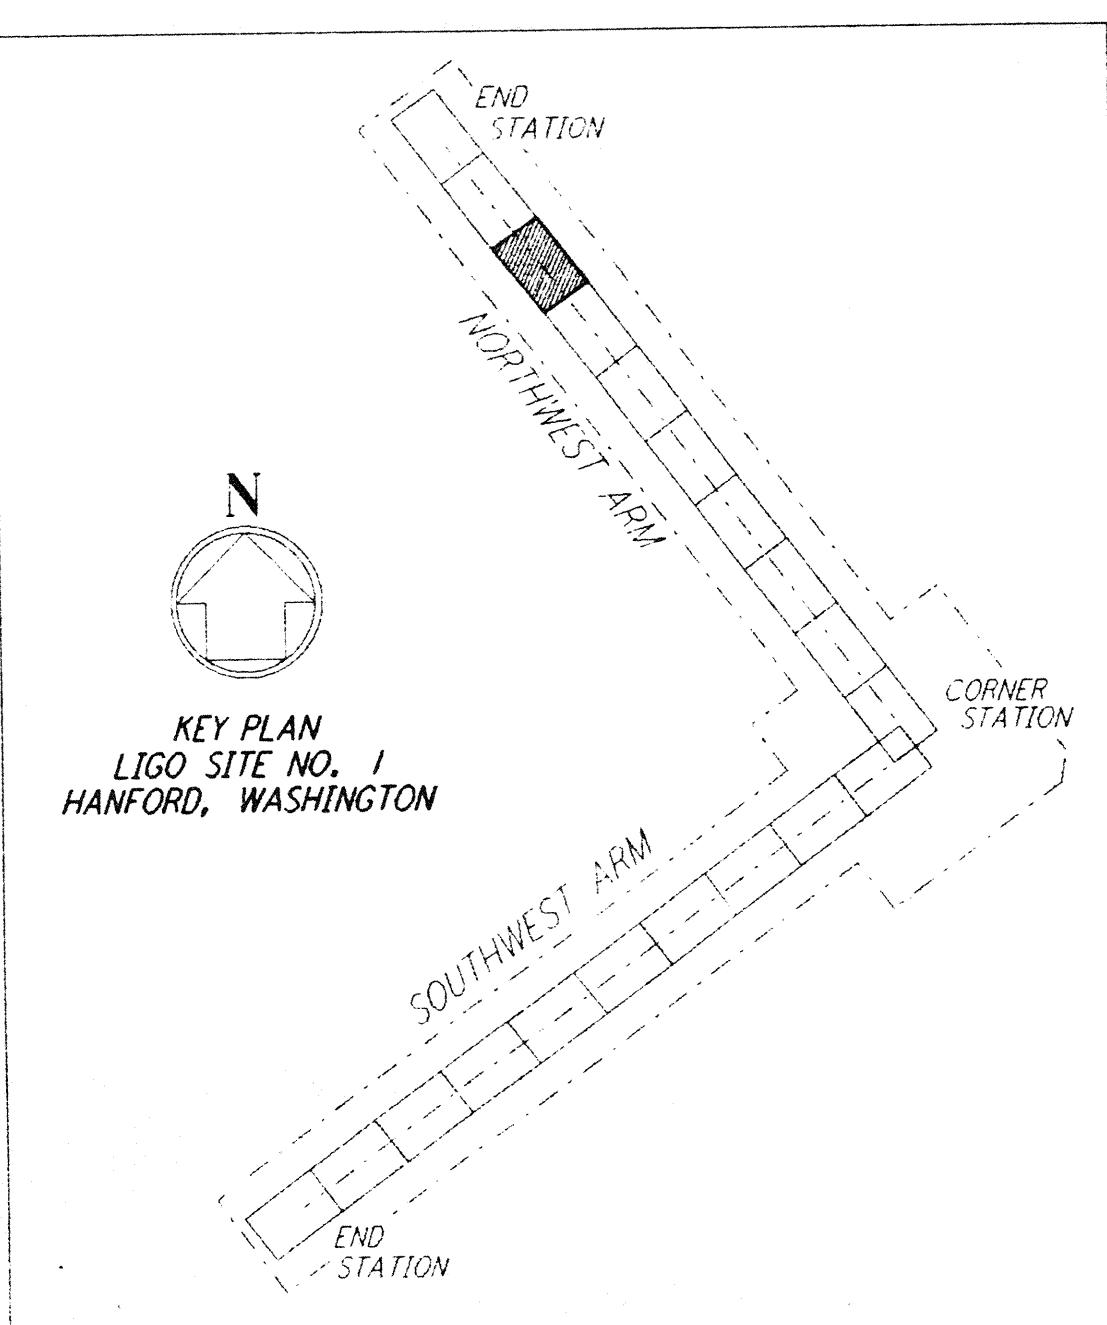


**NOTES:**  
1. SEE SHEET BT-C-002 FOR GENERAL NOTES, LEGEND AND ABBREVIATIONS.  
2. SEE SHEET BT-C-004 FOR TYPICAL SECTIONS AND DETAILS.

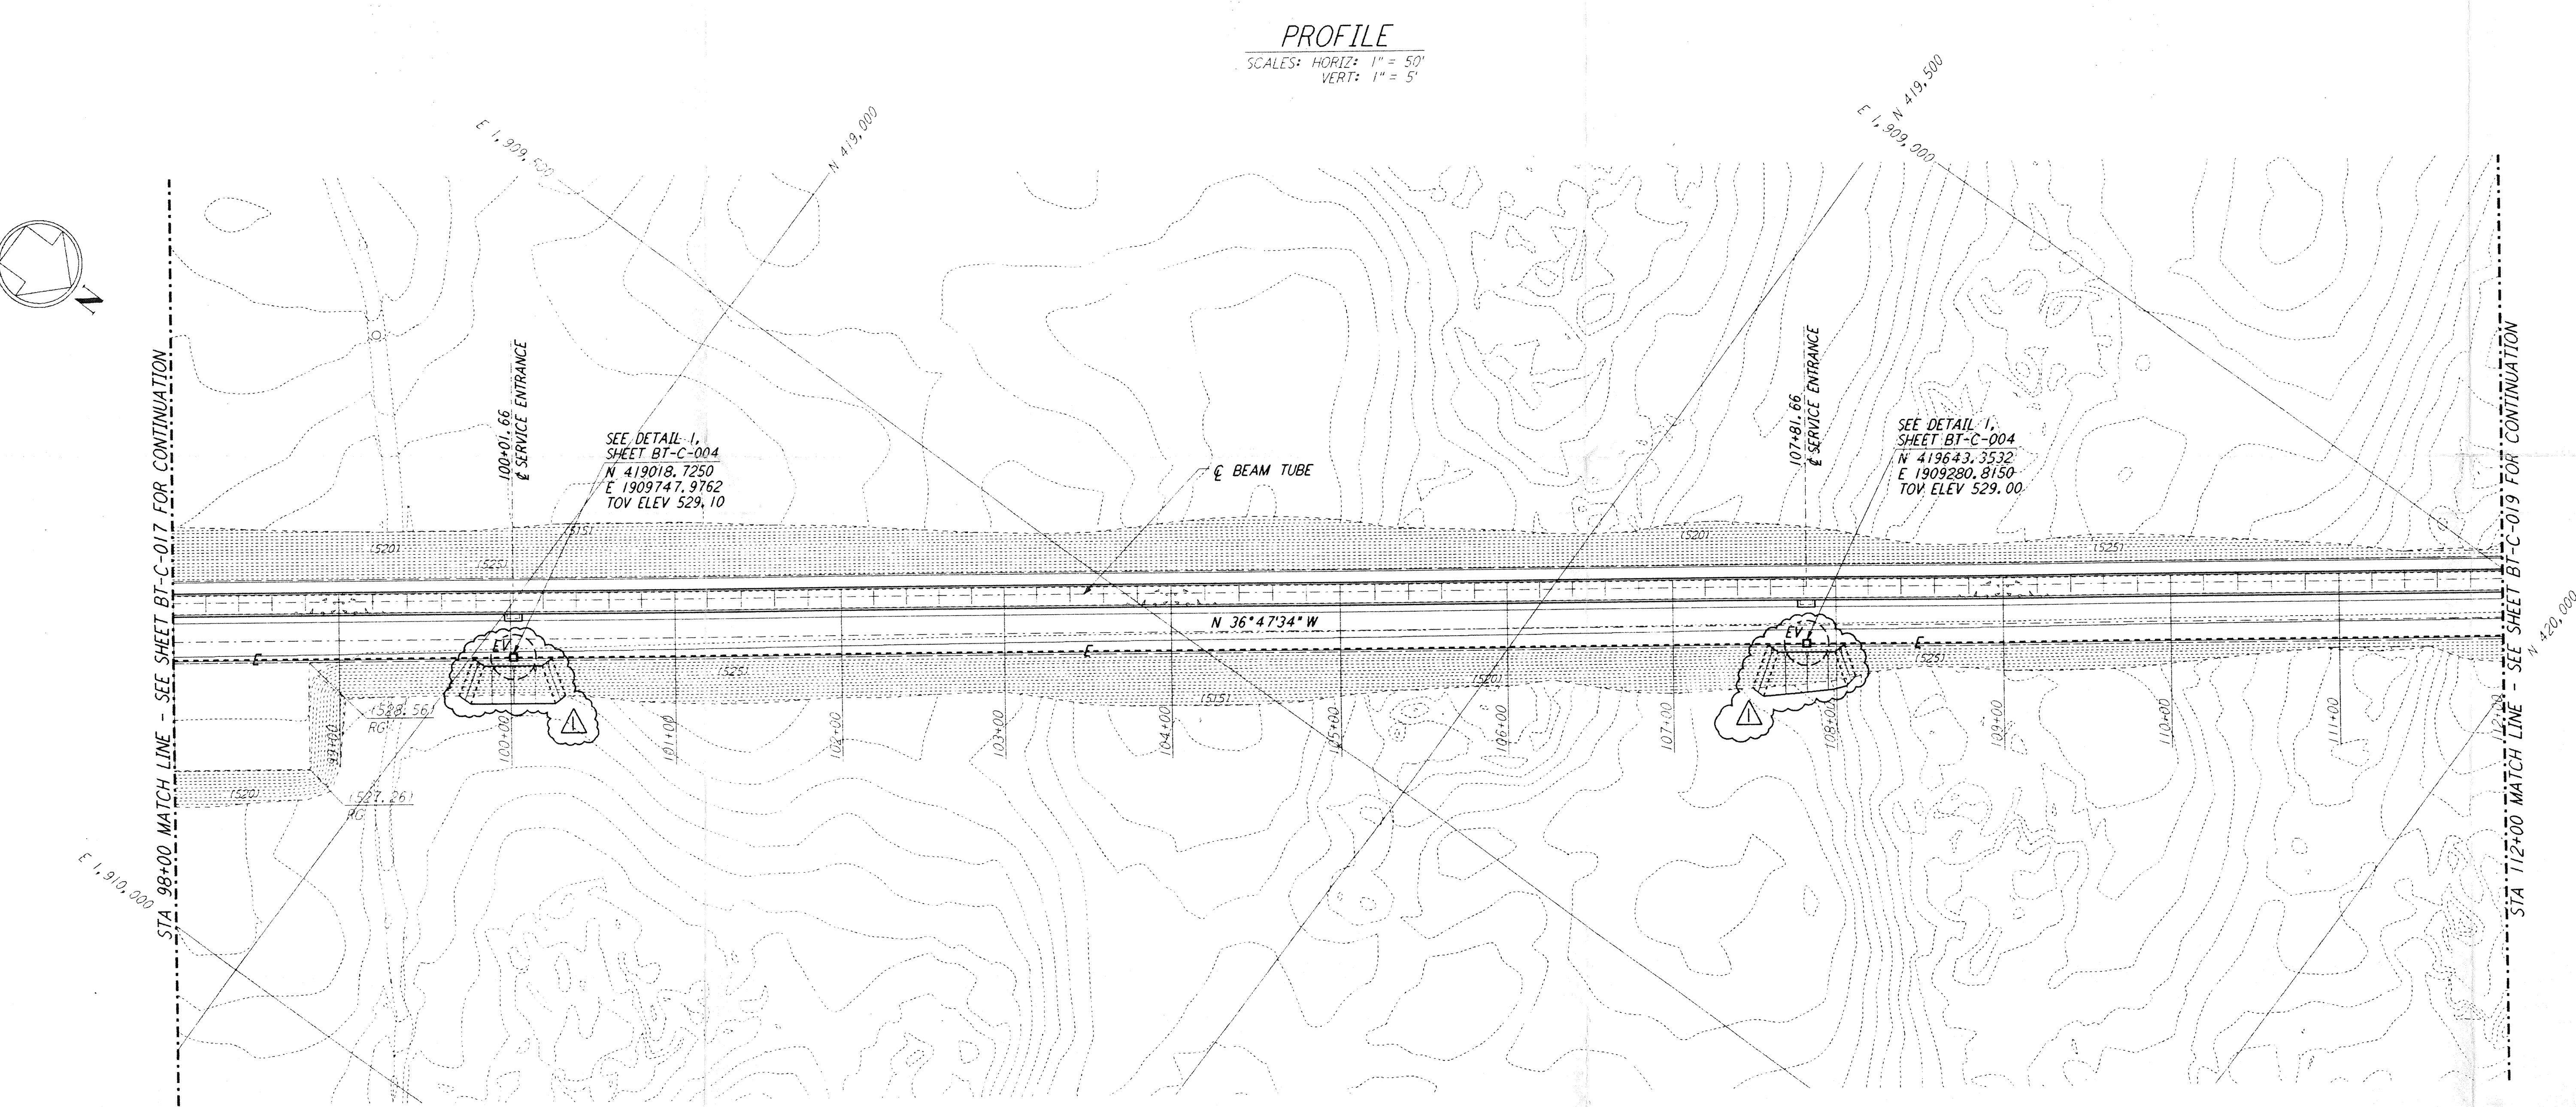

GRAPHIC SCALES  
0 50 100 150 200  
0 5 10 15 20  
HORIZ SCALE: 1" = 50'  
VERT SCALE: 1" = 5'

REFERENCES	REVISIONS	ISSUED FOR CONSTRUCTION				
		DRAWN	WRB	1-19-96	CHECKED	MP
		JOHN BLAND	1-19-96		1-19-96	
		PROJ	MOW	1-19-96		

CHANGE ORDER NO. 2  
NO. DATE BY CHKD ENGR PROJ  
1 2-29-96 WRB C JBL

ISSUED FOR CONSTRUCTION  
DRAWN WRB 1-19-96  
CHECKED MP 1-19-96  
ENGINEER JB 1-19-96  
PROJ MOW 1-19-96

PLAN  
SCALE: 1" = 50'

John Bland  
1/86

**PARSONS**  
100 WEST WALNUT STREET  
PASADENA, CALIFORNIA

**LIGO**  
CALIFORNIA INSTITUTE OF TECHNOLOGY  
MASSACHUSETTS INSTITUTE OF TECHNOLOGY

LASER INTERFEROMETER  
GRAVITATIONAL-WAVE OBSERVATORY  
BTE SITWORK & FABRICATION - HANFORD, WA  
TITLE: CIVIL NORTHWEST ARM PLAN AND PROFILE  
SHEET NUMBER: AS NOTED PP150969 8094  
PROJECT NUMBER: BT-C-018  
REVISIONS: A  
Date Received: 3/25/96  
Comments: LIGO-  
TIN #: LIGO-  
Date: / / Approved:  
TDN #: LIGO-  
Date: / / Approved:  
Gen Transmittal: LIGO-  
Date: / / Approved:

LIGO-D960173-01-D  
LIGOTF3.6DR