


## NOTES:

- SEE SHEET BT-C-002 FOR GENERAL NOTES, LEGEND AND ABBREVIATIONS.
- SEE SHEET BT-C-004 FOR TYPICAL SECTIONS AND DETAILS.

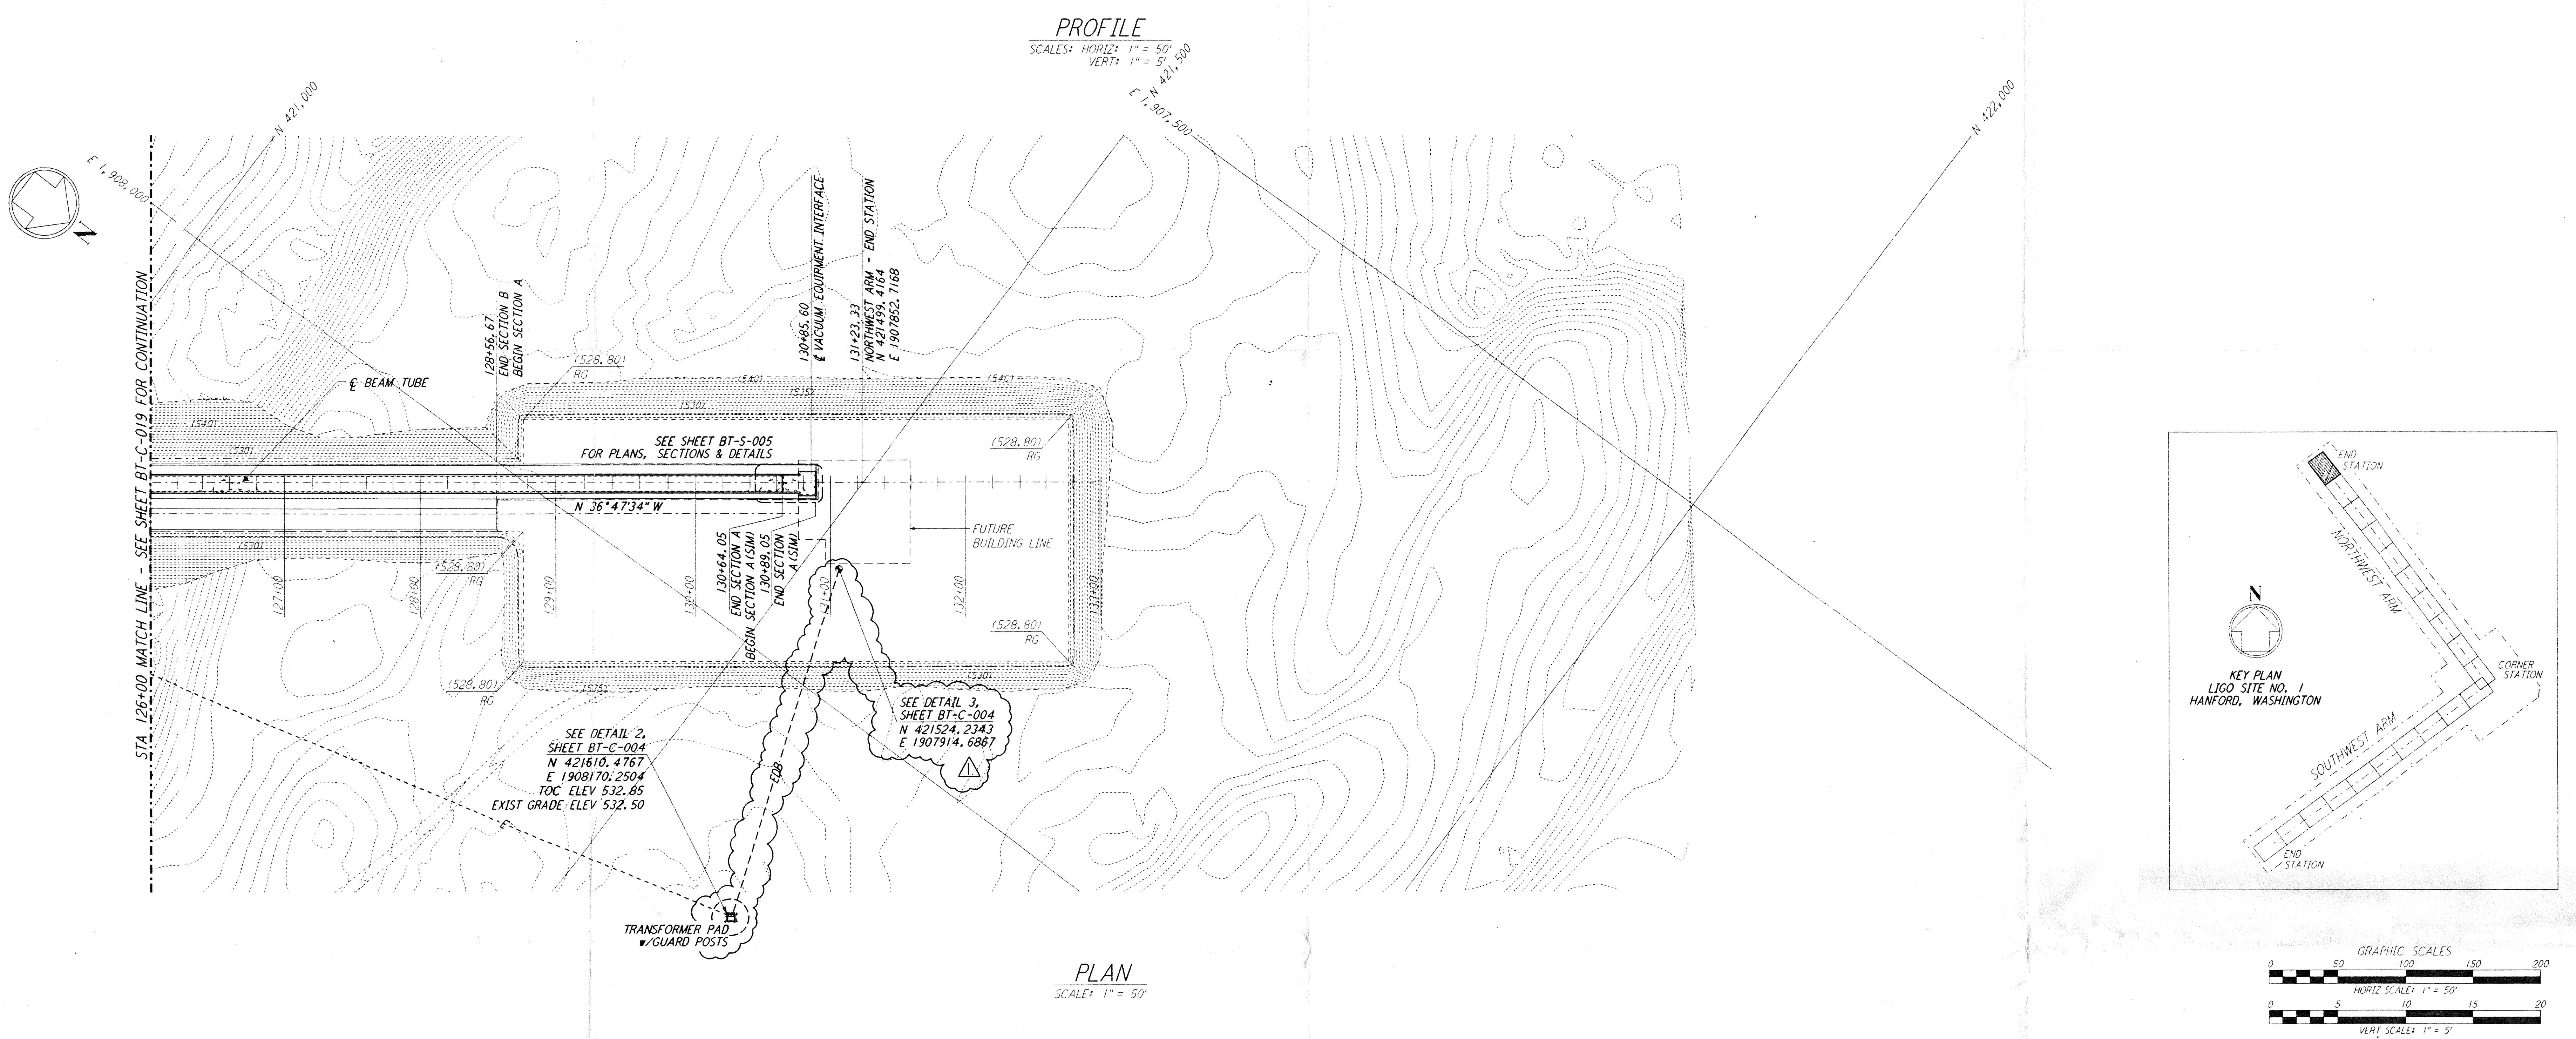


REFERENCES

		REVISIONS							
DRAWING NO.	DESCRIPTION								
NO.	DATE	WRB	CHKD	LENGR	PROJ	CHANGE ORDER NO. 2	DESCRIPTION		

ISSUED FOR CONSTRUCTION	
DRAWN	WRB
CHECKED	MP
ENGINEER	JB
PROJ	MOW

1-19-96

*J. Blane Blane*  
1-19-96

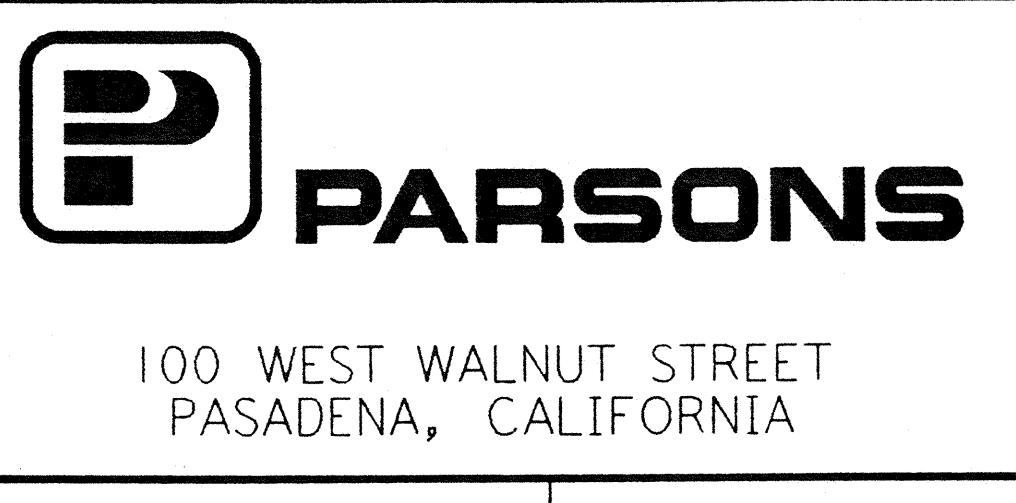

LIGO

CALIFORNIA INSTITUTE OF TECHNOLOGY  
MASSACHUSETTS INSTITUTE OF TECHNOLOGY

LASER INTERFEROMETER  
GRAVITATIONAL-WAVE OBSERVATORY  
BTE SITWORK & FABRICATION - HANFORD, WA

TITLE	SCALE	CONTRACT NUMBER	PROJECT NUMBER
CIVIL	AS NOTED	PP150969	8094
NORTHWEST ARM	SHEET NUMBER		
PLAN AND PROFILE	REVISIONS		
STA 126+00 TO STA 133+00			
B T - C - 020			

Date Received: 3/25/96  
LIGO-0150960175-01-0  
Contractor #: BT-C-020 Rev. 1

TIME: / / Approved:  
TDM #: / / Approved:  
Date: / / Approved:  
Gen'l Transmittal: / / Approved:  
Date: / / Approved:

1 LIGO-D160175-01-0