This document and the design it covers are the property of PARSONS. They are loaned only with the borrower's expressed written agreement that they will not be reproduced, copied, loaned, exhibited, or used in any other way, except by written consent from PARSONS to the borrower.

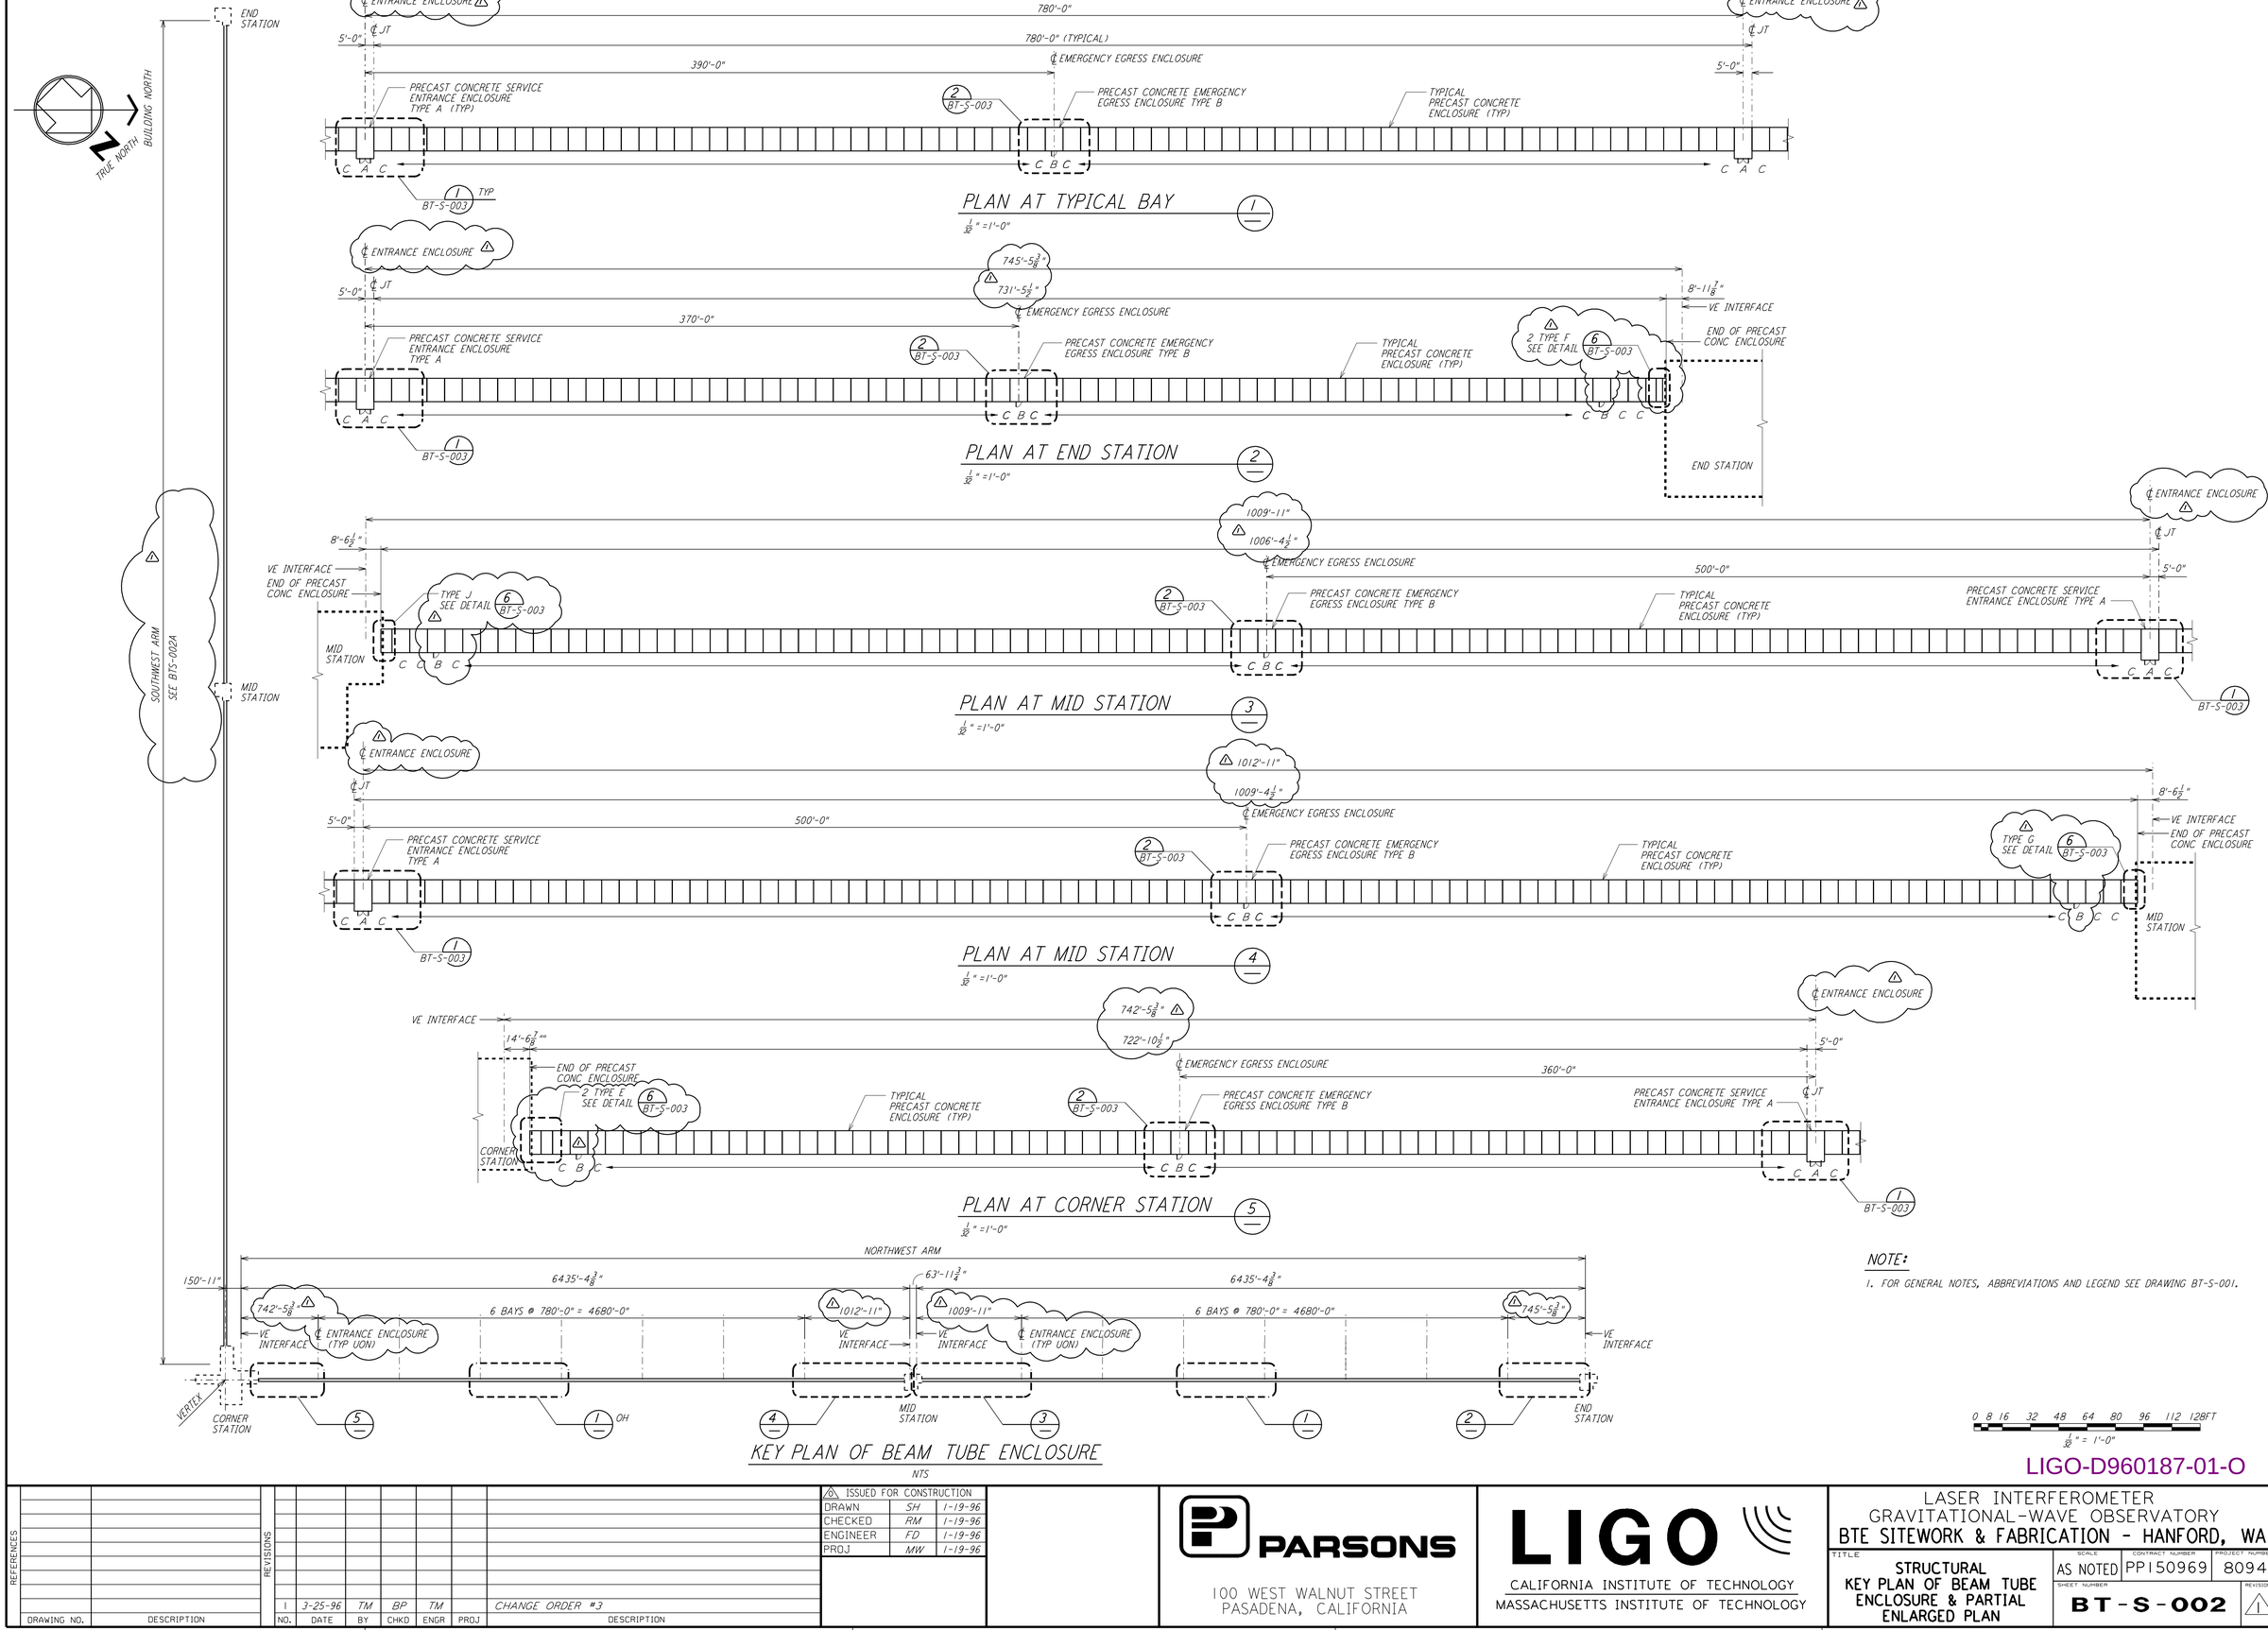

NOTE:

1. FOR GENERAL NOTES, ABBREVIATIONS AND LEGEND SEE DRAWING BT-S-001.

0 8 16 32 48 64 80 96 112 128FT
1/32" = 1'-0"

LIGO-D960187-01-O

REFERENCES		REVISIONS						
		1	3-25-96	TM	BP	TM		CHANGE ORDER #3
DRAWING NO.	DESCRIPTION	NO.	DATE	BY	CHKD	ENGR	PROJ	DESCRIPTION

ISSUED FOR CONSTRUCTION		
DRAWN	SH	1-19-96
CHECKED	RM	1-19-96
ENGINEER	FD	1-19-96
PROJ	MW	1-19-96

PARSONS
100 WEST WALNUT STREET
PASADENA, CALIFORNIA

LIGO
CALIFORNIA INSTITUTE OF TECHNOLOGY
MASSACHUSETTS INSTITUTE OF TECHNOLOGY

LASER INTERFEROMETER GRAVITATIONAL-WAVE OBSERVATORY
BTE SITEWORK & FABRICATION - HANFORD, WA

TITLE: STRUCTURAL KEY PLAN OF BEAM TUBE ENCLOSURE & PARTIAL ENLARGED PLAN

SCALE	CONTRACT NUMBER	PROJECT NUMBER
AS NOTED	PP150969	8094

SHEET NUMBER: BT-S-002
REVISIONS: 1

LIGOBTF.BDR

Fri Sep 11 12:02:57 1998 c:\plot\scf\S3-30.scf N:\DUE\ES\E30B2\STB002.PRF