



This document and the design it covers are the property of PARSONS. They are loaned only with the borrower's expressed written agreement that they will not be reproduced, copied, loaned, exhibited, or used in any other way, except by written consent from PARSONS to the borrower.

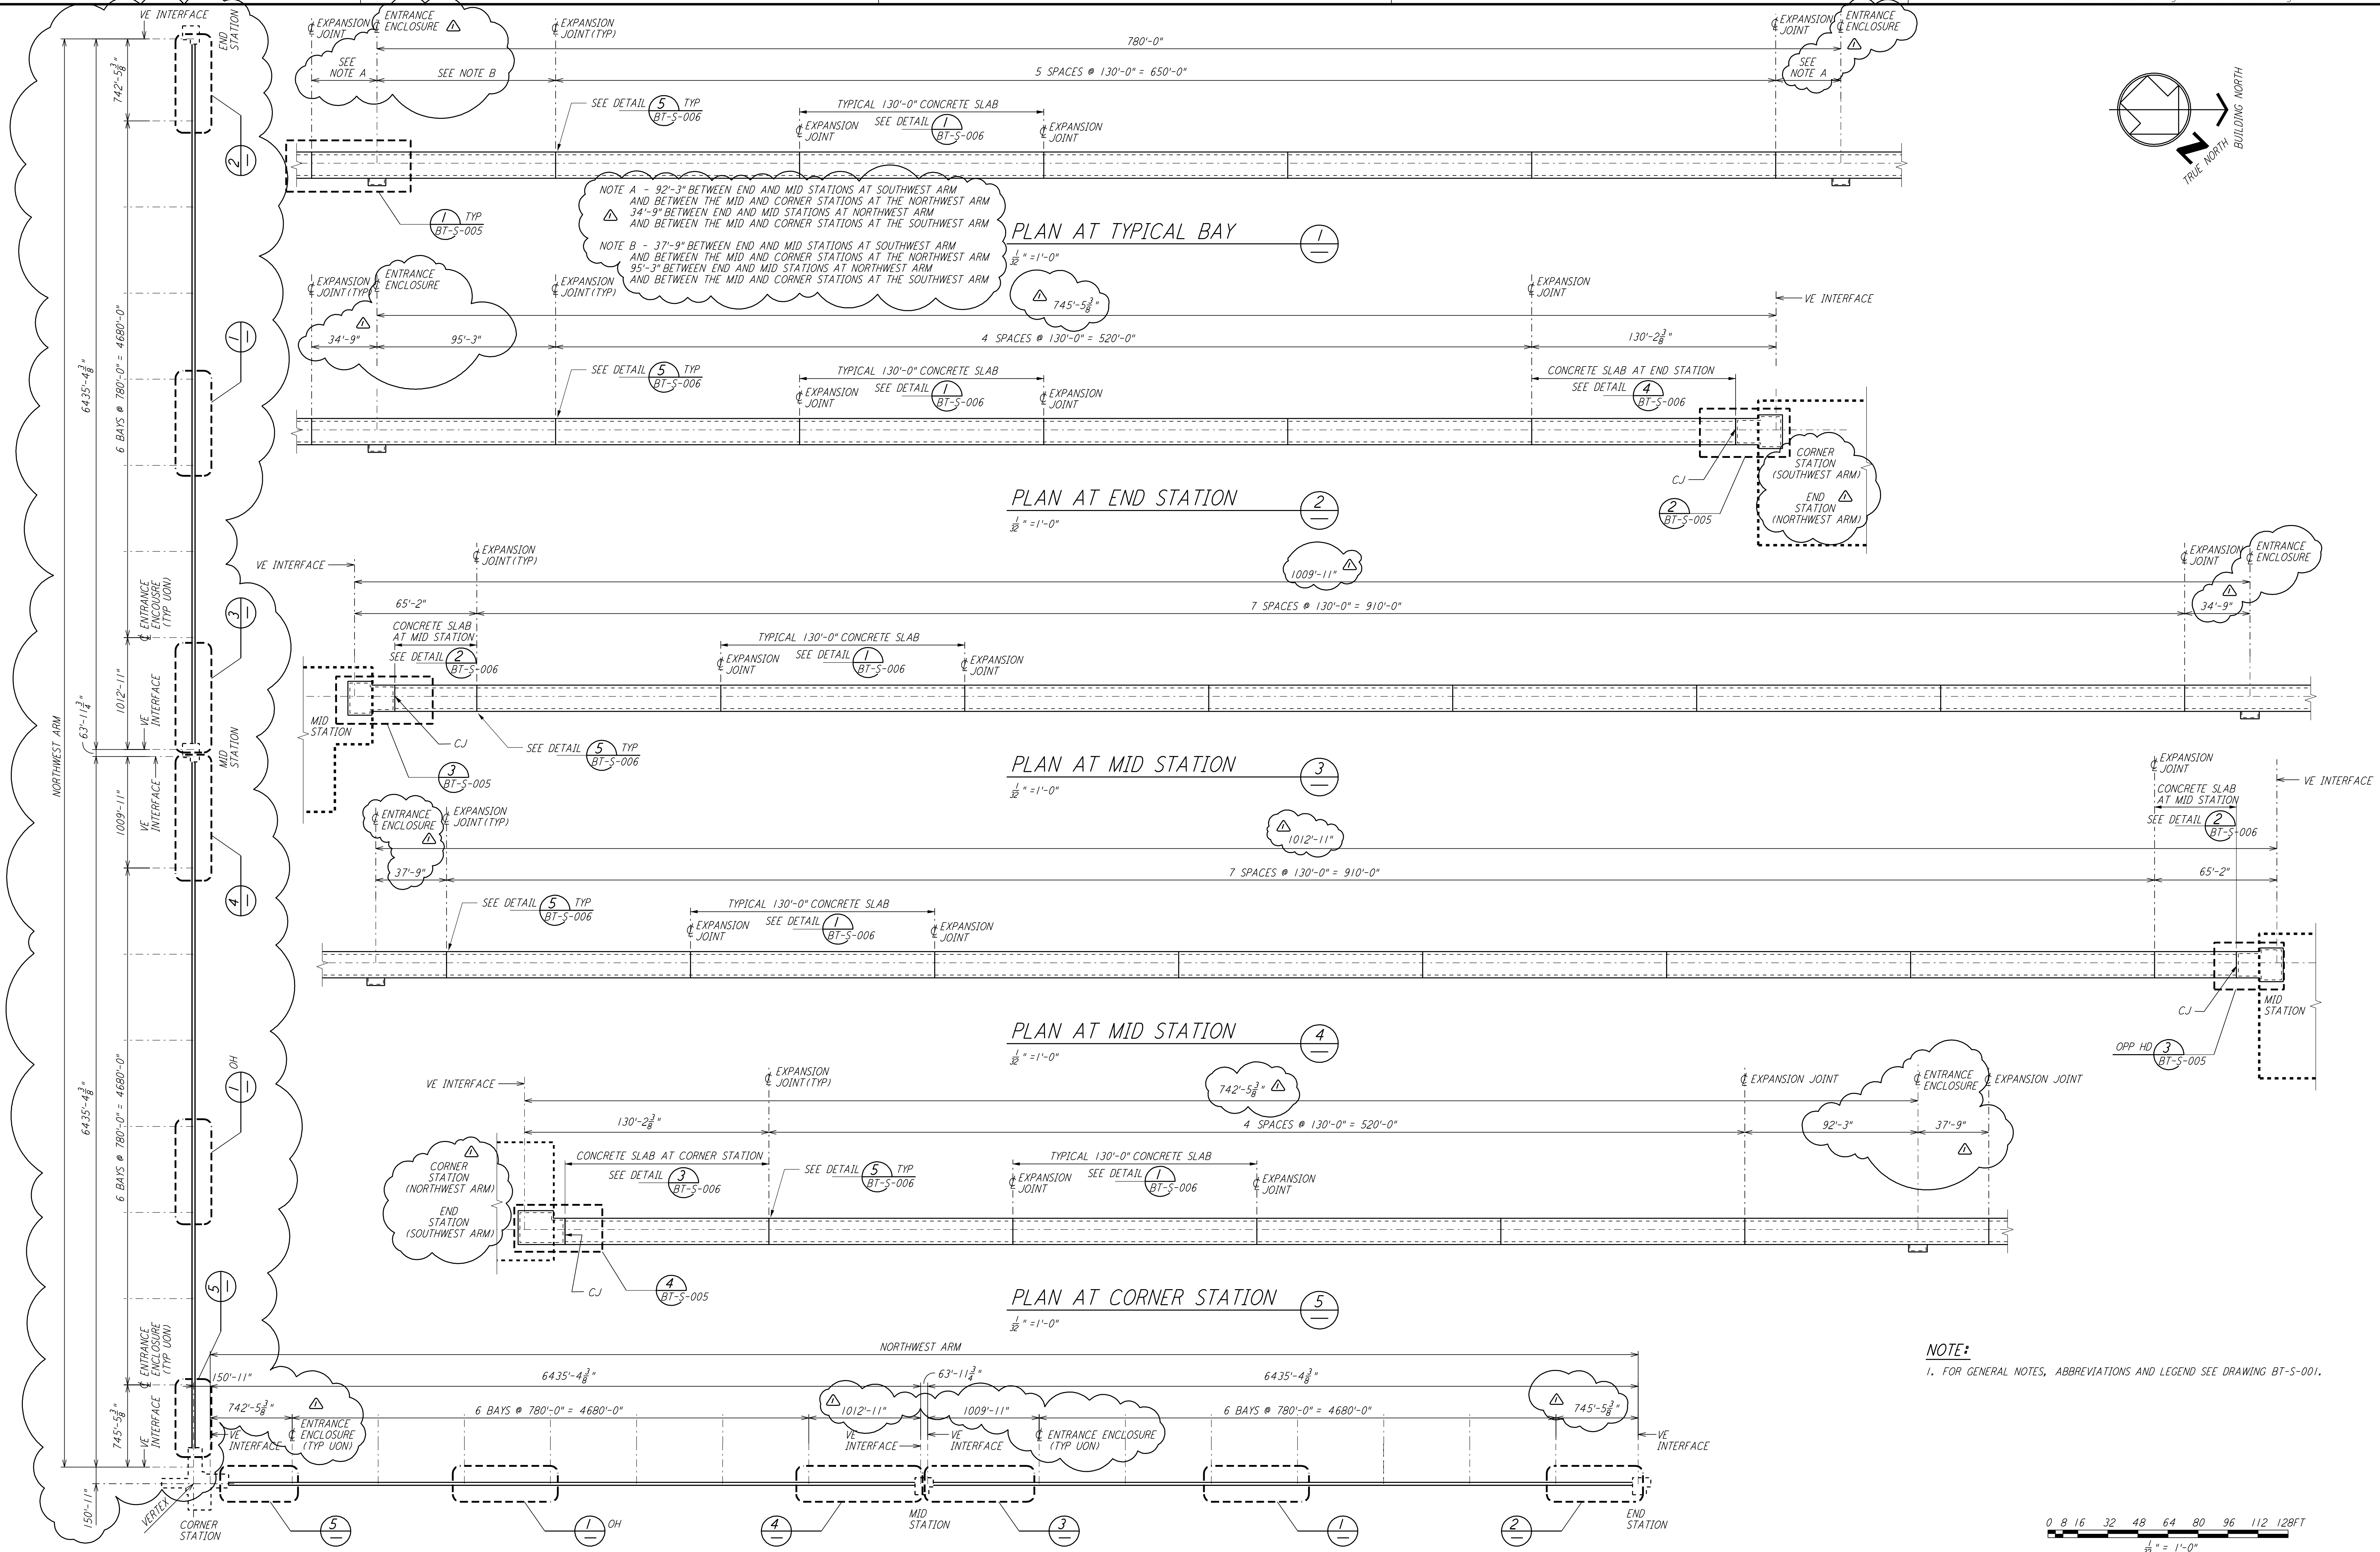

NOTE:
 1. FOR GENERAL NOTES, ABBREVIATIONS AND LEGEND SEE DRAWING BT-S-001.

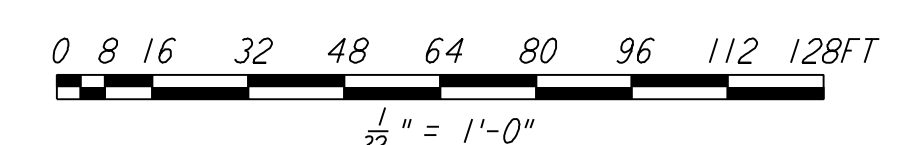

KEY PLAN OF BEAM TUBE ENCLOSURE FOUNDATION

NO.	DATE	BY	CHKD	ENGR	PROJ	DESCRIPTION
1	3-25-96	TM	BP	TM		CHANGE ORDER #3

ISSUED FOR CONSTRUCTION			
DRAWN	SH	1-19-96	
CHECKED	RM	1-19-96	
ENGINEER	FD	1-19-96	
PROJ	MW	1-19-96	

PARSONS
 100 WEST WALNUT STREET
 PASADENA, CALIFORNIA

LIGO
 CALIFORNIA INSTITUTE OF TECHNOLOGY
 MASSACHUSETTS INSTITUTE OF TECHNOLOGY

LIGO-D960190-01-0
 LASER INTERFEROMETER
 GRAVITATIONAL-WAVE OBSERVATORY
 BTE SITework & FABRICATION - HANFORD, WA

TITLE	SCALE	CONTRACT NUMBER	PROJECT NUMBER						
STRUCTURAL KEY PLAN OF BEAM TUBE ENCLOSURE FDN & PARTIAL ENLARGED PLANS	AS NOTED	PP150969	8094						
SHEET NUMBER	REVISIONS								
BT-S-004	<table border="1"> <tr> <td>NO.</td> <td>DATE</td> <td>DESCRIPTION</td> </tr> <tr> <td> </td> <td> </td> <td> </td> </tr> </table>			NO.	DATE	DESCRIPTION			
NO.	DATE	DESCRIPTION							