This document and the design it covers are the property of PARSONS. They are loaned only with the borrower's expressed written agreement that they will not be reproduced, copied, loaned, exhibited, or used in any other way, except by written consent from PARSONS to the borrower.

DRAWING INDEX

DRAWING NUMBER	DRAWING TITLE
WA-C-001	DRAWING INDEX, LOCATION & VICINITY MAPS
WA-C-002	GENERAL NOTES, LEGEND & ABBREVIATIONS
WA-C-003	DRAWING MATRIX
WA-C-004	TYPICAL SECTIONS AND DETAILS
WA-C-505	CORNER STATION PLOT PLAN
WA-C-006	CORNER STATION PLOT PLAN, ENLARGED PLANS
WA-C-507	CORNER STATION GRADING PLAN
WA-C-008	CORNER STATION GRADING PLAN, ENLARGED PLANS
WA-C-509	CORNER STATION UTILITY PLAN
WA-C-510	CORNER STATION UTILITY PLAN, ENLARGED PLANS
WA-C-011	NORTHWEST ARM, PLAN AND PROFILE, STA 0+00 TO 14+00
WA-C-012	NORTHWEST ARM, PLAN AND PROFILE, STA 14+00 TO 28+00
WA-C-013	NORTHWEST ARM, PLAN AND PROFILE, STA 28+00 TO 42+00
WA-C-014	NORTHWEST ARM, PLAN AND PROFILE, STA 42+00 TO 56+00
WA-C-015	NORTHWEST ARM, PLAN AND PROFILE, STA 56+00 TO 70+00
WA-C-016	NORTHWEST ARM, PLAN AND PROFILE, STA 70+00 TO 84+00
WA-C-017	NORTHWEST ARM, PLAN AND PROFILE, STA 84+00 TO 98+00
WA-C-018	NORTHWEST ARM, PLAN AND PROFILE, STA 98+00 TO 112+00
WA-C-019	NORTHWEST ARM, PLAN AND PROFILE, STA 112+00 TO 126+00
WA-C-020	NORTHWEST ARM, PLAN AND PROFILE, STA 126+00 TO 133+00
WA-C-021	NORTHWEST ARM, MID-STATION, PLOT PLAN
WA-C-022	NORTHWEST ARM, MID-STATION, GRADING PLAN
WA-C-023	NORTHWEST ARM, MID-STATION, UTILITY PLAN
WA-C-025	NORTHWEST ARM, END-STATION, PLOT PLAN
WA-C-026	NORTHWEST ARM, END-STATION, GRADING PLAN
WA-C-027	NORTHWEST ARM, END-STATION, UTILITY PLAN
WA-C-031	SOUTHWEST ARM, PLAN AND PROFILE, STA 0+00 TO 14+00
WA-C-032	SOUTHWEST ARM, PLAN AND PROFILE, STA 14+00 TO 28+00
WA-C-033	SOUTHWEST ARM, PLAN AND PROFILE, STA 28+00 TO 42+00
WA-C-034	SOUTHWEST ARM, PLAN AND PROFILE, STA 42+00 TO 56+00
WA-C-035	SOUTHWEST ARM, PLAN AND PROFILE, STA 56+00 TO 70+00
WA-C-036	SOUTHWEST ARM, PLAN AND PROFILE, STA 70+00 TO 84+00
WA-C-037	SOUTHWEST ARM, PLAN AND PROFILE, STA 84+00 TO 98+00
WA-C-038	SOUTHWEST ARM, PLAN AND PROFILE, STA 98+00 TO 112+00
WA-C-039	SOUTHWEST ARM, PLAN AND PROFILE, STA 112+00 TO 126+00
WA-C-040	SOUTHWEST ARM, PLAN AND PROFILE, STA 126+00 TO 133+00
WA-C-041	SOUTHWEST ARM, MID-STATION, PLOT PLAN
WA-C-042	SOUTHWEST ARM, MID-STATION, GRADING PLAN
WA-C-043	SOUTHWEST ARM, MID-STATION, UTILITY PLAN
WA-C-045	SOUTHWEST ARM, END-STATION, PLOT PLAN
WA-C-046	SOUTHWEST ARM, END-STATION, GRADING PLAN
WA-C-047	SOUTHWEST ARM, END-STATION, UTILITY PLAN
WA-C-050	LIGO ACCESS ROAD, PLAN AND PROFILE
WA-C-051	SITEWORK DETAILS, SHEET 1
WA-C-052	SITEWORK DETAILS, SHEET 2
WA-C-053	GRADING SECTIONS & DETAILS, SHEET 1
WA-C-054	GRADING SECTIONS & DETAILS, SHEET 2
WA-C-055	UTILITY DETAILS, SHEET 1
WA-C-056	UTILITY DETAILS, SHEET 2
WA-C-057	UTILITY DETAILS, SHEET 3

LOCATION MAP
NOT TO SCALE

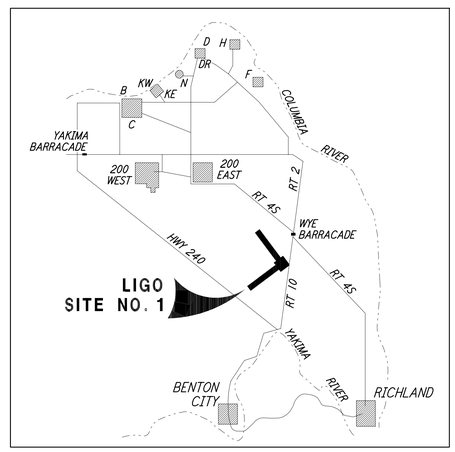

VICINITY MAP
NOT TO SCALE

COORDINATE TABLE & ELEVATIONS FOR LIGO GPS POINTS

GPS POINT	COORDINATES NORTH	COORDINATES EAST	ELEVATION
LIGO 1	421113.464	1907424.820	563.237
LIGO 2	416164.285	1912526.068	550.905
LIGO 3	410647.803	1916004.584	542.532
LIGO 4	407401.131	1909213.733	561.242
LIGO 5	403900.640	1905770.659	554.431
LIGO 6	413750.547	1904062.124	——

NOTE: GPS COORDINATE POINTS ARE HIGH ACCURACY, PLACED BY THE WSDOT GEOGRAPHIC SERVICES.

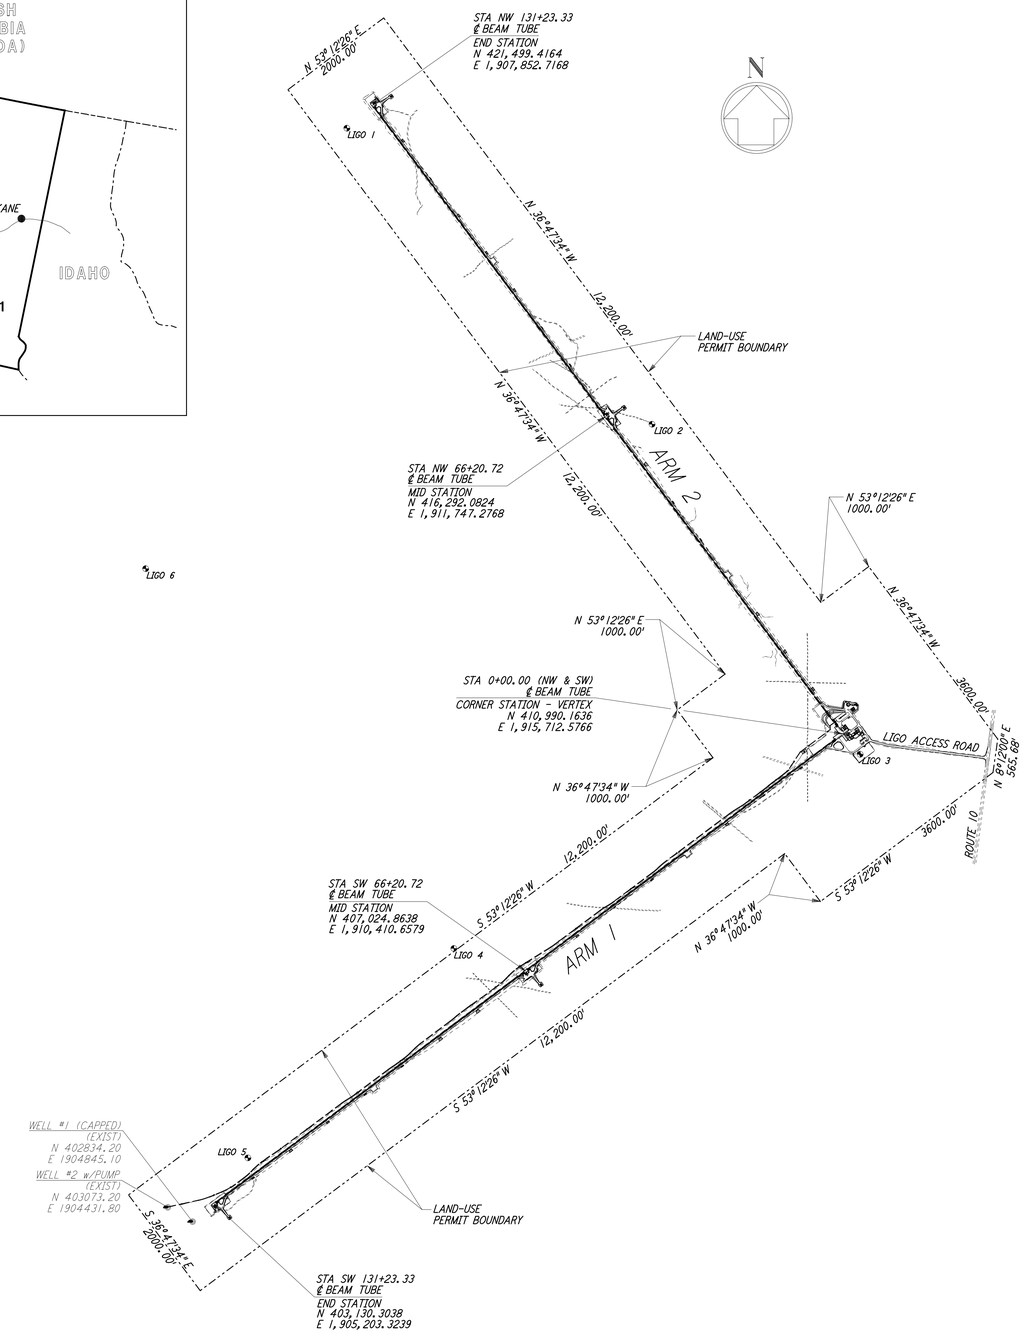

LIGO-D960196-01-O

REFERENCES		REVISIONS							
		1	5/15/98	WRB					ISSUED FOR AS-BUILT
DRAWING NO.	DESCRIPTION	NO.	DATE	BY	CHKD	ENGR	PROJ		DESCRIPTION

FOR CONSTRUCTION		
DRAWN	WRB	9/28/95
CHECKED	ML	7/9/96
ENGINEER	JB	7/9/96
PROJ	MDW	7/9/96

AS-BUILT DRAWINGS

PARSONS
100 WEST WALNUT STREET
PASADENA, CALIFORNIA

LIGO
CALIFORNIA INSTITUTE OF TECHNOLOGY
MASSACHUSETTS INSTITUTE OF TECHNOLOGY

LASER INTERFEROMETER GRAVITATIONAL-WAVE OBSERVATORY
SITE NO. 1 - HANFORD, WASHINGTON

TITLE: CIVIL DRAWING INDEX LOCATION & VICINITY MAPS

SCALE	CONTRACT NUMBER	PROJECT NUMBER
AS NOTED	PP150969	8094

SHEET NUMBER: WA-C-001
REVISION: 1