




NOTES:
 1. SEE SHEET WA-C-002 FOR GENERAL NOTES, LEGEND AND ABBREVIATIONS.

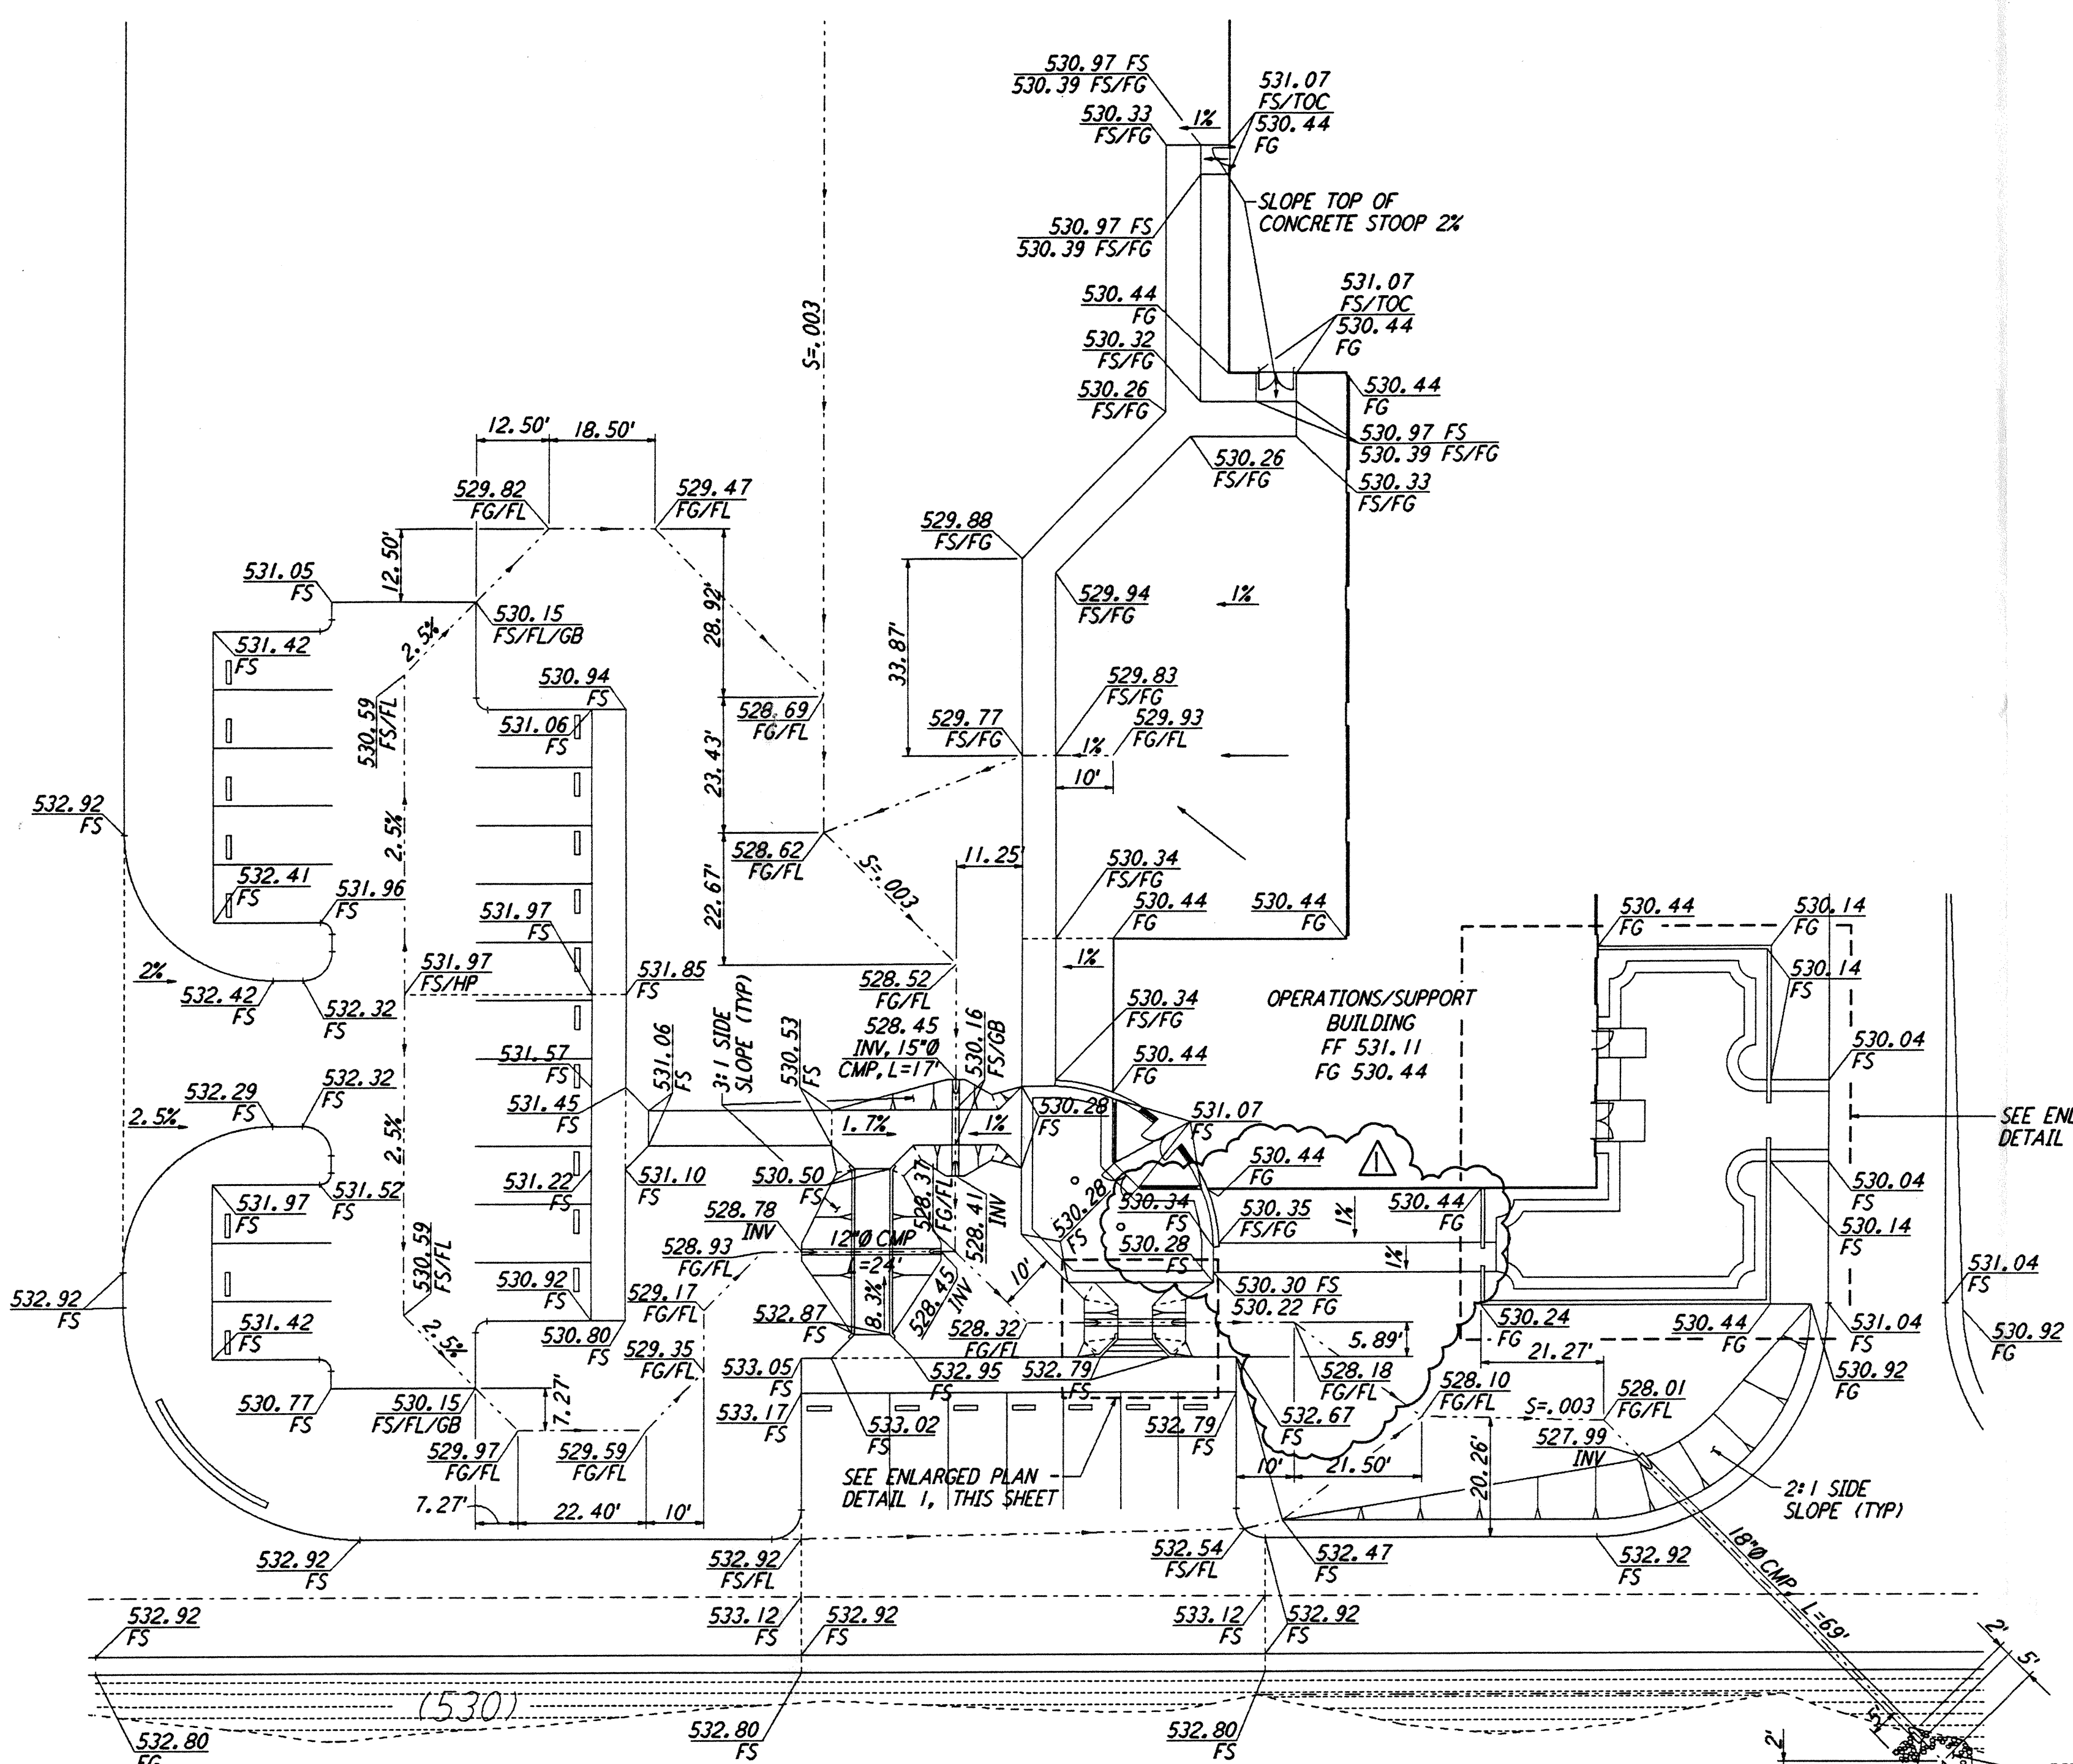


ENLARGED AREA - BUILDING ENTRANCE
 SCALE: 1" = 20'

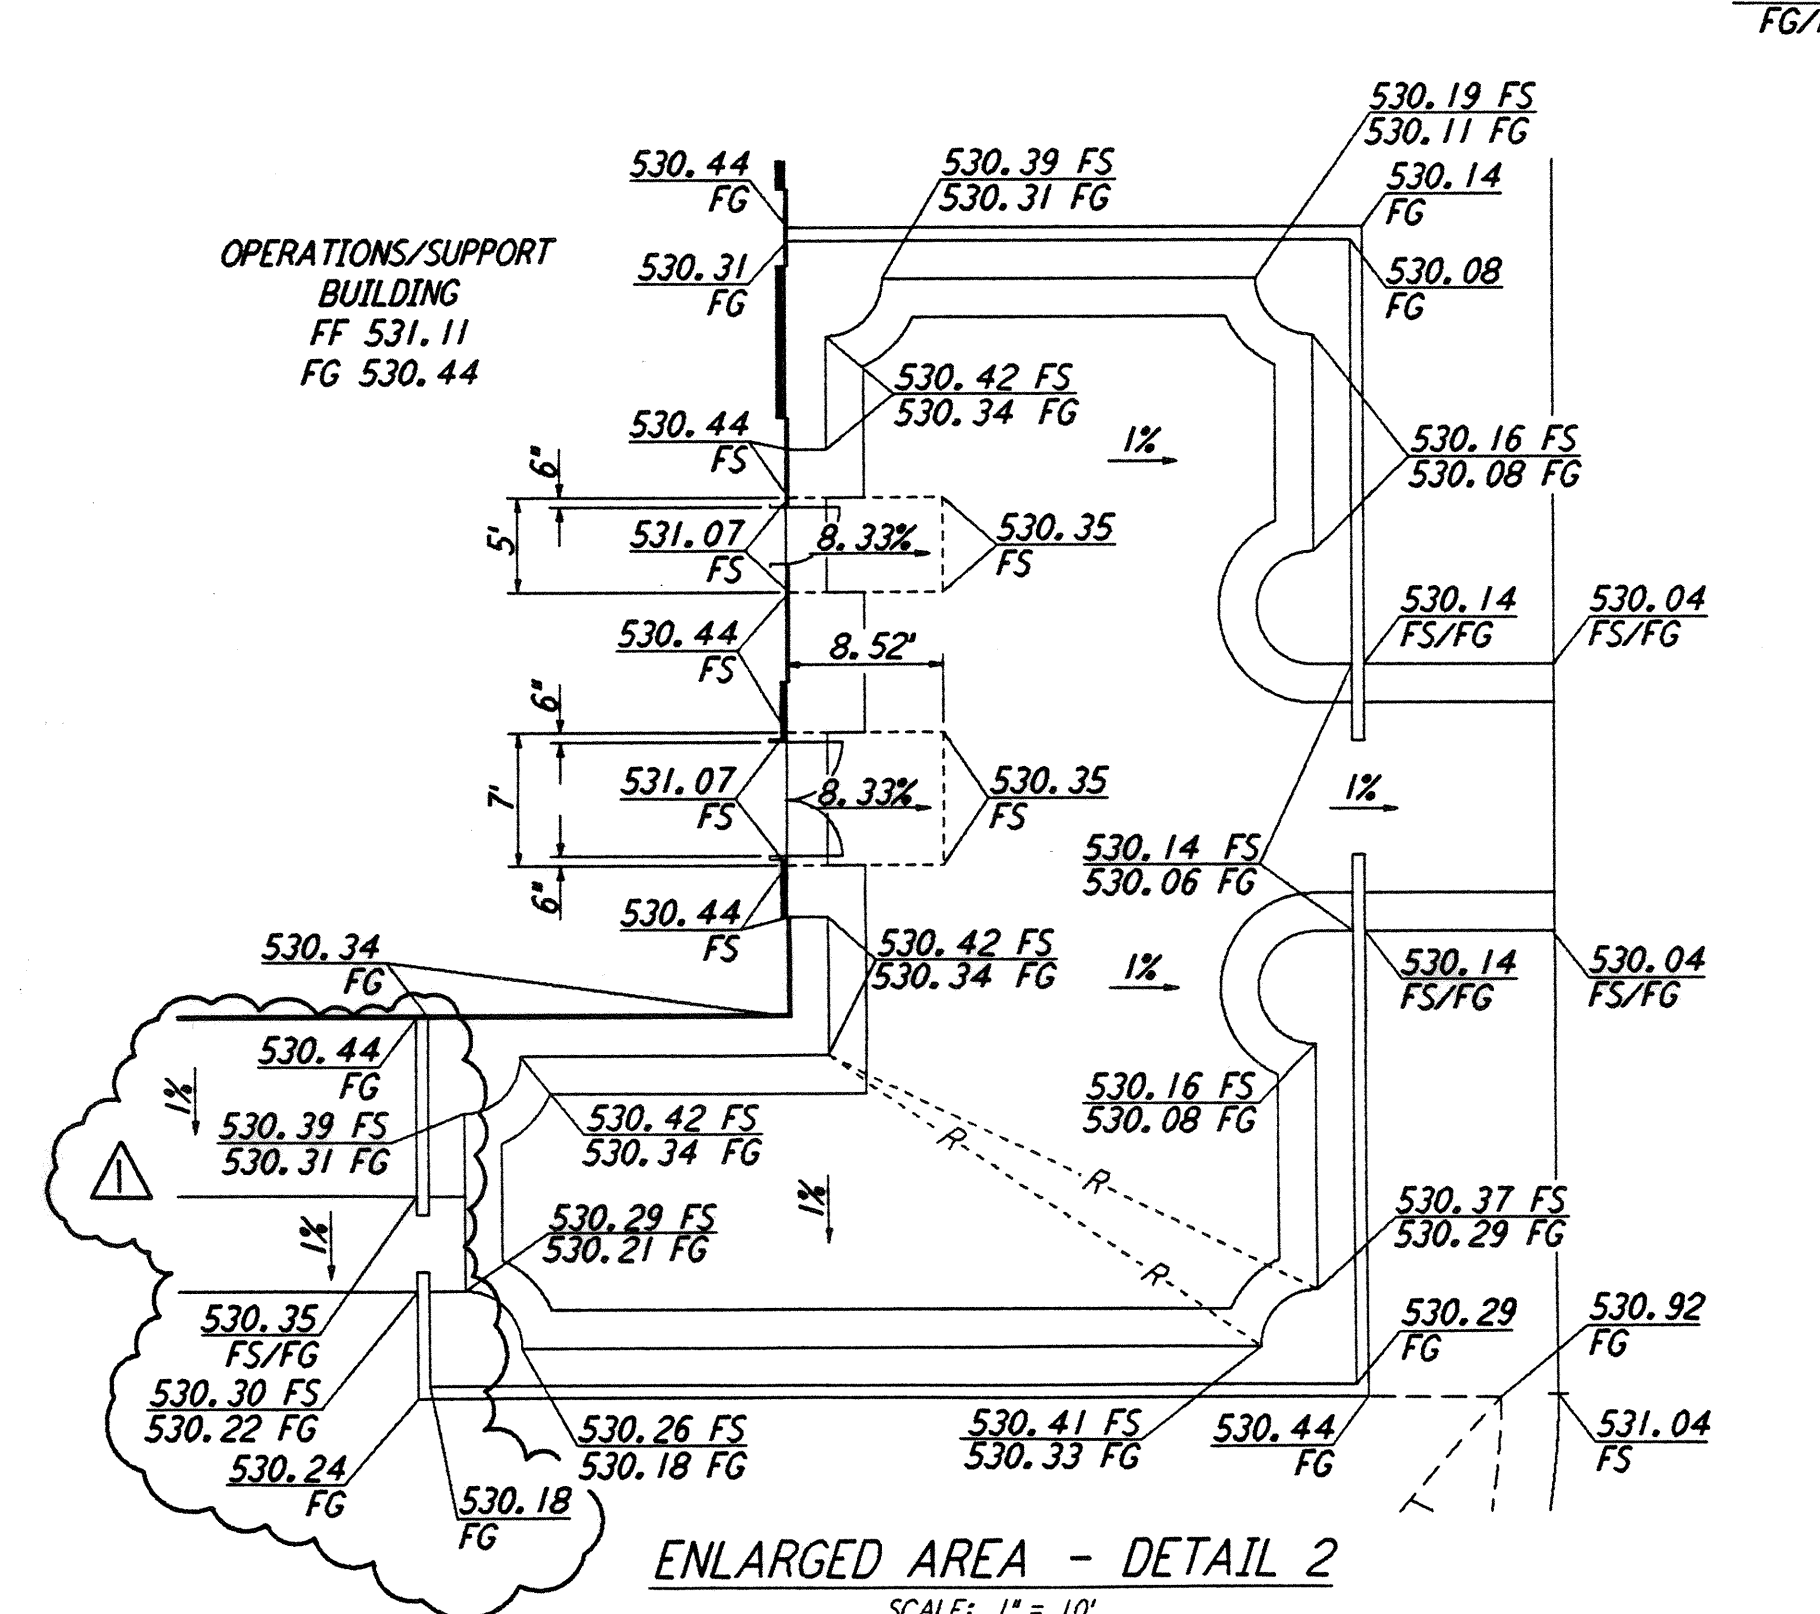




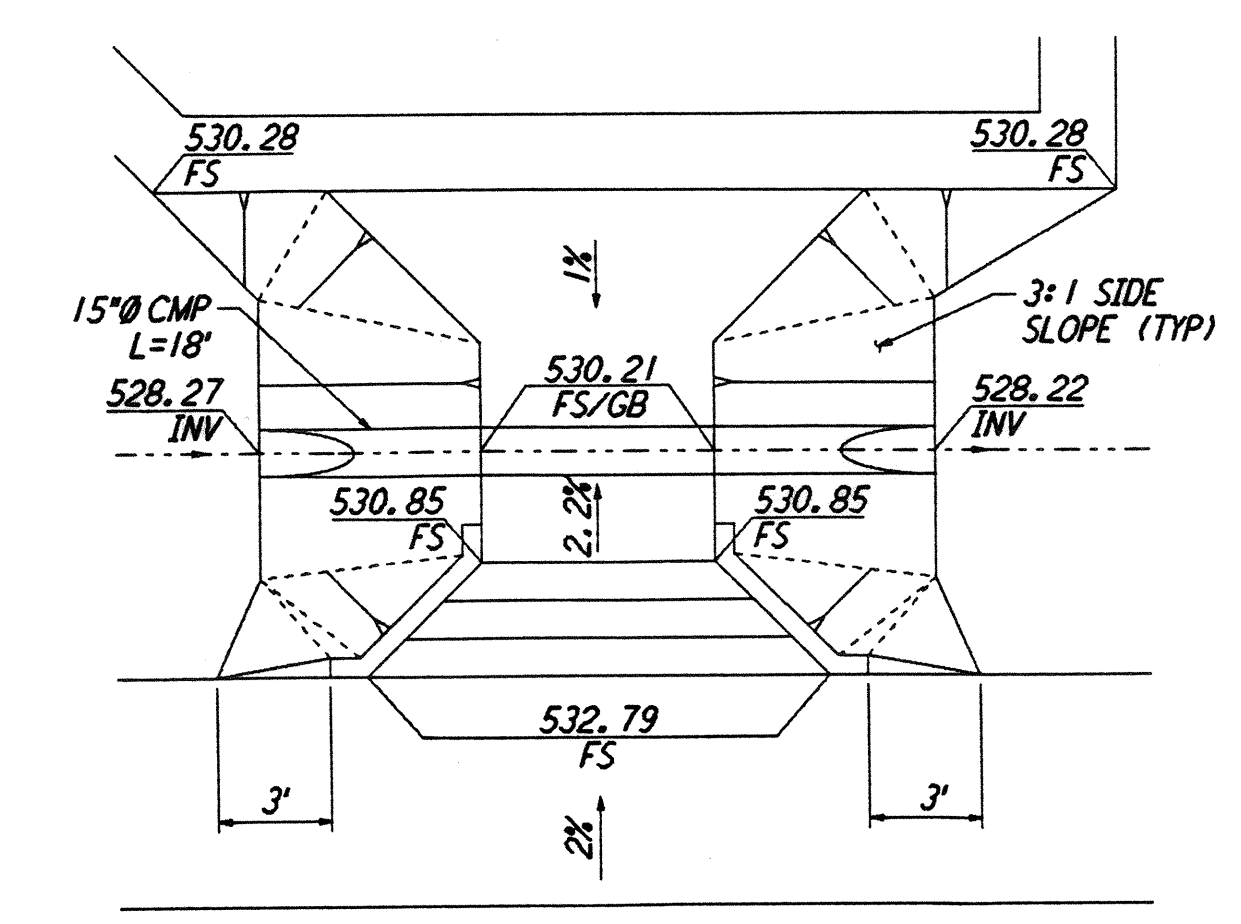


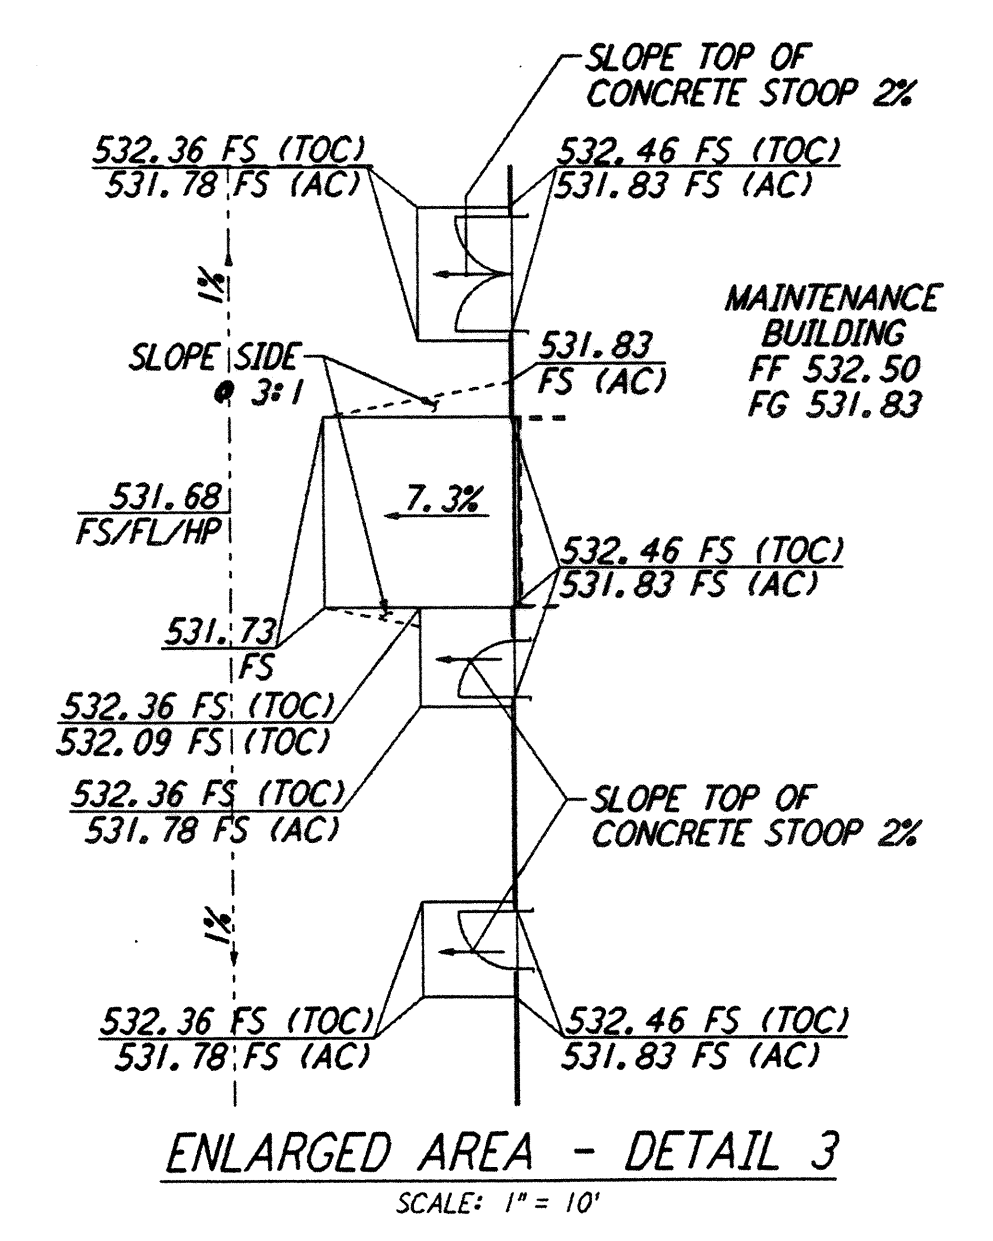

ENLARGED AREA - DETAIL 3
 SCALE: 1" = 10'

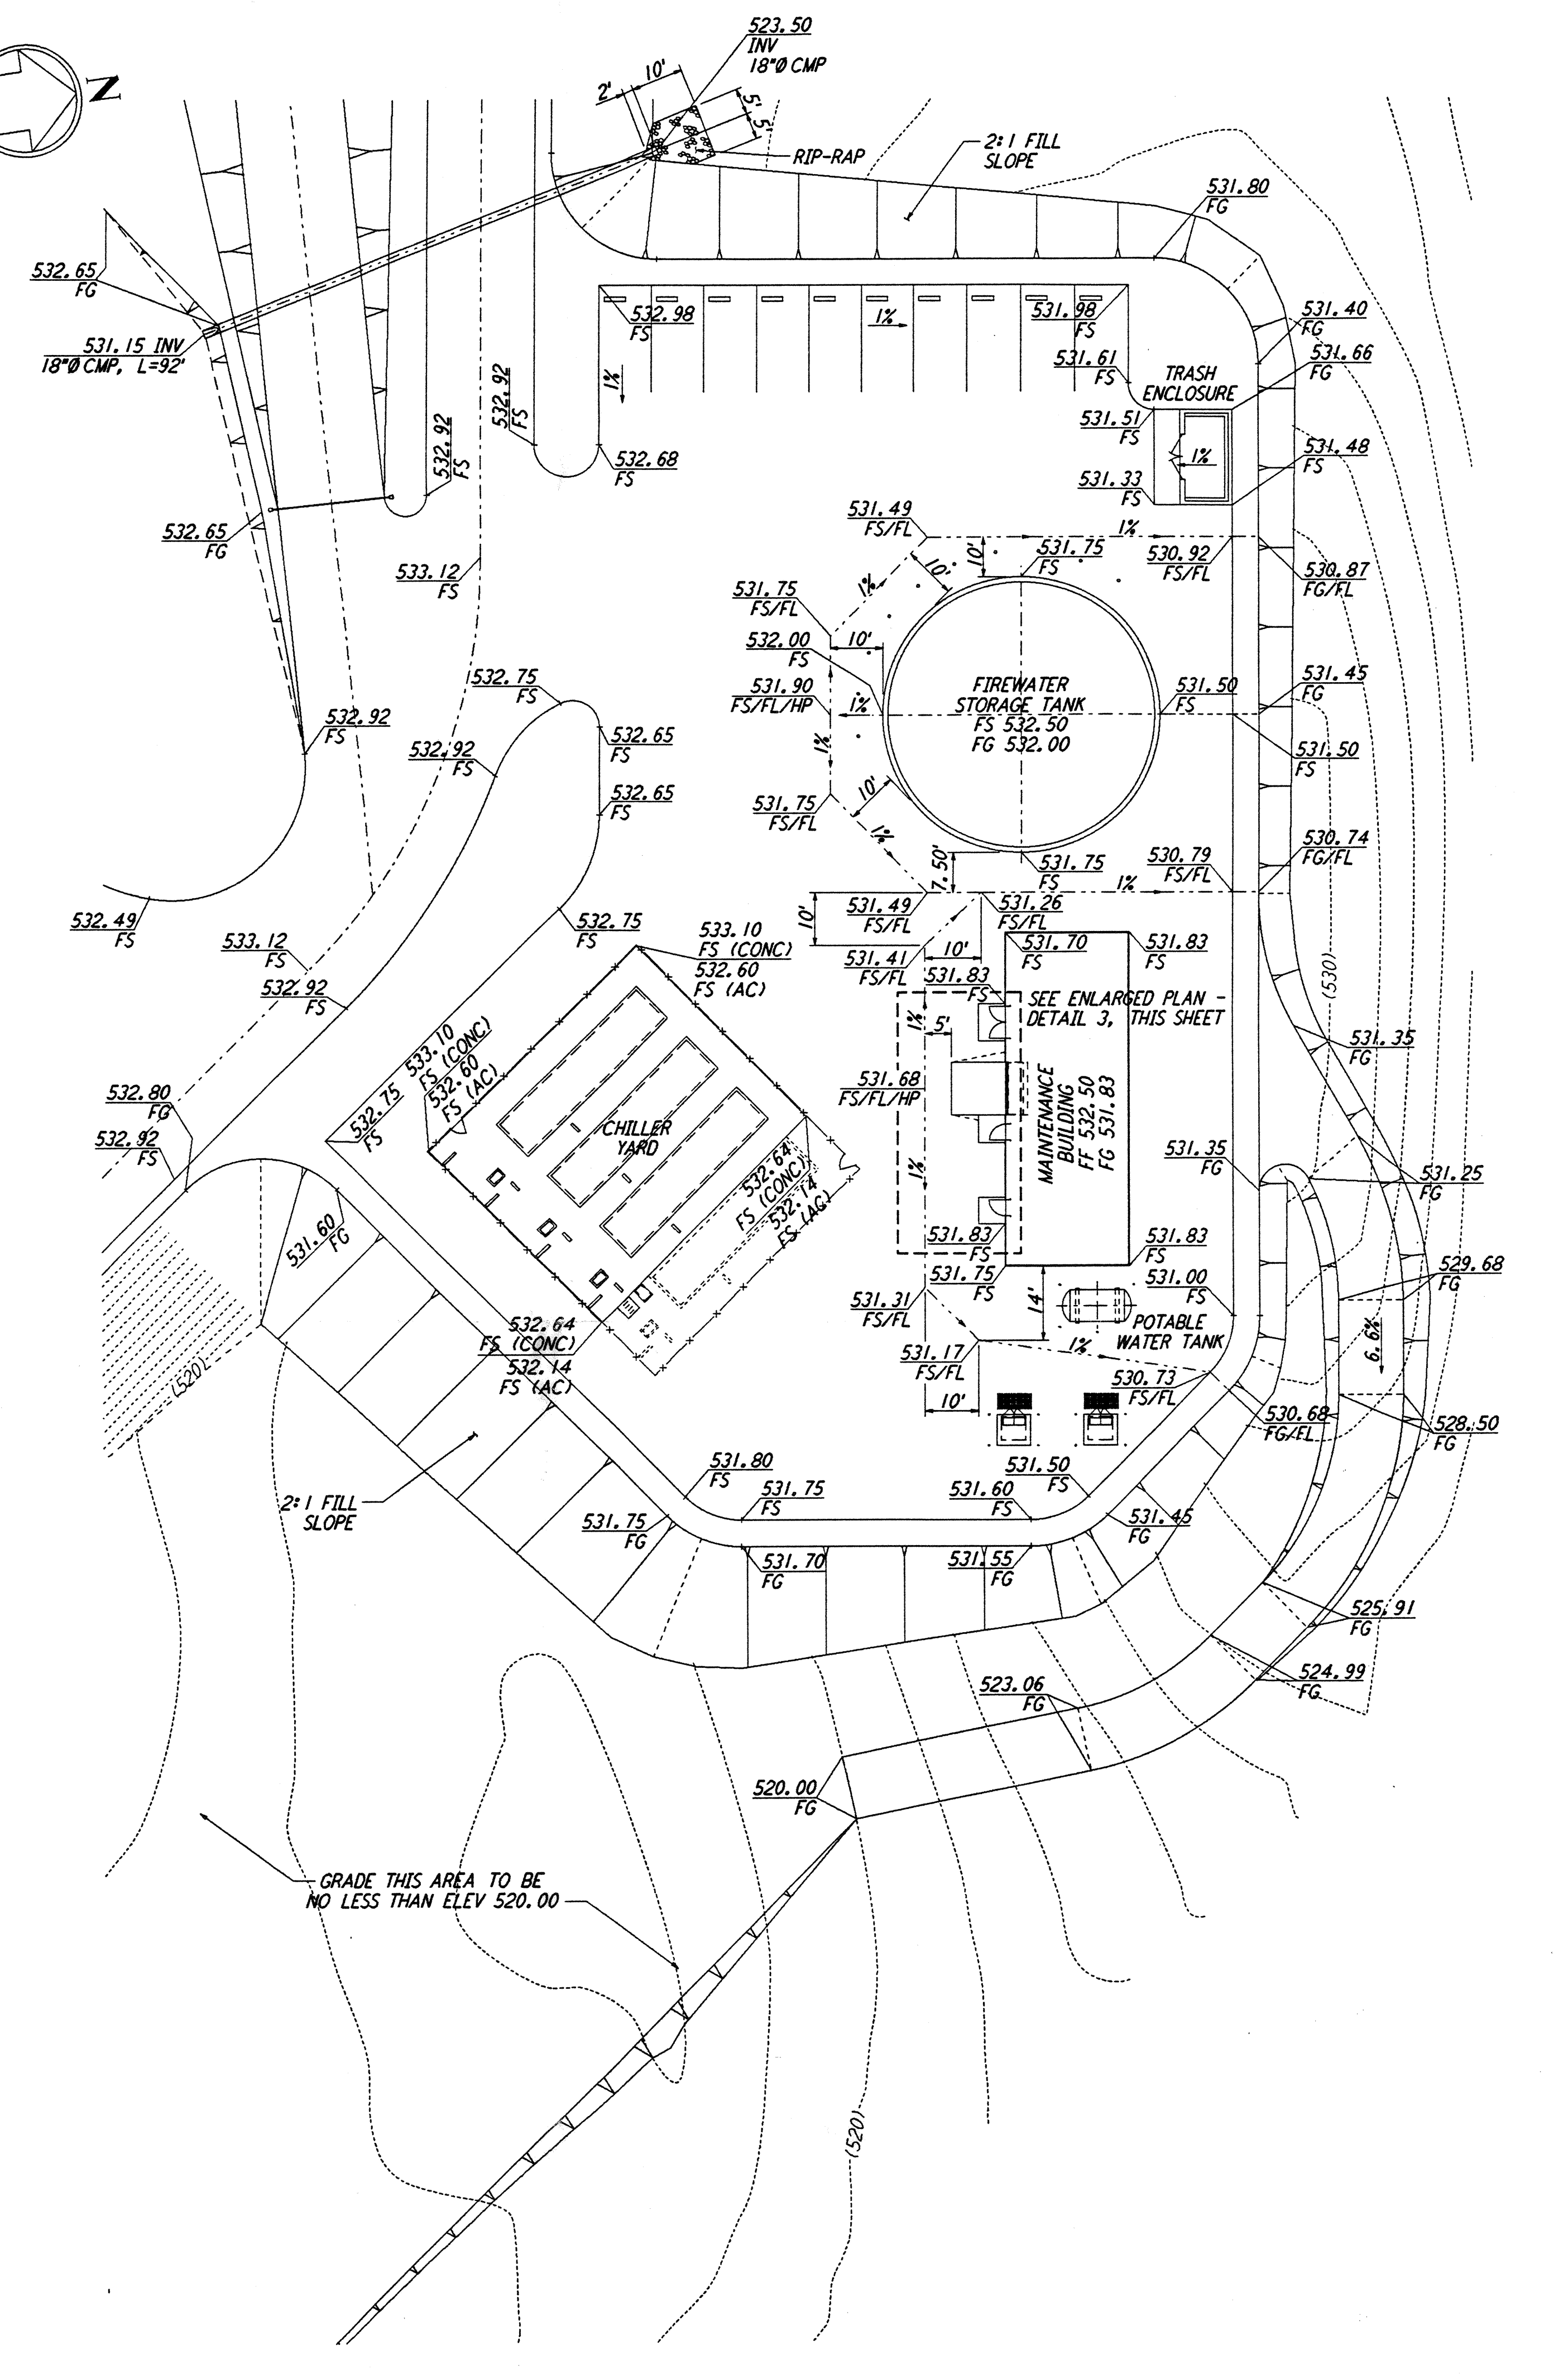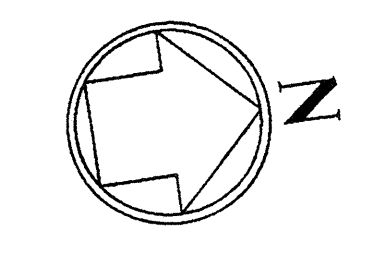

ENLARGED AREA - MAINTENANCE YARD
 SCALE: 1" = 20'


LIGO-D960201-01-0
 GRAPHIC SCALE
 SCALE: 1" = 20'

not be reproduced, copied, loaned, exhibited, or used in any other way, except by written consent from PARSONS to the borrower.

This document and the design it covers are the property of PARSONS. They are loaned only with the borrower's expressed written agreement that they will

NO.	DATE	BY	CHKD	ENGR	PROJ	DESCRIPTION
1	2-28-97	WRB	C/L			ADDED WALK/WALL OPENING, REVISED GRADING

FOR CONSTRUCTION	
DRAWN	WRB 9/28/95
CHECKED	ML 7/9/96
ENGINEER	J/B 7/9/96
PROJ	MOW 7/9/96

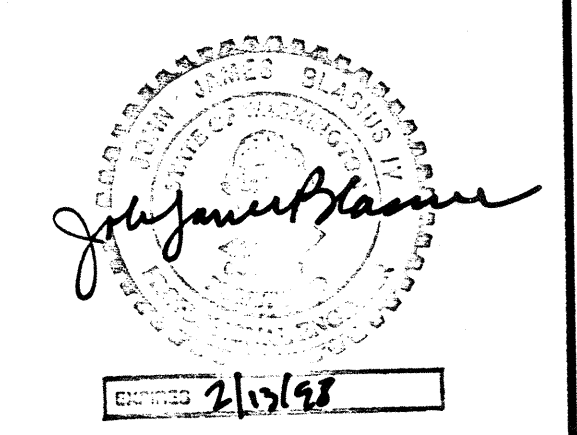

PARSONS
 100 WEST WALNUT STREET
 PASADENA, CALIFORNIA

LIGO
 CALIFORNIA INSTITUTE OF TECHNOLOGY
 MASSACHUSETTS INSTITUTE OF TECHNOLOGY

**LASER INTERFEROMETER
 GRAVITATIONAL-WAVE OBSERVATORY
 SITE NO. 1 - HANFORD, WASHINGTON**

TITLE: CIVIL CORNER STATION GRADING PLAN ENLARGED PLANS

SCALE: AS NOTED
 CONTRACT NUMBER: PPI50969
 PROJECT NUMBER: 8094

WA-C-008