This document and the design it covers are the property of **PARSONS**. They are loaned only with the borrower's expressed written agreement that they will not be reproduced, copied, loaned, exhibited, or used in any other way, except by written consent from **PARSONS** to the borrower.

DATE: 04/10/96 TIME: 13:34:48
DESIGN FILE: I:\ligo\site1\ce\wac042.dgz

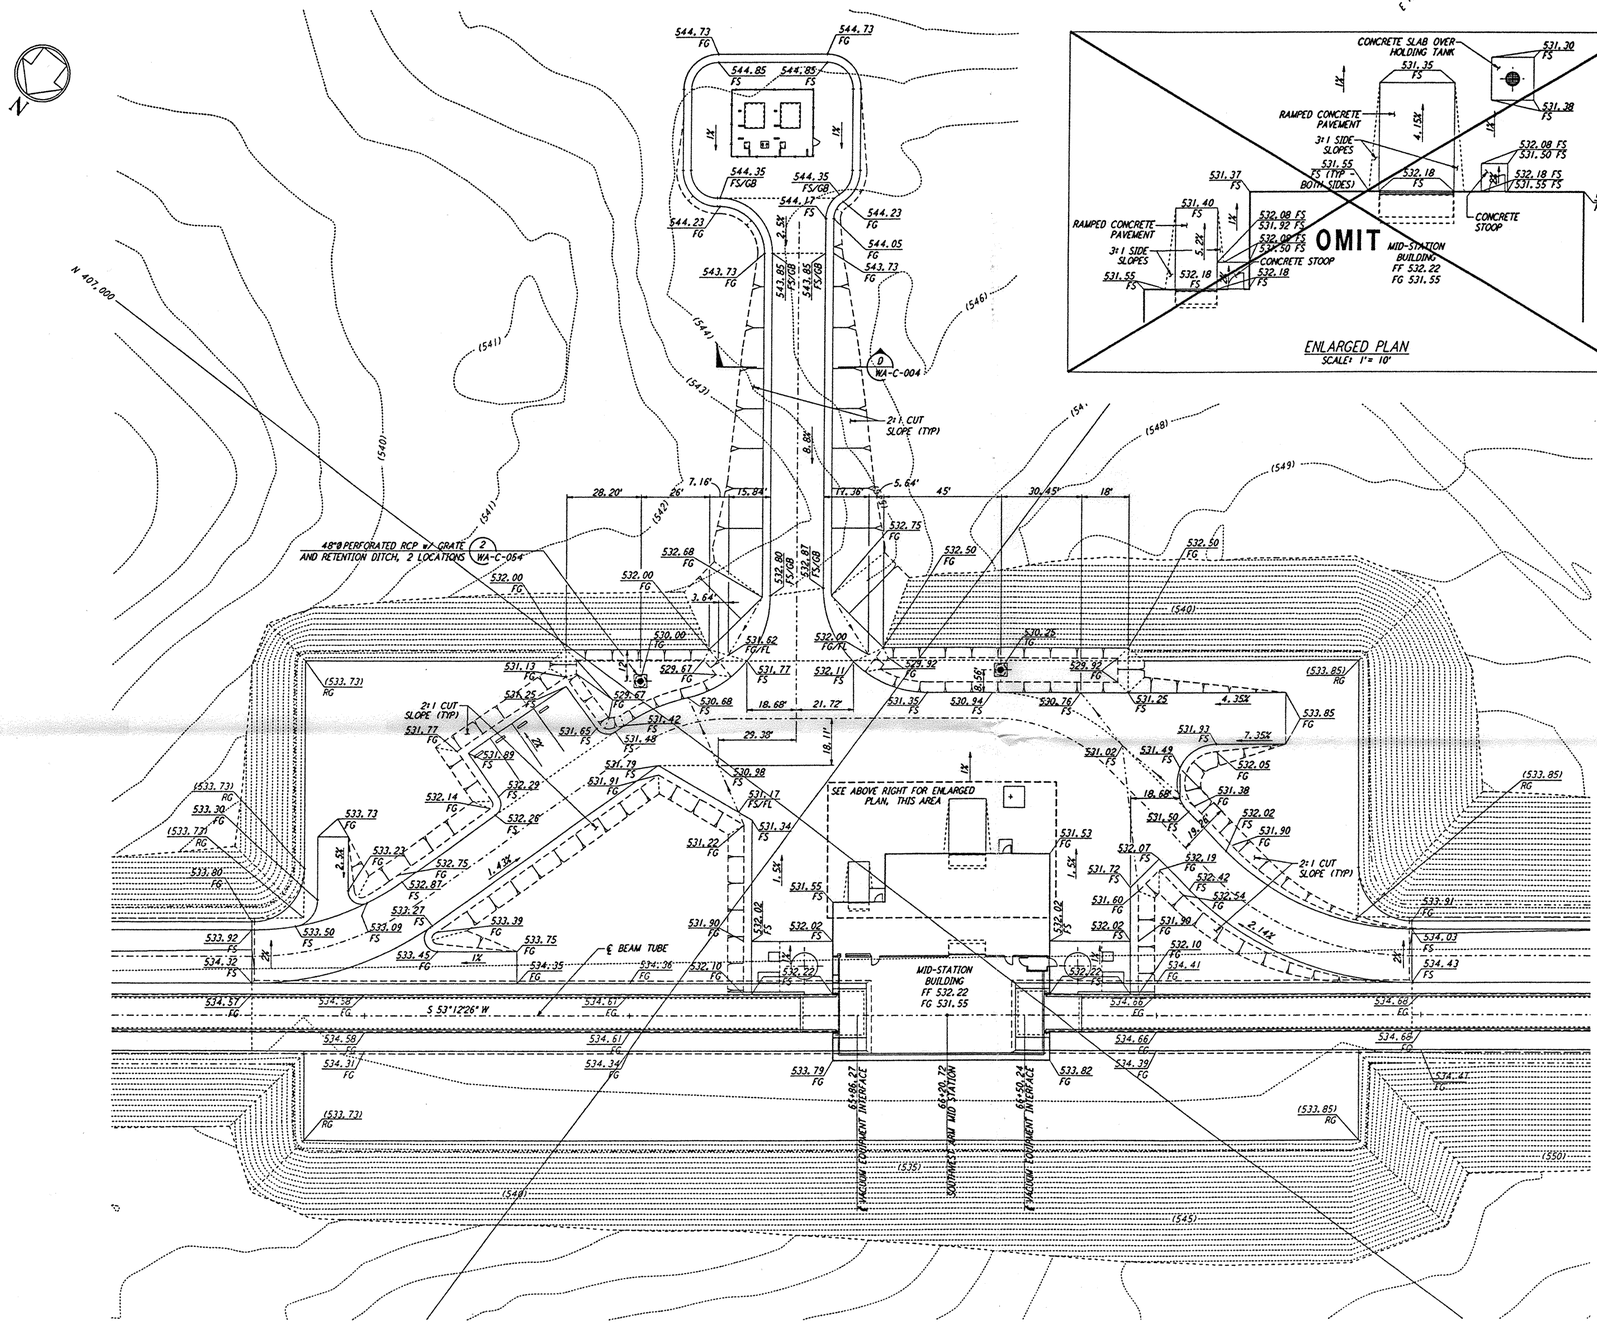

ENLARGED PLAN
SCALE: 1" = 10'

NOTES:

1. SEE SHEET WA-C-002 FOR GENERAL NOTES, LEGEND AND ABBREVIATIONS.
2. GRADING BY OTHERS.

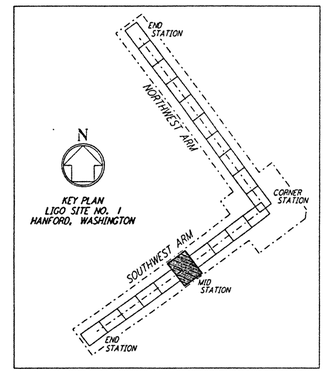

GRAPHIC SCALE
0 20 40 60 80
SCALE: 1" = 20'

REFERENCES

DRAWING NO.	DESCRIPTION

REVISIONS

NO.	DATE	BY	CHKD	ENGR	PROJ	DESCRIPTION
B	4/19/96	WRB		TOM		FINAL DESIGN REVIEW & BID
A	10/31/95	WRB				PRELIMINARY DESIGN REVIEW

DRAWN	WRB
CHECKED	
ENGINEER	
PROJ	

PARSONS
100 WEST WALNUT STREET
PASADENA, CALIFORNIA

LIGO
CALIFORNIA INSTITUTE OF TECHNOLOGY
MASSACHUSETTS INSTITUTE OF TECHNOLOGY

LASER INTERFEROMETER
GRAVITATIONAL-WAVE OBSERVATORY
SITE NO. 1 - HANFORD, WASHINGTON

TITLE: CIVIL SOUTHWEST ARM MID-STATION GRADING PLAN

SCALE	CONTRACT NUMBER	PROJECT NUMBER
1" = 20'	PP150969	8094

SHEET NUMBER: WA-C-042
REVISIONS: (B)

L1GO-D960229-B-D

L1GOWAF3.BOR

Wed Apr 10 13:34:16 1996 s:\v3662\ACAD\STD\DETSTV3662\ACLEDRAW.PHP