



NOTES:
 1. SEE SHEET WA-C-002 FOR GENERAL NOTES, LEGEND AND ABBREVIATIONS.

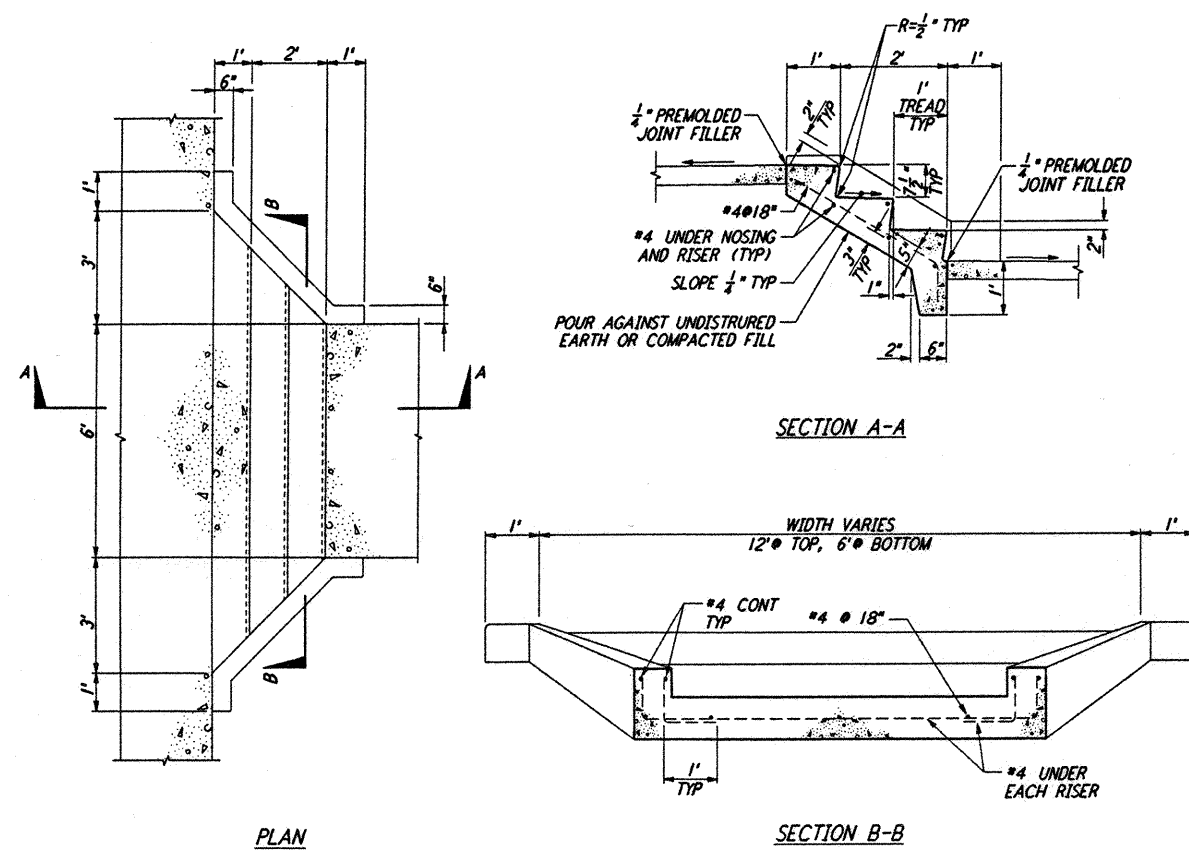


CONCRETE STEPS
 NOT TO SCALE

REF	WA-C-052
WA-C-006	
WA-C-006	
WA-C-505	

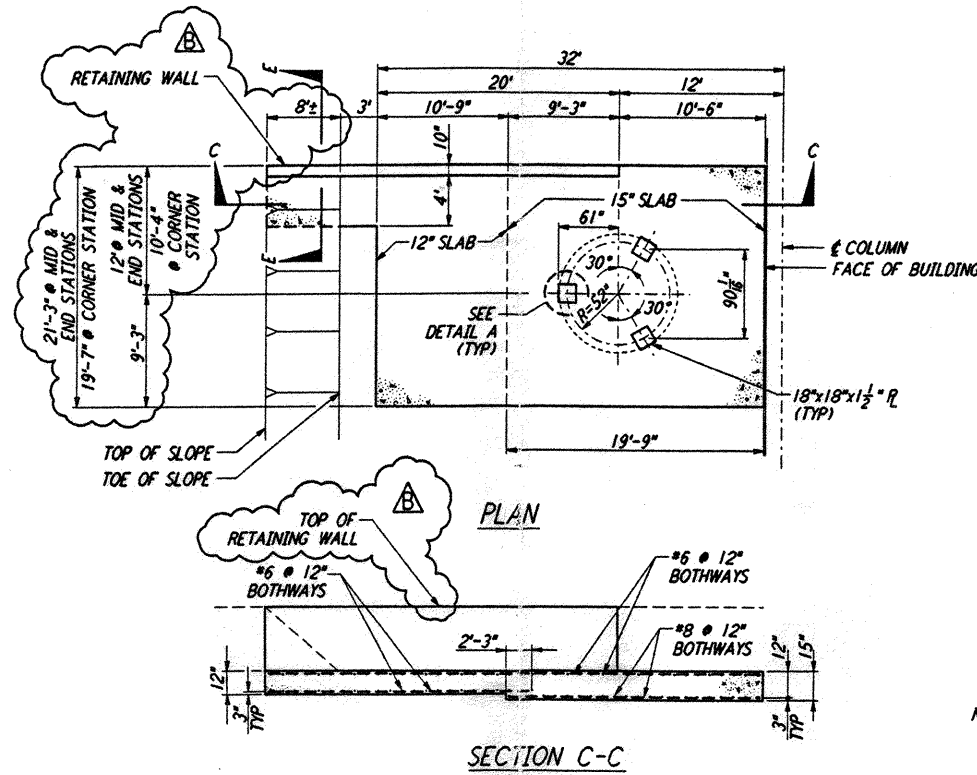


CONCRETE FOUNDATION FOR LIQUID NITROGEN TANK
 NOT TO SCALE

REF	WA-C-052
WA-C-021	
WA-C-025	
WA-C-041	
WA-C-045	
WA-C-505	

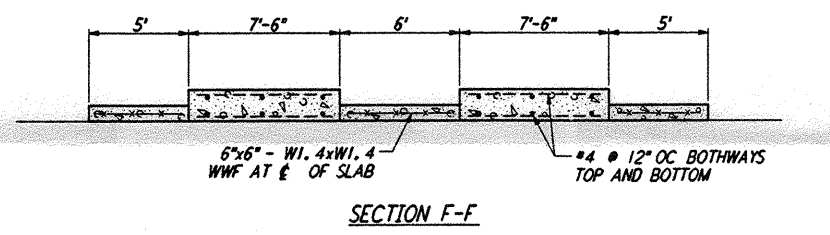


ENLARGED CHILLER YARD PLAN @ MID AND END STATIONS
 NOT TO SCALE

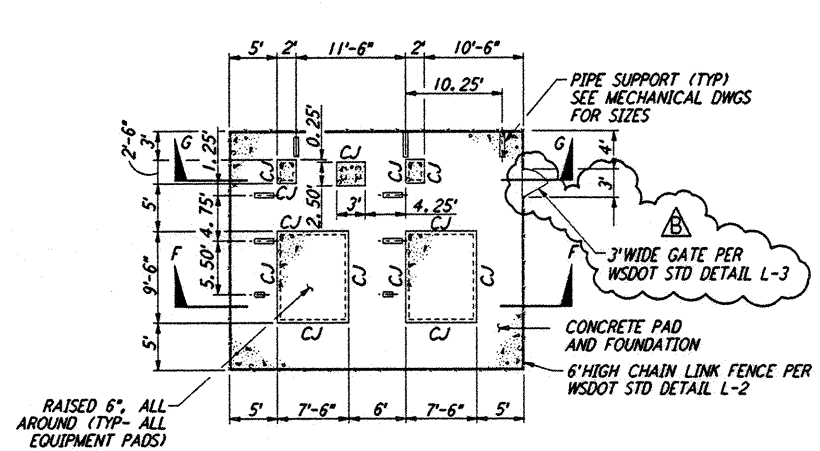

ENLARGED CHILLER YARD PLAN @ MID AND END STATIONS
 NOT TO SCALE


REF	WA-C-052
WA-C-021	
WA-C-025	
WA-C-041	
WA-C-045	

NOTE:
 FOR MID AND END STATIONS - NORTHWEST ARM, USE PLAN AS SHOWN.
 FOR MID AND END STATIONS - SOUTHWEST ARM, PLAN IS ROTATED 90° AND MIRRORED ABOUT THE BEAM TUBE

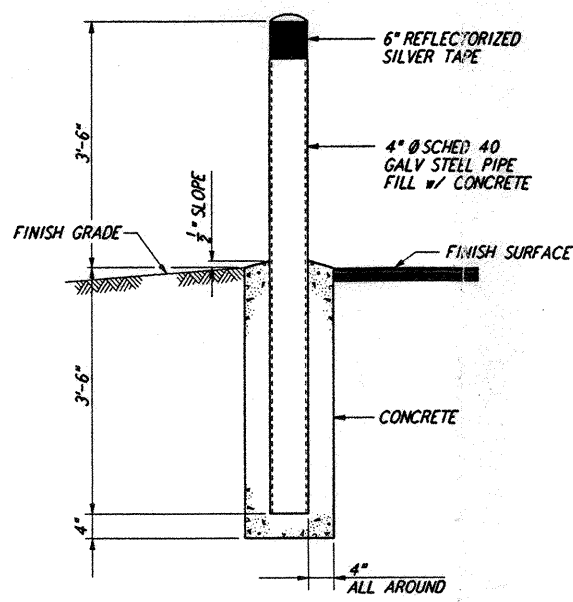

GUARD POST
 NOT TO SCALE

REF	WA-C-052
WA-C-006	
WA-C-006	
WA-C-055	

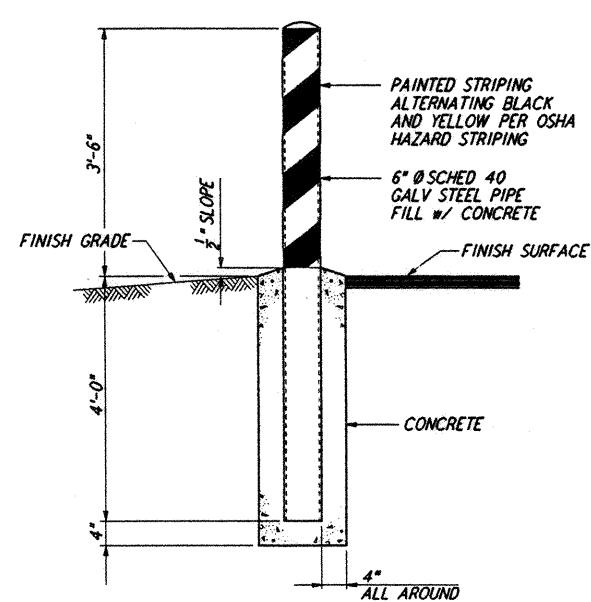

BOLLARD
 NOT TO SCALE

REF	WA-C-052
WA-C-006	
WA-C-006	
WA-C-021	
WA-C-025	
WA-C-041	
WA-C-045	
WA-C-505	

This document and the design it covers are the property of PARSONS. They are loaned only with the borrower's expressed written agreement that they will not be reproduced, copied, loaned, exhibited, or used in any other way, except by written consent from PARSONS to the borrower.

This document and the design it covers are the property of PARSONS. They are loaned only with the borrower's expressed written agreement that they will not be reproduced, copied, loaned, exhibited, or used in any other way, except by written consent from PARSONS to the borrower.

NO.	DATE	BY	CHKD	ENGR	PROJ	DESCRIPTION
B	5/22/96	WRB	ML	JB	MDW	BID ADDENDUM #2
A	4/19/96	WRB	ML	JB	MDW	FINAL DESIGN REVIEW & BID

DRAWN	WRB
CHECKED	
ENGINEER	
PROJ	

PARSONS
 100 WEST WALNUT STREET
 PASADENA, CALIFORNIA

LIGO
 CALIFORNIA INSTITUTE OF TECHNOLOGY
 MASSACHUSETTS INSTITUTE OF TECHNOLOGY

LASER INTERFEROMETER GRAVITATIONAL-WAVE OBSERVATORY SITE NO. 1 - HANFORD, WASHINGTON	
TITLE	CIVIL SITework DETAILS SHEET 2
SCALE	AS NOTED
CONTRACT NUMBER	PP150969
PROJECT NUMBER	8094
SHEET NUMBER	WA-C-052

LIGO-0960236-B-0

LIGOVAF3.BDR