
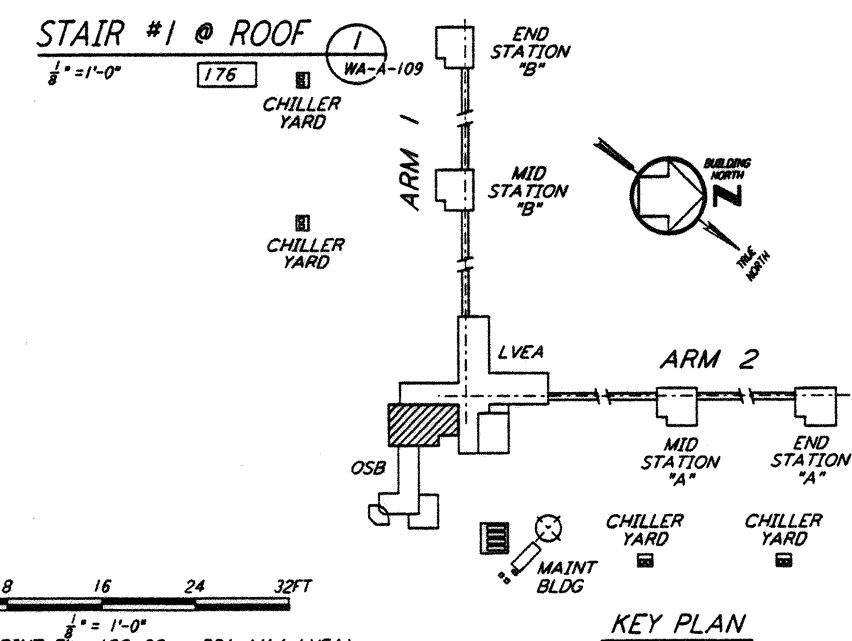
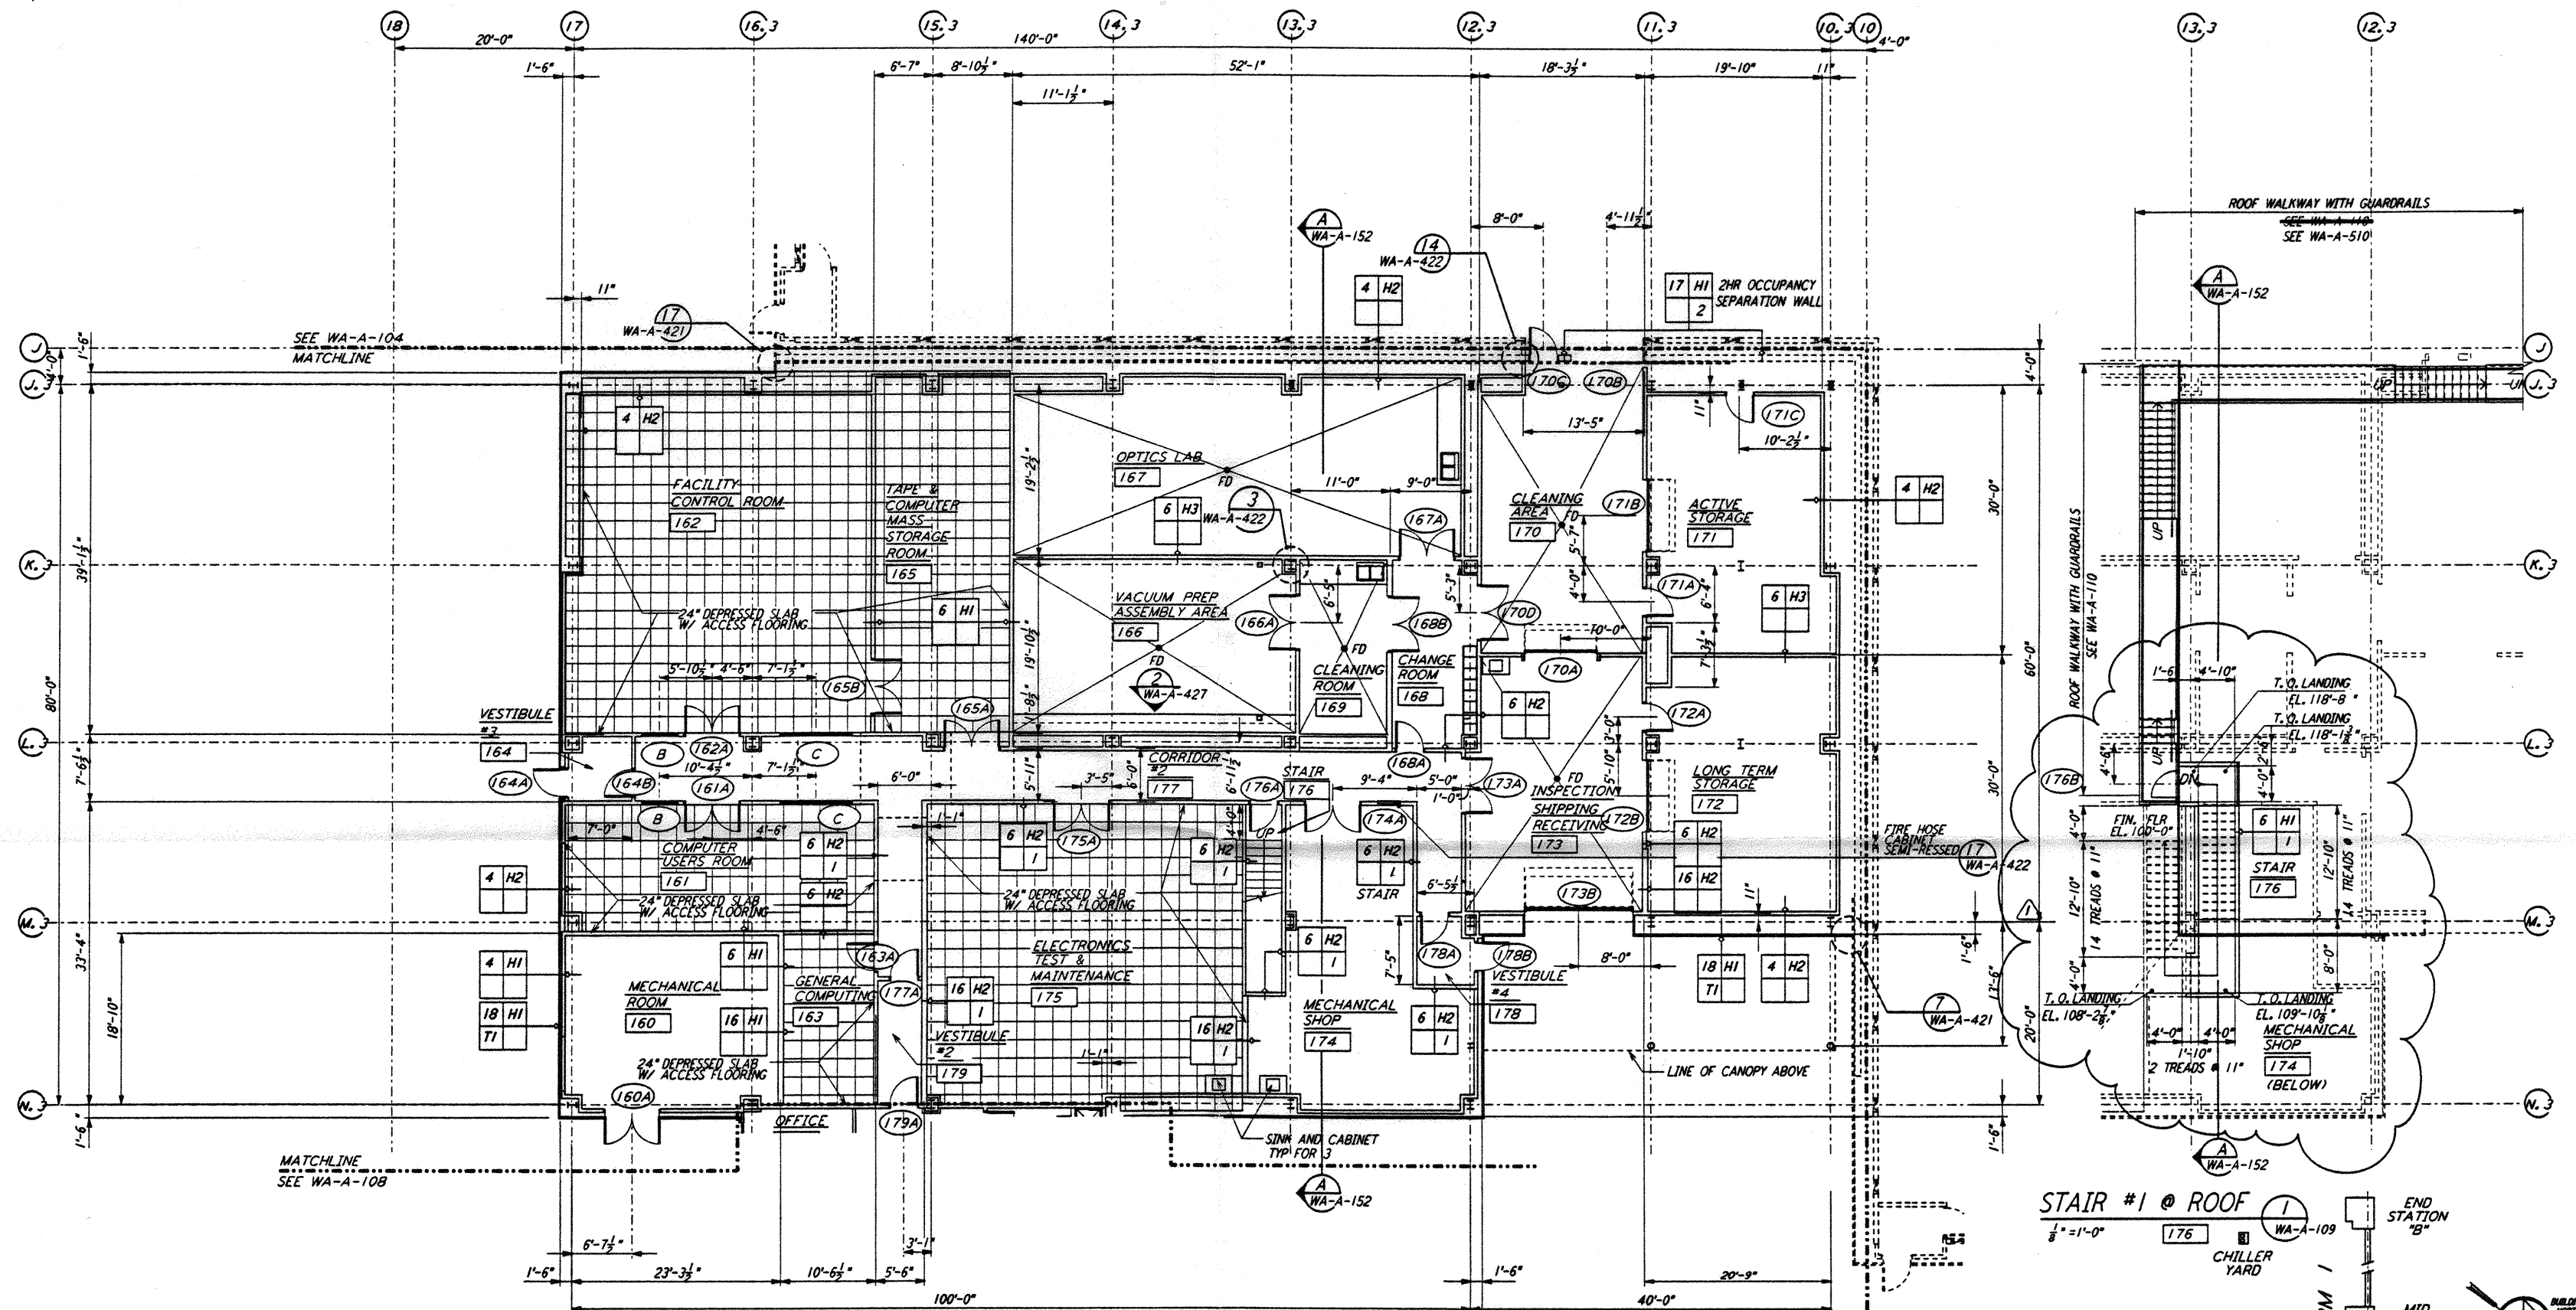


NOTE: SEE SPECIFICATIONS FOR
 ADDITIONAL INFORMATION
 AND SCHEDULES

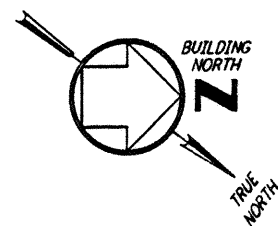

LIGO-D960249-01-0
 DATUM POINT EL +100.00 = 531.11' (LVEA)
 DATUM POINT EL +100.00 = 531.11' (OSB)

This document and the design it covers are the property of PARSONS. They are loaned only with the borrower's expressed written agreement that they will not be reproduced, copied, loaned, exhibited, or used in any other way, except by written consent from PARSONS to the borrower.

NO.	DATE	BY	CHKD	ENGR	PROJ	OSB REVISION	DESCRIPTION
1	2-28-97	CKT	TB	AK	TDM		

ISSUED FOR CONSTRUCTION	5-12-96
DRAWN (SF/CKT)	5-12-96
CHECKED (TB)	5-26-96
ENGINEER (AK)	7-12-96
PROJ (MDW)	7-12-96

6809 REGISTERED ARCHITECT
 ALEXANDER W. PELL
 STATE OF WASHINGTON
 2/29/97

PARSONS
 100 WEST WALNUT STREET
 PASADENA, CALIFORNIA

LIGO
 CALIFORNIA INSTITUTE OF TECHNOLOGY
 MASSACHUSETTS INSTITUTE OF TECHNOLOGY

LASER INTERFEROMETER
 GRAVITATIONAL-WAVE OBSERVATORY
 SITE NO. 1 - HANFORD, WASHINGTON
 ARCHITECTURAL CORNER STATION
 OSB PARTIAL FLOOR PLAN
 SHEET 2
 AS NOTED PPI50969 8094
WA-A-109