DATE: 06/04/98 TIME: 22:03:30
DESIGN FILE: I:\ligo\site1\ar\wa0111.d3z

NOTE: SEE SPECIFICATIONS FOR ADDITIONAL INFORMATION AND SCHEDULES

not be reproduced, copied, loaned, exhibited, or used in any other way, except by written consent from PARSONS to the borrower.

This document and the design it covers are the property of PARSONS. They are loaned only with the borrower's expressed written agreement that they will

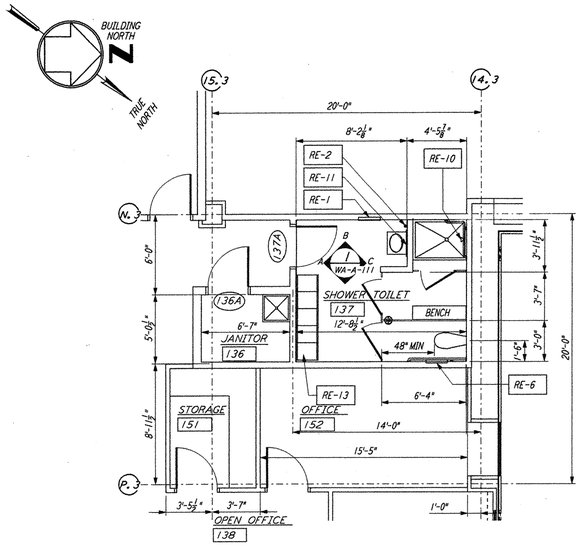

ENLARGED PLAN

JANITOR 136 / SHOWER TOILET 137

1/4" = 1'-0"

1 REF WA-A-111 WA-A-108

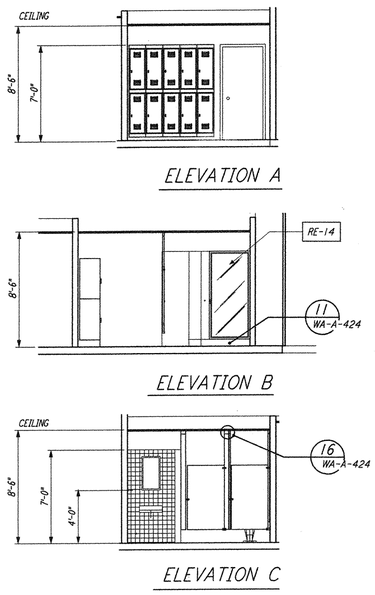

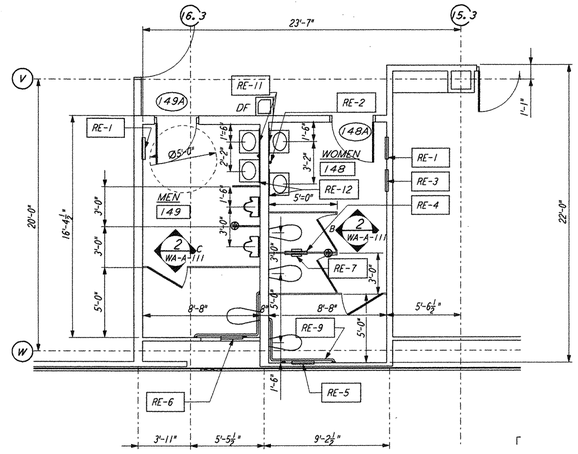

ENLARGED TOILET PLAN

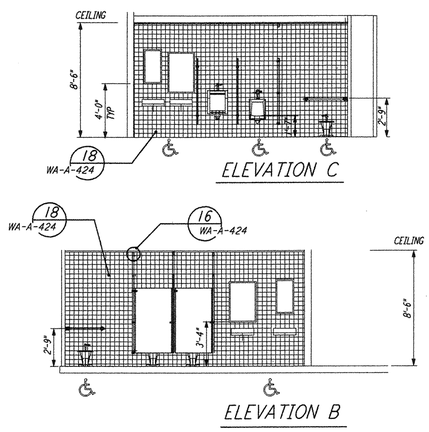

MEN 149 / WOMEN 148

1/4" = 1'-0"

2 REF WA-A-111 WA-A-108

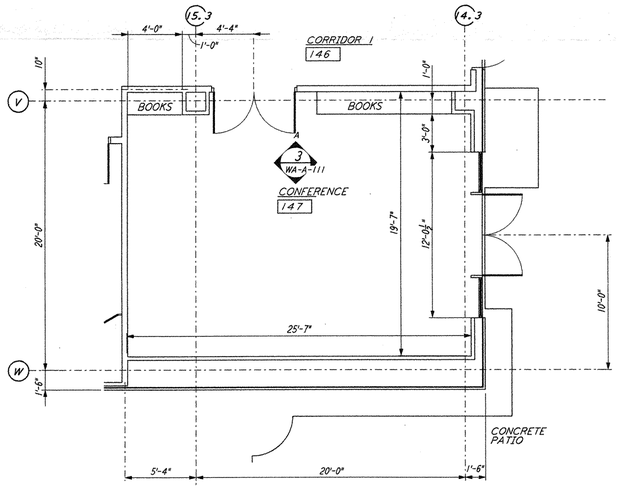

ENLARGED PLAN

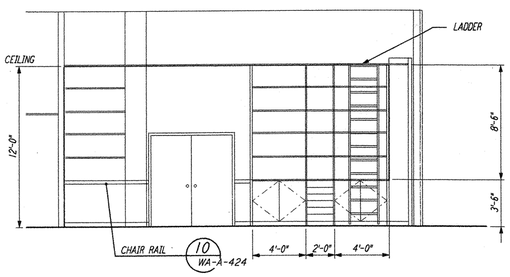

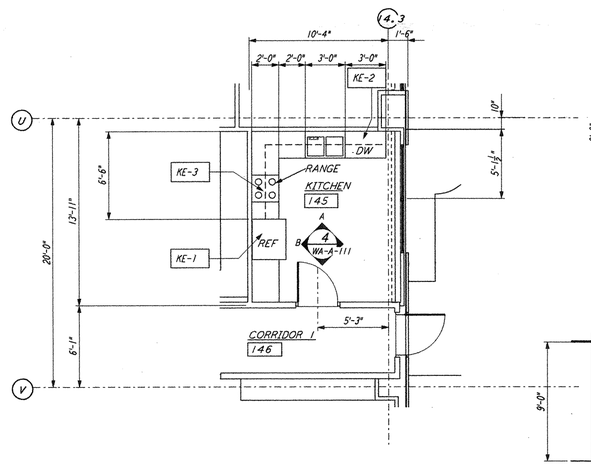

ENLARGED KITCHEN PLAN

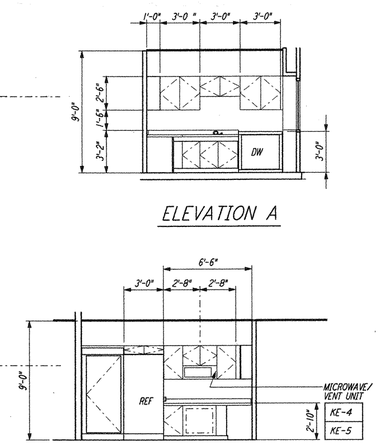

CONFERENCE ROOM 147

1/4" = 1'-0"

3 REF WA-A-111 WA-A-108

KITCHEN PLAN 145

1/4" = 1'-0"

4 REF WA-A-111 WA-A-108

0 4 8 12 16FT

1/4" = 1'-0"

LIGO-D960250-02-O

REFERENCES		REVISIONS							
DRAWING NO.	DESCRIPTION	NO.	DATE	BY	CHKD	ENGR	PROJ	DESCRIPTION
		2	5-15-98	CKT	[illegible]	[illegible]	[illegible]	ISSUED FOR AS-BUILT
		1	2-28-97	CKT	TB	AK	TDM	OSB REVISION

ISSUED FOR CONSTRUCTION		
DRAWN	CKT	5-12-96
CHECKED	TB	5-26-96
ENGINEER	bkk	7-12-96
PROJ	MDW	7-12-96

AS-BUILT DRAWINGS

PARSONS
100 WEST WALNUT STREET
PASADENA, CALIFORNIA

LIGO
CALIFORNIA INSTITUTE OF TECHNOLOGY
MASSACHUSETTS INSTITUTE OF TECHNOLOGY

LASER INTERFEROMETER GRAVITATIONAL-WAVE OBSERVATORY
SITE NO. 1 - HANFORD, WASHINGTON

TITLE: ARCHITECTURAL CORNER STATION OSB ENLARGED PLANS

SCALE	CONTRACT NUMBER	PROJECT NUMBER
AS NOTED	PP150969	8094

SHEET NUMBER: WA-A-111 REVISIONS: 2

LIGOWAF3.BDR

Thu Jun 04 22:03:04 1998 C:\PLOT\DWG\93-V3682\ar-111.prf 52085 R:\V3682\ar-111.prf