This document and the design it covers are the property of **PARSONS**. They are loaned only with the borrower's expressed written agreement that they will not be reproduced, copied, loaned, exhibited, or used in any other way, except by written consent from **PARSONS** to the borrower.

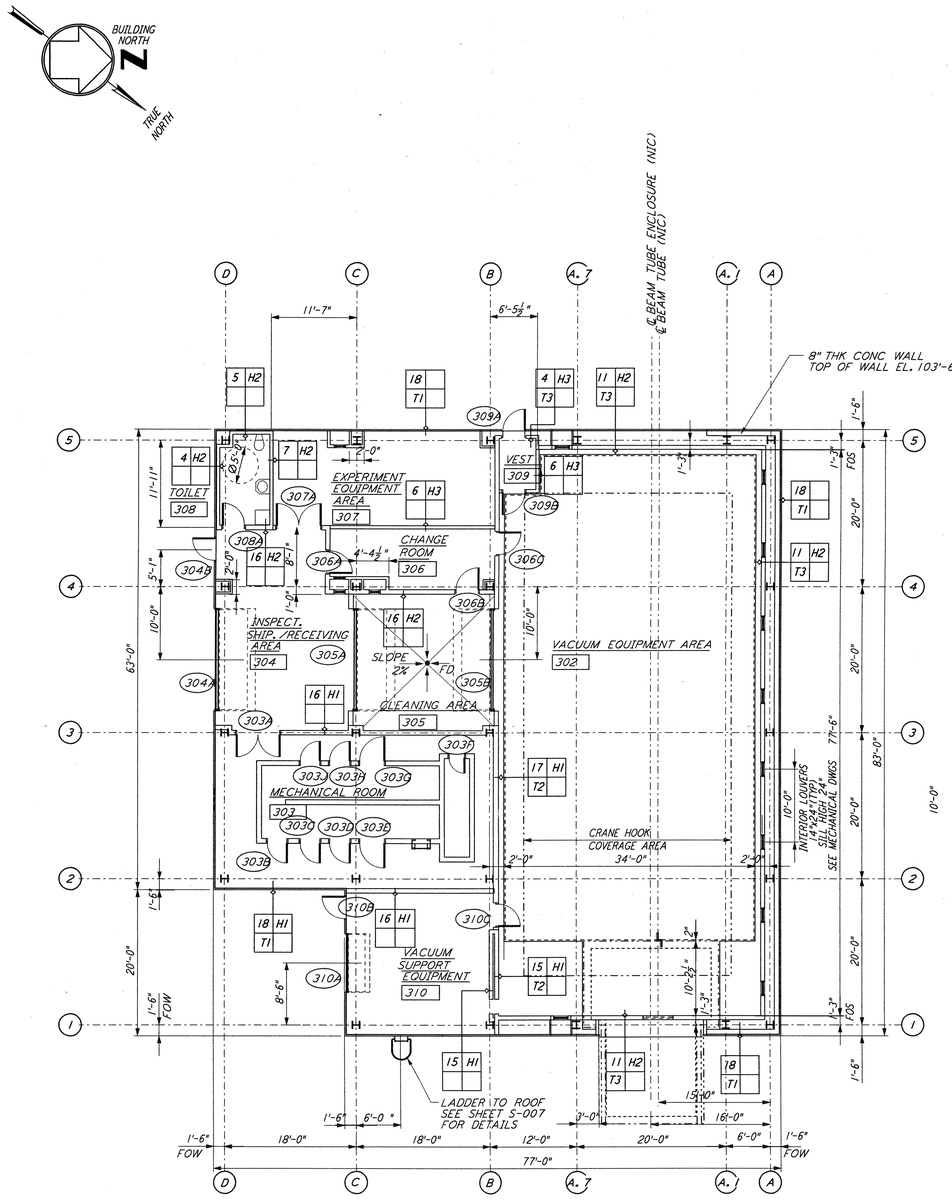

END STATION "B" FLOOR PLAN

2 WA-A-202

1/8"=1'-0"
FOR LOUVER AND OPENING LOCATIONS
SEE MID STATION "A" FLOOR PLAN

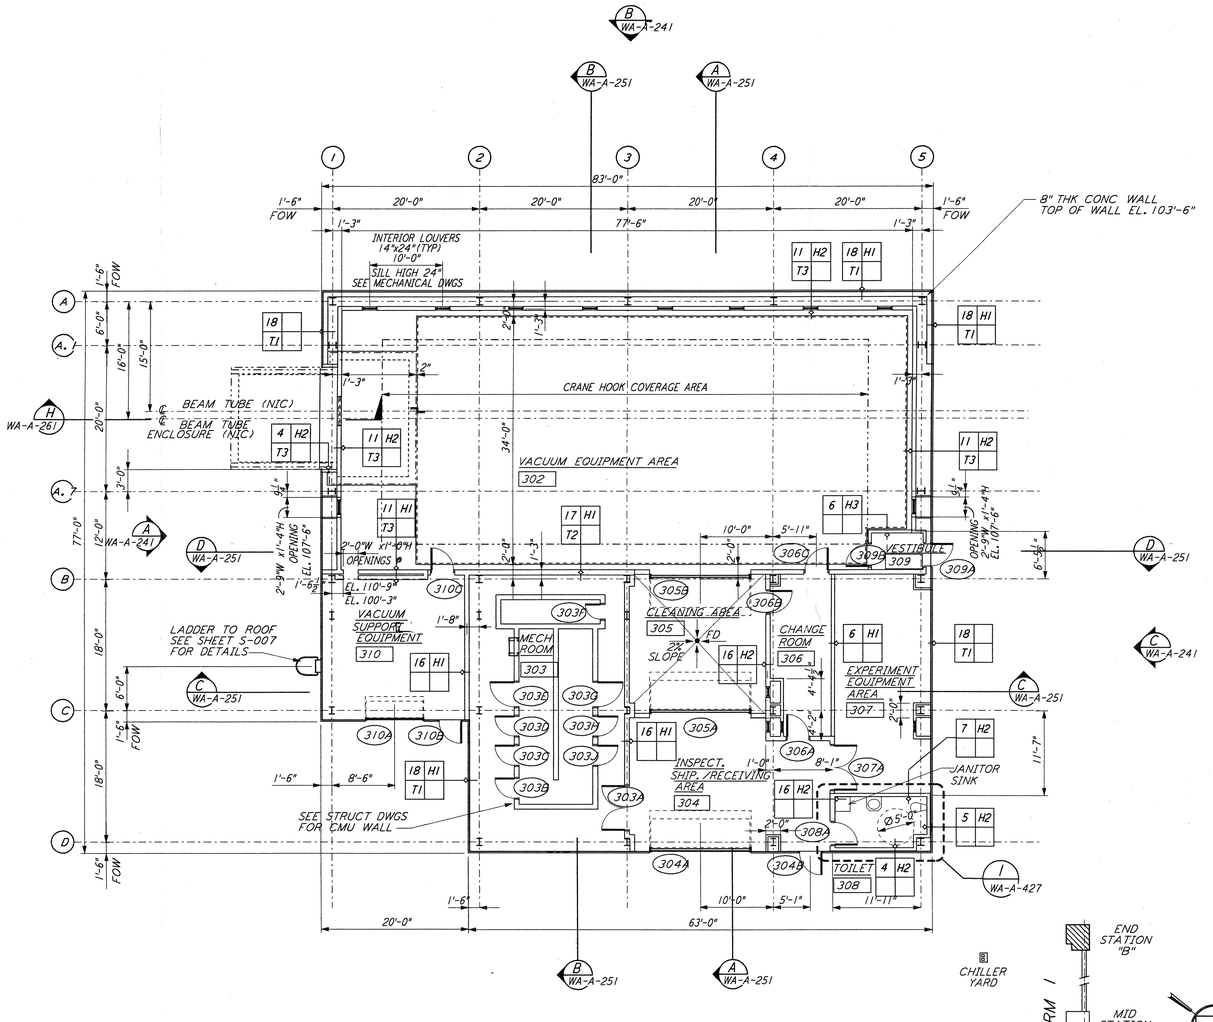

END STATION "A" FLOOR PLAN

1 WA-A-202

1/8"=1'-0"
FOR LOUVER AND OPENING LOCATIONS
SEE MID STATION "A" FLOOR PLAN

0 8 16 24 32FT
1/8"=1'-0"

DATUM POINT EB +100.00 = 531.11' (LVEA)
DATUM POINT EL +100.00 = 531.11' (OSB)
DATUM POINT EL +100.00 = 528.07' (MID NORTH)
DATUM POINT EL +100.00 = 527.05 (END NORTH)
DATUM POINT EL +100.00 = 532.22' (MID SOUTH WEST)

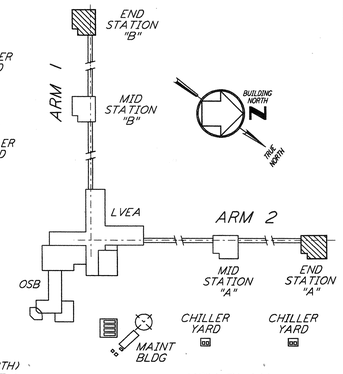

KEY PLAN

LIGO-D960260-02-O

REFERENCES		REVISIONS							
		NO.	DATE	BY	CHKD	ENGR	PROJ	DESCRIPTION
		2	5-15-98	CKT	[illegible]	[illegible]		ISSUED FOR AS-BUILT
		1	2-28-97	CKT	TB	AK	TDM	MID & END STATION PARTITION
DRAWING NO.	DESCRIPTION							

ISSUED FOR CONSTRUCTION		
DRAWN	CKT	5-12-96
CHECKED	TB	5-26-96
ENGINEER	bkk	7-12-96
PROJ	MDW	7-12-96

AS-BUILT DRAWINGS

PARSONS
100 WEST WALNUT STREET
PASADENA, CALIFORNIA

LIGO
CALIFORNIA INSTITUTE OF TECHNOLOGY
MASSACHUSETTS INSTITUTE OF TECHNOLOGY

LASER INTERFEROMETER GRAVITATIONAL-WAVE OBSERVATORY
SITE NO. 1 - HANFORD, WASHINGTON

TITLE: **ARCHITECTURAL END STATIONS FLOOR PLANS**

SCALE	CONTRACT NUMBER	PROJECT NUMBER
AS NOTED	PP150969	8094

SHEET NUMBER: **WA-A-202** REVISIONS: 2

LIGOWAF3.BDR

Wed Jul 15 08:56:54 1998 C:\PLOT\QUES3-V3682.DCF 52805 K1V3682\or202.plf