This document and the design it covers are the property of PARSONS. They are loaned only with the borrower's expressed written agreement that they will not be reproduced, copied, loaned, exhibited, or used in any other way, except by written consent from PARSONS to the borrower.

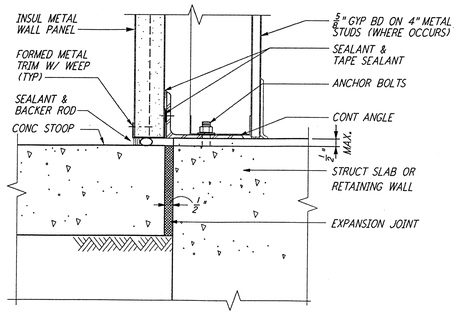

CONC STOOP AT MET PANEL — 14 REF WA-A-421 WA-A-261

3" =1'-0"

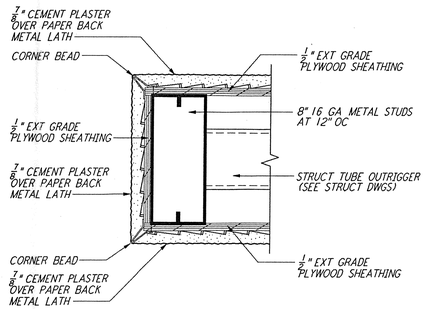

END OF CURVED WALL — 10 REF WA-A-421 WA-A-108

3" =1'-0"

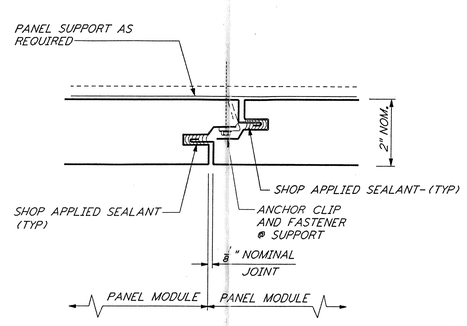

VERT MET WALL PANEL JT — 6 REF WA-A-421 WA-A-542

HALF FULL ~~WA-A-142~~

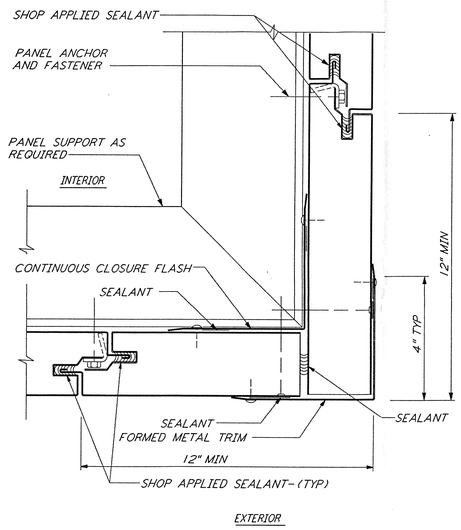

OUTSIDE CORNER FLASHING — 4 REF WA-A-421 WA-A-541 WA-A-542

HALF FULL ~~WA-A-141~~ ~~WA-A-142~~

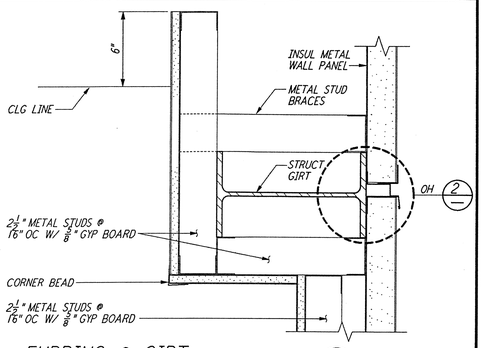

FURRING @ GIRT — 1 REF WA-A-421 WA-A-163

3" =1'-0"

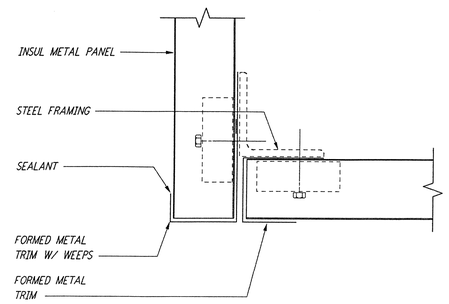

METAL PANEL SOFFIT — 15 REF WA-A-421 WA-A-425

HALF FULL

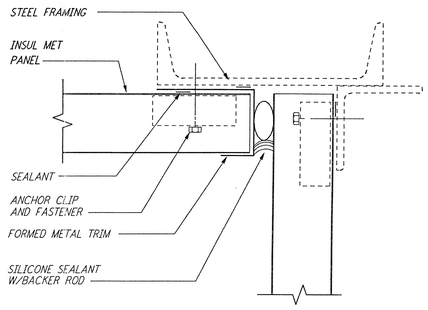

METAL PANEL SOFFIT — 11 REF WA-A-421 WA-A-425

HALF FULL

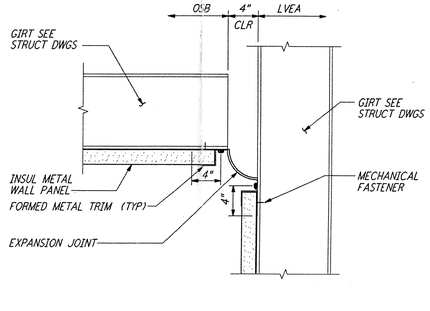

VERT INSIDE CORNER EXP JT — 7 REF WA-A-421 WA-A-132

1 1/2"=1'-0"

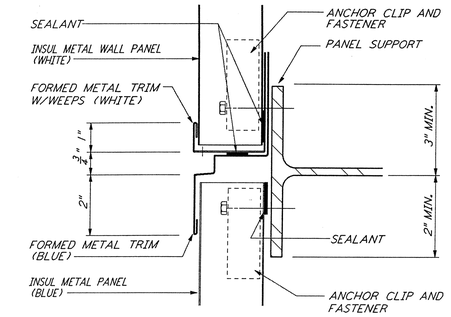

MET WALL PANEL HORIZ JT — 2 REF WA-A-421 WA-A-541

HALF FULL ~~WA-A-141~~

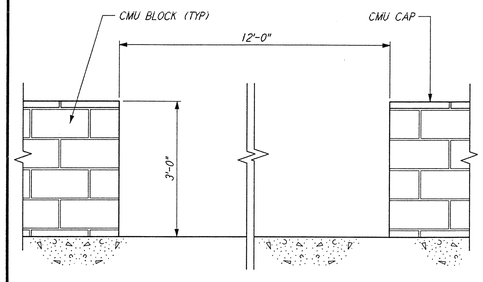

BLOCK WALL — 16 REF WA-A-421 WA-A-108

3/4"=1'-0"

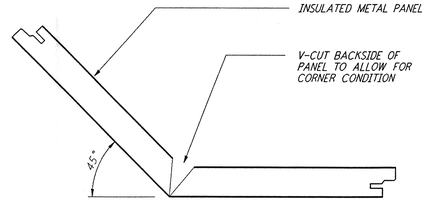

PANEL JOINT AT CANOPY — 12 REF WA-A-421 WA-A-132 WA-A-122

3" =1'-0"

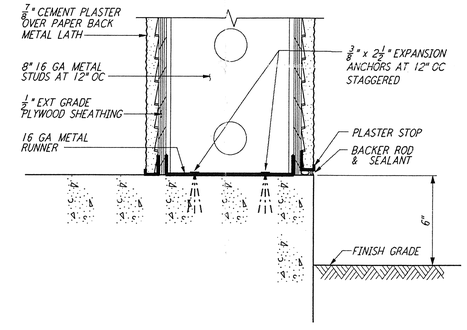

CURVED WALL CURB — 8 REF WA-A-421 WA-A-541

3" =1'-0" ~~WA-A-141~~

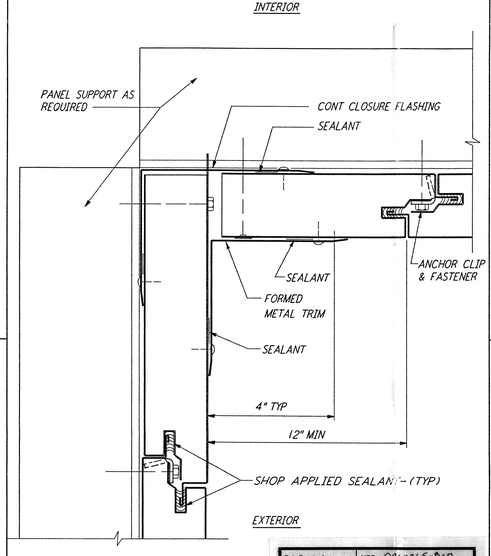

Date Received: 4/19/96	LIGO- D960265-B-D WA-A-421 REV. B
TIM #: 2.5	LIGO- C960857-00-V
Date: 4/19/96	Approved:
TDM #:	LIGO-
Date: / /	Approved:
Gen'l Transmittal	LIGO-
Date: / /	Approved:

INSIDE CORNER FLASHING — 5 REF WA-A-421 WA-A-502 WA-A-505

HALF FULL ~~WA-A-102~~ ~~WA-A-105~~

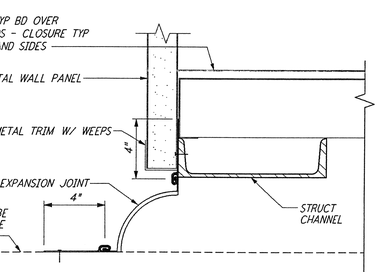

EXP JT @ BM TUBE ENCL — 3 REF WA-A-421 WA-A-161

3" =1'-0"

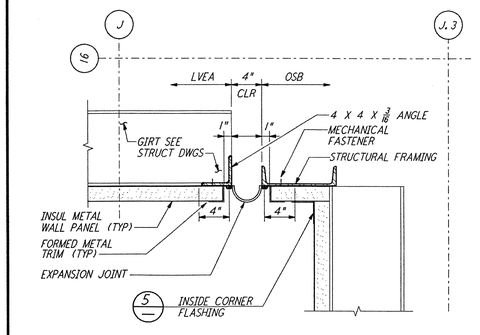

VERTICAL EXPANSION JOINT — 17 REF WA-A-421 WA-A-109 WA-A-504

1 1/2"=1'-0"

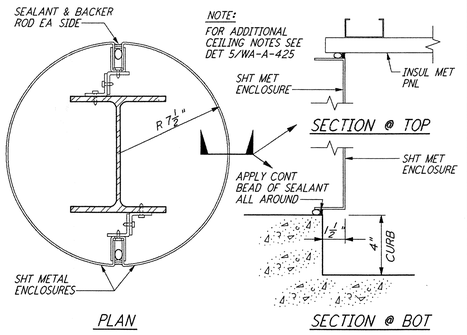

COLUMN ENCLOSURE — 13 REF WA-A-421 WA-A-163

3" =1'-0"

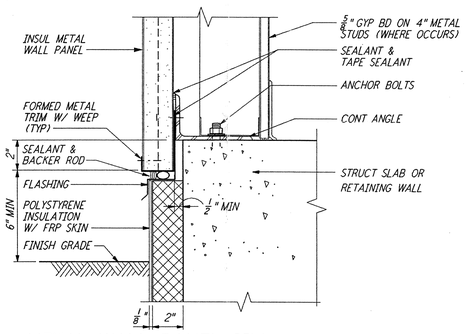

METAL WALL PANEL SILL — 9 REF WA-A-421 WA-A-163 WA-A-161

3" =1'-0"

0 1 2 3 4 5FT
3/4" = 1'-0"

0 1 2 3FT
1 1/2" = 1'-0"

0 1 2 3 4 5 6 7 8 9 10 11 1FT
3" = 1'-0"

0 1 2 3 4 5 6 7 8IN
HALF SIZE

REFERENCES		REVISIONS						
DRAWING NO.	DESCRIPTION	NO.	DATE	BY	CHKD	ENGR	PROJ	DESCRIPTION
		B	4-19-96		SF	SF	TDM	FINAL DESIGN REVIEW & BID
		A	01/17/96		SF	SF	TDM	PRELIMINARY DESIGN REVIEW

DRAWN	SH/RR
CHECKED	
ENGINEER	
PROJ	

PARSONS

100 WEST WALNUT STREET
PASADENA, CALIFORNIA

LIGO

CALIFORNIA INSTITUTE OF TECHNOLOGY
MASSACHUSETTS INSTITUTE OF TECHNOLOGY

LASER INTERFEROMETER GRAVITATIONAL-WAVE OBSERVATORY
SITE NO. 1 - HANFORD, WASHINGTON

TITLE: ARCHITECTURAL EXTERIOR WALL DETAILS

SCALE	CONTRACT NUMBER	PROJECT NUMBER
AS NOTED	PP150969	8094

SHEET NUMBER: WA-A-421 REVISIONS: B

LIGO-D960265-B-D

LIGOWAF.BDR

J:\PLOTS\DUELUES\V3BBC\AH4421E.PHP 2892633 1996 s-s-x 04 Apr