This document and the design it covers are the property of PARSONS. They are loaned only with the borrower's expressed written agreement that they will not be reproduced, copied, loaned, exhibited, or used in any other way, except by written consent from PARSONS to the borrower.

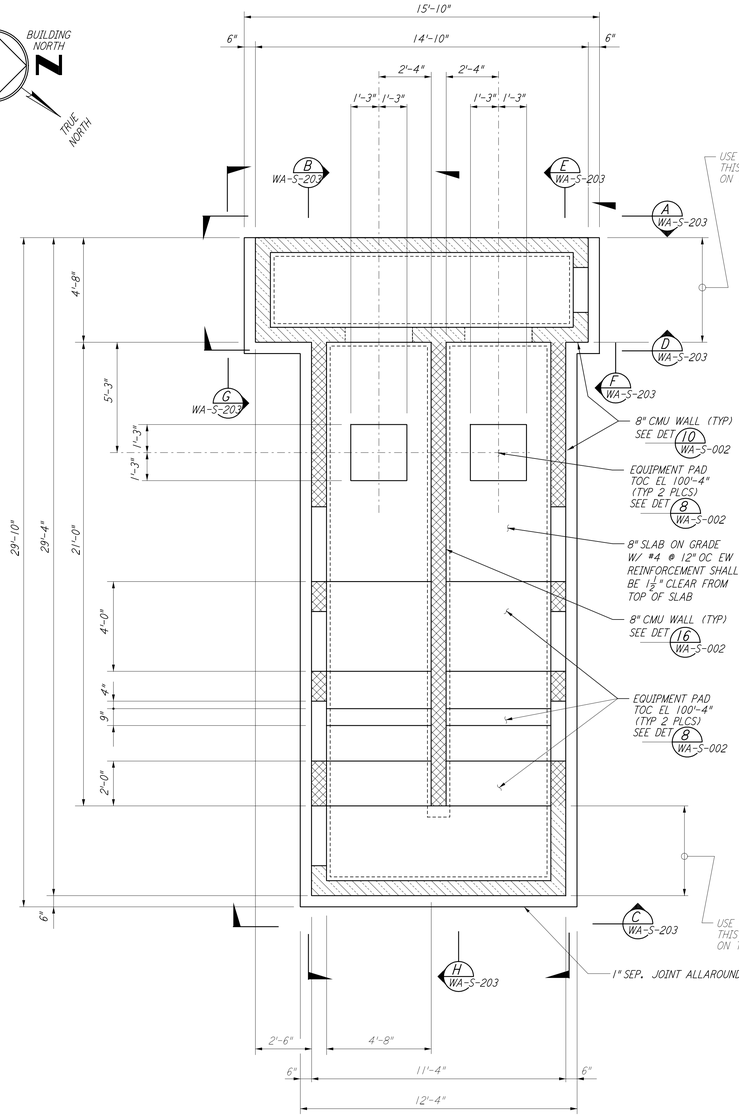

AIR HANDLING UNIT STRUCTURE

FOUNDATION PLAN

⅜" = 1'-0"

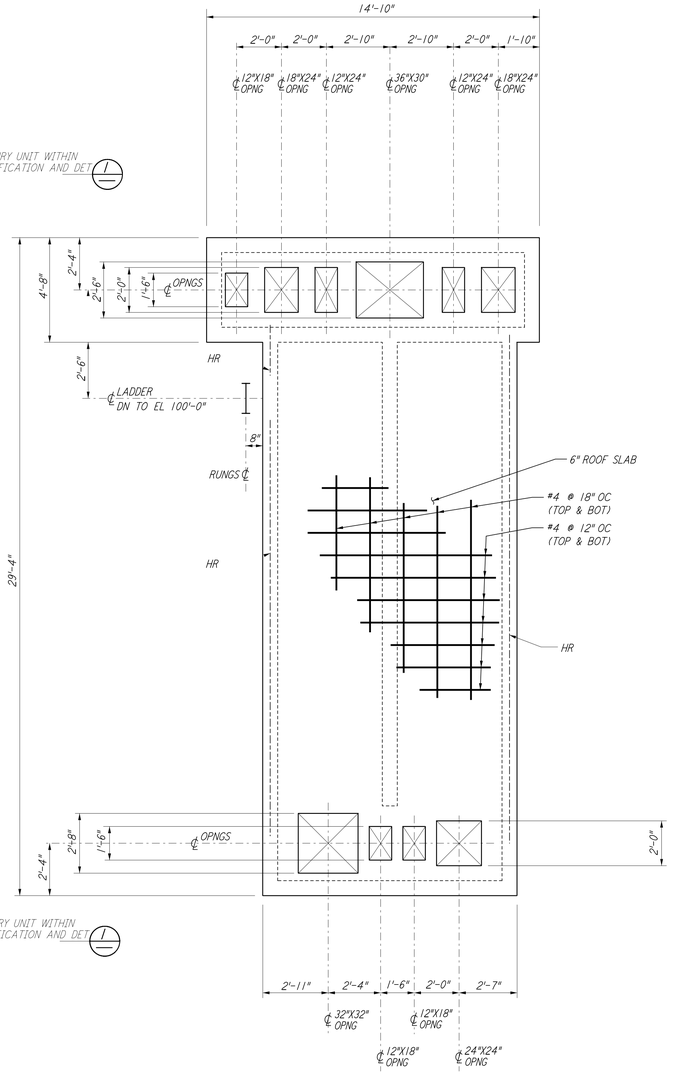

AIR HANDLING UNIT STRUCTURE

CONCRETE ROOF SLAB PLAN

⅜" = 1'-0"

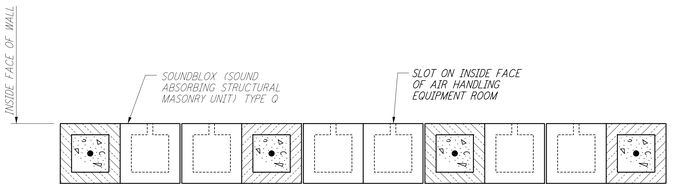

TYPICAL SECTION OF SOUNDBLOX MASONRY WALL

DETAIL 1

1½" = 1'-0"

NOTE:

1. LOCATION AND SIZE OF ALL EQUIPMENT PADS ARE FOR BID PURPOSE ONLY. CONTRACTOR SHALL ADJUST TO SUIT ACTUAL EQUIPMENT AND SUBMIT DRAWINGS SHOWING ACTUAL SIZES AND LOCATIONS PRIOR TO CONSTRUCTION.

0 2 4 6 8 10FT

⅜" = 1'-0"

LIGO-D960308-01-O

REFERENCES

DRAWING NO.	DESCRIPTION

REVISIONS

NO.	DATE	BY	CHKD	ENGR	PROJ	DESCRIPTION
1	6-15-98	CKT				ISSUED FOR AS-BUILT

ISSUED FOR CONSTRUCTION		
DRAWN	MCS	6-24-96
CHECKED	DDM	7-2-96
ENGINEER	BP	6-18-96
PROJ	MDW	7-9-96

AS-BUILT DRAWINGS

PARSONS
100 WEST WALNUT STREET
PASADENA, CALIFORNIA

LIGO
CALIFORNIA INSTITUTE OF TECHNOLOGY
MASSACHUSETTS INSTITUTE OF TECHNOLOGY

LASER INTERFEROMETER GRAVITATIONAL-WAVE OBSERVATORY
SITE NO. 1 - HANFORD, WASHINGTON

TITLE
STRUCTURAL MID & END STATIONS AIR HANDLING UNIT ENCLOSURE PLANS

SCALE	CONTRACT NUMBER	PROJECT NUMBER
AS NOTED	PP150969	8094

SHEET NUMBER **WA-S-202** REVISIONS 1

LIGOWAF.BDR