

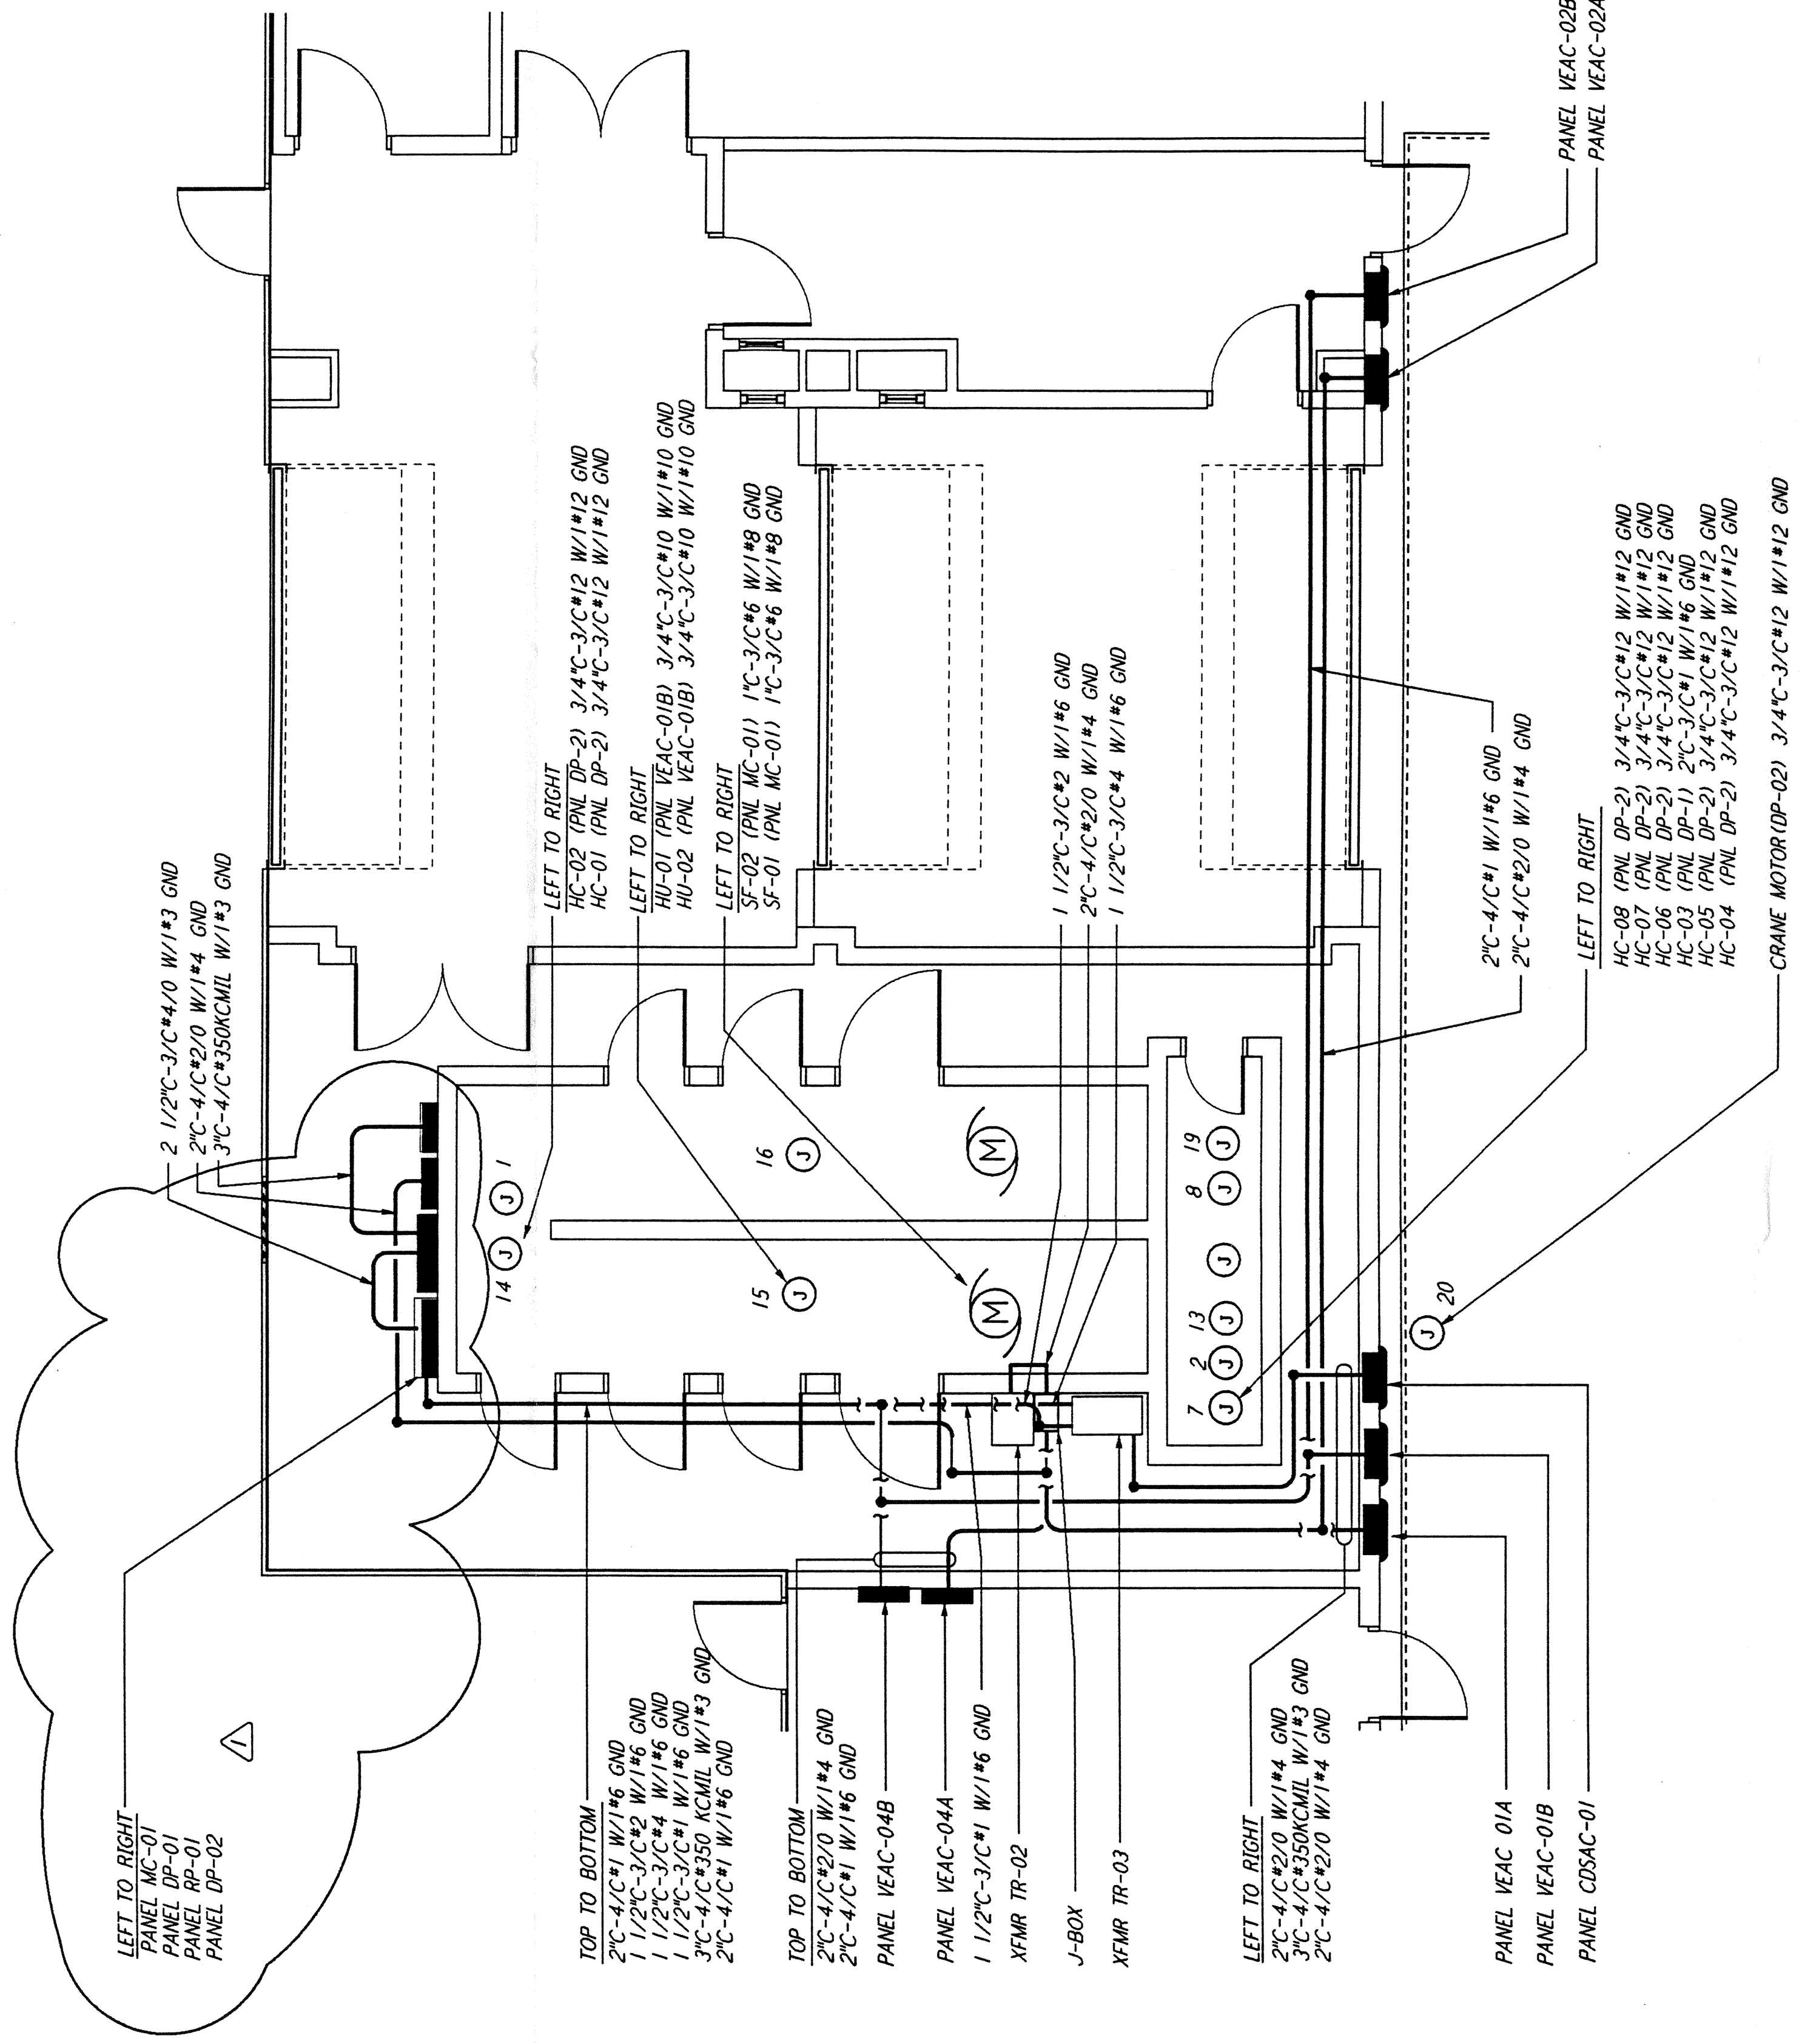
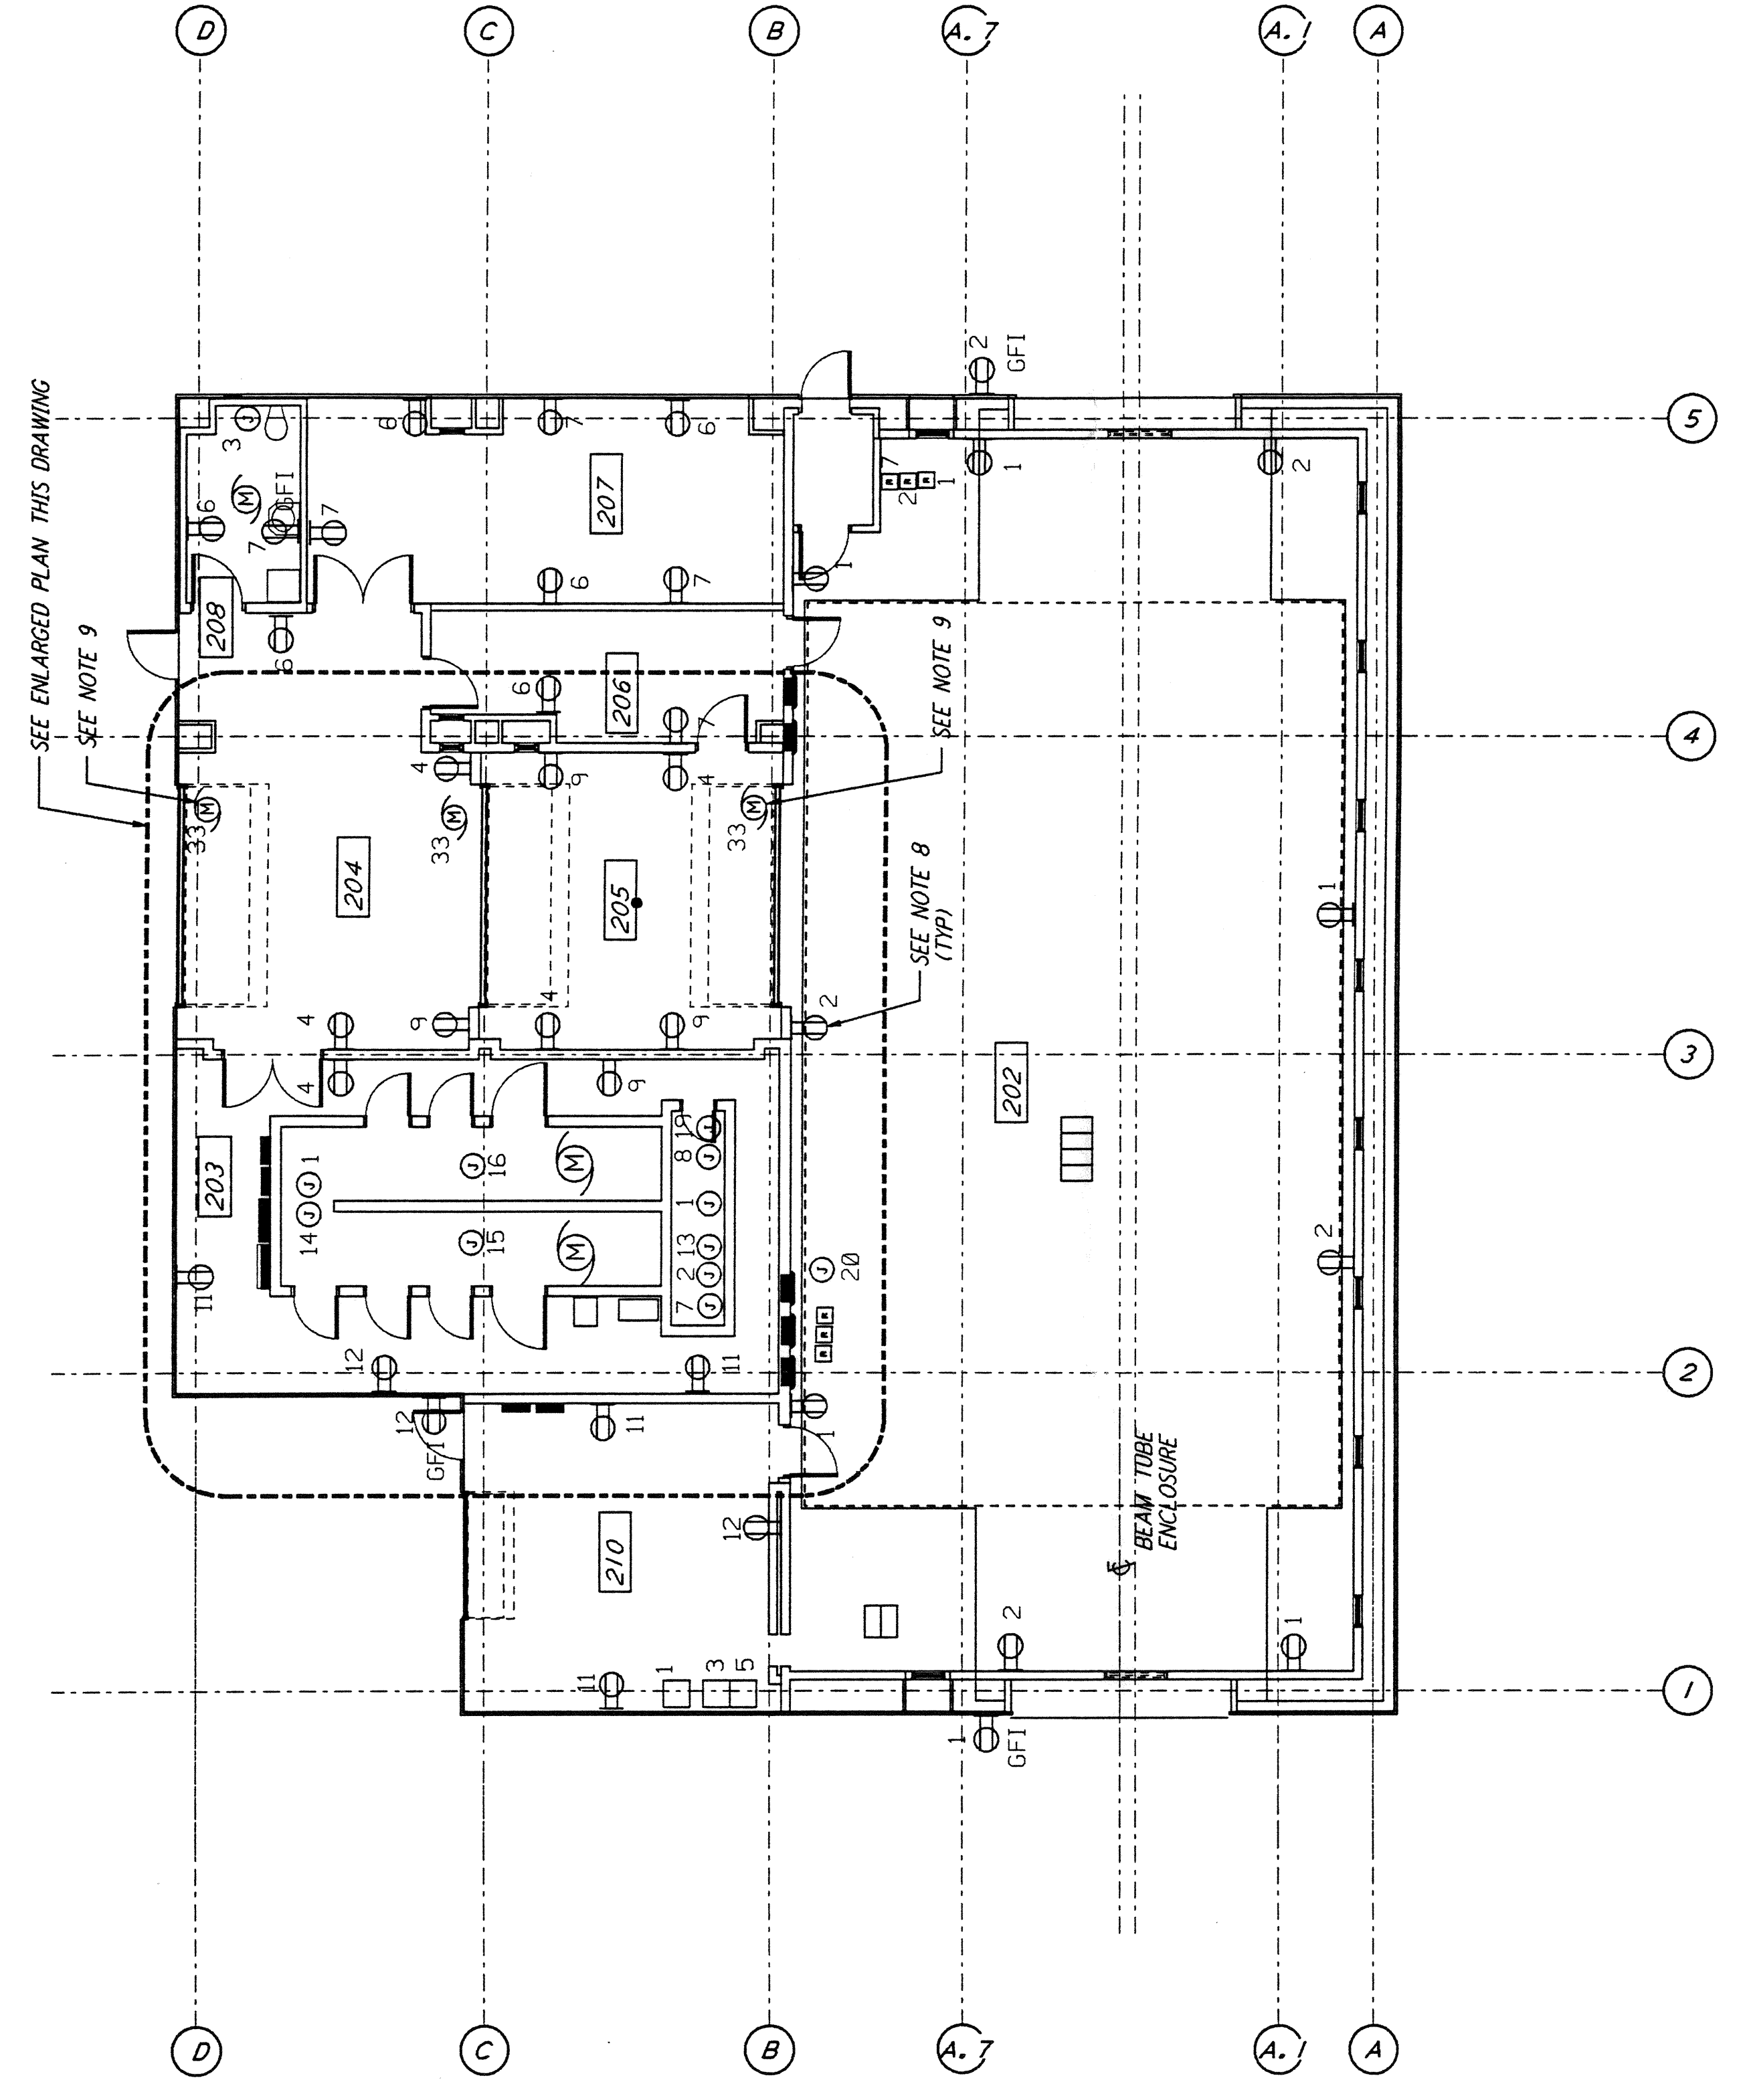


GENERAL NOTES:


- FOR STANDARD SYMBOLS, ABBREVIATIONS AND ACRONYMS SEE DWG. WA-E-001.
- FOR ELECTRICAL SYMBOLS SEE DWG. WA-E-002.
- FOR STANDARD INSTALLATION DETAILS SEE DWG. WA-E-404 AND WA-E-409.
- FOR CABLE TYPE DESCRIPTION SEE DWG. WA-E-007.
- ALL RUNS ARE SHOWN DIAGRAMMATICALLY ONLY, CONTRACTOR SHALL COORDINATE INSTALLATION WITH OTHER DISCIPLINES.
- FOR SINGLE LINE DIAGRAM, SEE DWG. WA-E-008.
- FOR EQUIPMENT LOCATION, SEE HVAC DWG. WA-H-211.
- ALL CIRCUITS SHOWN ON THIS DRAWING ARE FROM PANEL RP01 UNLESS OTHERWISE NOTED.
- CIRCUIT SHOWN FEEDING THESE ITEMS ARE FROM DP-02.
- PANEL SCHEDULES ARE SHOWN ON DRAWINGS WA-E-205 AND WA-E-206.

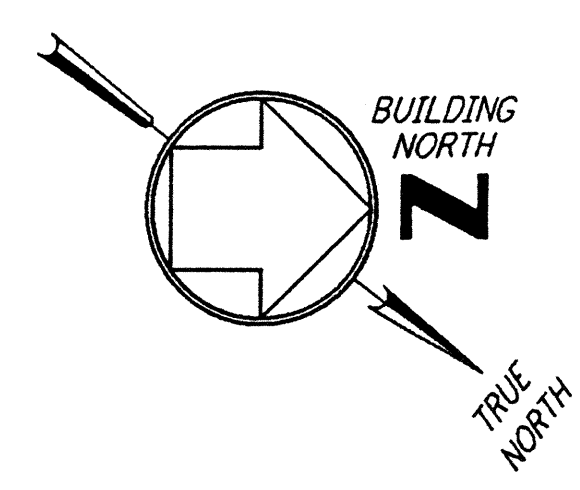

ENLARGED PLAN
 1/4" = 1'-0"

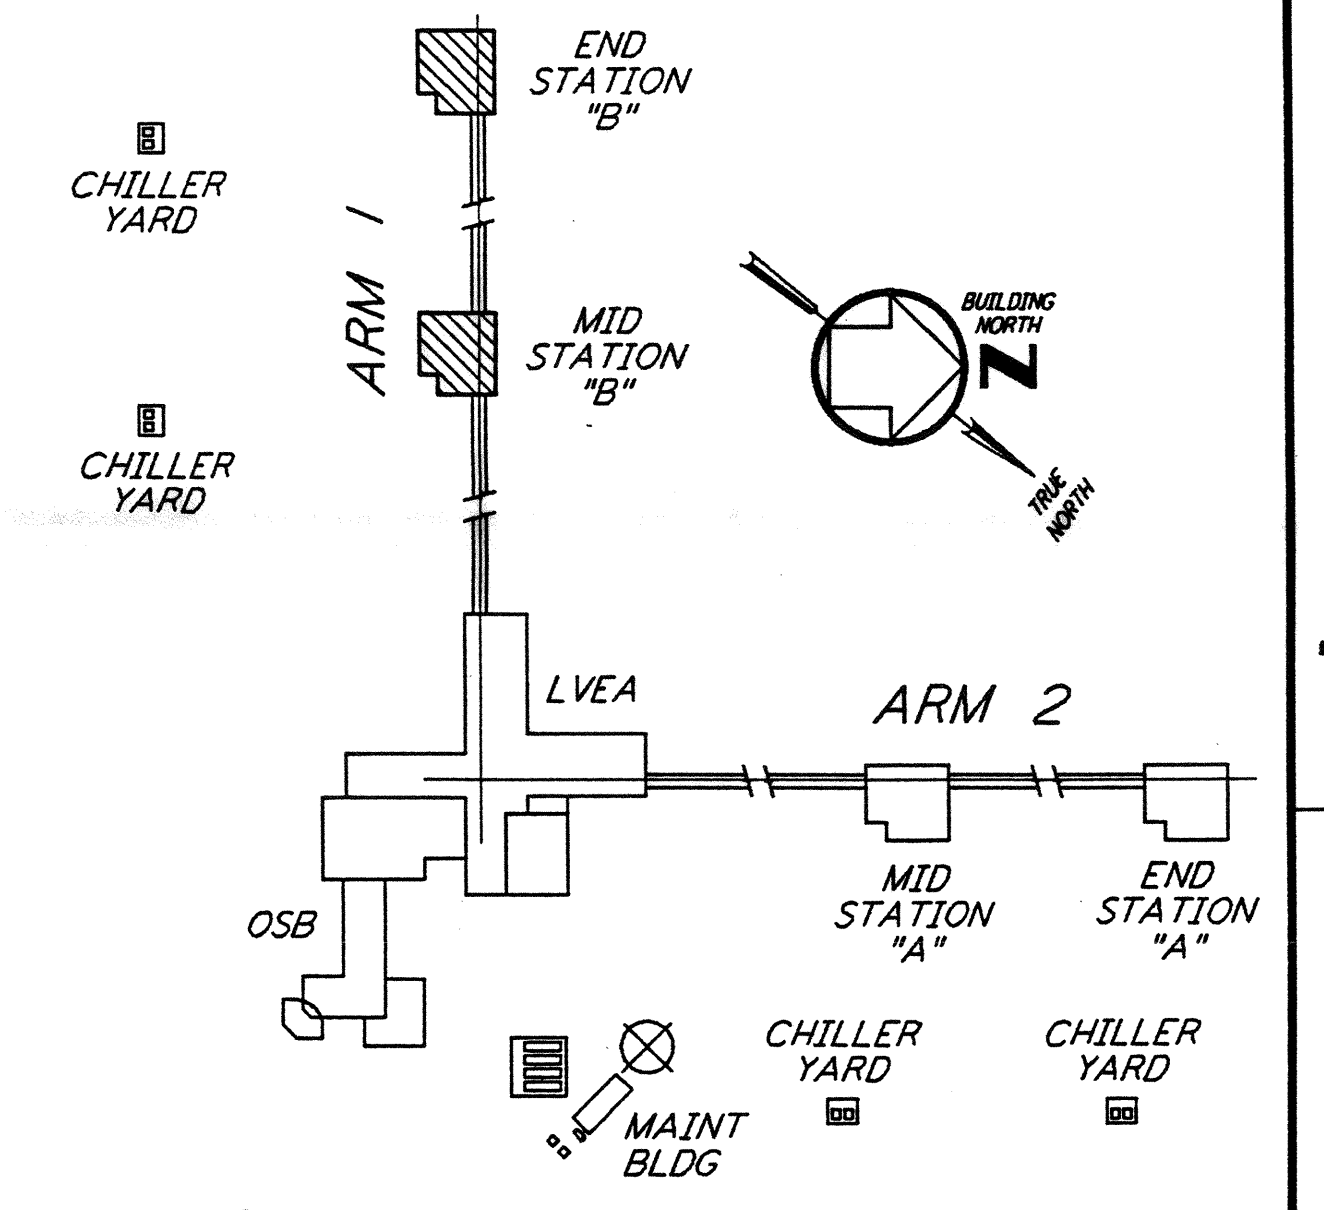


KEY PLAN

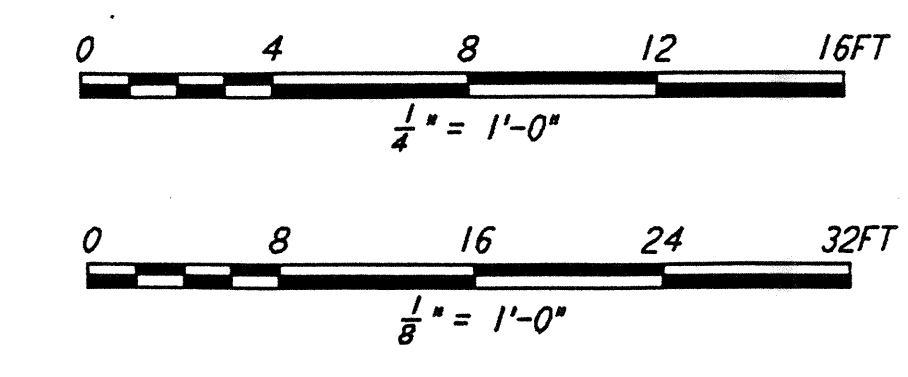

LIGO-D960420-01-0

NO.	DATE	BY	CHKD	ENGR	PROJ	DESCRIPTION
1	3-21-97	J.G.				BID ADDENDUM #2 GENERAL REVISIONS

NO.	DATE	BY	CHKD	ENGR	PROJ	DESCRIPTION
1	6-25-96	M.M.				ISSUED FOR CONSTRUCTION
2	7-3-96	J.K.				CHECKED
3	7-3-96	K.R.				ENGINEER
4	7-8-96	T.D.M.				PROJ

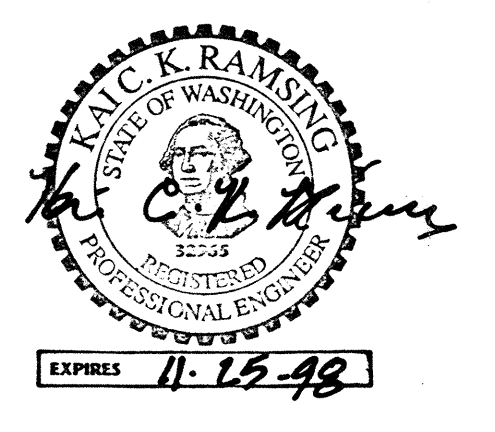

PARSONS
 100 WEST WALNUT STREET
 PASADENA, CALIFORNIA

LIGO
 CALIFORNIA INSTITUTE OF TECHNOLOGY
 MASSACHUSETTS INSTITUTE OF TECHNOLOGY

LASER INTERFEROMETER
 GRAVITATIONAL-WAVE OBSERVATORY
 SITE NO. 1 - HANFORD, WASHINGTON

TITLE: ELECTRICAL MID & END B STATIONS ABOVEGROUND POWER PLAN
 SCALE: AS NOTED
 CONTRACT NUMBER: PP150969
 PROJECT NUMBER: 8094
 SHEET NUMBER: **WA-E-214**

This document and the design it covers are the property of **PARSONS**. They are loaned only with the borrower's expressed written agreement that they will not be reproduced, copied, loaned, exhibited, or used in any other way, except by written consent from **PARSONS** to the borrower.

FOR NO. 24 1438326 1197 537466Z JCNPLUSV0005Y0R0K2E214.PDF LIGOWAF3.BDR