This document and the design it covers are the property of **PARSONS**. They are loaned only with the borrower's expressed written agreement that they will not be reproduced, copied, loaned, exhibited, or used in any other way, except by written consent from **PARSONS** to the borrower.

## NOTES:

1. SEE SHEET BT-C-002 FOR GENERAL NOTES, LEGEND AND ABBREVIATIONS.

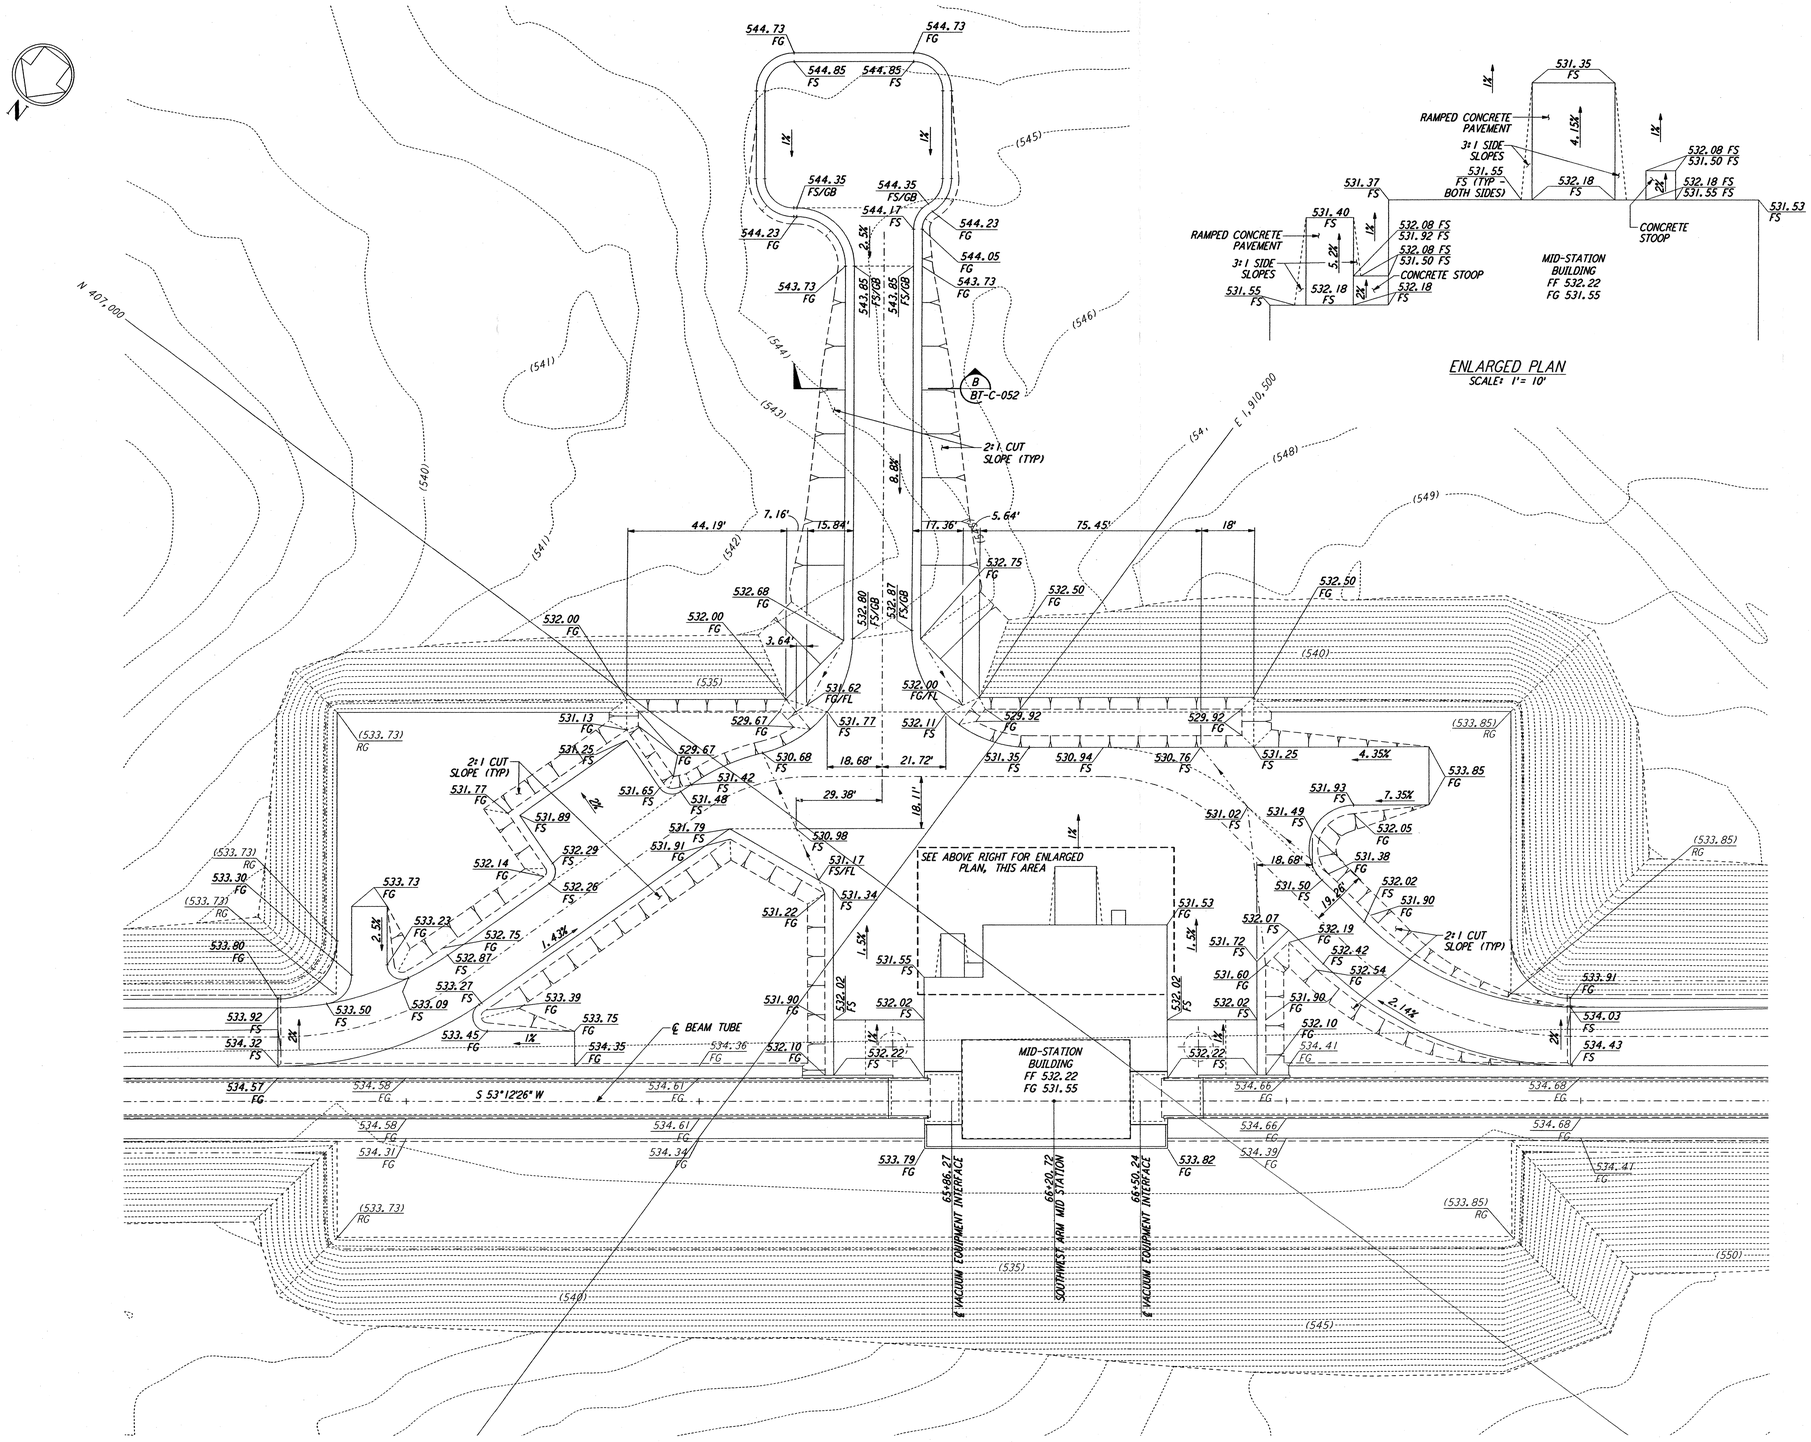





ENLARGED PLAN
SCALE: 1" = 10'

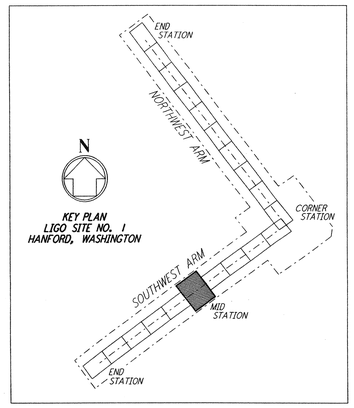


**LIGO-D960728-00-O**

GRAPHIC SCALE
0 20 40 60 80
SCALE: 1" = 20'

| REFERENCES | | REVISIONS | | | | | | |
|---|---|---|---|---|---|---|---|---|
| DRAWING NO. | DESCRIPTION | NO. | DATE | BY | CHKD | ENGR | PROJ | DESCRIPTION |
| | | 0 | 1-22-99 | MEI | -- | -- | MDW | ISSUED FOR AS BUILT |
| | | A | 4-19-96 | WRB | TDM | | MDW | CHANGE ORDER NO. 4 |

| | |
|---|---|
| DRAWN | WRB |
| CHECKED | |
| ENGINEER | |
| PROJ | |

**AS-BUILT DRAWINGS**

PARSONS
100 WEST WALNUT STREET
PASADENA, CALIFORNIA

LIGO
CALIFORNIA INSTITUTE OF TECHNOLOGY
MASSACHUSETTS INSTITUTE OF TECHNOLOGY

LASER INTERFEROMETER GRAVITATIONAL-WAVE OBSERVATORY
BTE SITEWORK & FABRICATION - HANFORD, WA

TITLE: CIVIL SOUTHWEST ARM MID-STATION GRADING PLAN

| SCALE | CONTRACT NUMBER | PROJECT NUMBER |
|---|---|---|
| 1" = 20' | PP150969 | 8094 |

SHEET NUMBER: BT-C-042 REVISIONS: 0

LIGOBTF3.BDR

Thu Jan 21 14:43:55 1999 C:\PLOT\DUE\S3-V3682.DCF 52885 K:\V3682\ce042a.prf